
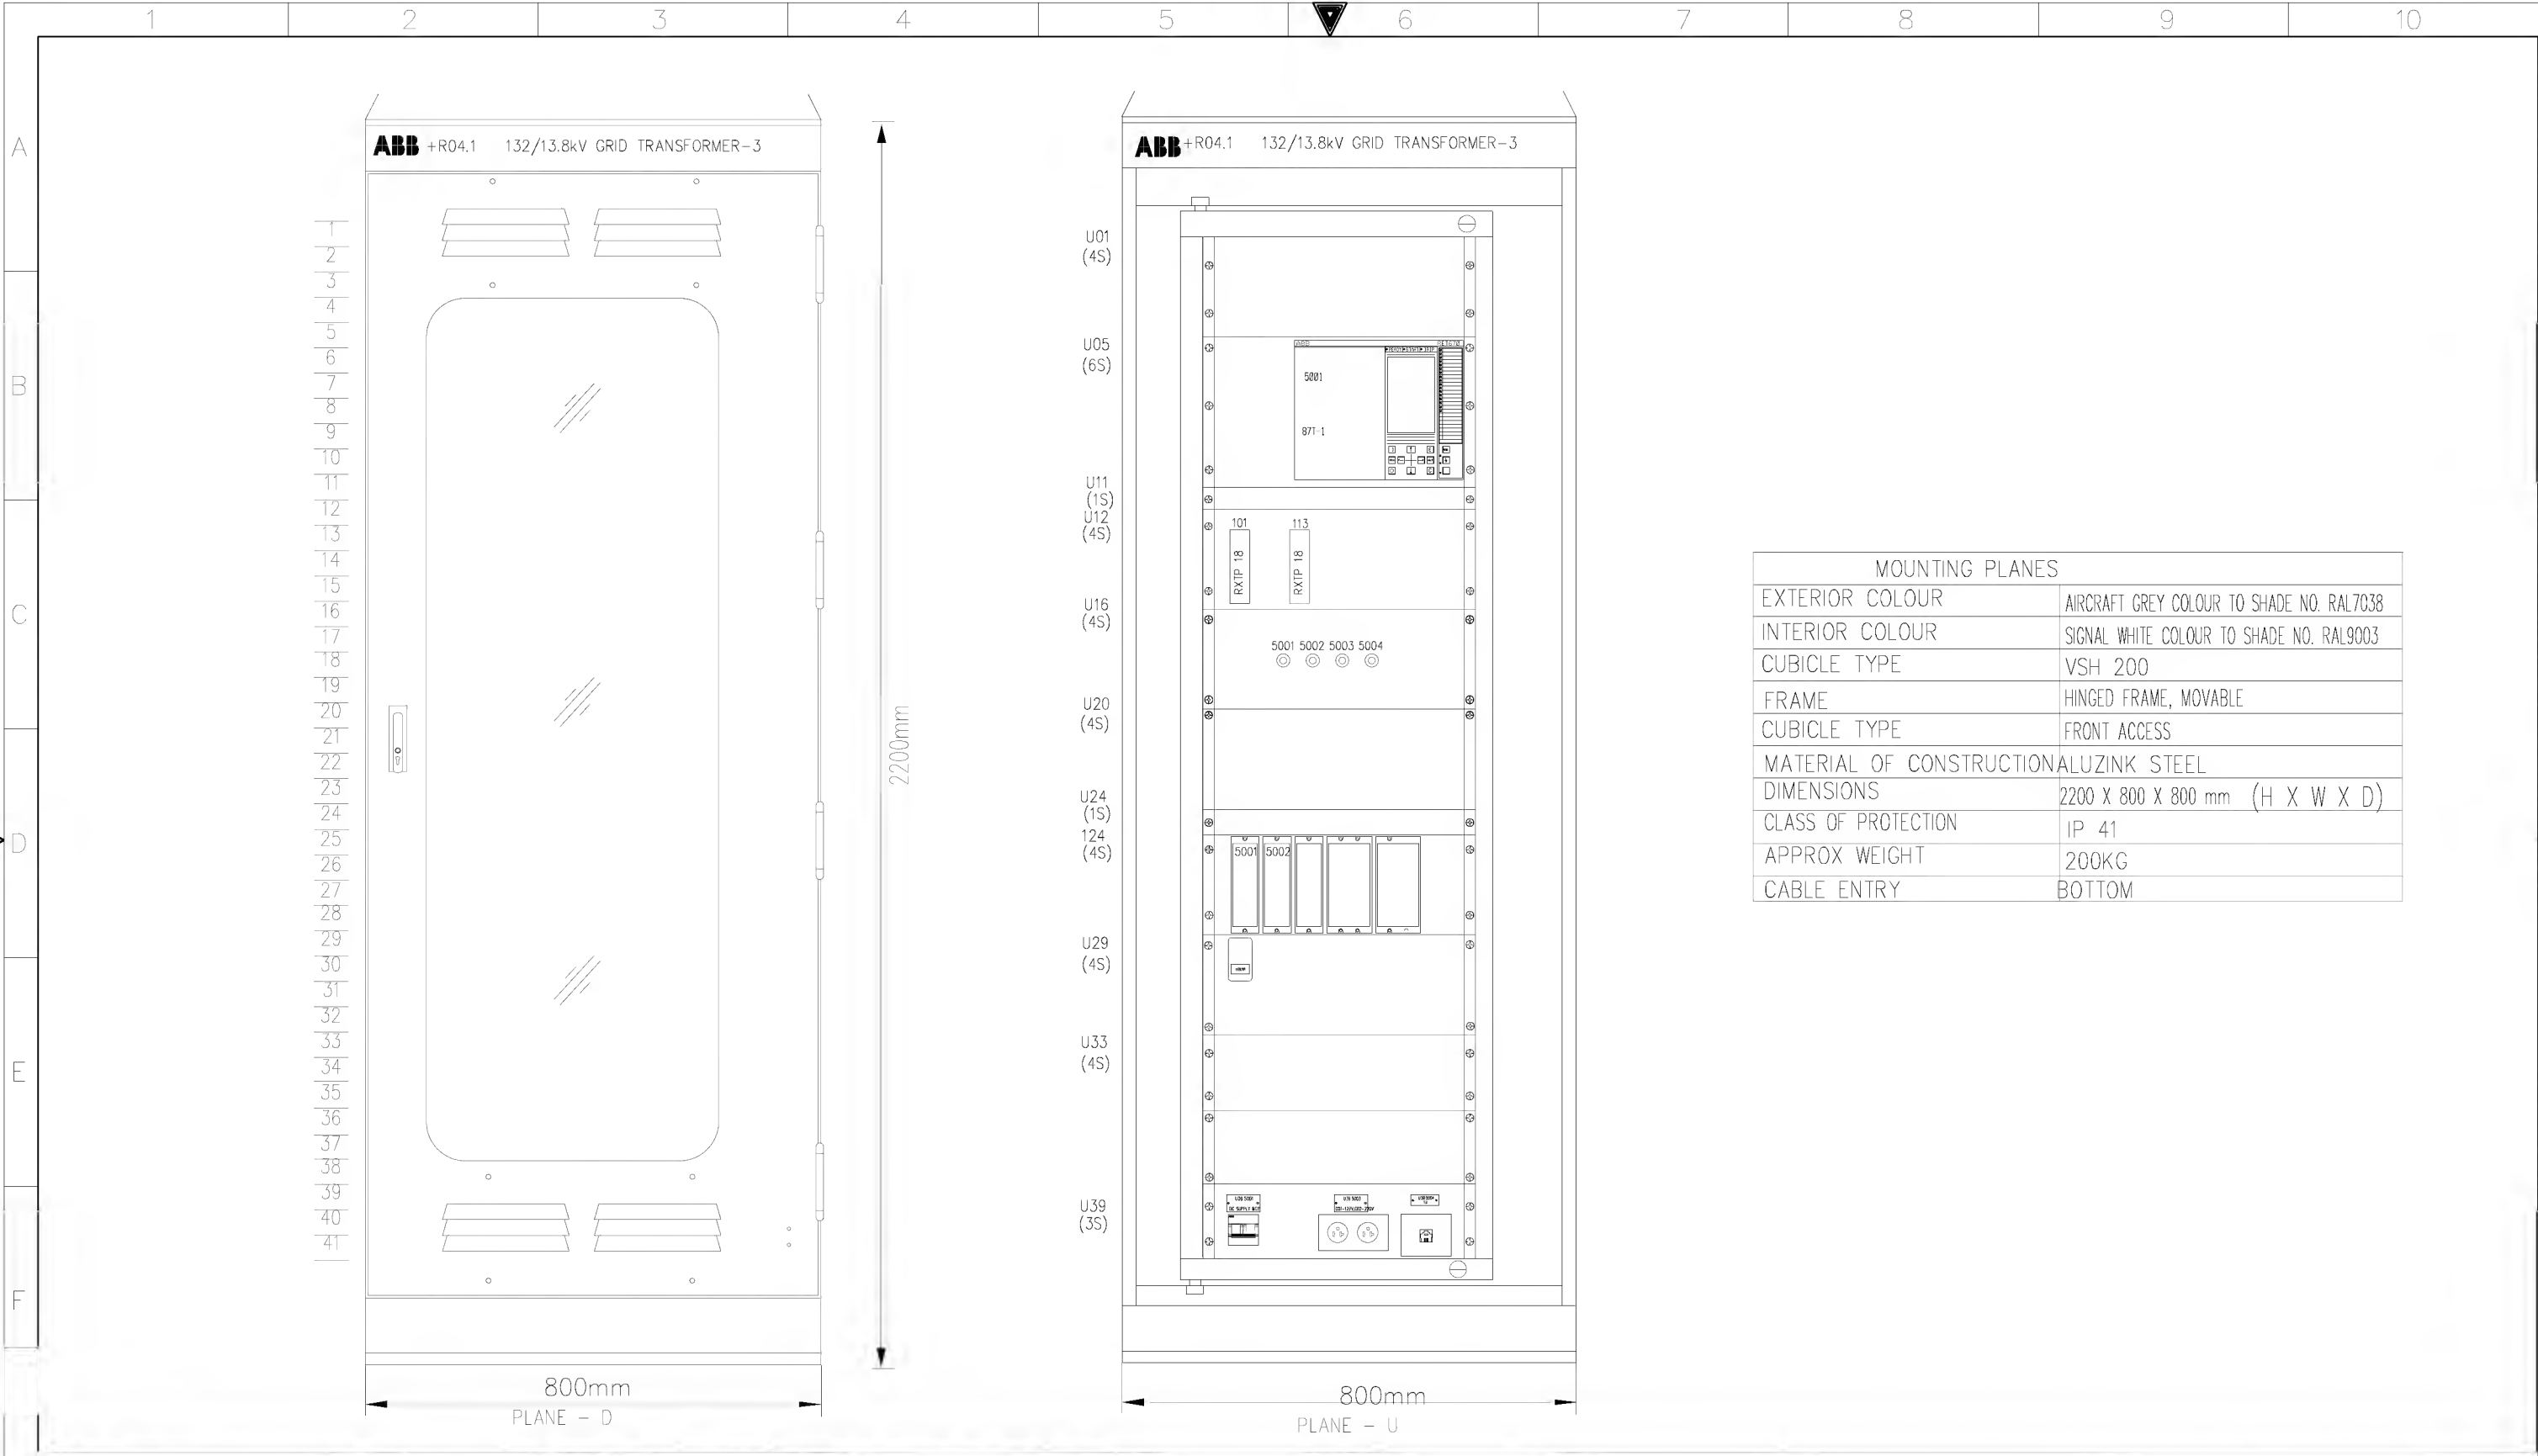


	1	2	3	4	5	6	7																																			
A	<div><div></div><div><div>POWER SYSTEMS NETWORK MANAGEMENT</div><div>PROTECTION AND SUBSTATION AUTOMATION SYSTEMS</div><div>WBS NO: S-13656</div></div></div>																																									
B																																										
C	<div>CONTRACTOR : ABB Contracting Company</div>																																									
D	<div>CLIENT : National Gridsa</div>																																									
E	<div>PROJECT : CONSTRUCTION OF NEW 132/13.8kV SS 8</div>																																									
F	<div>SUBSTATION : S/S 8709</div>																																									
	<div>CONTRACT NO. : 11131113/00</div>																																									
	<div>TITLE : Assembly Drawing – +R04.1 [GT-3]</div>																																									
G	<table><tr><td colspan="3">AS-BUILT BY _____ DATE _____</td><td colspan="2">CONTRACT NO. 11131113/00</td><td colspan="2">JOB ORDER NO. S-13656</td></tr><tr><td>01</td><td>13 49</td><td>FACTORY ASBUILT</td><td colspan="2">DRAWN BY RIZ CHECKED BY JKR</td><td colspan="2">COVER SHEET</td></tr><tr><td>00</td><td>13 04</td><td>FOR APPROVAL</td><td colspan="2">DATE STARTED 24.01.2013 DATE COMPLETED _____</td><td colspan="2">132/13.8kV GT-3 RELAY PANEL-1 +R04.1</td></tr><tr><td>REV. NO.</td><td>DATE</td><td>DESCRIPTION</td><td colspan="2">OPRG. DEPT. CTPD ENG. DEPT. AUT-PSAC</td><td colspan="2">S/S 8709-132/13.8KV IN AL-KHARJ CITY</td></tr><tr><td></td><td></td><td></td><td colspan="2"></td><td colspan="2">RIYADH SAUDI ARABIA</td></tr></table>							AS-BUILT BY _____ DATE _____			CONTRACT NO. 11131113/00		JOB ORDER NO. S-13656		01	13 49	FACTORY ASBUILT	DRAWN BY RIZ CHECKED BY JKR		COVER SHEET		00	13 04	FOR APPROVAL	DATE STARTED 24.01.2013 DATE COMPLETED _____		132/13.8kV GT-3 RELAY PANEL-1 +R04.1		REV. NO.	DATE	DESCRIPTION	OPRG. DEPT. CTPD ENG. DEPT. AUT-PSAC		S/S 8709-132/13.8KV IN AL-KHARJ CITY							RIYADH SAUDI ARABIA	
AS-BUILT BY _____ DATE _____			CONTRACT NO. 11131113/00		JOB ORDER NO. S-13656																																					
01	13 49	FACTORY ASBUILT	DRAWN BY RIZ CHECKED BY JKR		COVER SHEET																																					
00	13 04	FOR APPROVAL	DATE STARTED 24.01.2013 DATE COMPLETED _____		132/13.8kV GT-3 RELAY PANEL-1 +R04.1																																					
REV. NO.	DATE	DESCRIPTION	OPRG. DEPT. CTPD ENG. DEPT. AUT-PSAC		S/S 8709-132/13.8KV IN AL-KHARJ CITY																																					
					RIYADH SAUDI ARABIA																																					




AS-BUILT BY _____ DATE _____			CONTRACT NO. 11131113/00		JOB ORDER NO. S-13656		ASSEMBLY DRAWING		<div>الشركة الوطنية لنقل الكهرباء</div> <div>National Grid sa</div>	
13 49			11		S		132/13.8kV GT-3 RELAY PANEL-1 +R04.1			
00			13 04		04		S/S 8709-132/13.8KV IN AL-KHARJ CITY		INDEX	
REV. NO.			DATE		DESCRIPTION		OPRG. DEPT. CTPD ENG. DEPT. AUT-PSAC		PLANT NO.	
							RIYADH SAUDI ARABIA		DRAWING NUMBER	
									SHEET NO.	
									REV. NO.	
									G01 G02	
									01	

NG/D2-D (2012/01)

DMS VECTOR

NGD200

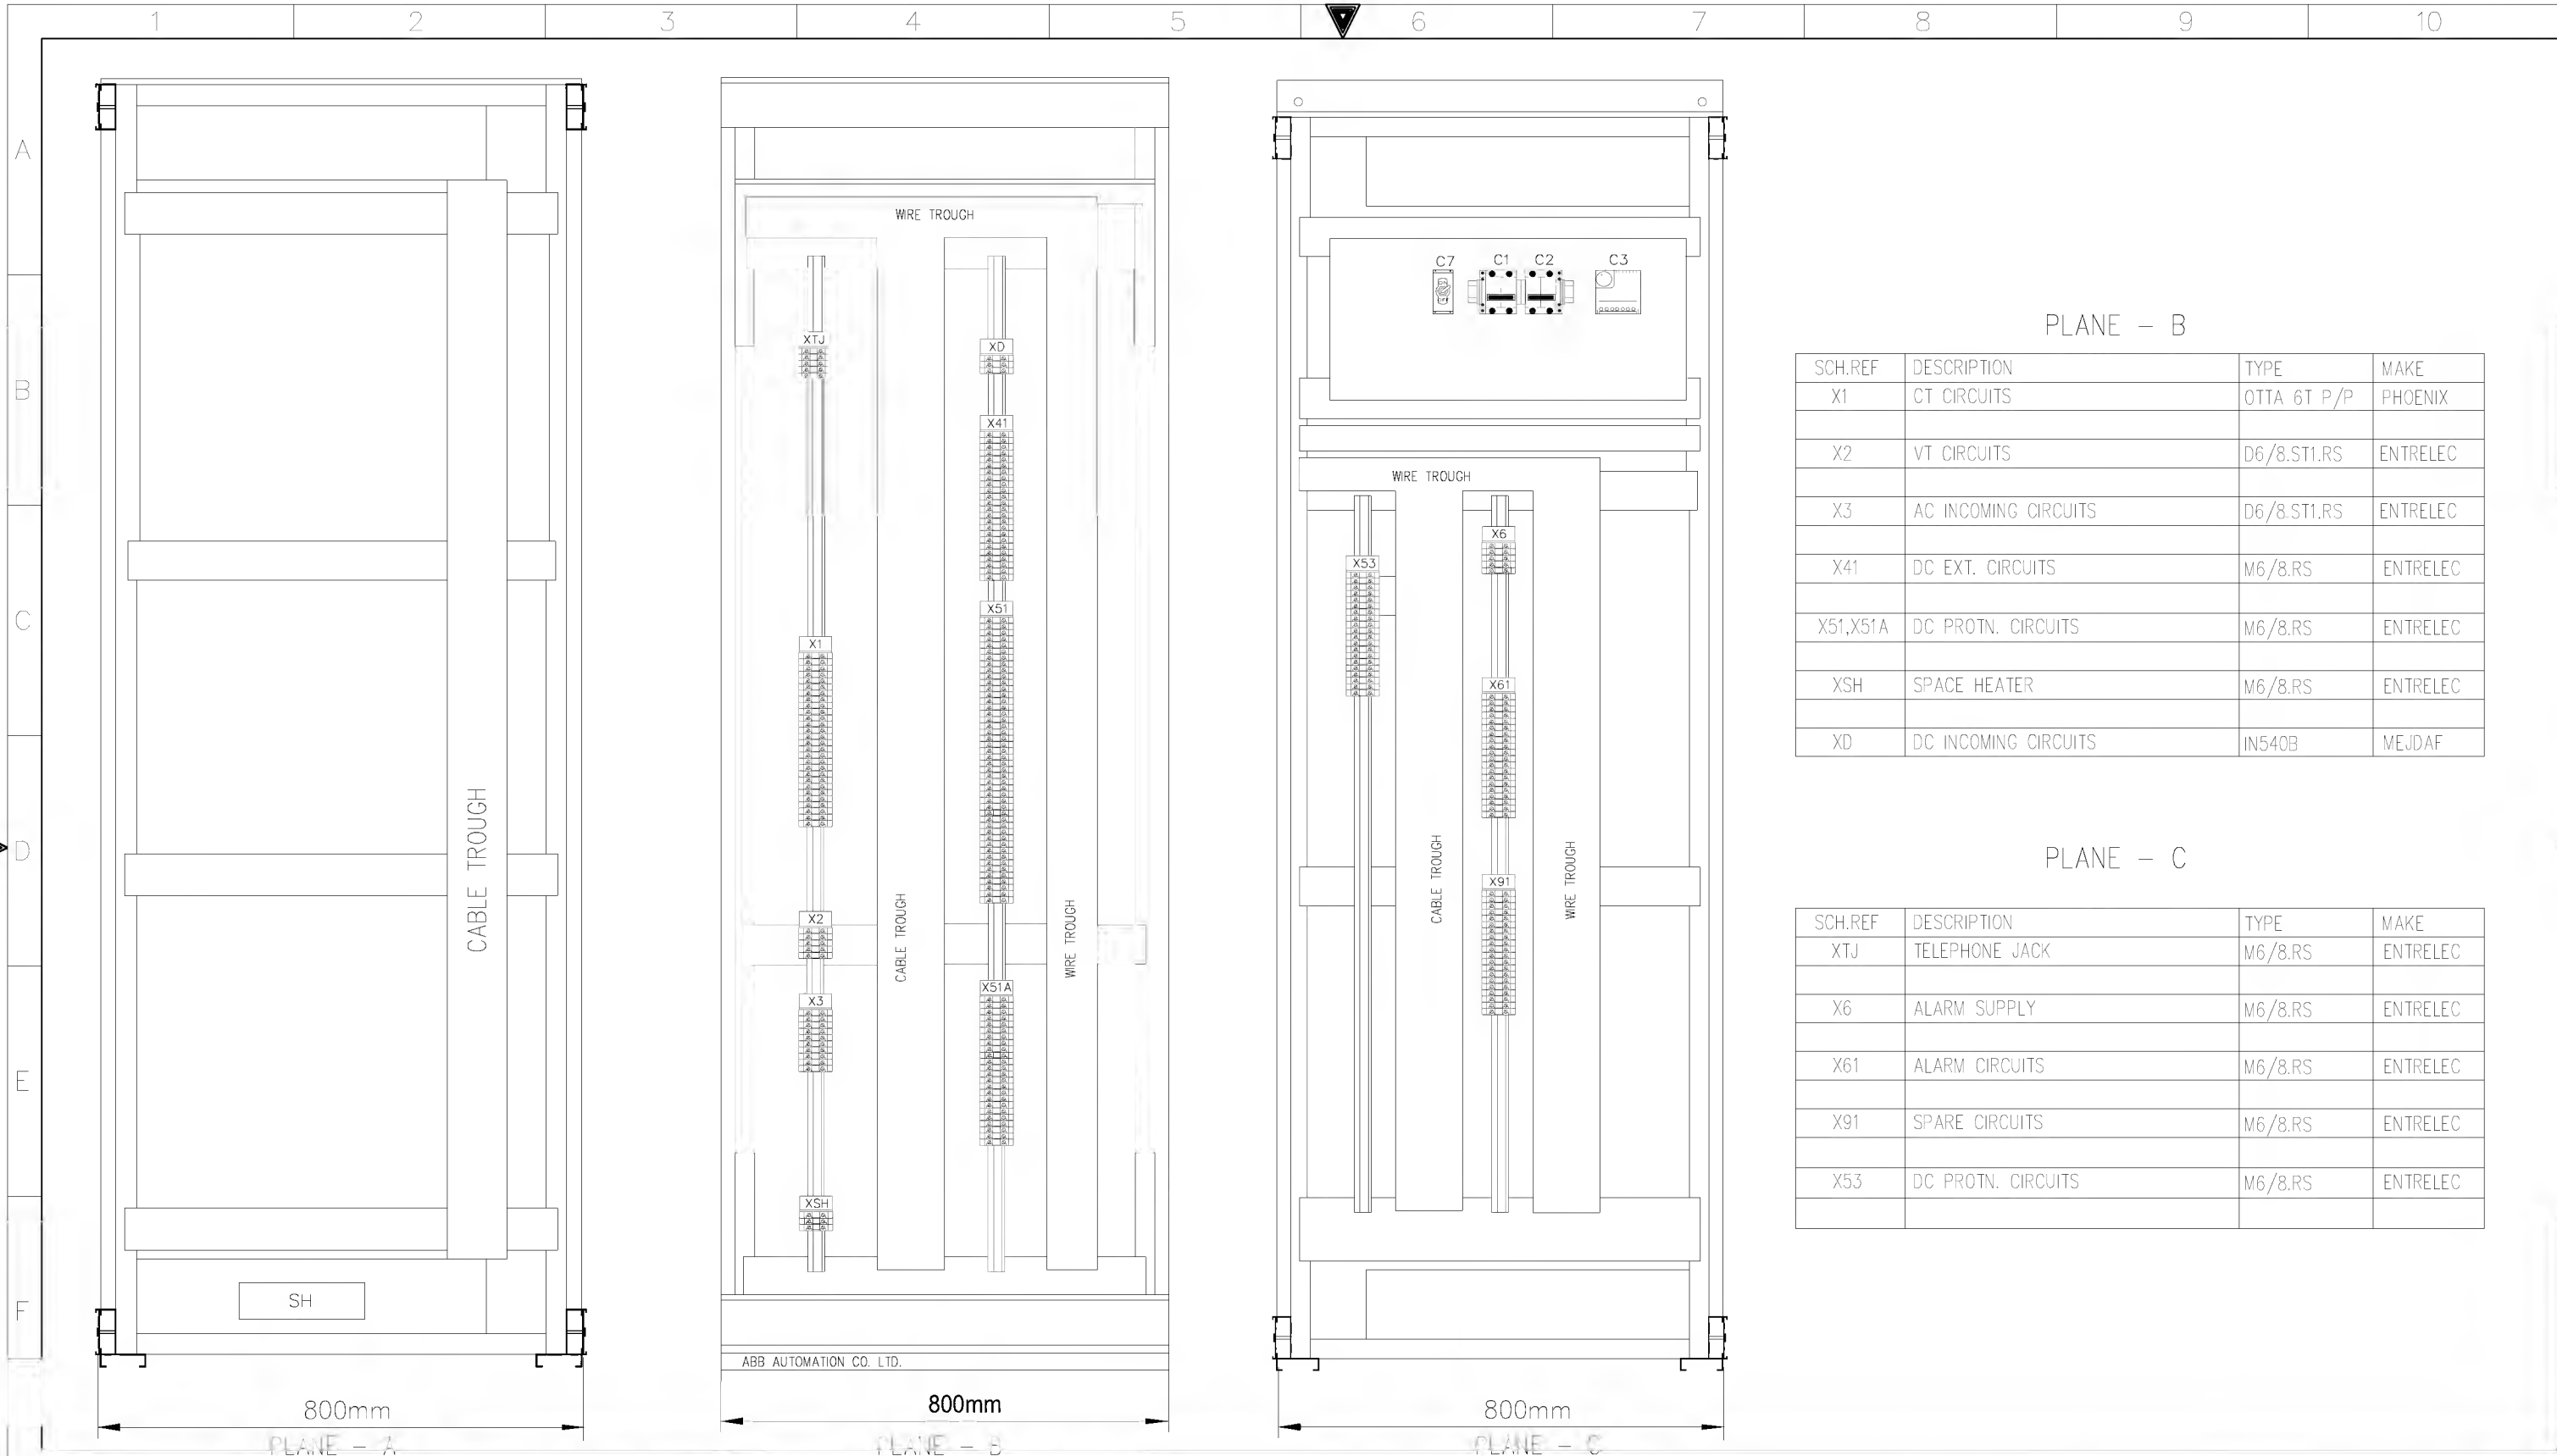


PLANE – B

SCH.REF	DESCRIPTION	TYPE	MAKE
X1	CT CIRCUITS	OTTA 6T P/P	PHOENIX
X2	VT CIRCUITS	D6/8.ST1.RS	ENTRELEC
X3	AC INCOMING CIRCUITS	D6/8.ST1.RS	ENTRELEC
X41	DC EXT. CIRCUITS	M6/8.RS	ENTRELEC
X51,X51A	DC PROTN. CIRCUITS	M6/8.RS	ENTRELEC
XSH	SPACE HEATER	M6/8.RS	ENTRELEC
XD	DC INCOMING CIRCUITS	IN540B	MEJDAF

PLANE – C

SCH.REF	DESCRIPTION	TYPE	MAKE
XTJ	TELEPHONE JACK	M6/8.RS	ENTRELEC
X6	ALARM SUPPLY	M6/8.RS	ENTRELEC
X61	ALARM CIRCUITS	M6/8.RS	ENTRELEC
X91	SPARE CIRCUITS	M6/8.RS	ENTRELEC
X53	DC PROTN. CIRCUITS	M6/8.RS	ENTRELEC

G	AS-BUILT BY _____ DATE _____		CONTRACT NO. 11131113/00		JOB ORDER NO. S-13656		ASSEMBLY DRAWING		<div>نقل الكهرباء</div> <div>National Grid sa</div> <div>الشركة الوطنية لنقل الكهرباء</div>				
	01	13 49	FACTORY ASBUILT		DRAWN BY RIZ CHECKED BY JKR		132/13.8kV GT-3 RELAY PANEL-1 +R04.1						
	00	13 04	FOR APPROVAL		DATE STARTED 24.01.2013 DATE COMPLETED _____		S/S 8709-132/13.8KV IN AL-KHARJ CITY						
	REV. NO.	DATE	DESCRIPTION		OPRG. DEPT. CTPD ENG. DEPT. AUT-PSAC		RIYADH SAUDI ARABIA						
								INDEX	PLANT NO.	DRAWING NUMBER	SHEET NO.		REV. NO.
								-	C421	CD322932	SHT	CONT.	01
											G02	G03	

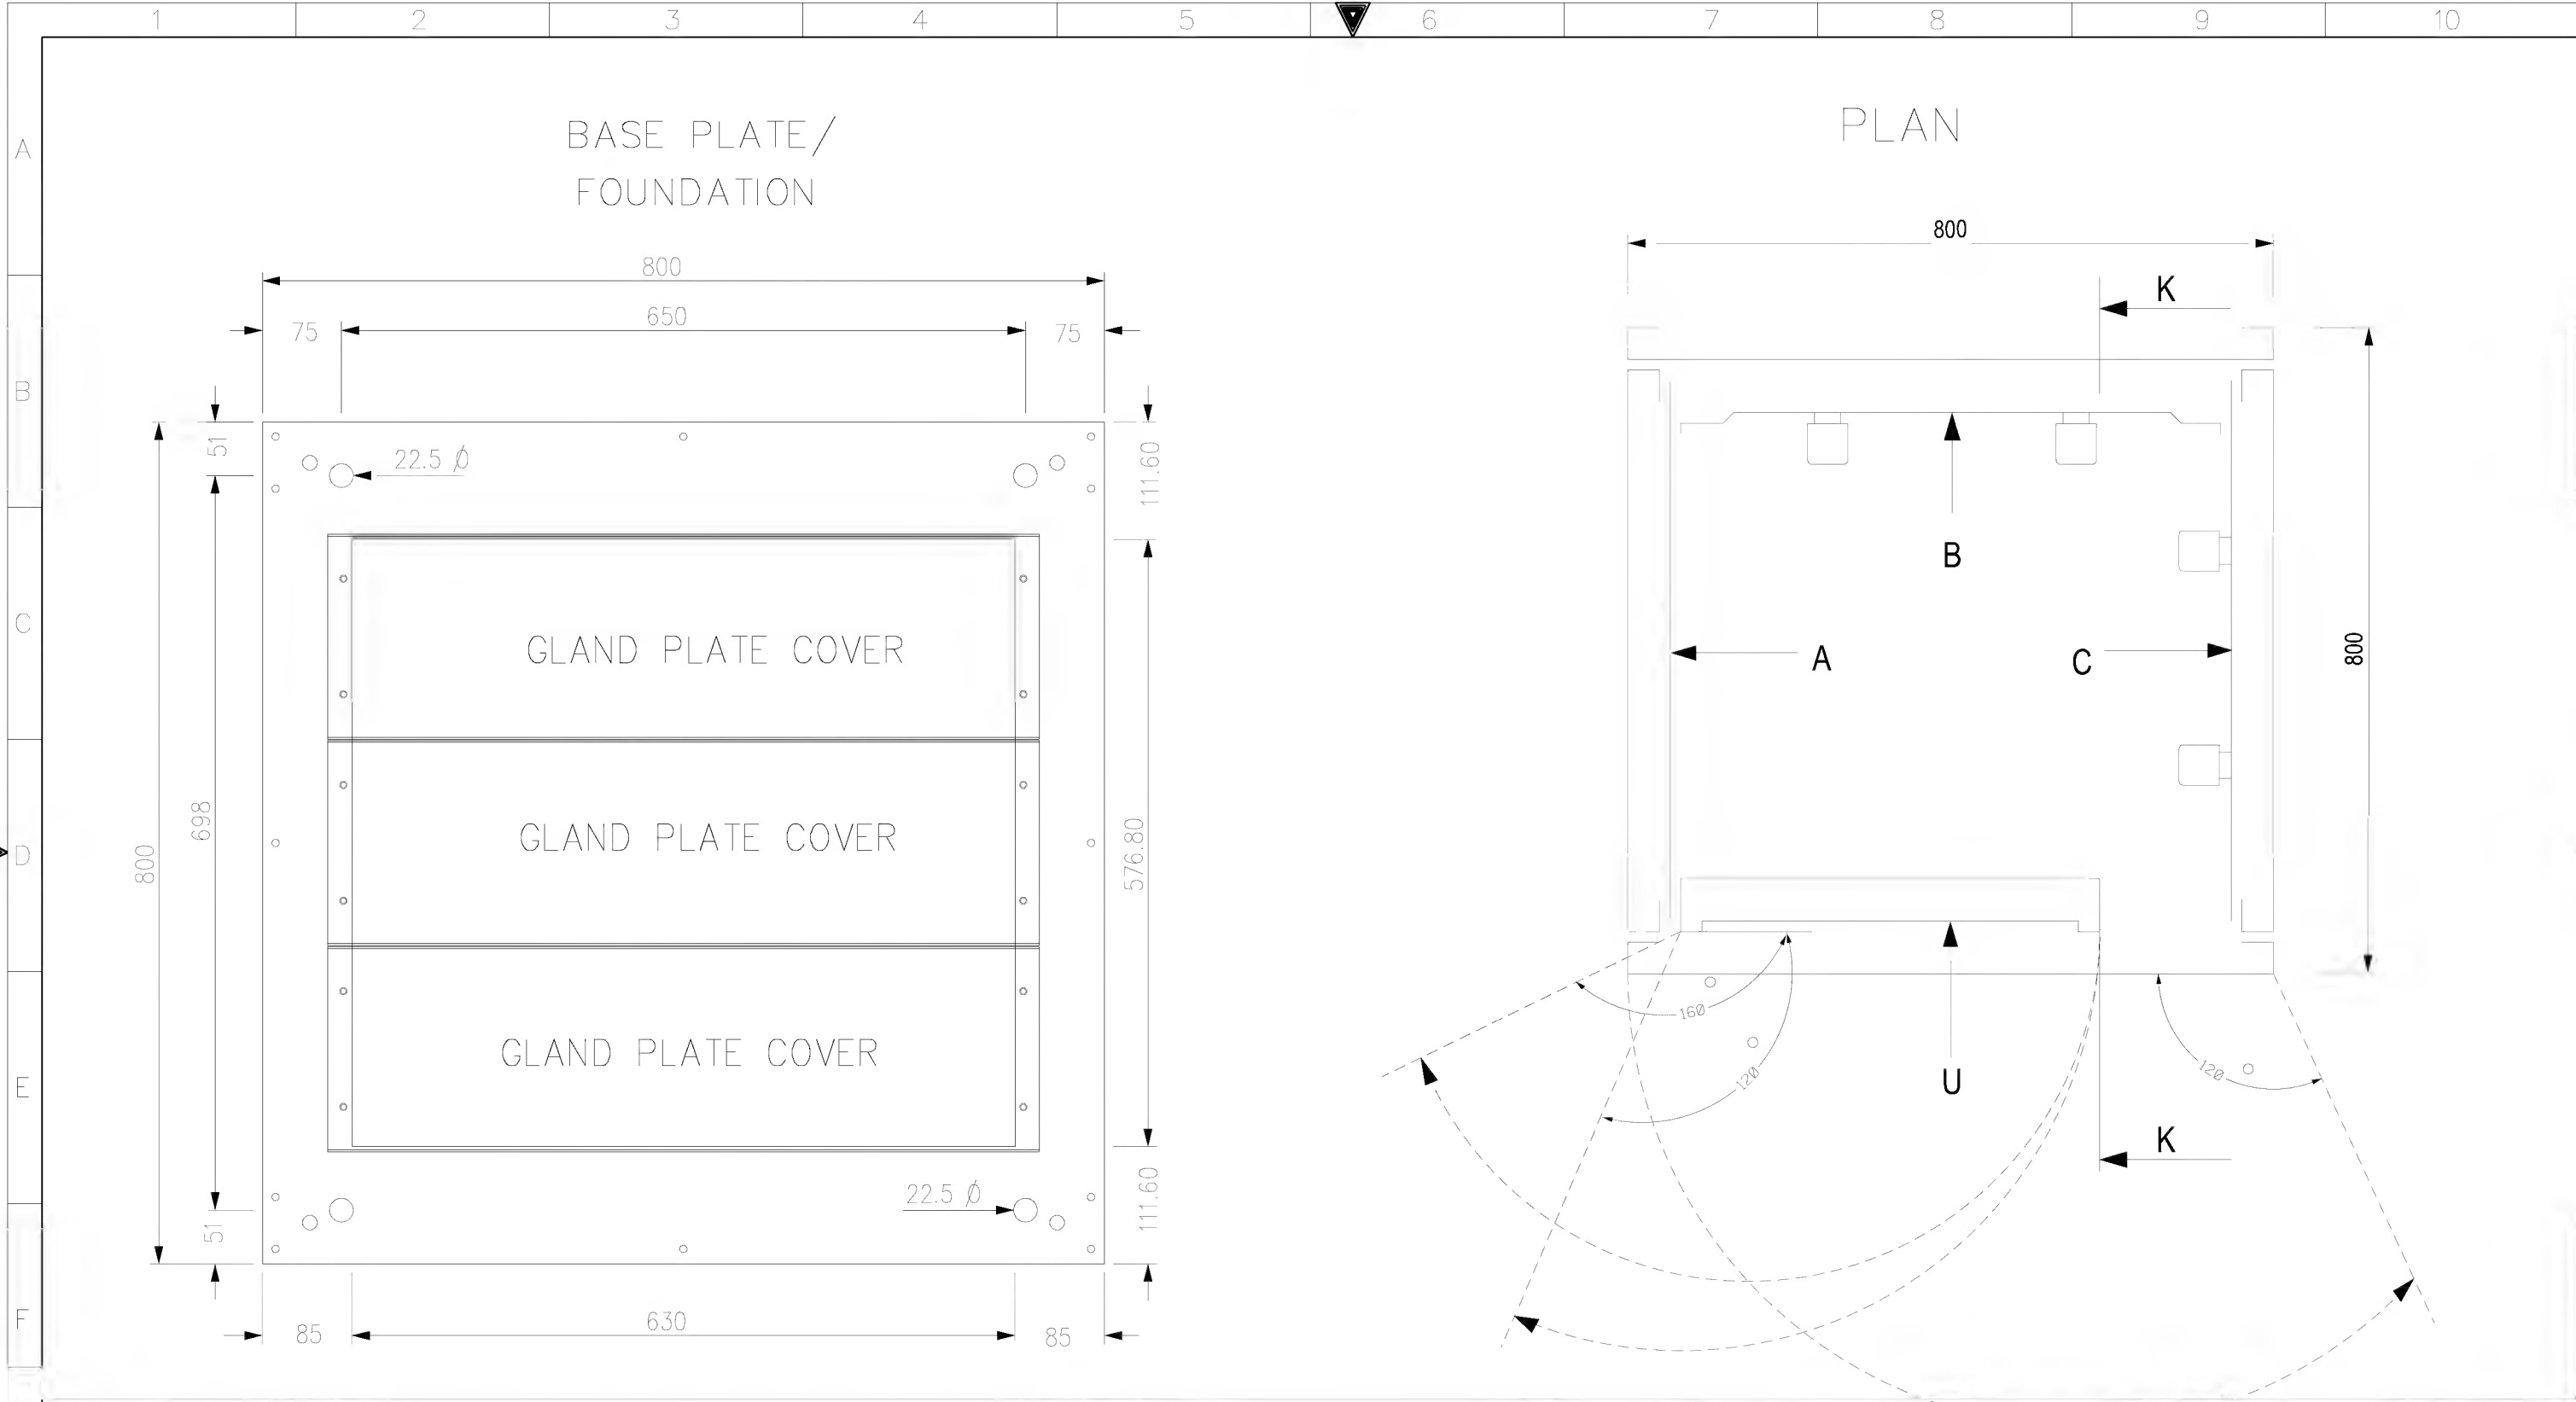

AS-BUILT BY _____ DATE _____ CONTRACT NO. 11131113/00 JOB ORDER NO. S-13656

01	13 49	FACTORY ASBUILT
00	13 04	FOR APPROVAL
REV. NO.	DATE	DESCRIPTION

DRAWN BY	RIZ	CHECKED BY	JKR
DATE STARTED	24.01.2013	DATE COMPLETED	
OPRG. DEPT.	CTPD	ENG. DEPT.	AUT-PSAC

ASSEMBLY DRAWING
132/13.8kV GT-3 RELAY PANEL-1 +R04.1
S/S 8709-132/13.8KV IN AL-KHARJ CITY
RIYADH SAUDI ARABIA

الشركة الوطنية لنقل الكهرباء National Grid sa				
INDEX	PLANT NO.	DRAWING NUMBER	SHEET NO.	REV. NO.
-	C421	CD322932	G03G04	01

A

B

C

D


E

F



TOP VIEW FOR EARTHING BAR

U PLANE TOP LABEL

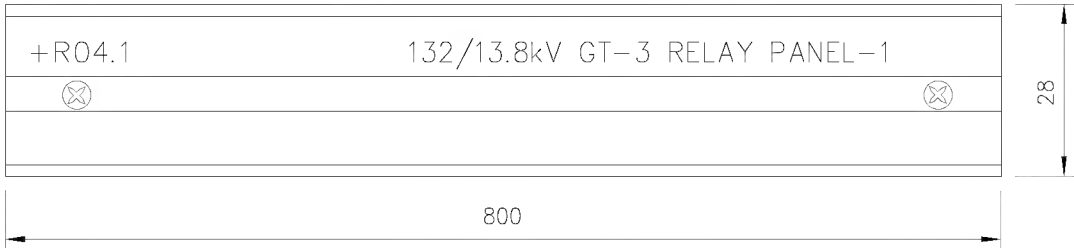

U PLANE BOTTOM LABEL



MANUFACTURING LABEL

ABB
ABB Automation Co.Ltd.

PROJECT : National Grid SA
S/S 8709

ORDER REFERENCE : 2875 RF S13656


YEAR OF MANUFACTURE: 2013


PANEL NO. : +R04.1


DRAWING NO. : S13656-CD-323934

MADE IN THE KINGDOM OF SAUDI ARABIA

G

AS-BUILT BY _____ DATE _____			CONTRACT NO. 11131113/00		JOB ORDER NO. S-13656		ASSEMBLY DRAWING		<div>الشركة الوطنية لنقل الكهرباء</div> <div> نقل الكهرباء National Grid sa</div>						
01	13 49	FACTORY ASBUILT	DRAWN BY RIZ		CHECKED BY JKR		132/13.8kV GT-3 RELAY PANEL-1 +R04.1		INDEX	PLANT NO.	DRAWING NUMBER		SHEET NO.		REV. NO.
00	13 04	FOR APPROVAL	DATE STARTED 24.01.2013		DATE COMPLETED _____		S/S 8709-132/13.8KV IN AL-KHARJ CITY		-	C421	CD322932		SHT	CONT.	01
REV. NO.	DATE	DESCRIPTION	OPRG. DEPT. CTPD		ENG. DEPT. AUT-PSAC		RIYADH SAUDI ARABIA						G04	L00	

	1	2	3	4	5	6	7	8	9	10
A			POWER SYSTEMS NETWORK MANAGEMENT PROTECTION AND SUBSTATION AUTOMATION SYSTEMS WBS NO: S-13656					ABB AUTOMATION COMPANY LTD., 414, AL-KHARJ ROAD SECOND INDUSTRIAL CITY RIYADH-11383 K.S.A		
B										
C	CONTRACTOR : ABB Contracting Company									
	CLIENT : National Gridsa									
D	PROJECT : CONSTRUCTION OF NEW 132/13.8kV SS 8709 IN AL-KHARJ CITY									
	SUBSTATION : S/S 8709									
E	CONTRACT NO. : 11131113/00									
F	TITLE : LIST OF APPARATUS +R04.1 [GT-3]									


G	AS-BUILT BY _____ DATE _____		CONTRACT NO. 11131113/00	JOB ORDER NO. S-13656	COVER SHEET		 نقل الكهرباء الشركة الوطنية لنقل الكهرباء National Grid sa				
	01	13 49	FACTORY ASBUILT	DRAWN BY RIZ	CHECKED BY JKR	132/13.8kV GT-3 RELAY PANEL-1 +R04.1	INDEX	PLANT NO.	DRAWING NUMBER	SHEET NO.	REV. NO.
	00	13 04	FOR APPROVAL	DATE STARTED 24.01.2013	DATE COMPLETED	S/S 8709-132/13.8KV IN AL-KHARJ CITY	-	C421	CD322932	SHT L00	CONT. L01
	REV. NO.	DATE	DESCRIPTION	OPRG. DEPT. CTPD	ENG. DEPT. AUT-PSAC	RIYADH SAUDI ARABIA					01

	1	2	3	4	5	6	7	8	9	10
A										
B										
C										
D										
E										
F										

SR. NO.	GA REF.	SCH. REF.	D E S C R I P T I O N	SHEET NO.	QTY.	TYPE	MAKE	ORDERING INFORMATION
			RELAY CUBICLE- +R04.1 ACCOMODATING THE FOLLOWING					
1	U05.5001	87T-1	NUMERICAL TRANSFORMER PROTECTION IED WITH FOLLOWING DETAILS	301	1	RET 670*1	ABB	1MRK 004 816-DC
			FUNCTIONS					
			-CONFIGURATION ALTERNATIVE		1			1MRK 004 005-DC
			DOUBLE BREAKER, 3WINDING (B40) BASIC					
			-CONTROL					
			HARDWARE					
			-ANALOG SYSTEM					
			TRANSFORMER INPUT MODULE,RING LUG TERMINALS 91+3U,1A					
			110/220/V,50/60HZ/(TRM)(BASIC SELECTED ALTERNATIVE)LOCATION/P40/					
			TRANSFORMER INPUT MODULE,RING LUG TERMINALS 91+3U,1A					
			110/220/V,50/60HZ/(TRM)(BASIC SELECTED ALTERNATIVE)LOCATION/P41/					
			-CASING					
			POWER SUPPLY MODULE 90-250 VDC (PSM)					
			LOCATION P1/					
			NUMERIC PROCESSING MODULE 600MHZ, 256MB (NUM) BASIC					
			LOCATION/P30/					
			3/4\ SX 19" RACK CASING MAX 5 I/O MOD,					
			2TRM (RACK)					
			COMBINED BACKPLANE MODULE MAX 5 I/O MOD.					
			(BASIC SELECTED ALTERNATIVE) 2TRM (RACK)					
			UNIVERSAL BACKPLANE MODULE 2 ADM,2TRM (UBM) BASIC					
			-CONNECTION TYPE					
			STANDARD COMPRESSION CONNECTION TERMINALS)					
			LOCATION/P1-P16					
			-HUMAN MACHINE INTERFACE					
			MEDIUM GRAPHIC HMI,15 CONTROLLABLE OBJECTS					
			3/4 X 19"IEC (MHMI)					
			-IN/OUT MODULES					
			BINARY INPUT MODULE LOCATION P3,P5		2			1MRK 000 508-BB
			BINARY OUTPUT MODULE,24 OUTPUT RELAYS (BOM)		2			1MRK 000 614-AB
			LOCATION P4					
			OPTICAL ETHERNET MODULE 2 GLASS INTERFACE IEC61850-8-1/IEC61850-9-2					1MRK 002 266-AA
			(OEM)(SELECTED OPTION) LOCATION P31:1					
2	U12.101	TS-1	TEST SWITCH FOR RET670 RELAY	222	1	RTXP18	ABB	RK 926 115-BH
	U12.113	TS-2	TEST SWITCH FOR RET670 RELAY	222	1	RTXP18	ABB	RK 926 115-BB

AS-BUILT BY _____ DATE _____			CONTRACT NO. 11131113/00		JOB ORDER NO. S-13656		LIST OF APPARATUS		<div>الشركة الوطنية لنقل الكهرباء National Grid sa</div>	
DRAWN BY _____ RIZ _____ CHECKED BY _____ JKR			DATE STARTED 24.01.2013		DATE COMPLETED _____		132/13.8kV GT-3 RELAY PANEL-1 +R04.1			
01 13 49 FACTORY ASBUILT			DATE STARTED 24.01.2013		DATE COMPLETED _____		S/S 8709-132/13.8KV IN AL-KHARJ CITY		INDEX PLANT NO. DRAWING NUMBER SHEET NO. REV. NO.	
00 13 04 FOR APPROVAL			OPRG. DEPT. _____ CTPD _____		ENG. DEPT. _____ AUT-PSAC _____		RIYADH SAUDI ARABIA		- C421 CD322932 L01 L02 01	
REV. NO. DATE DESCRIPTION									NG/D2-D (2012/01) DMS VECTOR NGD200	

	1	2	3	4	5	6	7	8	9	10
A	SR. NO.	GA REF.	SGH. REF.	D E S C R I P T I O N		SHEET. NO.	QTY.	TYPE	MAKE	ORDERING INFORMATION
	22		X1	BLOT CONNECTING TERMINAL BLOCKS DISCONNECTIBLE FOR CT CIRCUITS		304	60	OTTA 6T P/P	PHOENIX	0790462
			X2	SPRING LOADED TERMINAL BLOCKS DISCONNECTIBLE FOR VT CIRCUITS		304	5	D6/8.ST1.RS	ENTRELEC	1SNA 115 831 R0400
B			X3	SPRING LOADED TERMINAL BLOCKS DISCONNECTIBLE FOR AC CIRCUITS		304	10	D6/8.ST1.RS	ENTRELEC	1SNA 115 831 R0400
			X41	SPRING LOADED TERMINAL BLOCK FOR DC EXT. CIRCUITS		304	40	D6/8.ST1.RS	ENTRELEC	1SNA 115 831 R0400
			X51	SPRING LOADED TERMINAL BLOCK FOR DC PROTN. CIRCUITS		304	97	M6/8.RS	ENTRELEC	1SNA 115 685 R1200
			X6	SPRING LOADED TERMINAL BLOCK FOR STN COM		304	10	M6/8.RS	ENTRELEC	1SNA 115 685 R1200
			X61	KNIFE TYPE TERMINAL BLOCKS DISCONNECTIBLE FOR STN.-COM ALARM CIRCUITS		304	20	M6/8.SNB	ENTRELEC	1SNA 115 688 R2500
C			XTJ	SPRING LOADED TERMINAL BLOCK KNIFE TYPE FOR TELEPHONE JACK		305	5	M6/8.RS	ENTRELEC	1SNA 115 685 R1200
			XSH	SPRING LOADED TERMINAL BLOCKS FOR SPACE HEATER		305	3	M6/8.RS	ENTRELEC	1SNA 115 685 R1200
			XD	TERMINAL BLOCKS WITH BLOCKING DIODE, Vrrm=1kV, If=3A AND SURGE TRAP, ENERGY ABSORPTION RATING 8J (10/1000mS)		236,276	3	N4/6.S IN5408 V150ZA1	ENTRELEC MEJDAF RS	11521310 02-049 239-270
			X9	SPRING LOADED TERMINAL BLOCK KNIFE TYPE FOR SPARE CONTACTS		295	20	M6/8.RS	ENTRELEC	1SNA 115 685 R1200
			X51A	SPRING LOADED TERMINAL BLOCK FOR DC PROTN. CIRCUITS		304	15	M6/8.RS	ENTRELEC	1SNA 115 685 R1200
D			X53	SPRING LOADED TERMINAL BLOCK FOR DC PROTN. CIRCUITS		304	32	M6/8.RS	ENTRELEC	1SNA 115 685 R1200
E										
F										

AS-BUILT BY _____ DATE _____			CONTRACT NO. 11131113/00		JOB ORDER NO. S-13656		LIST OF APPARATUS			<div>نقل الكهرباء الشركة الوطنية لنقل الكهرباء National Grid sa</div> 						
			DRAWN BY RIZ CHECKED BY JKR			132/13.8kV GT-3 RELAY PANEL-1 +R04.1										
01	13 49	FACTORY ASBUILT		DATE STARTED 24.01.2013 DATE COMPLETED _____			S/S 8709-132/13.8KV IN AL-KHARJ CITY			INDEX	PLANT NO.	DRAWING NUMBER		SHEET NO.		REV. NO.
00	13 04	FOR APPROVAL		OPRG. DEPT. CTPD ENG. DEPT. AUT-PSAC			RIYADH SAUDI ARABIA			-	C421	CD322932		SHT L05 CONT. L06		01

	1	2	3	4	5	6	7	8	9	10
A										
B										
C										
D										
E										
F										


LABEL REF.	LABEL ENGRAVING	MATERIALS	ENGRAVING	LABEL SIZE	LETTER SIZE
U05.5001	U05.5001 87T1	TRAFOLITE	BLACK LETTERS ON WHITE BACKGROUND	50X15mm	4mm
U12.101	U12.101 TS-1	ALUMINUM PAPER FOIL	BLACK LETTERS	50X10mm	3mm
U12.113	U12.113 TS-2	ALUMINUM PAPER FOIL	BLACK LETTERS	50X10mm	3mm
U16.5001	U16.5001 S86T1	TRAFOLITE	BLACK LETTERS ON WHITE BACKGROUND	50X15mm	4mm
U16.5002	U16.5002 S86CBF	TRAFOLITE	BLACK LETTERS ON WHITE BACKGROUND	50X15mm	4mm
U16.5003	U16.5003 S86B-1	TRAFOLITE	BLACK LETTERS ON WHITE BACKGROUND	50X15mm	4mm
U16.5004	U16.5004 S86B-2	TRAFOLITE	BLACK LETTERS ON WHITE BACKGROUND	50X15mm	4mm
U25.5001	U25.5001 86T1	TRAFOLITE	BLACK LETTERS ON WHITE BACKGROUND	50X15mm	4mm
U25.5002	U25.5002 94T1	TRAFOLITE	BLACK LETTERS ON WHITE BACKGROUND	50X15mm	4mm
U25.5003	U25.5003 86CBF	TRAFOLITE	BLACK LETTERS ON WHITE BACKGROUND	50X15mm	4mm
U25.5004	U25.5004 86B-1	TRAFOLITE	BLACK LETTERS ON WHITE BACKGROUND	50X15mm	4mm
U25.5005	U25.5005 86B-2	TRAFOLITE	BLACK LETTERS ON WHITE BACKGROUND	50X15mm	4mm
U29.101	U29.101 74R1	ALUMINUM PAPER FOIL	BLACK LETTERS	50X10mm	3mm
U29.107	U29.107 TMR/86B-1	ALUMINUM PAPER FOIL	BLACK LETTERS	50X10mm	3mm
U29.301	U29.301 TMR/86B-2	ALUMINUM PAPER FOIL	BLACK LETTERS	50X10mm	3mm
U29.307	U29.307 R2	ALUMINUM PAPER FOIL	BLACK LETTERS	50X10mm	3mm
U29.113	U29.113 R1	ALUMINUM PAPER FOIL	BLACK LETTERS	50X10mm	3mm
U39.5001	U39.5001 Q1	ALUMINUM PAPER FOIL	BLACK LETTERS	50X10mm	3mm
U39.5002	U39.5002 Q2	ALUMINUM PAPER FOIL	BLACK LETTERS	50X10mm	3mm
U36.5001	U36.5001 Q3	ALUMINUM PAPER FOIL	BLACK LETTERS	50X10mm	3mm


G	AS-BUILT BY _____ DATE _____		CONTRACT NO. 11131113/00		JOB ORDER NO. S-13656		LIST OF APPARATUS		الشركة الوطنية لنقل الكهرباء نقل الكهرباء National Grid sa							
	01	13 49	FACTORY ASBUILT		DRAWN BY RIZ CHECKED BY JKR		132/13.8kV GT-2 RELAY PANEL-1 +R01.1		INDEX		PLANT NO.	DRAWING NUMBER		SHEET NO.		REV. NO.
	00	13 04	FOR APPROVAL		DATE STARTED 24.01.2013 DATE COMPLETED _____		S/S 8709-132/13.8KV IN AL-KHARJ CITY							SHT		CONT.
	REV. NO.	DATE	DESCRIPTION		OPRG. DEPT. CTPD ENG. DEPT. AUT-PSAC		RIYADH SAUDI ARABIA		-		C421	CD322932		L06		L07
																01


	1	2	3	4	5	6	7	8	9	10
A										
B										
C										
D										
E										
F										

LABEL REF.	LABEL ENGRAVING	MATERIALS	ENGRAVING	LABEL SIZE	LETTER SIZE
C1	C1 127V AC SUPPLY MCB	TRAFOLITE	BLACK LETTERS ON WHITE BACKGROUND	50X15mm	4mm
C2	C2 220V AC SUPPLY MCB	TRAFOLITE	BLACK LETTERS ON WHITE BACKGROUND	50X15mm	4mm
C3	C3 THERMOSTAT	TRAFOLITE	BLACK LETTERS ON WHITE BACKGROUND	50X15mm	4mm
C7	C7 ON/OFF SWITCH	TRAFOLITE	BLACK LETTERS ON WHITE BACKGROUND	50X15mm	4mm
DS	DS DOOR SWITCH	TRAFOLITE	BLACK LETTERS ON WHITE BACKGROUND	50X15mm	4mm
IL	IL ILLUMINATION LAMP	TRAFOLITE	BLACK LETTERS ON WHITE BACKGROUND	50X15mm	4mm
SH	SH SPACE HEATER	TRAFOLITE	BLACK LETTERS ON WHITE BACKGROUND	50X15mm	4mm

AS-BUILT BY _____ DATE _____			CONTRACT NO. 11131113/00		JOB ORDER NO. S-13656		LIST OF APPARATUS		الشركة الوطنية لنقل الكهرباء		 نقل الكهرباء National Grid sa			
G	01	13 49	FACTORY ASBUILT		DRAWN BY RIZ CHECKED BY JKR		132/13.8kV GT-3 RELAY PANEL-1 +R04.1		INDEX	PLANT NO.	DRAWING NUMBER	SHEET NO.		REV. NO.
	00	13 04	FOR APPROVAL		DATE STARTED 24.01.2013 DATE COMPLETED _____		S/S 8709-132/13.8KV IN AL-KHARJ CITY					SHT	CONT.	
	REV. NO.	DATE	DESCRIPTION		OPRG. DEPT. CTFD ENG. DEPT. AUT-PSAC		RIYADH SAUDI ARABIA					-	C421	


	1	2	3	4	5	6	7	8	9	10
A			POWER SYSTEMS NETWORK MANAGEMENT PROTECTION AND SUBSTATION AUTOMATION SYSTEMS WBS NO: S-13656					ABB AUTOMATION COMPANY LTD., 414, AL-KHARJ ROAD SECOND INDUSTRIAL CITY RIYADH-11383 K.S.A		
B										
C	CONTRACTOR : ABB Contracting Company									
	CLIENT : National Gridsa									
D	PROJECT : CONSTRUCTION OF NEW 132/13.8kV SS 8709 IN AL-KHARJ CITY									
	SUBSTATION : S/S 8709									
E	CONTRACT NO. : 11131113/00									
F	TITLE : Assembly Drawing +R04.2 [GT-3]									

G	AS-BUILT BY _____ DATE _____		CONTRACT NO. 11131113/00	JOB ORDER NO. S-13656	COVER SHEET		 نقل الكهرباء الشركة الوطنية لنقل الكهرباء National Grid sa				
	01	13 49	FACTORY ASBUILT	DRAWN BY RIZ	CHECKED BY JKR	132/13.8kV GT-3 RELAY PANEL-2 +R04.2	INDEX	PLANT NO.	DRAWING NUMBER	SHEET NO.	REV. NO.
	00	13 04	FOR APPROVAL	DATE STARTED 24.01.2013	DATE COMPLETED	S/S 8709-132/13.8KV IN AL-KHARJ CITY	-	C421	CD322933	SHT G00	CONT. G01
	REV. NO.	DATE	DESCRIPTION	OPRG. DEPT. CTPD	ENG. DEPT. AUT-PSAC	RIYADH SAUDI ARABIA					01

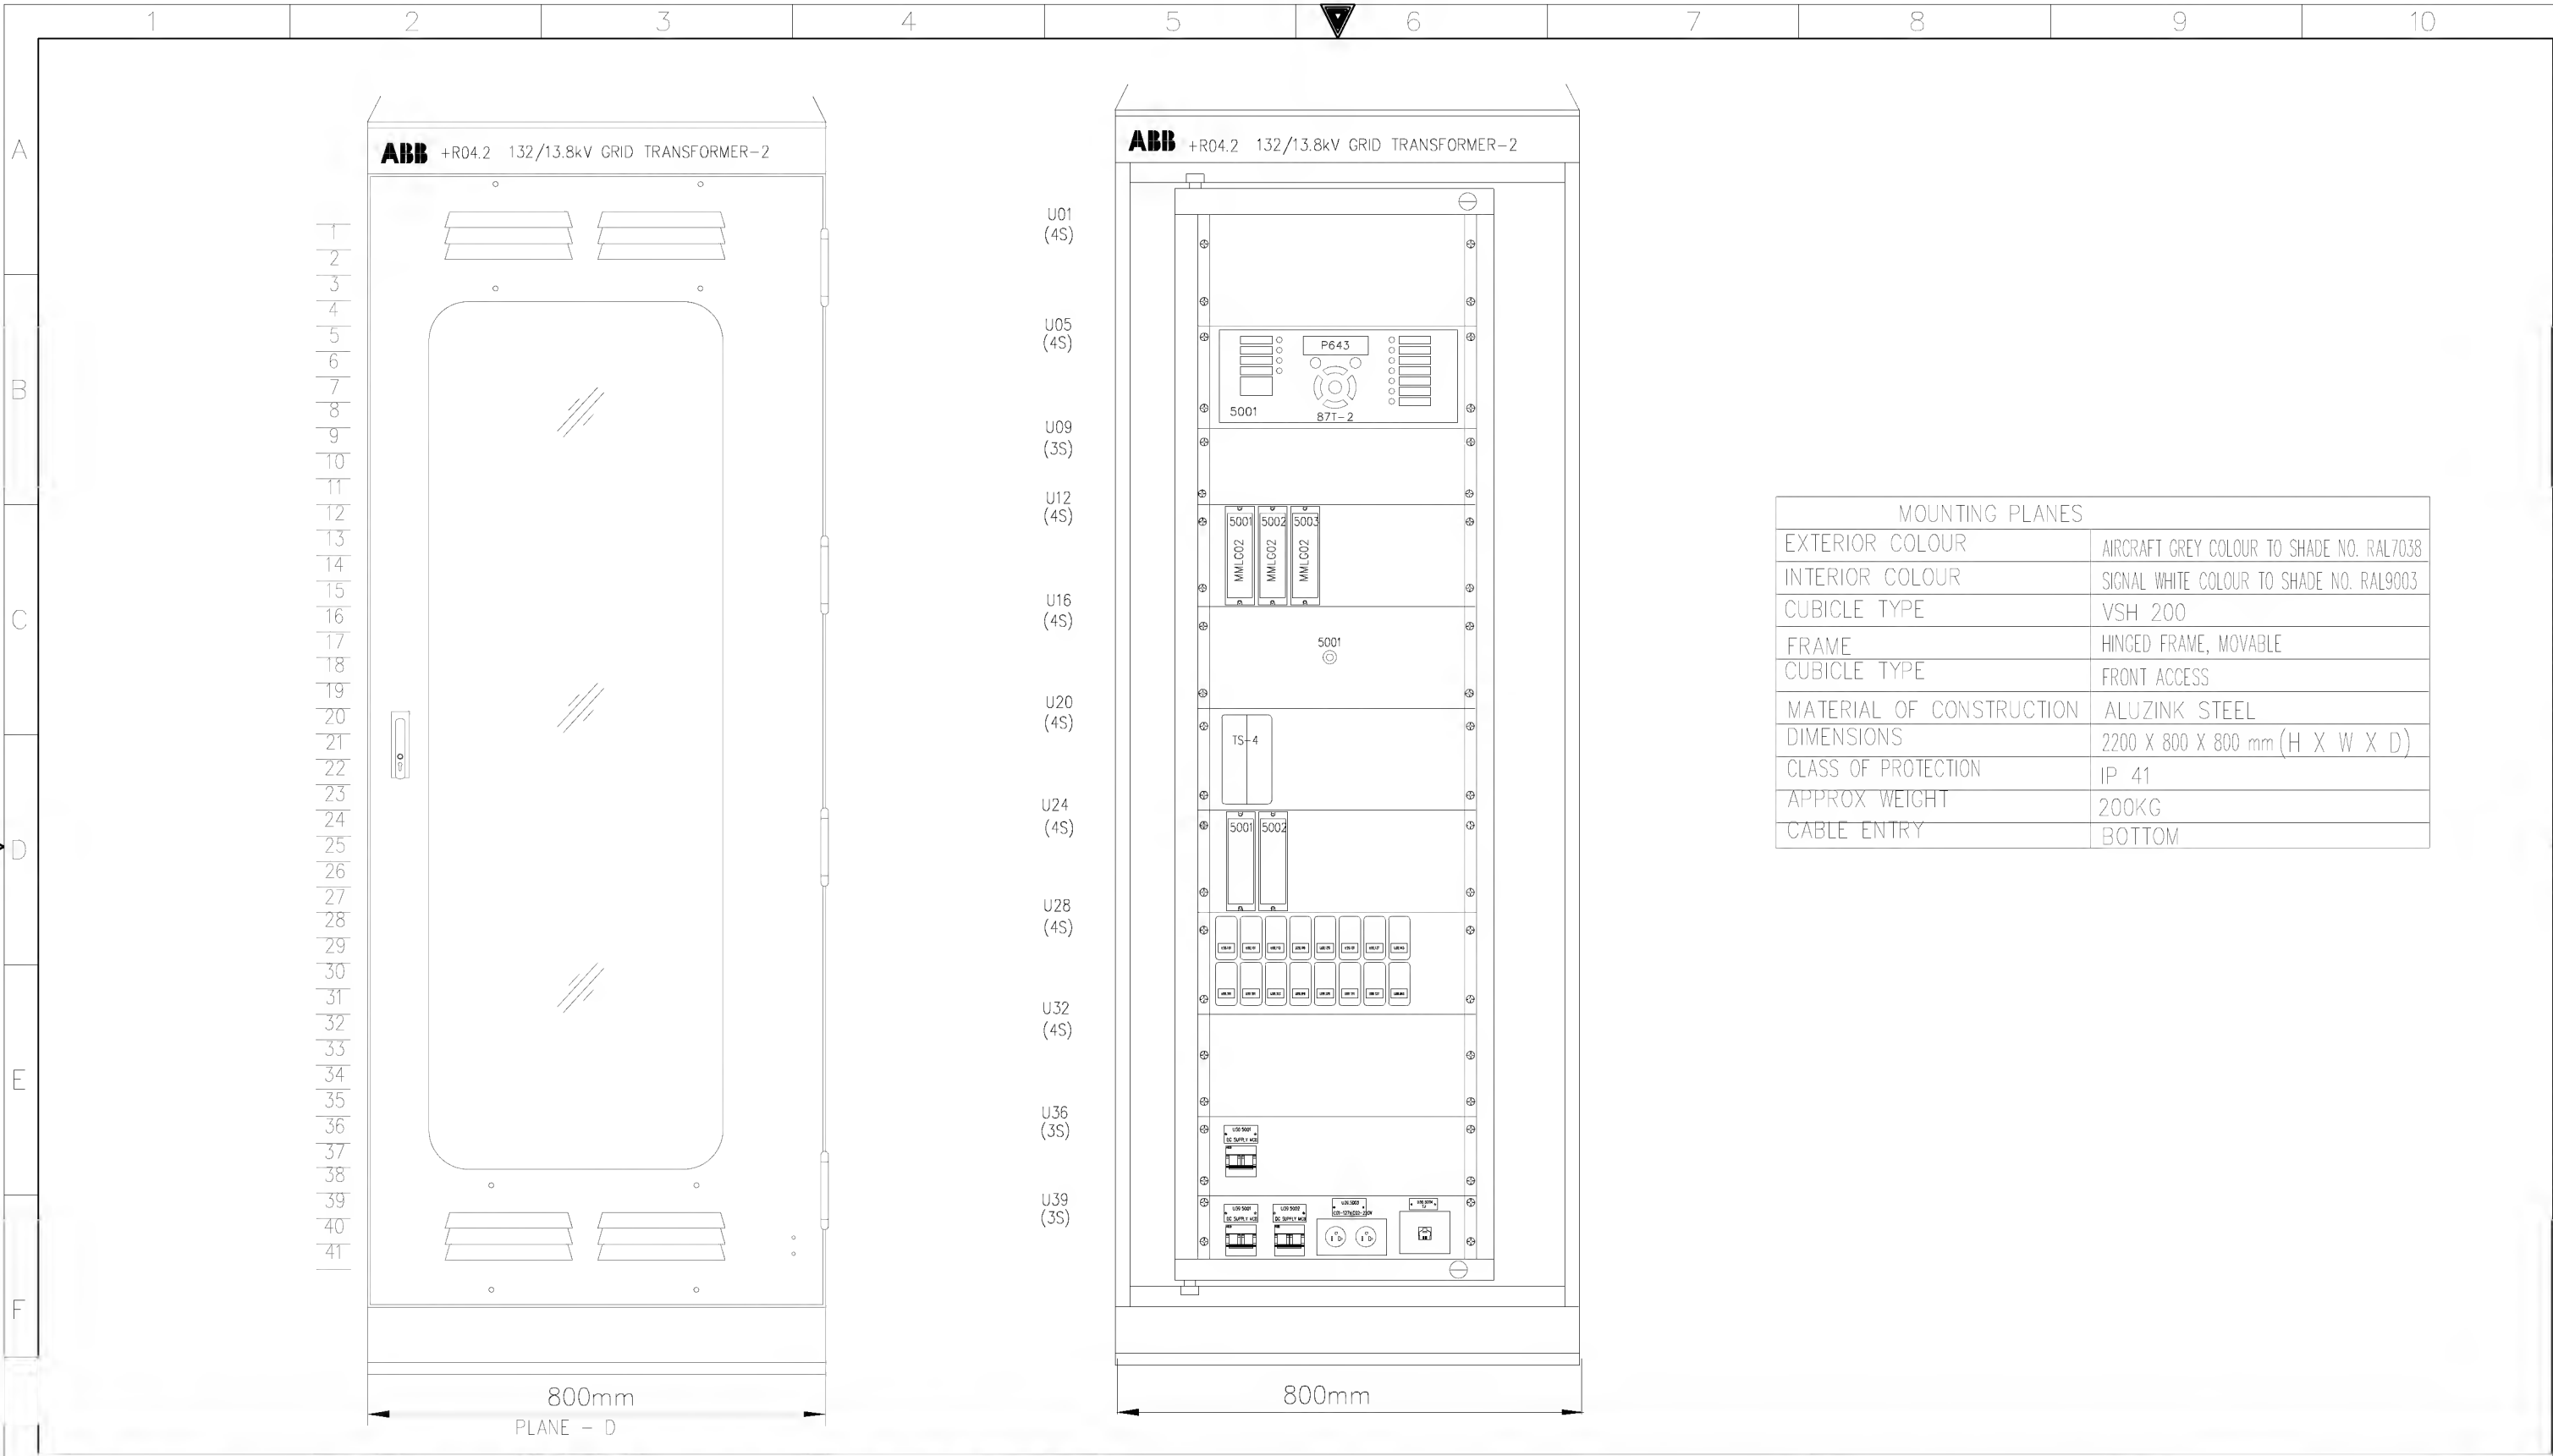

MOUNTING PLANES	
EXTERIOR COLOUR	AIRCRAFT GREY COLOUR TO SHADE NO. RAL7038
INTERIOR COLOUR	SIGNAL WHITE COLOUR TO SHADE NO. RAL9003
CUBICLE TYPE	VSH 200
FRAME	HINGED FRAME, MOVABLE
CUBICLE TYPE	FRONT ACCESS
MATERIAL OF CONSTRUCTION	ALUZINK STEEL
DIMENSIONS	2200 X 800 X 800 mm (H X W X D)
CLASS OF PROTECTION	IP 41
APPROX WEIGHT	200KG
CABLE ENTRY	BOTTOM

AS-BUILT BY _____ DATE _____			CONTRACT NO. 11131113/00		JOB ORDER NO. S-13656		ASSEMBLY DRAWING		الشركة الوطنية لنقل الكهرباء		نقل الكهرباء	
01 13 49 FACTORY ASBUILT			DRAWN BY RIZ		CHECKED BY JKR		132/13.8kV GT-3 RELAY PANEL-2 +R04.2		National Grid sa			
00 13 04 FOR APPROVAL			DATE STARTED 24.01.2013		DATE COMPLETED _____		S/S 8709-132/13.8KV IN AL-KHARJ CITY		INDEX		PLANT NO.	
REV. NO. DATE DESCRIPTION			OPRG. DEPT. CTPD		ENG. DEPT. AUT-PSAC		RIYADH SAUDI ARABIA		DRAWING NUMBER		SHEET NO.	
									- C421		CD322933	
											SHT CONT.	
											G01 G02	
											01	

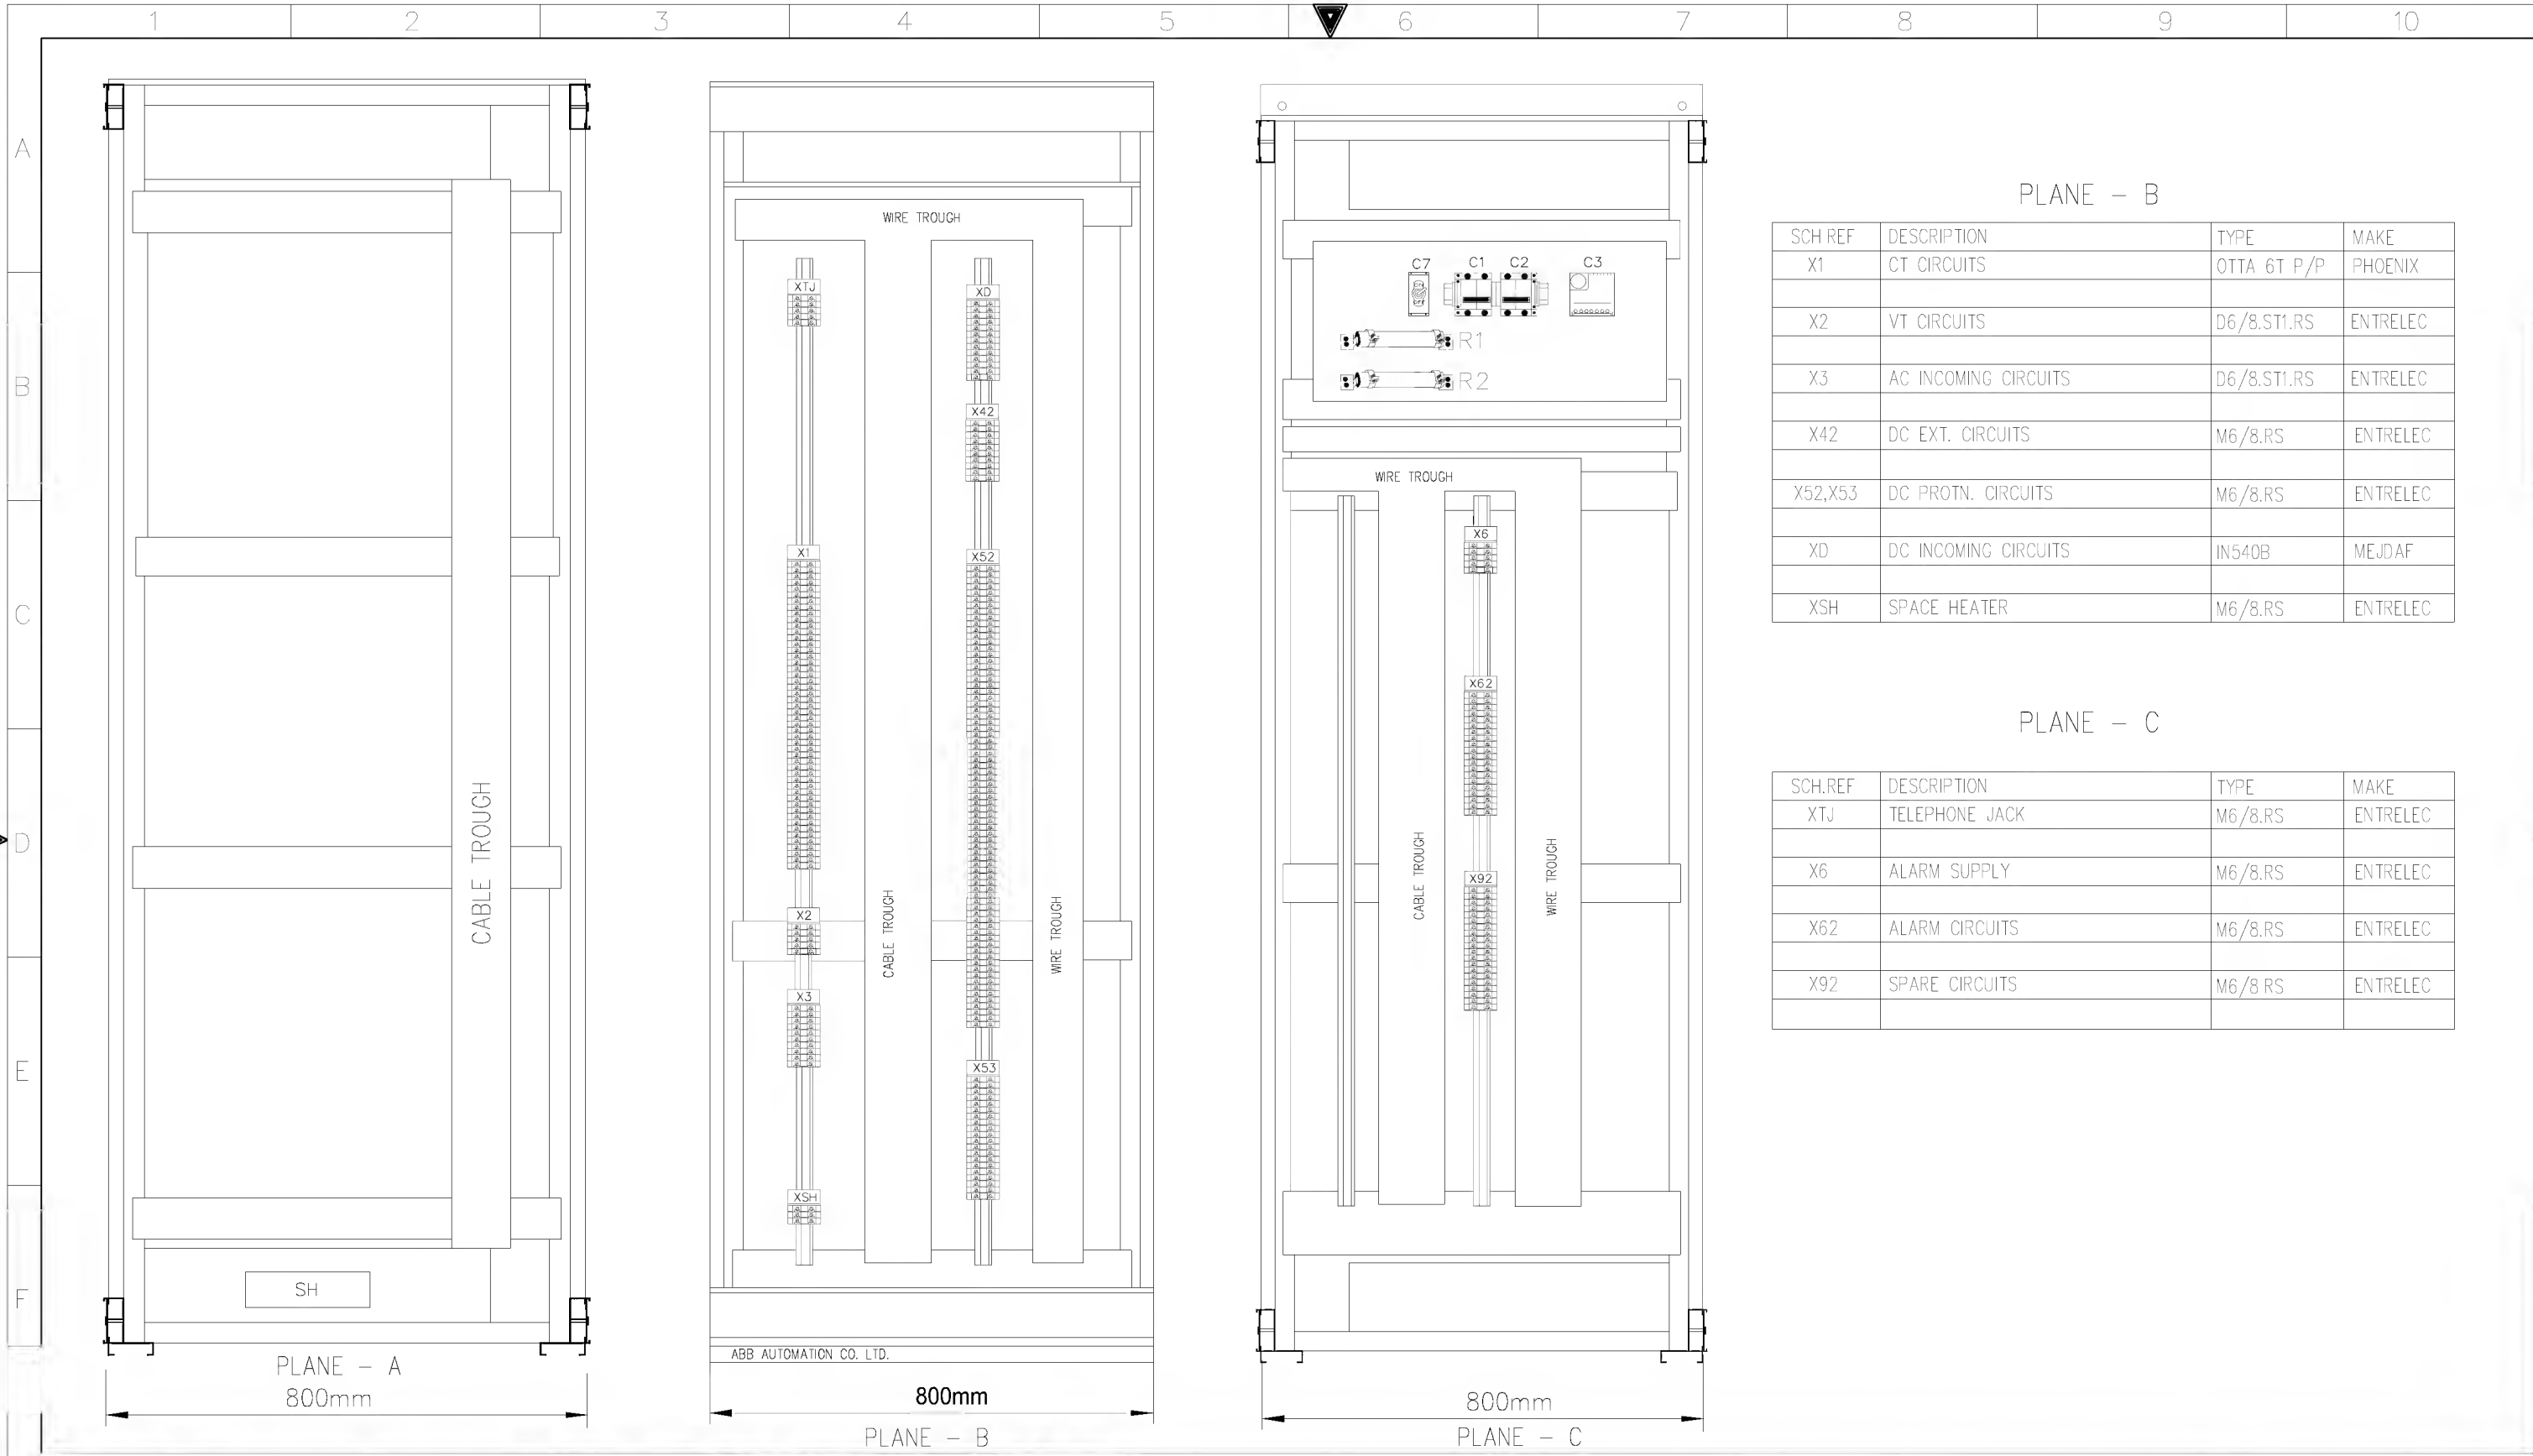

PLANE – B

SCH REF	DESCRIPTION	TYPE	MAKE
X1	CT CIRCUITS	OTTA 6T P/P	PHOENIX
X2	VT CIRCUITS	D6/8.ST1.RS	ENTRELEC
X3	AC INCOMING CIRCUITS	D6/8.ST1.RS	ENTRELEC
X42	DC EXT. CIRCUITS	M6/8.RS	ENTRELEC
X52,X53	DC PROTN. CIRCUITS	M6/8.RS	ENTRELEC
XD	DC INCOMING CIRCUITS	IN540B	MEJDAF
XSH	SPACE HEATER	M6/8.RS	ENTRELEC

PLANE – C

SCH.REF	DESCRIPTION	TYPE	MAKE
XTJ	TELEPHONE JACK	M6/8.RS	ENTRELEC
X6	ALARM SUPPLY	M6/8.RS	ENTRELEC
X62	ALARM CIRCUITS	M6/8.RS	ENTRELEC
X92	SPARE CIRCUITS	M6/8 RS	ENTRELEC

AS-BUILT BY _____ DATE _____ CONTRACT NO. 11131113/00 JOB ORDER NO. S-13656


01	13 49	FACTORY ASBUILT
00	13 04	FOR APPROVAL
REV. NO.	DATE	DESCRIPTION

DRAWN BY RIZ CHECKED BY JKR
DATE STARTED 24.01.2013 DATE COMPLETED _____
OPRG. DEPT. CTPD ENG. DEPT. AUT-PSAC

ASSEMBLY DRAWING
132/13.8kV GT-3 RELAY PANEL-2 +R04.2
S/S 8709-132/13.8KV IN AL-KHARJ CITY
RIYADH SAUDI ARABIA

الشركة الوطنية لنقل الكهرباء
National Grid sa

INDEX	PLANT NO.	DRAWING NUMBER	SHEET NO.	REV. NO.
-	C421	CD322933	SHT CONT.	01
			G02 G03	

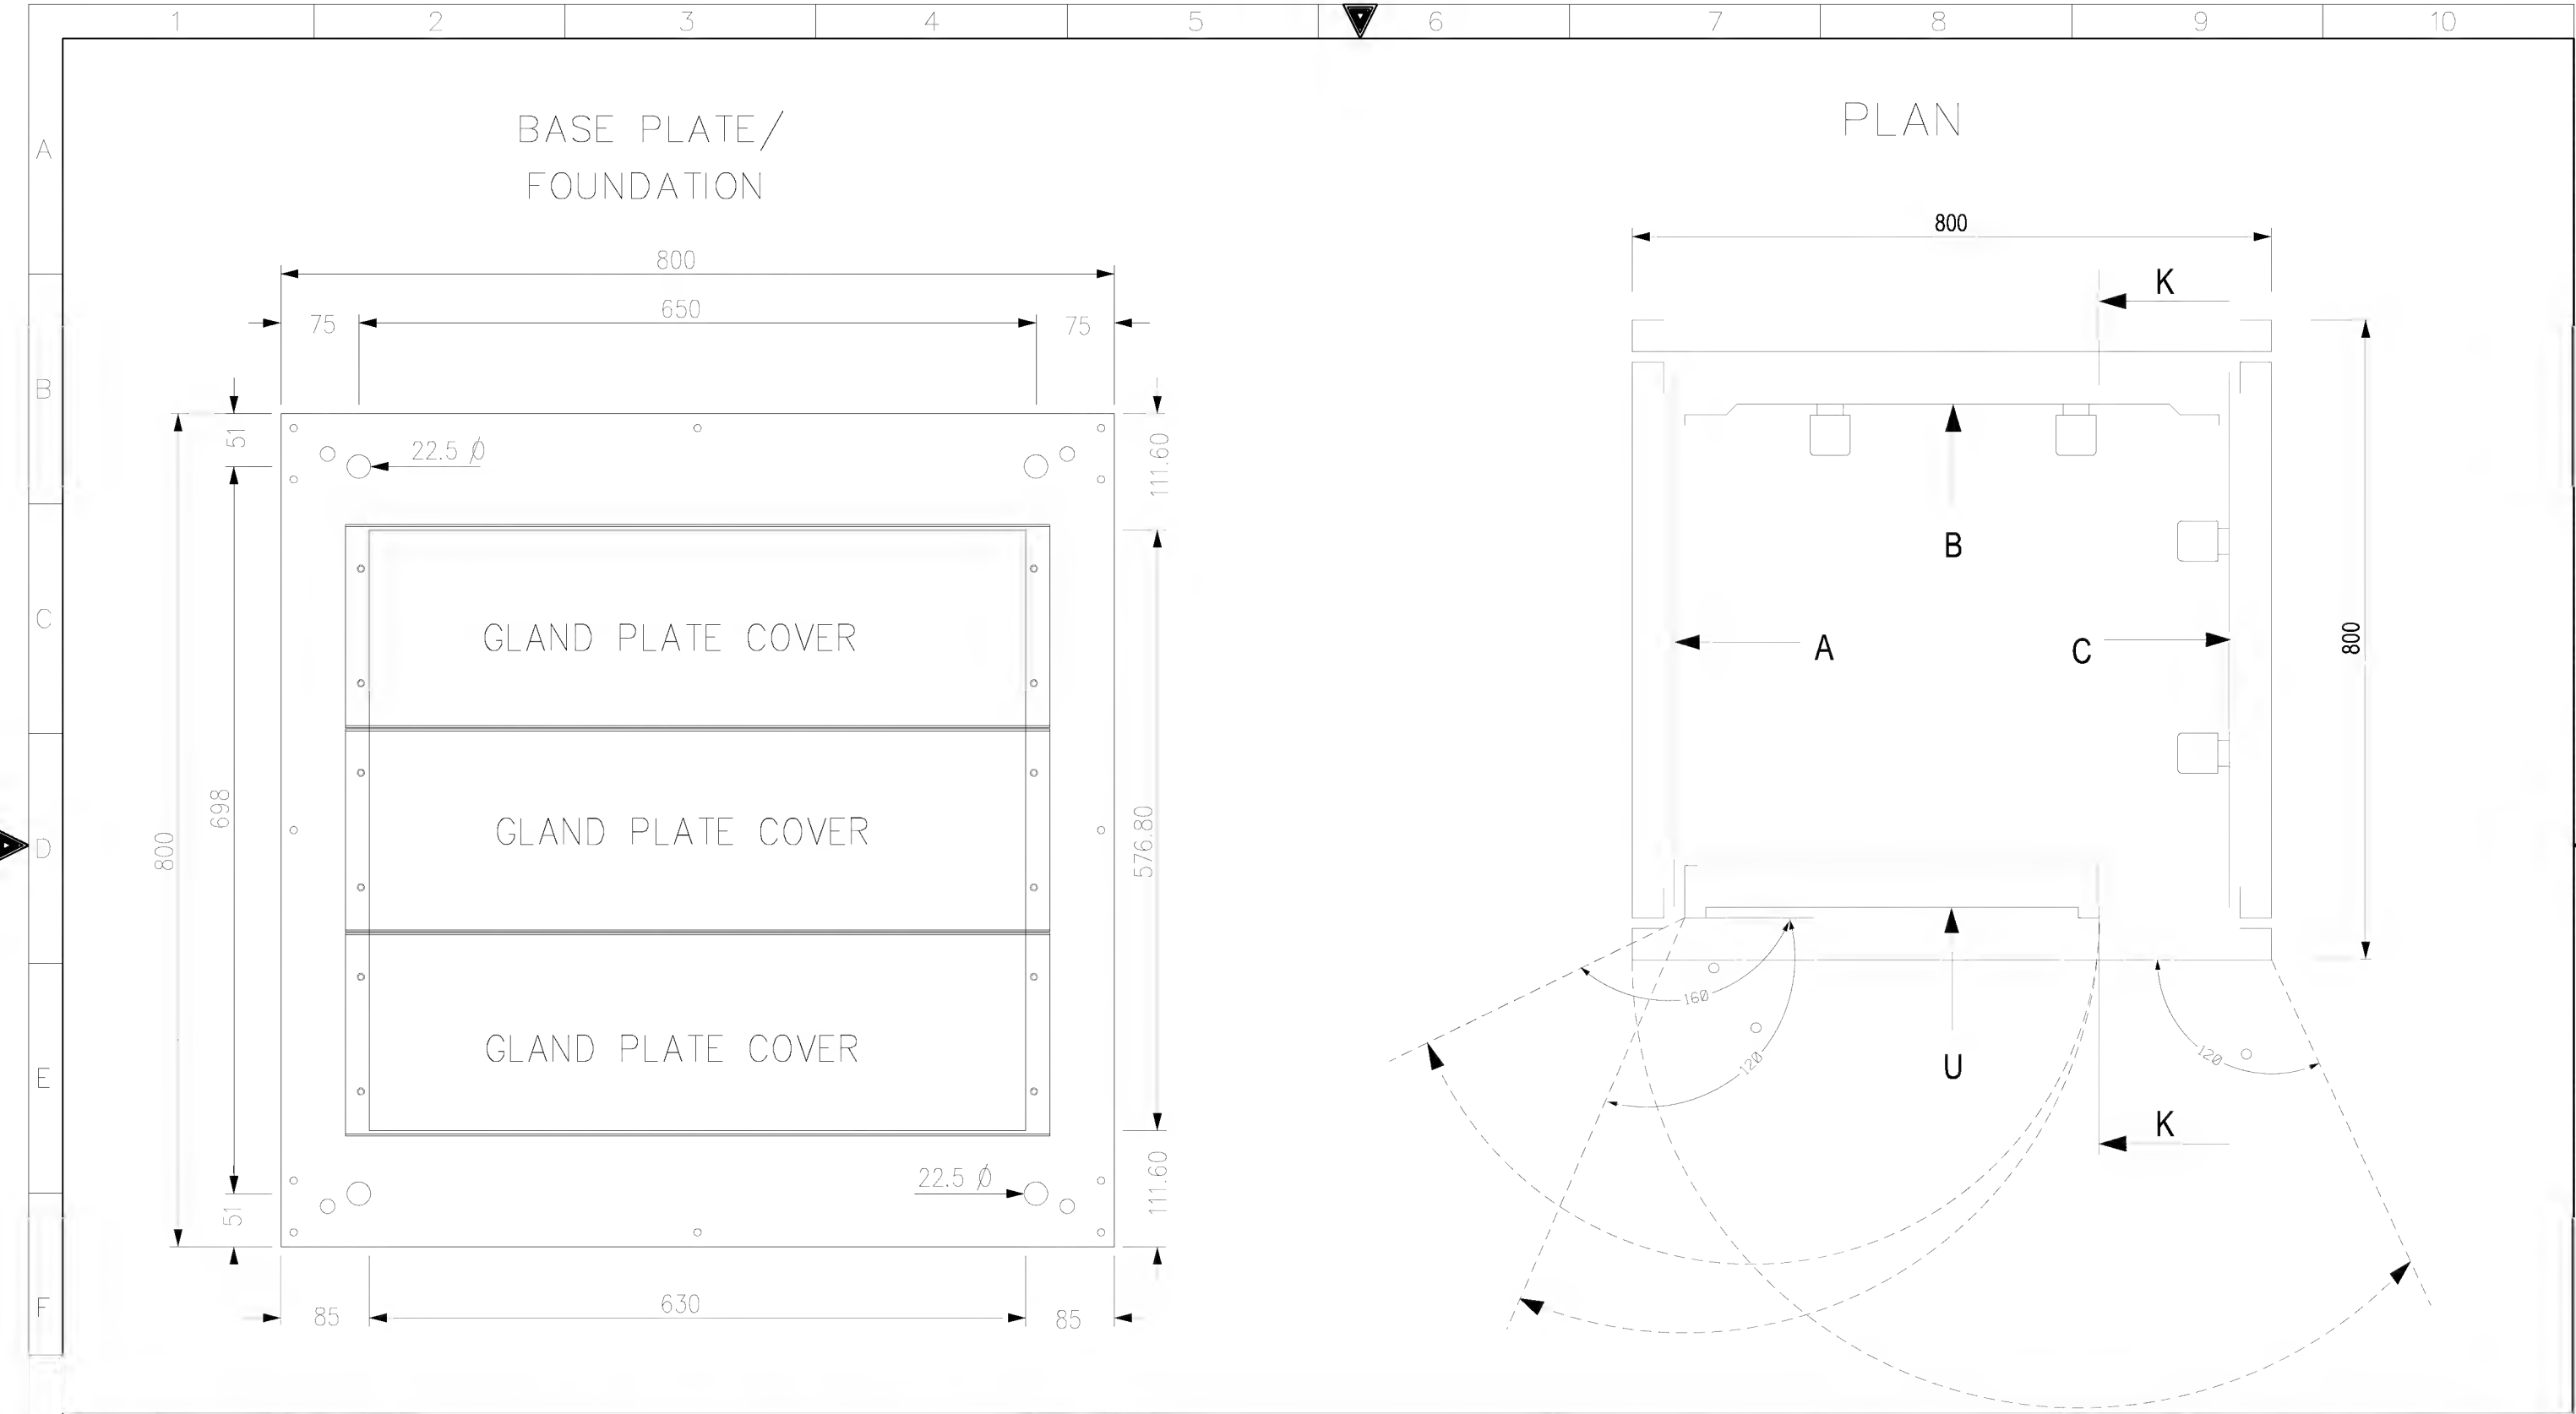

AS-BUILT BY _____ DATE _____ CONTRACT NO. 11131113/00 JOB ORDER NO. S-13656

01	13 49	FACTORY ASBUILT
00	13 04	FOR APPROVAL
REV. NO.	DATE	DESCRIPTION

DRAWN BY RIZ CHECKED BY JKR
DATE STARTED 24.01.2013 DATE COMPLETED _____
OPRG. DEPT. CTPD ENG. DEPT. AUT-PSAC

ASSEMBLY DRAWING
132/13.8kV GT-3 RELAY PANEL-2 +R04.2
S/S 8709-132/13.8KV IN AL-KHARJ CITY
RIYADH SAUDI ARABIA

الشركة الوطنية لنقل الكهرباء National Grid sa				
INDEX	PLANT NO.	DRAWING NUMBER	SHEET NO.	
-	C421	CD322933	SHT	CONT.
			G03	G04
			REV. NO.	
			01	

A


B

C

D


E

F

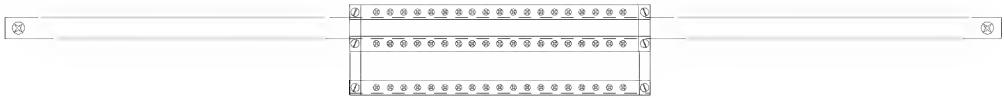

TOP VIEW FOR EARTHING BAR

U PLANE TOP LABEL

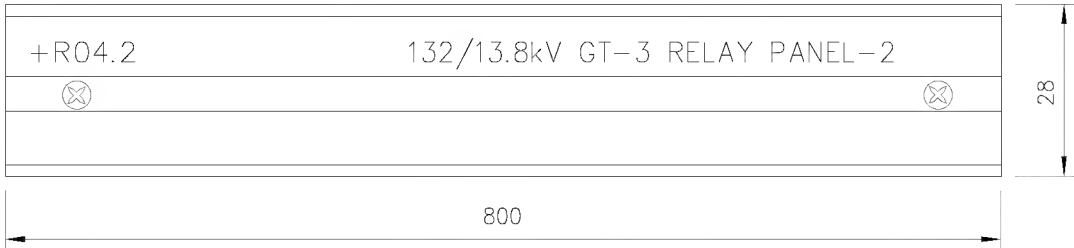

U PLANE BOTTOM LABEL



MANUFACTURING LABEL

ABB

ABB Automation Co.Ltd.

PROJECT :

National Grid SA
S/S 8709

ORDER REFERENCE :

2875 RF S13656

YEAR OF MANUFACTURE:

2013

PANEL NO. :

+R04.2

DRAWING NO. :

S13656-CD-323934

MADE IN THE KINGDOM OF SAUDI ARABIA

AS-BUILT BY _____ DATE _____ CONTRACT NO. 11131113/00 JOB ORDER NO. S-13656

01	13 49	FACTORY ASBUILT	DRAWN BY RIZ	CHECKED BY JKR
00	13 04	FOR APPROVAL	DATE STARTED 24.01.2013	DATE COMPLETED
REV. NO.	DATE	DESCRIPTION	OPRG. DEPT. CTPD	ENG. DEPT. AUT-PSAC


ASSEMBLY DRAWING
132/13.8kV GT-3 RELAY PANEL-2 +R04.2
S/S 8709-132/13.8KV IN AL-KHARJ CITY
RIYADH SAUDI ARABIA


الشركة الوطنية لنقل الكهرباء
National Grid sa

INDEX	PLANT NO.	DRAWING NUMBER	SHEET NO.	REV. NO.
-	C421	CD322933	SHT CONT.	01
			G04 L00	

NG/D2-D (2012/01)

DMS VECTOR NGD200


	1	2	3	4	5	6	7	8	9	10
A			POWER SYSTEMS NETWORK MANAGEMENT PROTECTION AND SUBSTATION AUTOMATION SYSTEMS WBS NO: S-13656					ABB AUTOMATION COMPANY LTD., 414, AL-KHARJ ROAD SECOND INDUSTRIAL CITY RIYADH-11383 K.S.A		
B										
C	CONTRACTOR : ABB Contracting Company									
	CLIENT : National Gridsa									
D	PROJECT : CONSTRUCTION OF NEW 132/13.8kV SS 8709 IN AL-KHARJ CITY									
	SUBSTATION : S/S 8709									
E	CONTRACT NO. : 11131113/00									
F	TITLE : LIST OF APPARATUS +R04.2 [GT-3]									

G	AS-BUILT BY _____ DATE _____		CONTRACT NO. 11131113/00	JOB ORDER NO. S-13656	LIST OF APPARATUS		 نقل الكهرباء الشركة الوطنية لنقل الكهرباء National Grid sa				
	01	13 49	FACTORY ASBUILT	DRAWN BY RIZ	CHECKED BY JKR	132/13.8kV GT-3 RELAY PANEL-2 +R04.2	INDEX	PLANT NO.	DRAWING NUMBER	SHEET NO.	REV. NO.
	00	13 04	FOR APPROVAL	DATE STARTED 24.01.2013	DATE COMPLETED	S/S 8709-132/13.8KV IN AL-KHARJ CITY	-	C421	CD322933	SHT L00	CONT. L01
	REV. NO.	DATE	DESCRIPTION	OPRG. DEPT. CTPD	ENG. DEPT. AUT-PSAC	RIYADH SAUDI ARABIA					01

	1	2	3	4	5	6	7	8	9	10
A										
B										
C										
D										
E										
F										

AS-BUILT BY _____ DATE _____			CONTRACT NO. 11131113/00		JOB ORDER NO. S-13656		LIST OF APPARATUS		الشركة الوطنية لنقل الكهرباء		نقل الكهرباء National Grid sa	
01	13 49	FACTORY ASBUILT	DRAWN BY RIZ		CHECKED BY JKR		132/13.8kV GT-3 RELAY PANEL-2 +R04.2		INDEX	PLANT NO.	DRAWING NUMBER	SHEET NO.
00	13 04	FOR APPROVAL	DATE STARTED 24.01.2013		DATE COMPLETED _____		S/S 8709-132/13.8KV IN AL-KHARJ CITY		-	C421	CD322933	REV. NO.
REV. NO.	DATE	DESCRIPTION	OPRG. DEPT. CTPD		ENG. DEPT. AUT-PSAC		RIYADH SAUDI ARABIA					L01 L02 01

	1	2	3	4	5	6	7	8	9	10
A										

AS-BUILT BY _____ DATE _____		CONTRACT NO. 11131113/00		JOB ORDER NO. S-13656		<div> <div>  <div> <div>نقل الكهرباء</div> <div>الشركة الوطنية لنقل الكهرباء</div> <div>National Grid sa</div> </div> </div> <div> <div>LIST OF APPARATUS</div> <div>132/13.8kV GT-3 RELAY PANEL-2 +R04.2</div> <div>S/S 8709-132/13.8KV IN AL-KHARJ CITY</div> <div>RIYADH SAUDI ARABIA</div> </div> </div>	
DRAWN BY _____ RIZ _____ CHECKED BY _____ JKR		DATE STARTED _____ 24.01.2013 _____ DATE COMPLETED _____		INDEX _____ PLANT NO. _____ DRAWING NUMBER _____ SHEET NO. _____ REV. NO. _____			
01	13 49	FACTORY ASBUILT					
00	13 04	FOR APPROVAL					
REV. NO.	DATE	DESCRIPTION		OPRG. DEPT. _____ CTPD _____ ENG. DEPT. _____ AUT-PSAC			

THIS DRAWING AND THE INFORMATION CONTAINED HEREIN ARE THE PROPERTY OF NATIONAL GRID SA AND ARE NOT TO BE REPRODUCED OR TRANSMITTED IN ANY FORM OR BY ANY MEANS, ELECTRONIC OR MECHANICAL, WITHOUT PERMISSION IN WRITING FROM NATIONAL GRID SA.

NG/D2-D (2012/01)


NGD200

DMS

VECTOR

	1	2	3	4	5	6	7	8	9	10
A										
B										
C										
D										
E										
F										

LABEL REF.	LABEL ENGRAVING	MATERIALS	ENGRAVING	LABEL SIZE	LETTER SIZE
U05.5001	U05.5001 871-2	TRAFOLITE	BLACK LETTERS ON WHITE BACKGROUND	50X15mm	4mm
U12.5001	U12.5001 TS-1	ALUMINUM PAPER FOIL	BLACK LETTERS	50X10mm	3mm
U12.5002	U12.5002 TS-2	ALUMINUM PAPER FOIL	BLACK LETTERS	50X10mm	3mm
U12.5003	U12.5003 TS-3	ALUMINUM PAPER FOIL	BLACK LETTERS	50X10mm	3mm
U12.5004	U12.5004 TS-4	ALUMINUM PAPER FOIL	BLACK LETTERS	50X10mm	3mm
U16.5001	U16.5001 S86T2	TRAFOLITE	BLACK LETTERS ON WHITE BACKGROUND	50X15mm	4mm
U20.101	U20.101 TS-4	ALUMINUM PAPER FOIL	BLACK LETTERS	50X10mm	3mm
U24.5001	U29.5001 86T2	ALUMINUM PAPER FOIL	BLACK LETTERS	50X10mm	3mm
U24.5002	U29.5002 94T2	ALUMINUM PAPER FOIL	BLACK LETTERS	50X10mm	3mm
U28.101	U28.101 23X 63QL-1X	ALUMINUM PAPER FOIL	BLACK LETTERS	50X10mm	3mm
U28.107	U28.107 63QH-1X 63QL-2X	ALUMINUM PAPER FOIL	BLACK LETTERS	50X10mm	3mm
U28.301	U28.301 63QH-2X 96D-1X	ALUMINUM PAPER FOIL	BLACK LETTERS	50X10mm	3mm
U28.307	U28.307 96D-2X 96-1X	ALUMINUM PAPER FOIL	BLACK LETTERS	50X10mm	3mm
U28.113	U28.113 63QP-1X 63GD-1X	ALUMINUM PAPER FOIL	BLACK LETTERS	50X10mm	3mm
U28.313	U28.313 26D-1X 26D-2X	ALUMINUM PAPER FOIL	BLACK LETTERS	50X10mm	3mm
U28.119	U28.119 49W1-5X 49W1-6X	ALUMINUM PAPER FOIL	BLACK LETTERS	50X10mm	3mm
U28.319	U28.319 630-SX 96-2X	ALUMINUM PAPER FOIL	BLACK LETTERS	50X10mm	3mm
U28.125	U28.125 63QP-2X 49W2-5X	ALUMINUM PAPER FOIL	BLACK LETTERS	50X10mm	3mm
U28.325	U28.325 49W2-6X SPARE	ALUMINUM PAPER FOIL	BLACK LETTERS	50X10mm	3mm
U28.131	U28.131 74R2	ALUMINUM PAPER FOIL	BLACK LETTERS	50X10mm	3mm
U28.331	U28.331 74R3	ALUMINUM PAPER FOIL	BLACK LETTERS	50X10mm	3mm
U28.137	U28.137 63/49/96x	ALUMINUM PAPER FOIL	BLACK LETTERS	50X10mm	3mm
U28.337	U28.337 T1	ALUMINUM PAPER FOIL	BLACK LETTERS	50X10mm	3mm
U28.149	U28.149 49X	ALUMINUM PAPER FOIL	BLACK LETTERS	50X10mm	3mm
U28.349	U28.349 96-3/96-4	ALUMINUM PAPER FOIL	BLACK LETTERS	50X10mm	3mm
U28.143	U28.143 R1	ALUMINUM PAPER FOIL	BLACK LETTERS	50X10mm	3mm
U28.343	U28.343 R2	ALUMINUM PAPER FOIL	BLACK LETTERS	50X10mm	3mm

G	AS-BUILT BY _____ DATE _____			CONTRACT NO. 11131113/00		JOB ORDER NO. S-13656		LIST OF APPARATUS		<div>الشركة الوطنية لنقل الكهرباء</div> <div> نقل الكهرباء National Grid sa</div>						
				DRAWN BY RIZ		CHECKED BY JKR		132/13.8kV GT-3 RELAY PANEL-2 +R04.2		INDEX	PLANT NO.	DRAWING NUMBER		SHEET NO.		REV. NO.
	01	13 49	FACTORY ASBUILT	DATE STARTED 24.01.2013		DATE COMPLETED		S/S 8709-132/13.8KV IN AL-KHARJ CITY		-	C421	CD322933		SHT	CONT.	01
	00	13 04	FOR APPROVAL	OPRG. DEPT. CTPD		ENG. DEPT. AUT-PSAC		RIYADH SAUDI ARABIA						L05	L06	
	REV. NO.	DATE	DESCRIPTION													

NG/D2-D (2012/01)


DMS VECTOR


NGD200

	1	2	3	4	5	6	7	8	9	10
A										
B										
C										
D										
E										
F										

LABEL REF.	LABEL ENGRAVING	MATERIALS	ENGRAVING	LABEL SIZE	LETTER SIZE
C1	C1 127V AC SUPPLY MCB	TRAFOLITE	BLACK LETTERS ON WHITE BACKGROUND	50X15mm	4mm
C2	C2 220V AC SUPPLY MCB	TRAFOLITE	BLACK LETTERS ON WHITE BACKGROUND	50X15mm	4mm
C3	C3 THERMOSTAT	TRAFOLITE	BLACK LETTERS ON WHITE BACKGROUND	50X15mm	4mm
C7	C7 ON/OFF SWITCH	TRAFOLITE	BLACK LETTERS ON WHITE BACKGROUND	50X15mm	4mm
DS	DS DOOR SWITCH	TRAFOLITE	BLACK LETTERS ON WHITE BACKGROUND	50X15mm	4mm
IL	IL ILLUMINATION LAMP	TRAFOLITE	BLACK LETTERS ON WHITE BACKGROUND	50X15mm	4mm
SH	SH SPACE HEATER	TRAFOLITE	BLACK LETTERS ON WHITE BACKGROUND	50X15mm	4mm
U39.5001	Q1 R2+SUPPLY	TRAFOLITE	BLACK LETTERS ON WHITE BACKGROUND	50X15mm	4mm
U39.5002	Q2 R3+SUPPLY	TRAFOLITE	BLACK LETTERS ON WHITE BACKGROUND	50X15mm	4mm
U39.5003	C01,C02 OUTLET	TRAFOLITE	BLACK LETTERS ON WHITE BACKGROUND	50X15mm	4mm
U39.5004	TJ TELEPHONE JACK	TRAFOLITE	BLACK LETTERS ON WHITE BACKGROUND	50X15mm	4mm
U36.5001	Q3 TC- 2+SUPPLY	TRAFOLITE	BLACK LETTERS ON WHITE BACKGROUND	50X15mm	4mm

G	AS-BUILT BY _____ DATE _____		CONTRACT NO. 11131113/00		JOB ORDER NO. S-13656		LIST OF APPARATUS		الشركة الوطنية لنقل الكهرباء National Grid sa				
	01	13 49	FACTORY ASBUILT		DRAWN BY RIZ CHECKED BY JKR		132/13.8kV GT-3 RELAY PANEL-2 +R04.2		<div><div>INDEX</div><div>PLANT NO.</div><div>DRAWING NUMBER</div><div>SHEET NO.</div><div>REV. NO.</div></div>				
	00	13 04	FOR APPROVAL		DATE STARTED 24.01.2013 DATE COMPLETED _____		S/S 8709-132/13.8KV IN AL-KHARJ CITY						
	REV. NO.	DATE	DESCRIPTION		OPRG. DEPT. CTPD ENG. DEPT. AUT-PSAC		RIYADH SAUDI ARABIA						
									-	C421	CD322933	L06000	01

	1	2	3	4	5	6	7	8	9	10
A			POWER SYSTEMS NETWORK MANAGEMENT PROTECTION AND SUBSTATION AUTOMATION SYSTEMS WBS NO: S-13656					ABB AUTOMATION COMPANY LTD. 414, AL-KHARJ ROAD SECOND INDUSTRIAL CITY RIYADH-11383 K.S.A		
B										
C										
D	CONTRACTOR : ABB Contracting Company									
	CLIENT : National Gridsa									
	PROJECT : CONSTRUCTION OF NEW 132/13.8kV SS 8709 IN AL-KHARJ CITY									
	SUBSTATION : S/S 8709									
E	CONTRACT NO. : 11131113/00									
F	TITLE : SCHEMATICS DRAWINGS (+R04.1,+R04.2)									

G	AS-BUILT BY _____ DATE _____		CONTRACT NO. 11131113/00	JOB ORDER NO. S-13656	COVER SHEET		 نقل الكهرباء الشركة الوطنية لنقل الكهرباء National Grid sa				
	01	13 49	FACTORY ASBUILT	DRAWN BY RIZ	CHECKED BY JKR	132/13.8KV GT-3 RELAY PANEL -+R04.1/+R04.2	INDEX	PLANT NO.	DRAWING NUMBER	SHEET NO.	REV. NO.
	00	13 04	FOR APPROVAL	DATE STARTED 24.01.2013	DATE COMPLETED	S/S 8709-132/13.8KV IN AL-KHARJ CITY	-	C421	CD322934	SHT 000	CONT. 001
	REV. NO.	DATE	DESCRIPTION	OPRG. DEPT. CTPD	ENG. DEPT. AUT-PSAC	RIYADH SAUDI ARABIA					01

1	2	3	4	5	6	7	8	9	10
A									
B									
C									
D									
E									
F									

CONTENTS	ABB SHT.NO.	REV.00	REV.01	REV.02
COVER SHEET	000	X	X	
CONTENTS SHEET	001	X	X	
CONTENTS SHEET	002	X	X	
CRAPHICAL SYMBOLS FOR DIACRAMS	011	X	X	
CRAPHICAL SYMBOLS FOR DIACRAMS	012	X	X	
COMMON LEGEND	013	X	X	
FERULE AND WIRINC DETAILS	014	X	X	
PRIMARY SYSTEM	051-055	X	X	
AC SUPPLY FOR ILLUMINATION & POWER SOCKET	211	X	X	
CUB. LIGHTING, HEATER & SOCKET ALARM CKT.	212	X	X	
DC SUPPLY DISTRIBUTION	216	X	X	
CT CIRCUITS	221-223	X	X	
VT CIRCUITS	224	X	X	
87T-1 BINARY INPUTS	227	X	X	
87T-1 BINARY INPUTS	228	X	X	
MAIN-1 TRAF DIFFL. PROTECTION TRIP RELAY CKT.	232	X	X	
CBF & BUSBAR-1 TRIP RELAY CIRCUIT	276	X	X	
BUSBAR-2 TRIP RELAY CIRCUIT	277	X	X	
TRIP COIL-1 SUPERVISION CIRCUIT	291	X	X	
CLOSE BLOCK & BF INI CKT.	292	X	X	
CONTACTS FOR ACSE INI & LV TRIPPING TC	293	X	X	
ACSE INI & LV CLOSE BLOCK CIRCUIT	294	X	X	
CONTACTS FOR TRIP CIRCUIT-2 & BFI	295	X	X	

CONTENTS	ABB SHT.NO.	REV.00	REV.01	REV.02
CONTACTS FOR U/F LOAD SHEDDINC	296	X	X	
STN COMMON ALARM CIRCUITS	298	X	X	
LOR SPARE CONTACTS	299	X	X	
BLOCK REFERENCE	301-303	X	X	
TERMINAL BLOCK REFERENCE +R04.1	304	X	X	

A

B

C

D

E

F

G

CONTENTS	ABB SHT.NO.	REV.00	REV.01	REV.02
AC SUPPLY FOR ILLUMINATION & POWER SOCKET	411	X	X	
CUB. LIGHTING, HEATER & SOCKET ALARM CKT.	412	X	X	
DC SUPPLY DISTRIBUTION FOR SYSTEM SYNCHRONISER	416	X	X	
CT CIRCUIT 87T-2 RELAY	421-422	X	X	
CT CIRCUIT 87T-2 RELAY	423	X	X	
CT & VT CIRCUITS 87T-2 RELAY	424	X	X	
87T-2 BINARY INPUTS	429	X	X	
87T-2 BINARY INPUTS	430	X	X	
MAIN-2 DIFF. PROTECTION TRIP RELAY CKT.	432	X	X	
TRANS.MECH.PROTN.CONTACT MULTI.CKT	433	X	X	
TRANS.MECH.PROTN.CONTACT MULTI.CKT	434	X	X	
TRANS.MECH.PROTN.CONTACT MULTI.CKT	435	X	X	
TRANS.MECH.PROTN.CONTACT MULTI.CKT	436	X	X	
CB K305 TRIP CIRCUIT-2 SUPERVISION CIRCUIT	491	X	X	
BF INI & CLOSE BLOCK CIRCUIT	492	X	X	
TRANSFORMER MECHANICAL.PROTN.	493	X	X	
CONTACTS FOR TRIP AND CLOSE BLOCK	494	X	X	
CONTACTS FOR U/F LOAD SHEDDING	496	X	X	
MECH PROTN. ALARM CIRCUIT	498	X	X	
STN COMMON ALARM CIRCUIT	499	X	X	
BLOCK REFERENCE	501	X	X	
BLOCK REFERENCE	502	X	X	
TERMINAL BLOCKS REFERENCE +R04.2	406	X	X	
TERMINAL BLOCKS REFERENCE +R04.2	507	X	X	

AS-BUILT BY _____ DATE _____			CONTRACT NO. 11131113/00		JOB ORDER NO. S-13656	
01	13 49	FACTORY ASBUILT	DRAWN BY RIZ		CHECKED BY JKR	
00	13 04	FOR APPROVAL	DATE STARTED 24.01.2013		DATE COMPLETED _____	
REV. NO.	DATE	DESCRIPTION	OPRG. DEPT. CTPD		ENG. DEPT. AUT-PSAC	

CONTENTS SHEET	
132/13.8KV GT-3 RELAY PANEL-1/2	
S/S 8709-132/13.8KV IN AL-KHARJ CITY	
RIYADH	SAUDI ARABIA

الشركة الوطنية لنقل الكهرباء National Grid sa		INDEX	PLANT NO.	DRAWING NUMBER	SHEET NO.		REV. NO.
		-	C421	CD322934	SHT	CCNT.	01
					002	011	

	1	2	3	4	5	6	7	8	9	10
A										
B										
C										
D										
E										
F										

SYMBOL	DESCRIPTION	SYMBOL	DESCRIPTION	SYMBOL	DESCRIPTION
	FRAME CONNECTION		MAIN CONTACT OF A CIRCUIT BREAKER		RELAY WITH TWO MAKE CONTACTS, ONE OF THEM DELAYED WHEN OPERATING
	EARTH CONNECTION		PASSING MAKE CONTACT CLOSING MOMENTARILY DURING OPERATION AND RELEASE		RELAY WITH TWO ACTUATORS AND A TWO STABLE POSITIONS
	RESISTOR		BREAK CONTACT DELAYED WHEN OPERATING		RELAY WITH TWO ACTUATORS AND A TWO STABLE POSITIONS
	VARIABLE RESISTOR		MAKE CONTACT DELAYED WHEN RELEASING		RELAY WITH TWO ACTUATORS AND A TWO STABLE POSITIONS
	RESISTOR WITH PRESET ADJUSTMENT		TWO MECHANICAL LINKS CROSSING WITHOUT CONNECTION		SIGNALLING LAMP
	CAPACITOR		JUNCTION OF MECHANICAL LINKS		MECHANICAL INDICATOR WITH AUTOMATIC RESET
	SEMICONDUCTOR DIODE USED AS A CAPACITIVE DEVICE		AUTOMATIC RESET		MECHANICAL INDICATOR WITH NON-AUTOMATIC RESET
	OPEN CONTACT, MAKE CONTACT		NON-AUTOMATIC RESET		ELECTRICALLY CONTROLLED MECHANICAL INDICATOR WITH AUTOMATIC RESET
	CLOSED CONTACT, BREAK CONTACT		SWITCHING DEVICE WITH MANUAL OPERATION AND WITH AUTOMATIC RESET		ELECTRICALLY CONTROLLED MECHANICAL INDICATOR WITH NON-AUTOMATIC RESET
	CHANGE-OVER CONTACT, BREAK BEFORE MAKE		SWITCHING DEVICE WITH MANUAL OPERATION AND WITH NON-AUTOMATIC RESET		ELECTRICALLY CONTROLLED MECHANICAL INDICATOR WITH NON-AUTOMATIC RESET
	MAKE CONTACT WHICH IS EARLY WHEN OPERATING AND LATE WHEN RELEASING		CHANGE-OVER SWITCHING DEVICE WITH MANUAL CONTROL AUTOMATIC RESET FROM POSITION 1-2 TO THE NEUTRAL POSITION		RELAY WITH MAKE CONTACT
	BREAK CONTACT WHICH IS LATE WHEN OPERATING AND EARLY WHEN RELEASING		RELAY WITH MAKE CONTACT, DELAYED WHEN OPERATING		RELAY WITH MAKE CONTACT, DELAYED WHEN RELEASING
	SWITCHING DEVICE WITH MANUAL CONTROL		RELAY WITH MAKE CONTACT, DELAYED WHEN OPERATING AND RELEASING		BELL, BUZZER
	MAKE CONTACT DELAYED WHEN OPERATING		RELAY WITH MAKE CONTACT, DELAYED WHEN OPERATING AND RELEASING		SIREN, HORN
	BREAK CONTACT DELAYED WHEN RELEASING				
	MAKE CONTACT DELAYED WHEN OPERATING AND RELEASING				
	MAIN CONTACT OF A SWITCH DISCONNECTOR				
	MAIN CONTACT OF A DISCONNECTOR				

	1	2	3	4	5	6	7	8	9	10
A										
B										
C										
D										
E										
F										

LEGENDS

±R1	DC SUPPLY – MAIN PROTECTION
±R2	DC SUPPLY – SECONDARY PROTECTION
±R3	DC SUPPLY – BACK UP PROTECTION
±IT	DC SUPPLY – INTER TRIP
FL	DC SUPPLY – FLASHING CIRCUIT
BB RS±	DC SUPPLY – BUS BAR – PROTECTION RESET
BB CBF±/CBF±	DC SUPPLY – CBF PROTECTION
R	RESET BUS – ALARM SYSTEM
CR	CONTROL ROOM
ECC	ENERGY CONTROL CENTRE
LOCAL	THE LOCATION OF CONTROLLED DEVICE
REMOTE	ANY OTHER LOCATION NOT LOCAL
ON	CB NORMALLY OPEN AUXILIARY CONTACT
OFF	CB NORMALLY CLOSED AUXILIARY CONTACT
A	COMMON
T	TEST POSITION
S	SERVICE POSITION
CS	CLOSE IN SERVICE POSITION
CT	CLOSE IN TEST POSITION
LS	LOCAL SERVICE
LT	LOCAL TEST
LC	LOCAL CLOSE
LO	LOCAL OPEN
RO	REMOTE OPEN
OP	OPERATE
RE	RESET

NOTES

LABELS

WHITE LABEL WITH BLACK LETTERING WILL BE PROVIDED FOR ALL MOUNTED APPARATUS EQUIPMENT IDENTIFICATION AND FUNCTION REFERENCE LABEL WILL BE PROVIDED FOR FRONT MOUNTED EQUIPMENTS OF THE PANEL AND EQUIPMENT IDENTIFICATION LABEL WILL BE PROVIDED FOR INTERNALLY MOUNTED EQUIPMENTS

WIRING

PVC INSULATED 600V GRADE
2.5 SQ.mm. YELLOW COLOURED FOR CT CIRCUITS
2.5 SQ.mm. RE COLOURED FOR VT CIRCUITS
1.5 SQ.mm. GREY COLOURED FOR DC SUPPLY, SCADA AND CONTROL CIRCUITS
2.5 SQ.mm. BLACK COLOURED FOR AVC AND AC CIRCUITS
2.5 SQ.mm. YELLOW/GREEN COLOURED FOR EARTHING CONNECTIONS
FOLLOWING MARKERS SHALL BE PROVIDED ON FOLLOWING WIRES:
+ SIGN FOR DC + WIRE
– SIGN FOR DC – WIRE

LUGS

A. CT CIRCUITS– RING TYPE
B. OTHER CIRCUITS – SPADE TYPE

FERULLING

YELLO TUBE 3.2 mm FOR 1.5SQ mm WIRES AND 4.2 FOR 2.5 SQ mm WIRES (AS PER 31 – TMSS–1, RE.0)

AS-BUILT BY _____ DATE _____ CONTRACT NO. 11131113/00 JOB ORDER NO. S-13656

01	13 49	FACTORY ASBUILT	DRAWN BY RIZ	CHECKED BY JKR
00	13 04	FOR APPROVAL	DATE STARTED 24.01.2013	DATE COMPLETED
REV. NO.	DATE	DESCRIPTION	OPRG. DEPT. CTPD	ENG. DEPT. AUT-PSAC

COMMON LEGEND

132/13.8KV GT-3 RELAY PANEL-1/2
S/S 8709-132/13.8KV IN AL-KHARJ CITY
RIYADH SAUDI ARABIA

الشركة الوطنية لنقل الكهرباء
National Grid sa

INDEX	PLANT NO.	DRAWING NUMBER	SHEET NO.	REV. NO.
-	C421	CD322934	SHT 013	CONT. 014
				01

A


B

C

D

E

F

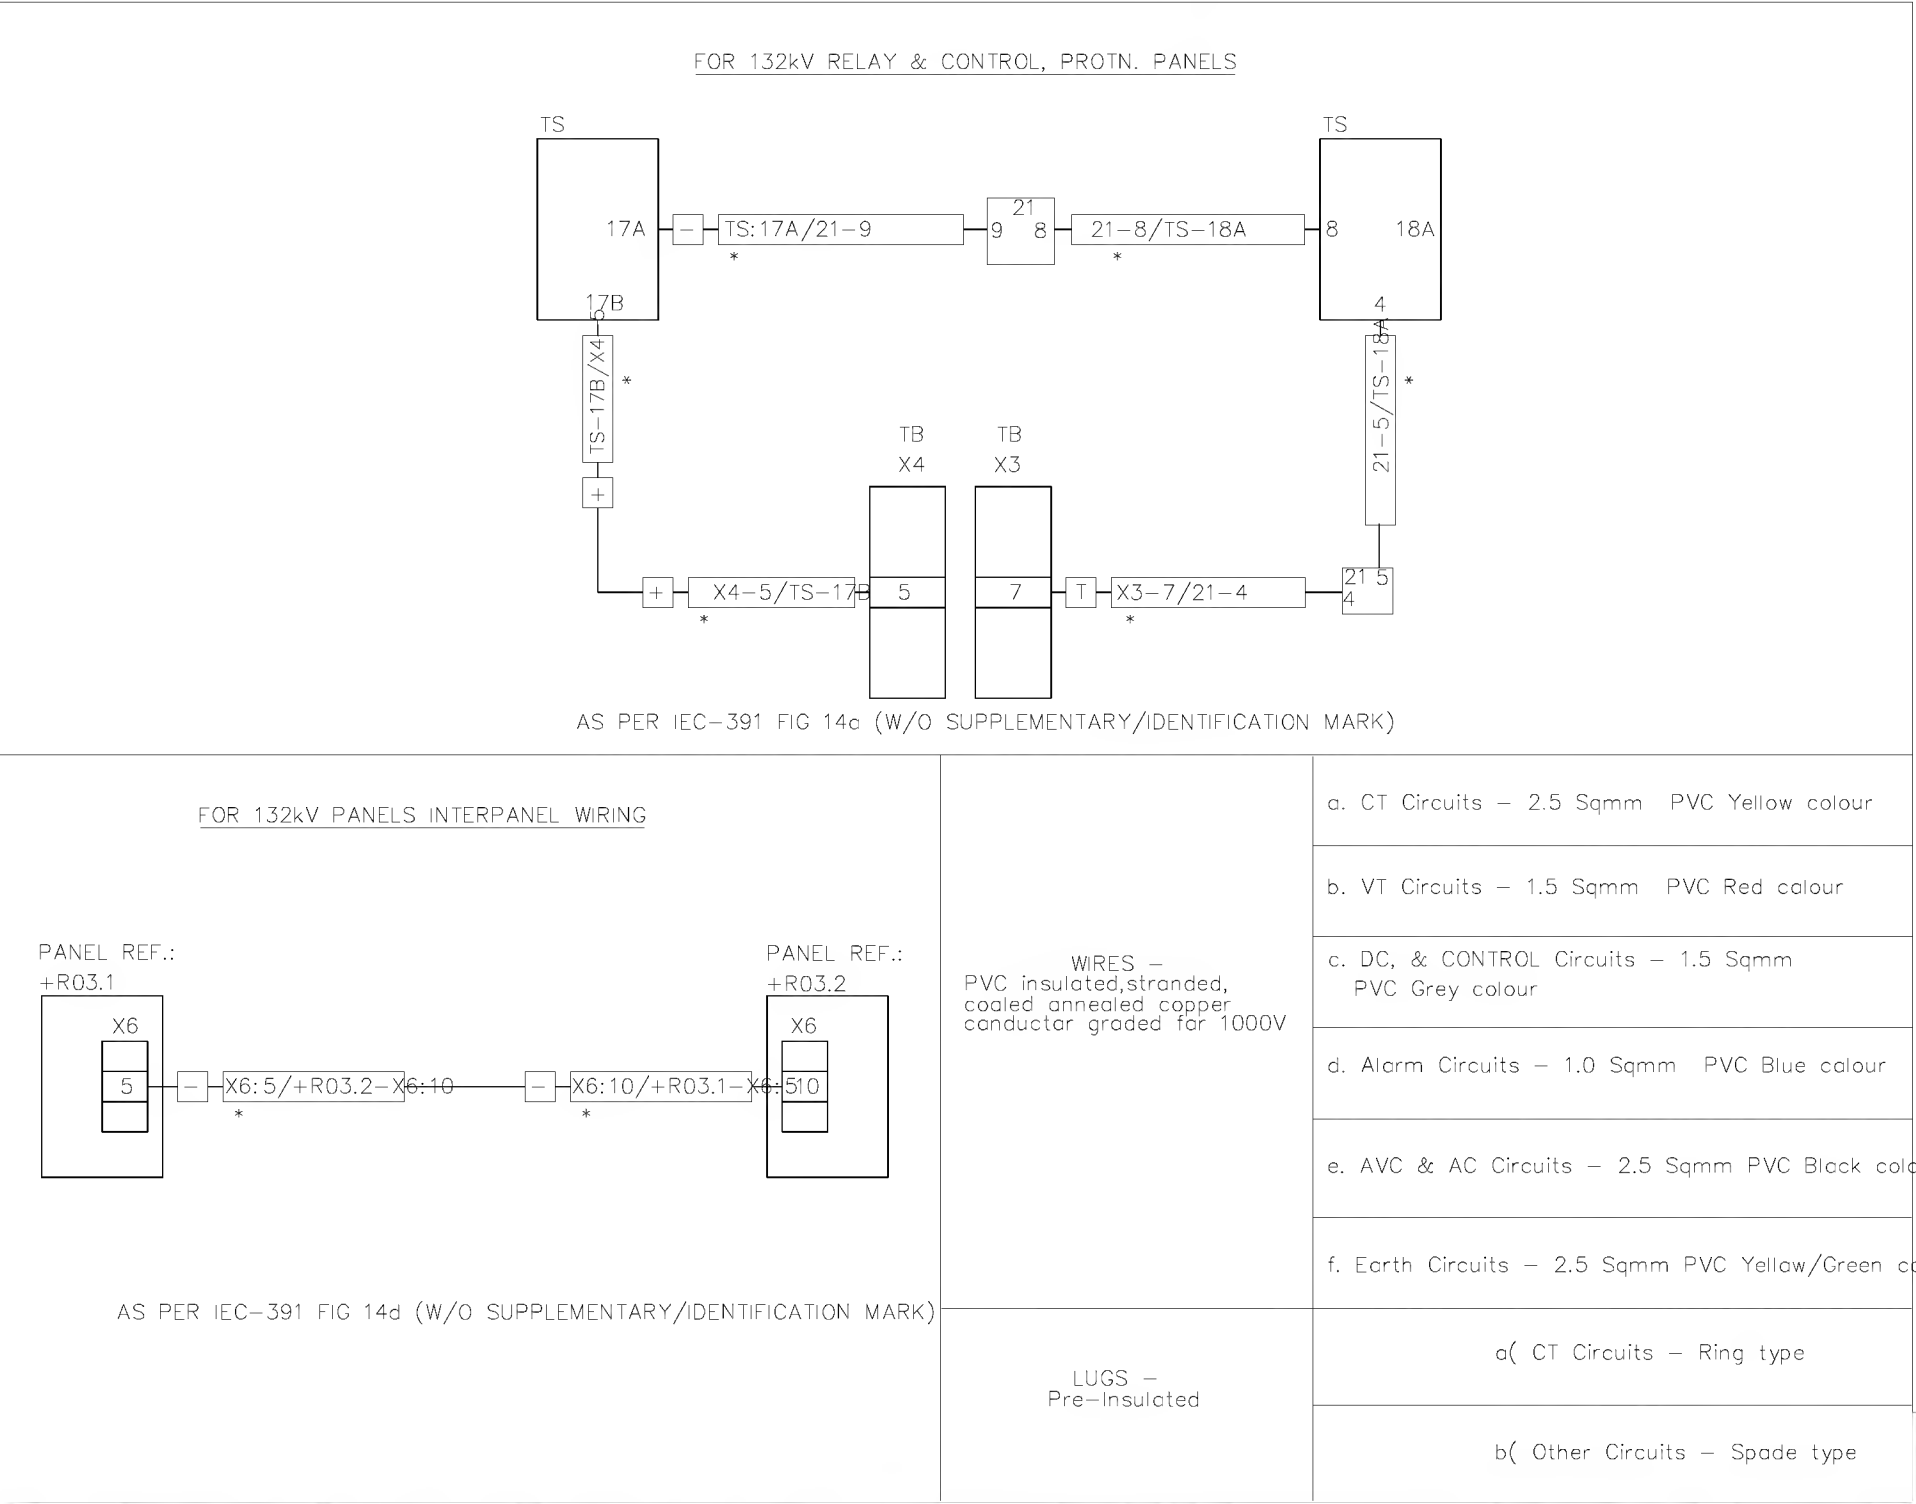

NOTE:1 ADDITIONAL MARKING AS APPLICABLE


NOTE:2 FERRULE NUMBERING WILL BE BLACK LETTERS ON YELLOW TUBE
3.2 mm for 1.5 sq mm wires and
4.2 mm for 2.5 sq mm wires
(As per 31-TMSS-1, REV 0)

NOTE:3 STARTING POINT OF THE FERRULE LEFT TO RIGHT


G

AS-BUILT BY _____ DATE _____			CONTRACT NO. 11131113/00		JOB ORDER NO. S-13656	
01	13 49	FACTORY ASBUILT	DRAWN BY RIZ		CHECKED BY JKR	
00	13 04	FOR APPROVAL	DATE STARTED 24.01.2013		DATE COMPLETED _____	
REV. NO.	DATE	DESCRIPTION	OPRG. DEPT. CTPD		ENG. DEPT. AUT-PSAC	

FERRULE AND WIRING DETAILS	
132/13.8KV GT-3 RELAY PANEL-1/2	
S/S 8709-132/13.8KV IN AL-KHARJ CITY	
RIYADH	SAUDI ARABIA


الشركة الوطنية لنقل الكهرباء			 نقل الكهرباء		
			National Grid sa		
INDEX	PLANT NO.	DRAWING NUMBER	SHEET NO.		REV. NO.
-	C421	CD322934	SHT	CONT.	01
			014	015	

	1	2	3	4	5	6	7	8	9	10
A										
B										
C										
D										
E										
F										

MANUFACTURER	SCHEMATICS DWG.NO	PANEL DESCRIPTION	PANEL REFERENCE
 PROTECTION & SUBSTATION AUTOMATION		SS 8709 132kV RELAY PANELS	
	CD322934	132/13.8kV GT-3 RELAY PANEL -1	+R04.1
		132/13.8kV GT-3 RELAY PANEL -2	+R04.2
	CD322934	132/13.8kV GT-3 RELAY PANEL -1	+R04.1
		132/13.8kV GT-3 RELAY PANEL -2	+R04.2
	CD-322934	132/13.8kV GT-3 RELAY PANEL -1	+R04.1
		132/13.8kV GT-3 RELAY PANEL -2	+R04.2
	CD-322936	132/13.8kV TRANSFORMER-1,2& 3 AVC PANEL	+AVC
	CD-322922	132KV SPARE-1 UGF RELAY PANEL -1	+R07.1
		132KV SPARE-1 UGF RELAY PANEL -2	+R07.2
	CD-322916	132KV 8020 UGF RELAY PANEL -1	+R02.1
		132KV 8020 UGF RELAY PANEL -2	+R02.2
	CD-322919	132KV 8710 UGF RELAY PANEL -1	+R04.1
		132KV 8710 UGF RELAY PANEL -2	+R04.2
	CD-322925	132KV SPARE-2 UGF RELAY PANEL -1	+R06.1
		132KV SPARE-2 UGF RELAY PANEL -2	+R06.2
	CD-323012	132KV FOIP PANEL	+FOIP
	CD-322946	132kV BUS COUPLER-A	+R130
	CD-322948	132kV BUS COUPLER-B	+R230
	CD-322950	132kV BUS SECTION	+R120
	CD-322991	132kV BUSBAR PROTECTION MAIN-1 CENTRAL UNIT PANEL	+BB1-1
	CD-322993	132kV BUSBAR PROTECTION MAIN-1 BAY UNIT PANEL	+BB1-2
	CD-322995	132kV BUSBAR PROTECTION MAIN-1 BAY UNIT PANEL	+BB1-3
	CD-322997	132kV BUSBAR PROTECTION MAIN-1 BAY UNIT PANEL	+BB1-4
	CD-322999	132kV BUSBAR PROTECTION MAIN-1 BAY UNIT PANEL	+BB1-5
	CD-323001	132kV BUSBAR PROTECTION MAIN-2 CENTRAL UNIT PANEL	+BB2-1
	CD-323003	132kV BUSBAR PROTECTION MAIN-2 BAY UNIT PANEL	+BB2-2
	CD-323005	132kV BUSBAR PROTECTION MAIN-2 BAY UNIT PANEL	+BB2-3
	CD-323007	132kV BUSBAR PROTECTION MAIN-2 BAY UNIT PANEL	+BB2-4
	CD-323009	132kV BUSBAR PROTECTION MAIN-2 BAY UNIT PANEL	+BB2-5


G	AS-BUILT BY _____ DATE _____		CONTRACT NO. 11131113/00		JOB ORDER NO. S-13656		DRAWING REFERENCES		الشركة الوطنية لنقل الكهرباء National Grid sa						
			DRAWN BY _____ RIZ _____ CHECKED BY _____ JKR				132/13.8KV GT-3 RELAY PANEL-1/2		INDEX	PLANT NO.	DRAWING NUMBER		SHEET NO.		REV. NO.
	01 13 49 FACTORY ASBUILT		DATE STARTED 24.01.2013 DATE COMPLETED _____				S/S 8709-132/13.8KV IN AL-KHARJ CITY				SHT CONT.				
	00 13 04 FOR APPROVAL		OPRG. DEPT. _____ CTPD _____ ENG. DEPT. _____ AUT-PSAC				RIYADH SAUDI ARABIA				- C421 CD322934		015 016		01
REV. NO.		DATE		DESCRIPTION											


	1	2	3	4	5	6	7	8	9	10
A										
B										
C										
D										
E										
F										


MANUFACTURER	SCHEMATICS DWG.NO	PANEL DESCRIPTION	PANEL REFERENCE
 PROTECTION & SUBSTATION AUTOMATION		SS 8709 13.8KV RELAY PANELS	
	CD-322952	13.8KV Capacitor Bank-1 Protection Panel	+CBP-1
	CD-322954	13.8KV Capacitor Bank-2 Protection Panel	+CBP-2
	CD-322956	13.8KV Capacitor Bank-2 Protection Panel	+CBP-3
	CD-322958	13.8 KV ACCS PANEL	+ACCS
	CD-322962	13.8KV ACSE PANEL	+ACSE
	CD-322968	13.8KV Under Voltage Load Shedding Panel	+UVLS
	CD-322964	13.8KV Under Frequency Load Shedding Panel-1	+UFLS01
	CD-322966	13.8KV Under Frequency Load Shedding Panel-2	+UFLS02


AS-BUILT BY _____ DATE _____			CONTRACT NO. 11131113/00	JOB ORDER NO. S-13656
01	13 49	FACTORY ASBUILT	DRAWN BY RIZ	CHECKED BY JKR
00	13 04	FOR APPROVAL	DATE STARTED 24.01.2013	DATE COMPLETED _____
REV. NO.	DATE	DESCRIPTION	OPRG. DEPT. CTPD	ENG. DEPT. AUT-PSAC

DRAWING REFERENCES	
132/13.8KV GT-3 RELAY PANEL-1/2	
S/S 8709-132/13.8KV IN AL-KHARJ CITY	
RIYADH	SAUDI ARABIA

الشركة الوطنية لنقل الكهرباء		 نقل الكهرباء National Grid sa			
INDEX	PLANT NO.	DRAWING NUMBER	SHEET NO.		REV. NO.
-	C421	CD322934	SHT 016	CONT. 051	01

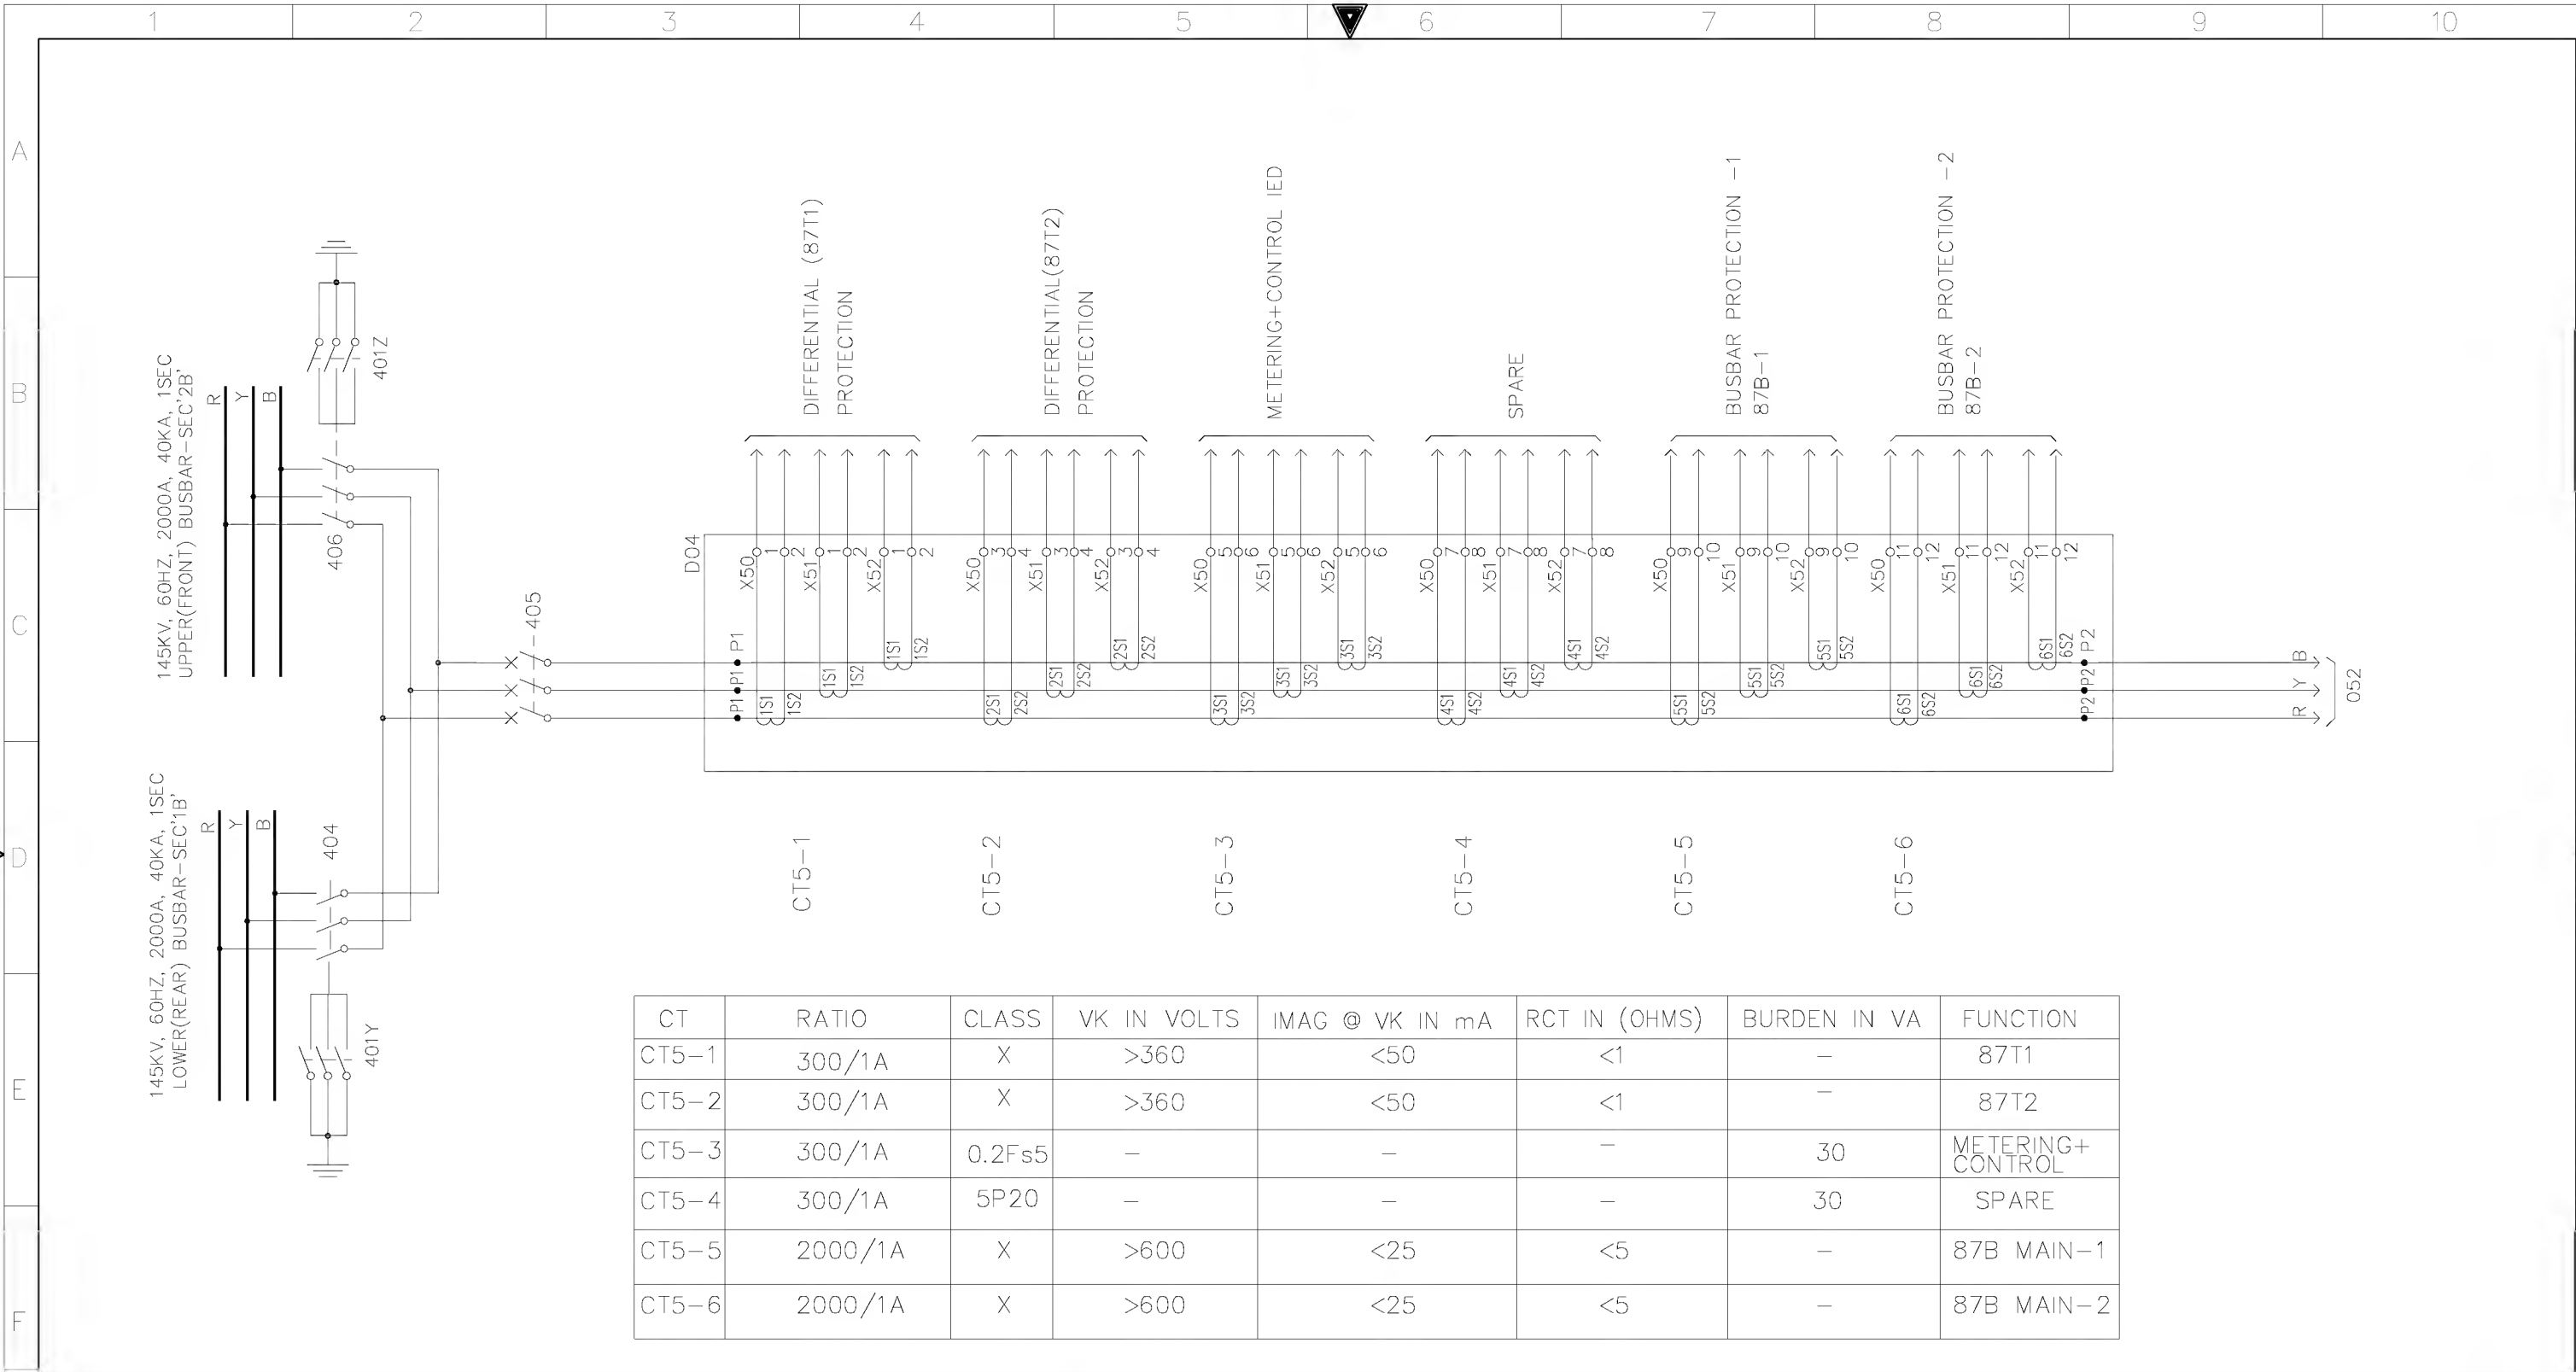


AS-BUILT BY _____ DATE _____			CONTRACT NO. 11131113/00		JOB ORDER NO. S-13656		PRIMARY SYSTEM (GT-3)		<div>الشركة الوطنية لنقل الكهرباء</div> <div>نقل الكهرباء</div> <div>National Grid sa</div>							
G					DRAWN BY RIZ CHECKED BY JKR		132/13.8KV GT-3 RELAY PANEL-1/2		INDEX		PLANT NO.	DRAWING NUMBER		SHEET NO.		REV. NO.
	01	13 49	FACTORY ASBUILT				S/S 8709-132/13.8KV IN AL-KHARJ CITY							SHT		CONT.
	00	13 04	FOR APPROVAL		DATE STARTED 24.01.2013 DATE COMPLETED _____		RIYADH SAUDI ARABIA		-		C421	CD322934		051		052
REV. NO.			DATE		DESCRIPTION		OPRG. DEPT. CTPD ENG. DEPT. AUT-PSAC									

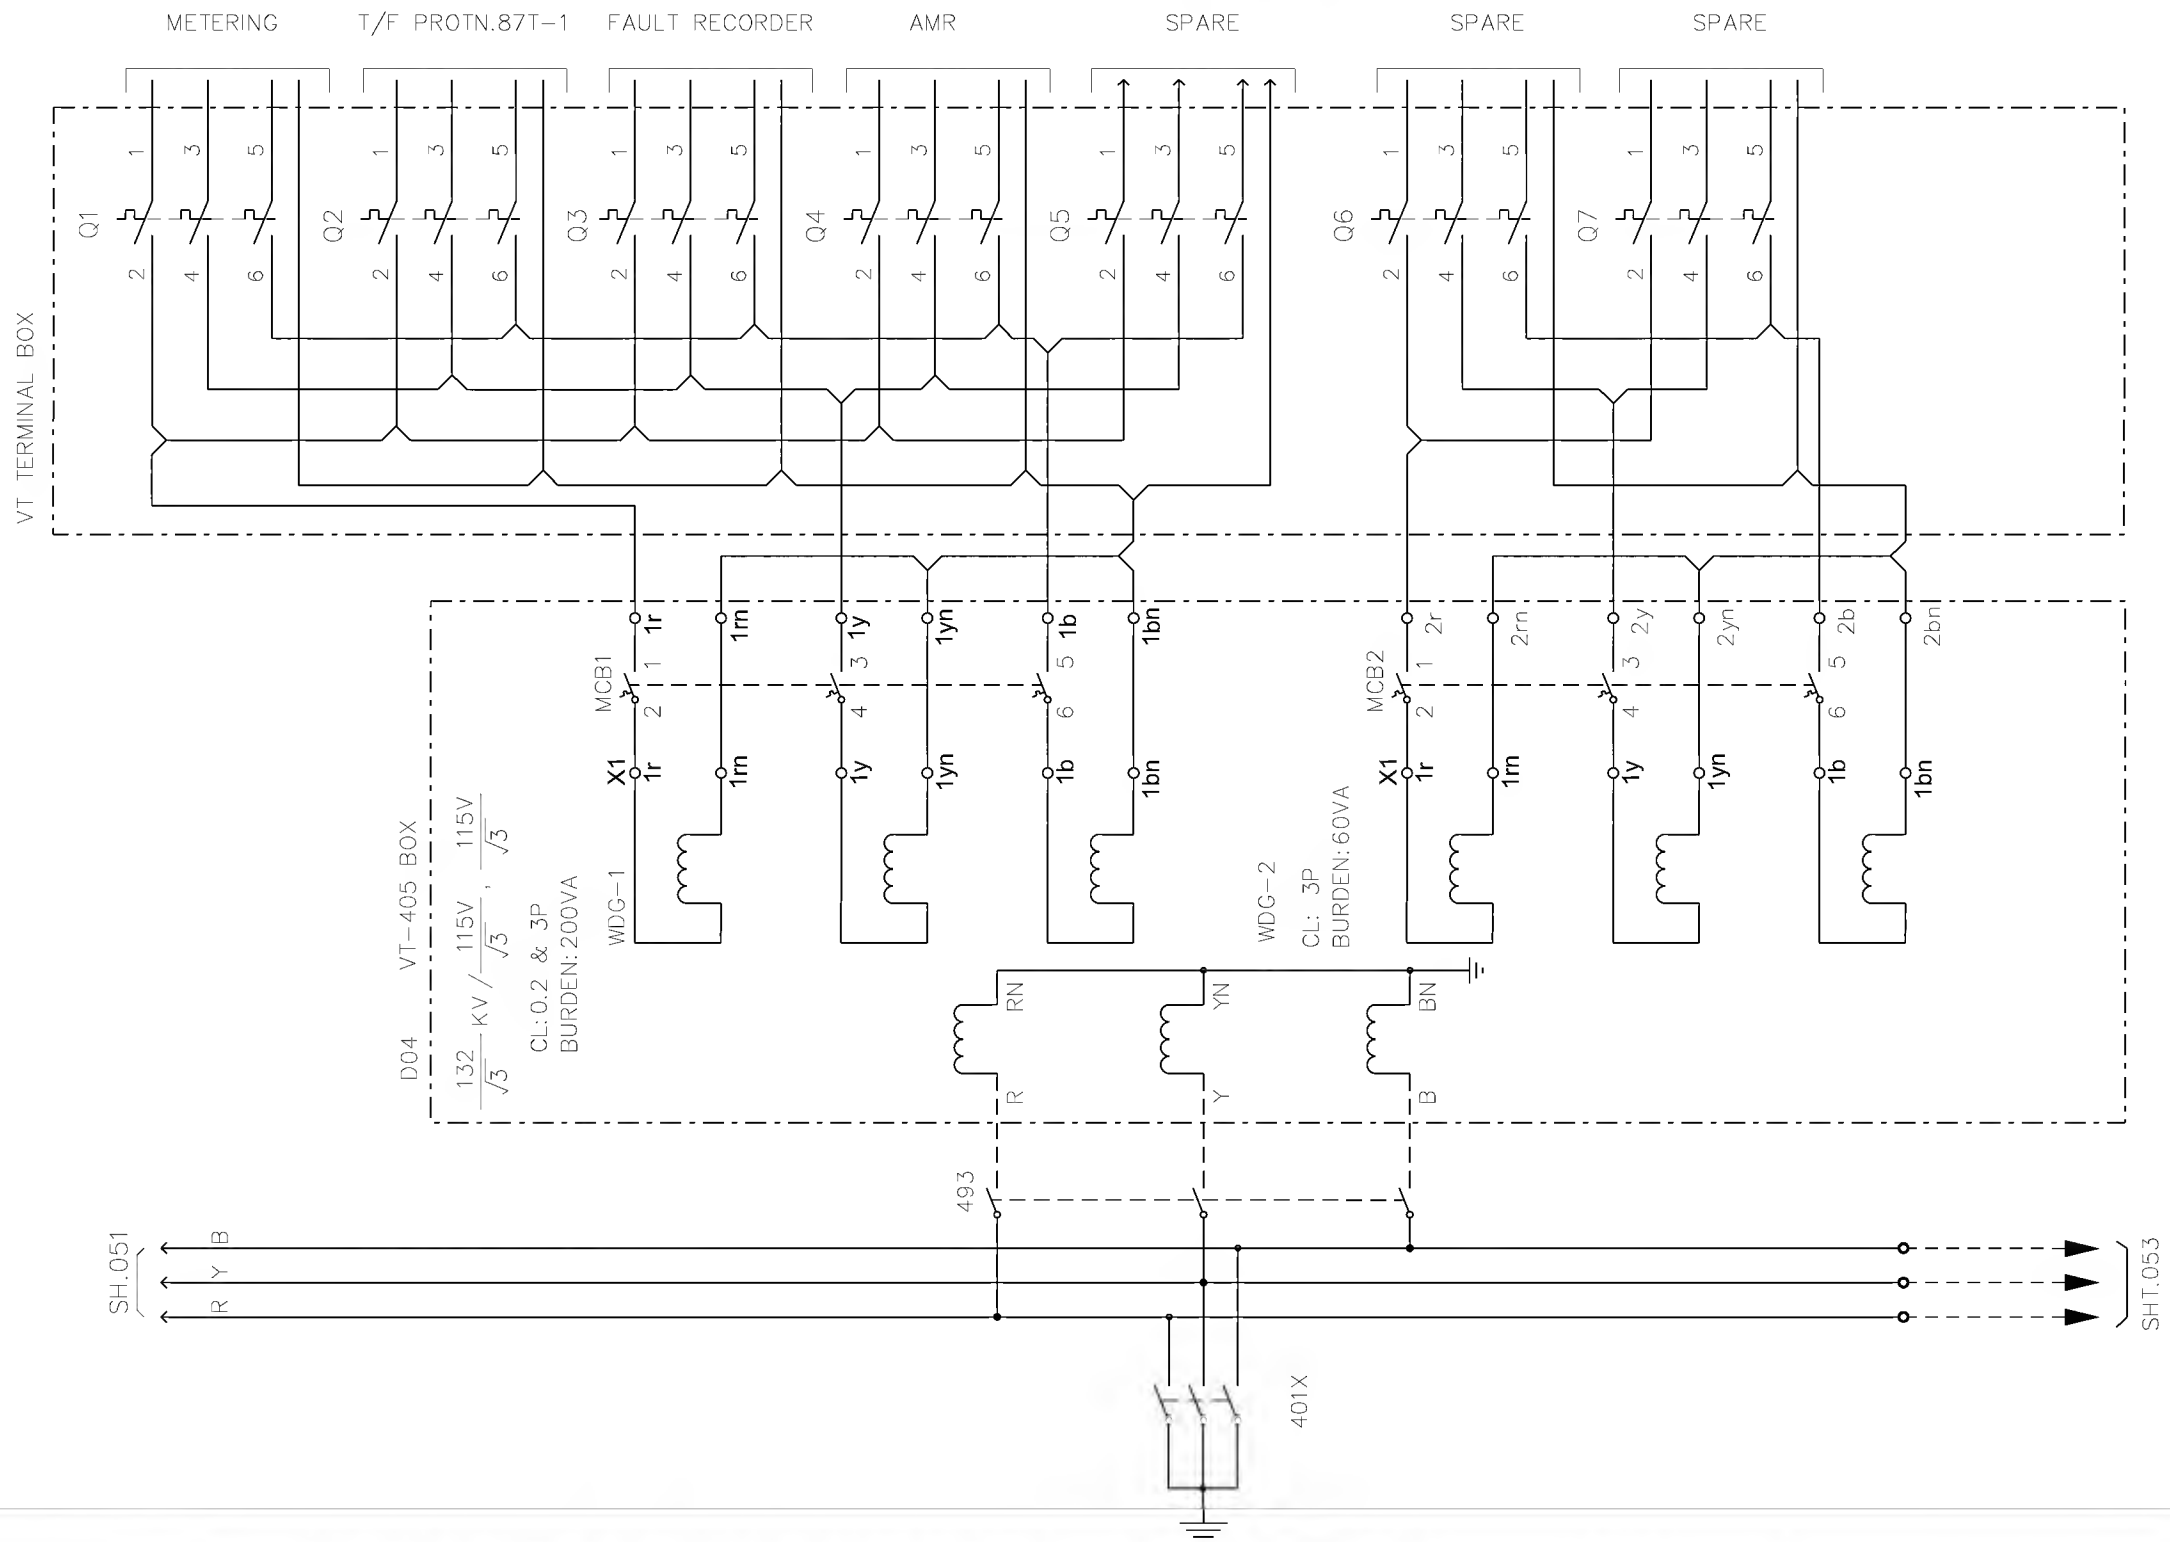


AS-BUILT BY _____		DATE _____	CONTRACT NO. 11131113/00	JOB ORDER NO. S-13656
Ø1	13 49	FACTORY ASBUILT	DRAWN BY RIZ	CHECKED BY JKR
ØØ	13 04	FOR APPROVAL	DATE STARTED 24.01.2013	DATE COMPLETED _____
REV. NO.	DATE	DESCRIPTION	OPRG. DEPT. CTPD	ENG. DEPT. AUT-PSAC

PRIMARY SYSTEM (GT-3)
132/13.8KV GT-3 RELAY PANEL-1/2
S/S 8709-132/13.8KV IN AL-KHARJ CITY
RIYADH SAUDI ARABIA

الشركة الوطنية لنقل الكهرباء		نقل الكهرباء	
National Grid sa		National Grid sa	
INDEX	PLANT NO.	DRAWING NUMBER	SHEET NO.
-	C421	CD322934	052 053
		REV. NO.	01

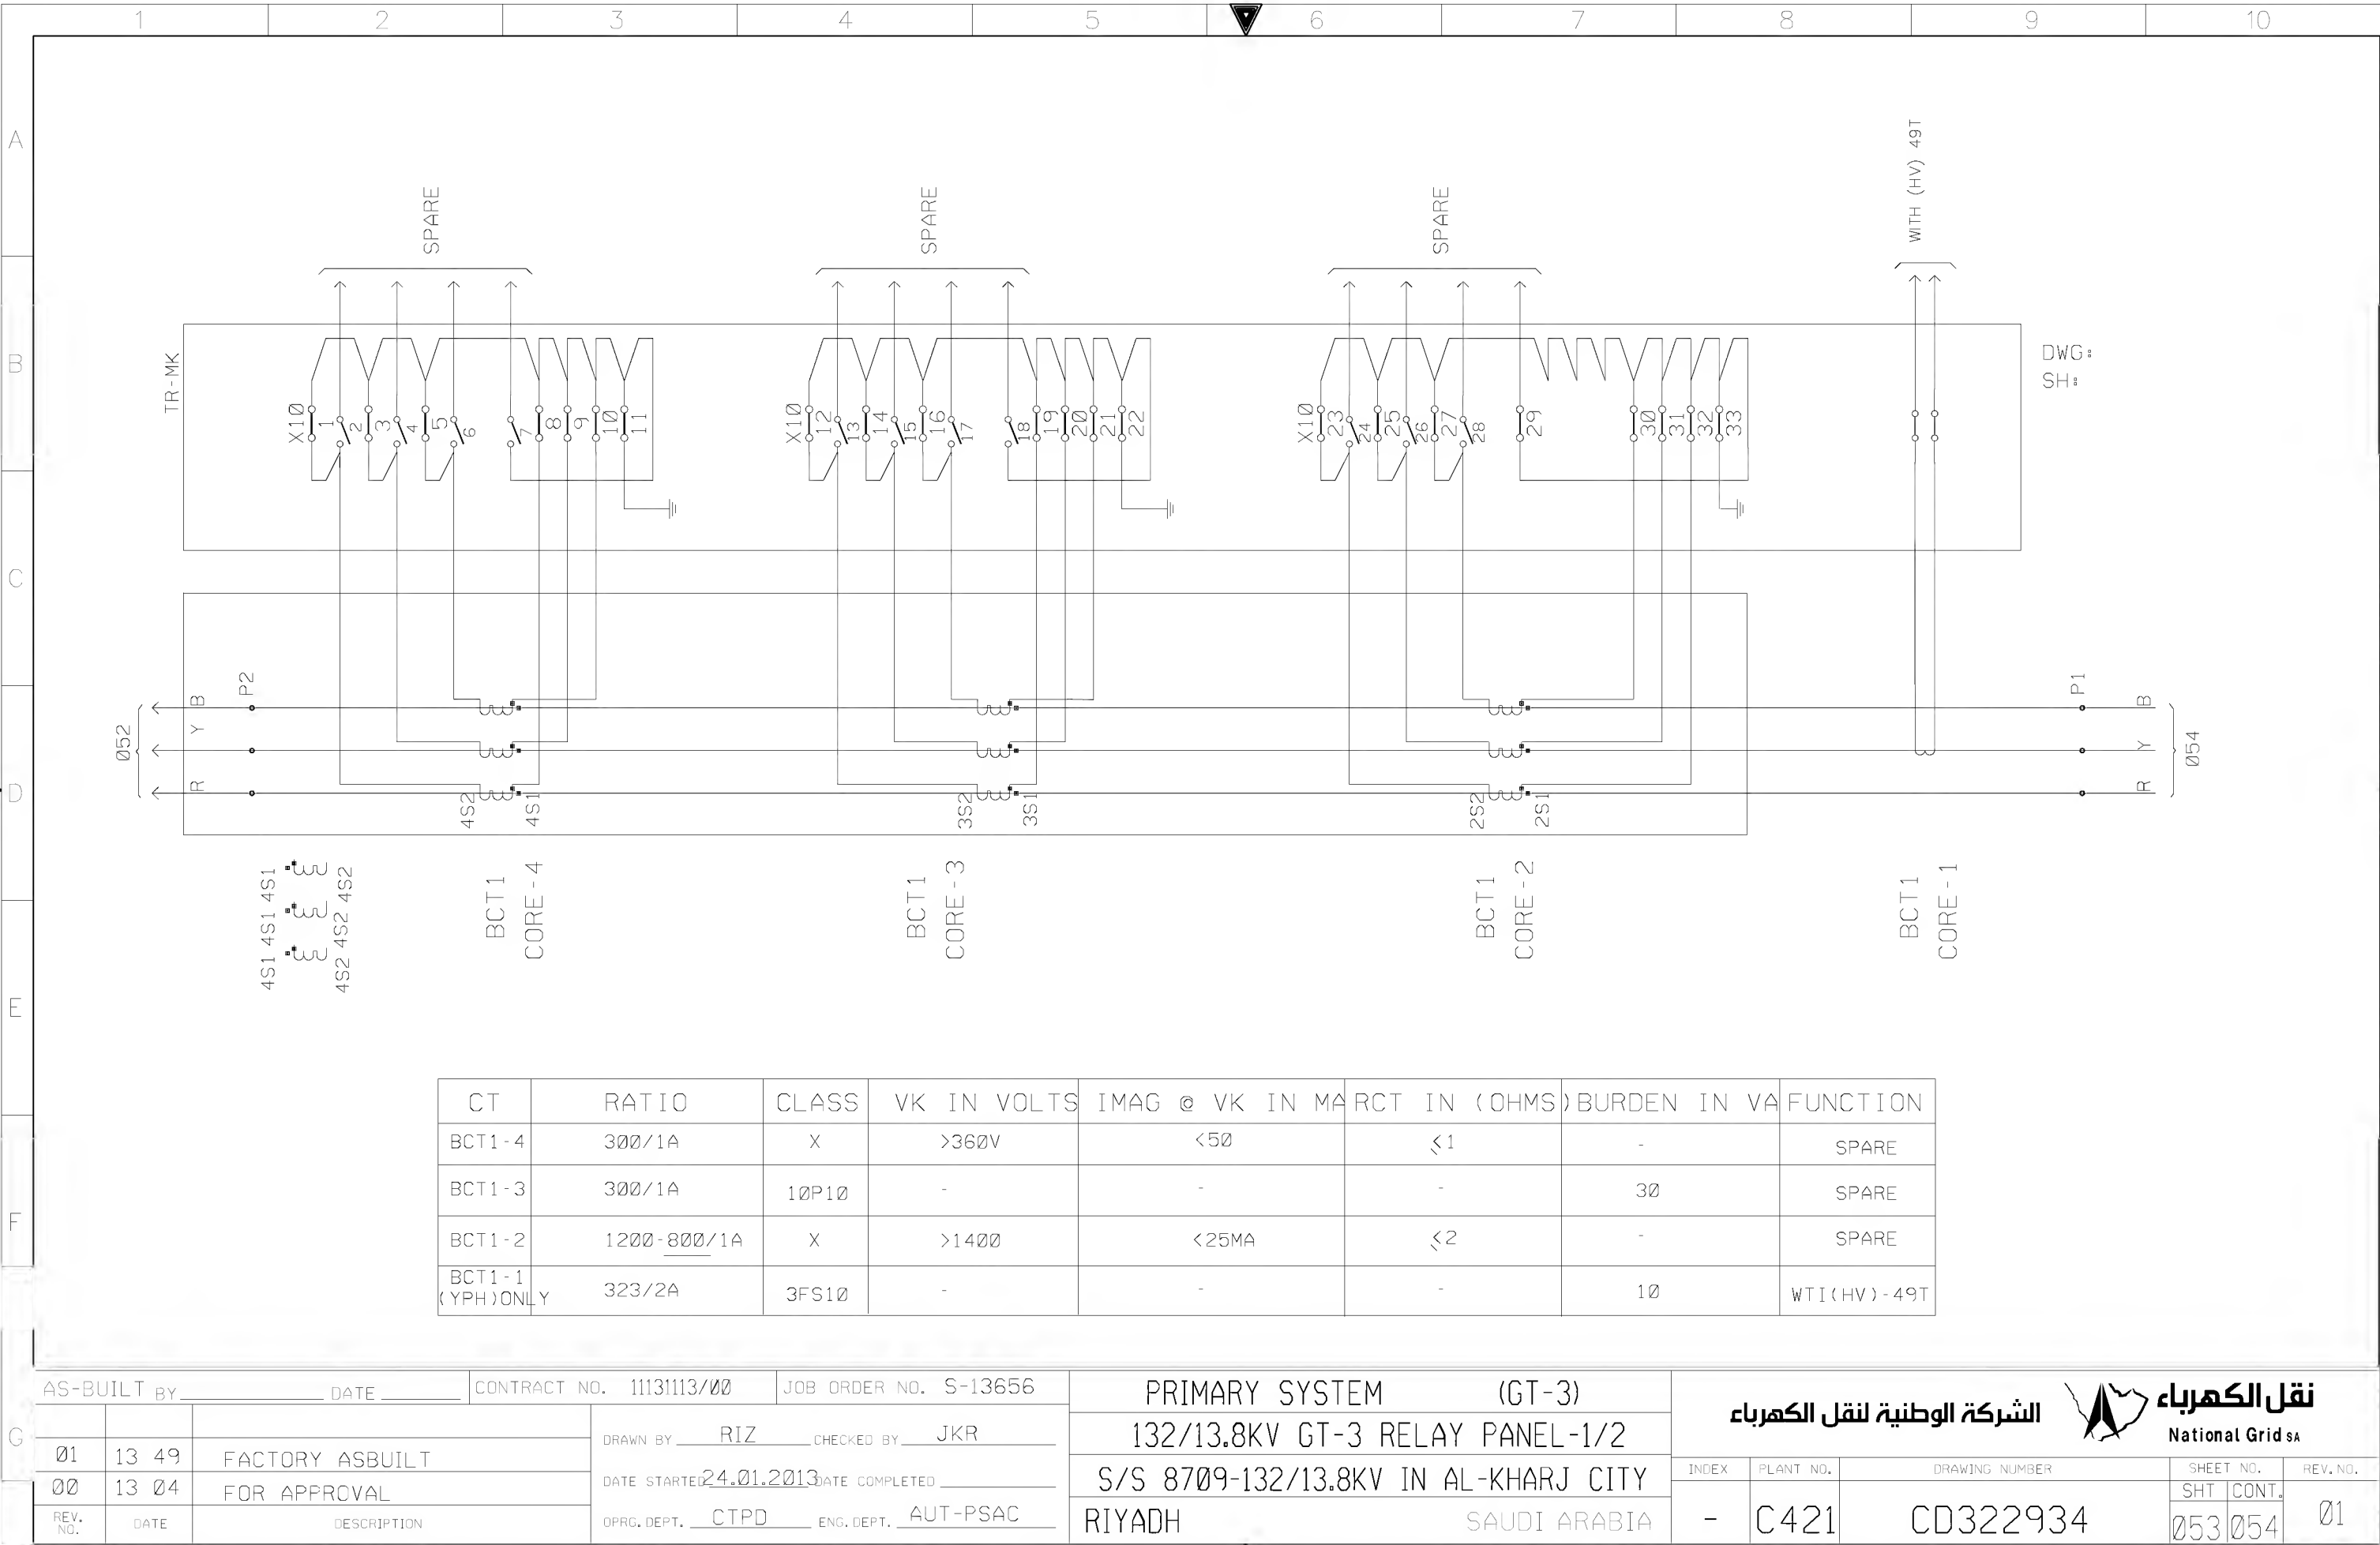


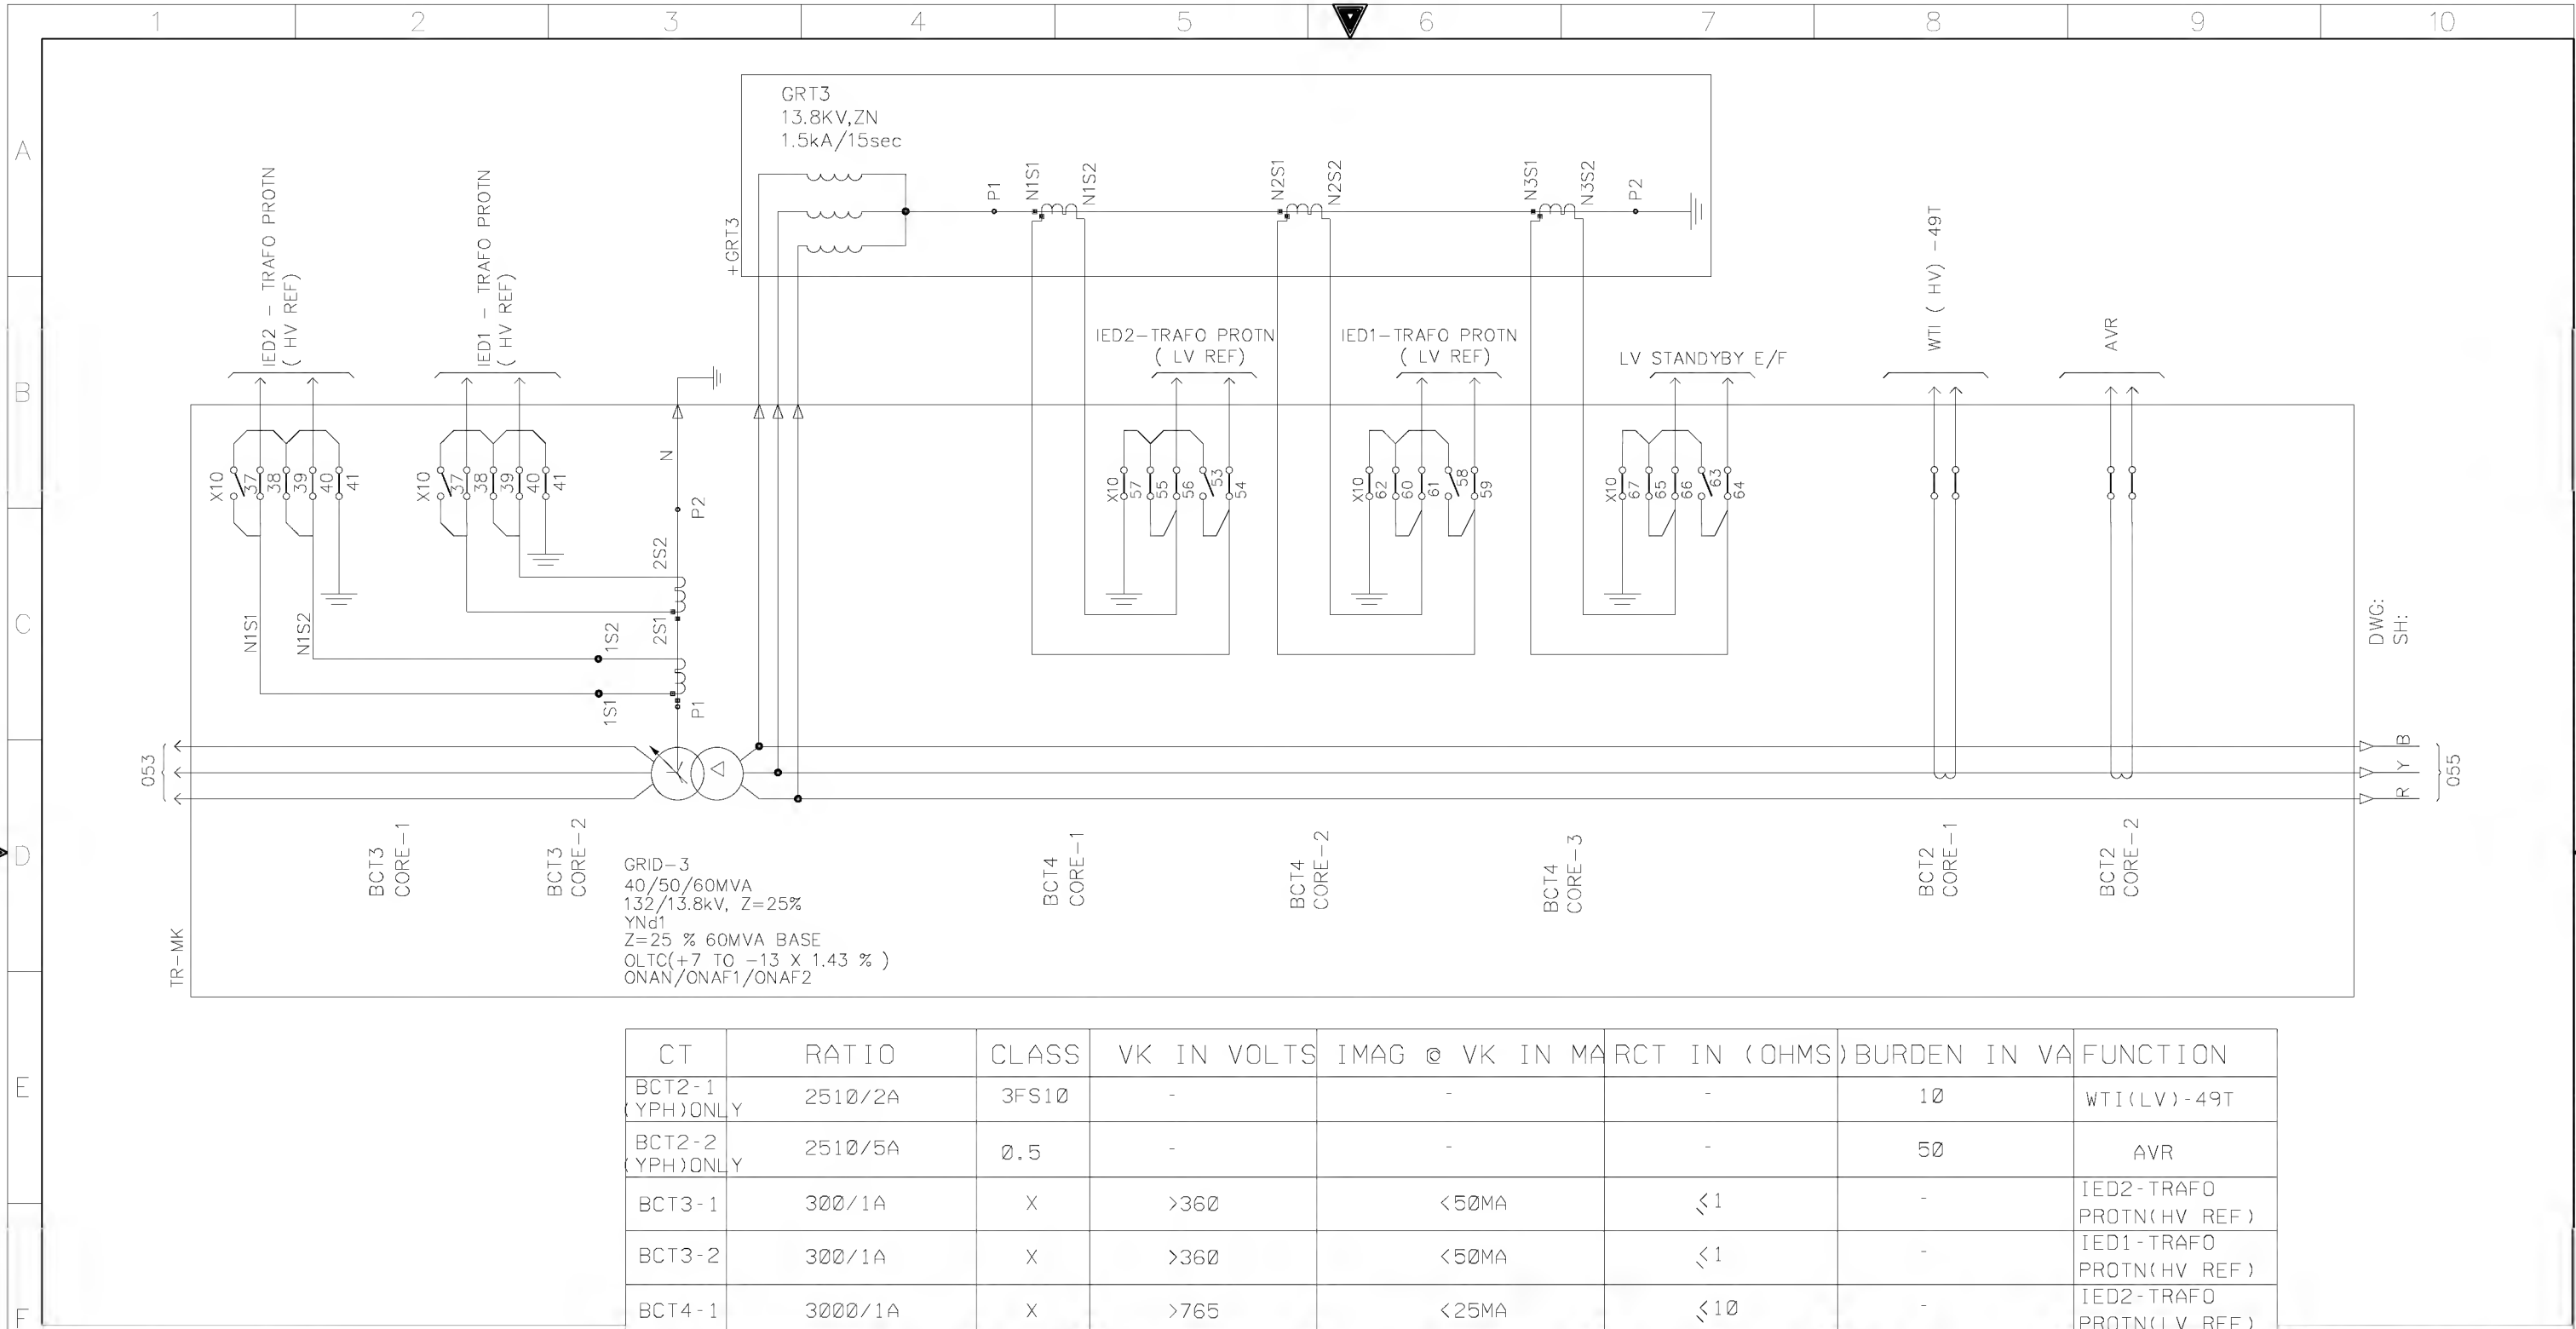


AS-BUILT BY _____ DATE _____			CONTRACT NO. 11131113/00		JOB ORDER NO. S-13656	
01	13 49	FACTORY ASBUILT	DRAWN BY RIZ		CHECKED BY JKR	
00	13 04	FOR APPROVAL	DATE STARTED 24.01.2013		DATE COMPLETED _____	
REV. NO.	DATE	DESCRIPTION	OPRG. DEPT. CTPD		ENG. DEPT. AUT-PSAC	

PRIMARY SYSTEM (GT-3)	
132/13.8KV GT-3 RELAY PANEL-1/2	
S/S 8709-132/13.8KV IN AL-KHARJ CITY	
RIYADH SAUDI ARABIA	

الشركة الوطنية لنقل الكهرباء National Grid sa				
INDEX	PLANT NO.	DRAWING NUMBER	SHEET NO.	REV. NO.
-	C421	CD322934	054	01

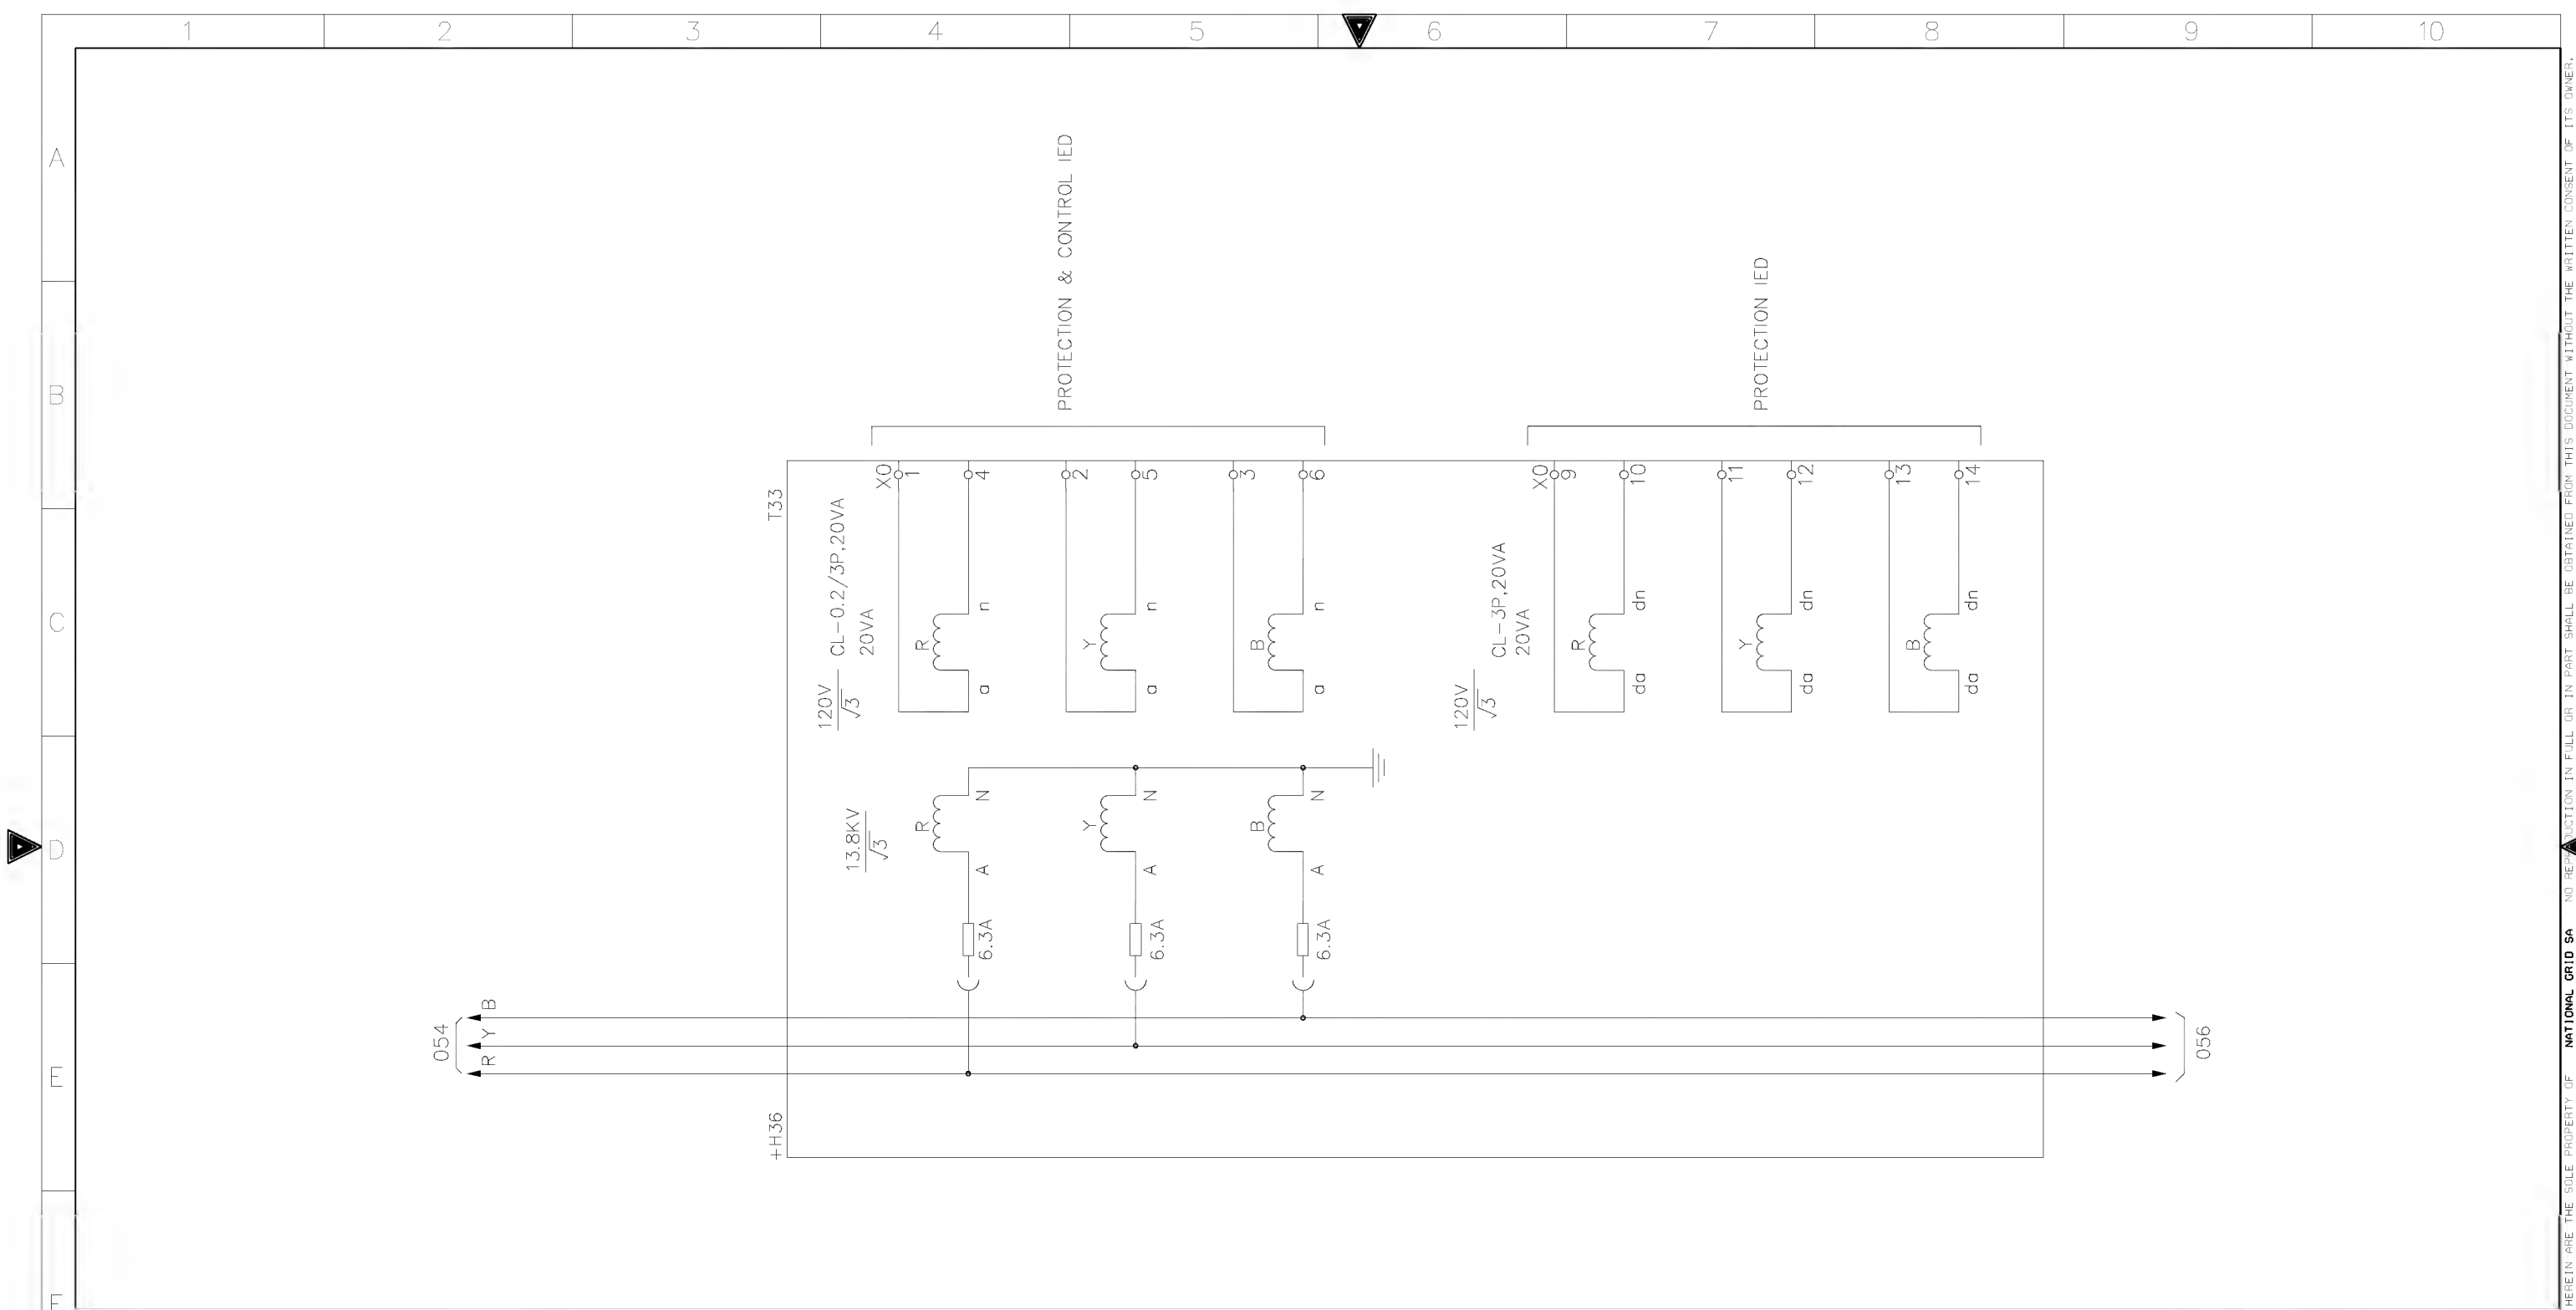


AS-BUILT BY _____ DATE _____			CONTRACT NO. 11131113/00		JOB ORDER NO. S-13656		PRIMARY SYSTEM (GT-3)		<div>الشركة الوطنية لنقل الكهرباء</div> <div>نقل الكهرباء</div> <div>National Grid sa</div>									
01	13 49	FACTORY ASBUILT	DRAWN BY RIZ		CHECKED BY JKR		132/13.8KV GT-3 RELAY PANEL-1/2		INDEX		PLANT NO.		DRAWING NUMBER		SHEET NO.		REV. NO.	
00	13 04	FOR APPROVAL	DATE STARTED 24.01.2013		DATE COMPLETED		S/S 8709-132/13.8KV IN AL-KHARJ CITY		-		C421		CD322934		SHT 055		CONT. 056	
REV. NO.	DATE	DESCRIPTION	OPRG. DEPT. CTPD		ENG. DEPT. AUT-PSAC		RIYADH SAUDI ARABIA										01	

DMS




VECTOR

NGD200

NG/D2-D (2012/01)

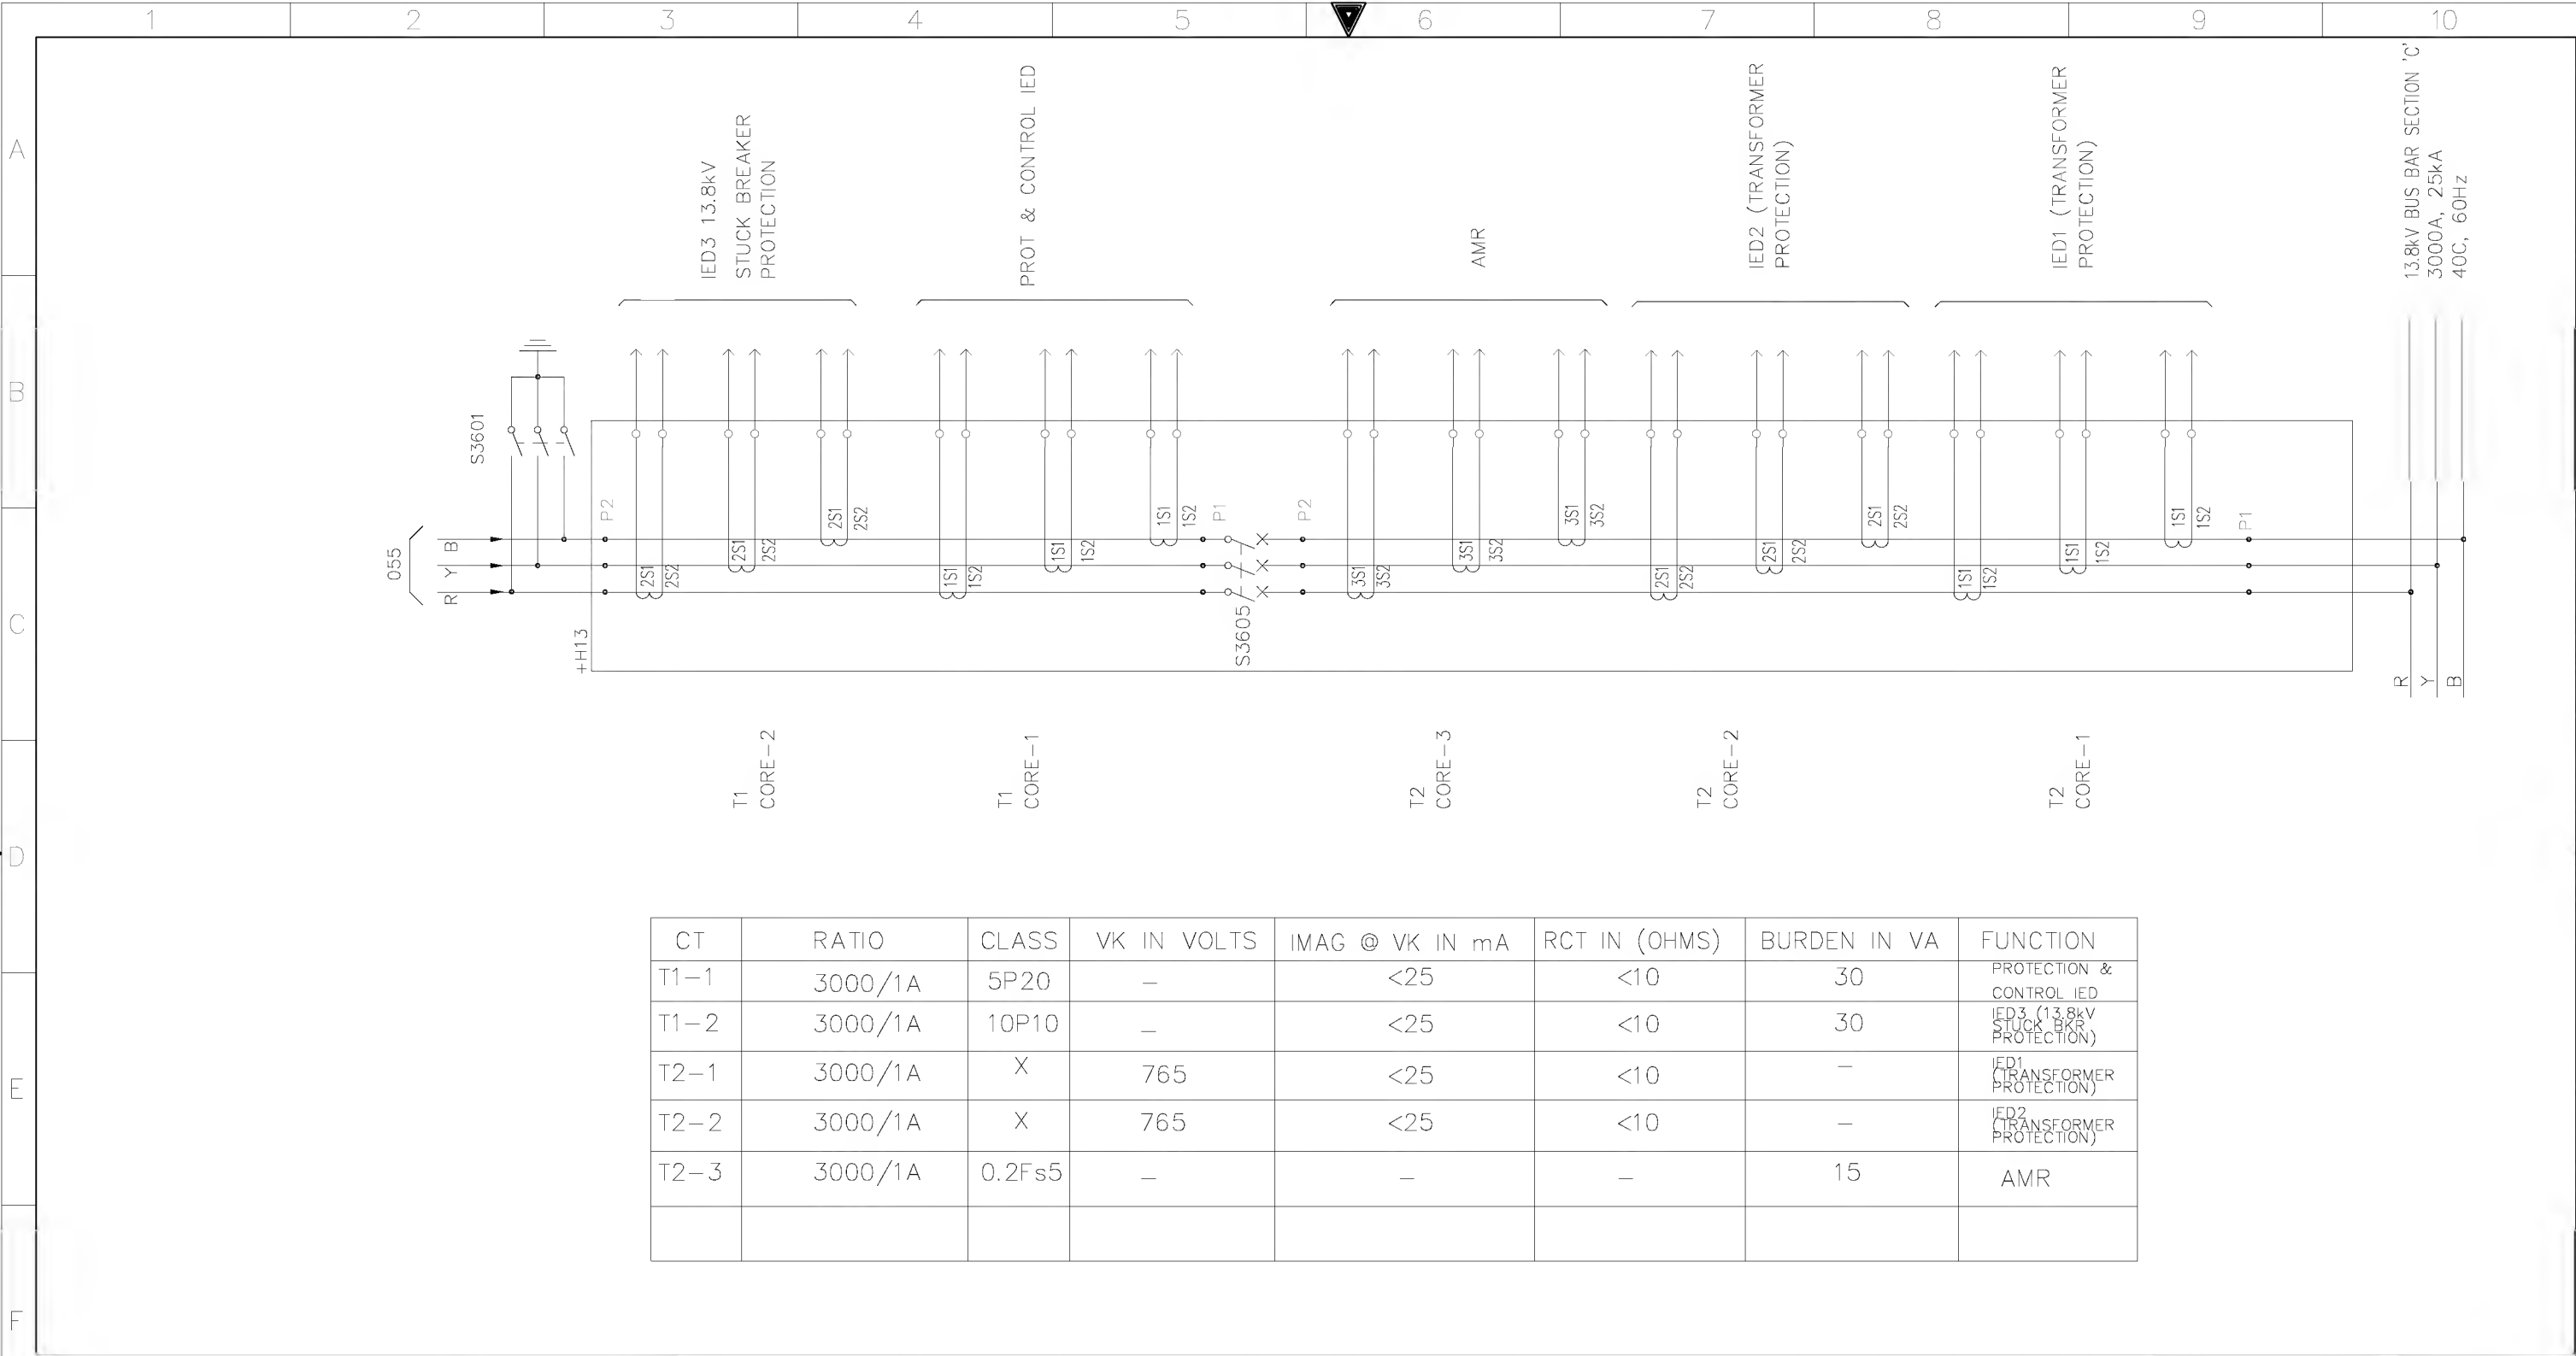

AS-BUILT BY _____ DATE _____			CONTRACT NO. 11131113/00		JOB ORDER NO. S-13656		PRIMARY SYSTEM (GT-3)		<div>الشركة الوطنية لنقل الكهرباء</div> <div>نقل الكهرباء</div> <div>National Grid sa</div>									
			DRAWN BY RIZ		CHECKED BY JKR		132/13.8KV GT-3 RELAY PANEL-1/2											
			DATE STARTED 24.01.2013		DATE COMPLETED _____		S/S 8709-132/13.8KV IN AL-KHARJ CITY											
01 13 49			FACTORY ASBUILT				S/S 8709-132/13.8KV IN AL-KHARJ CITY		INDEX		PLANT NO.		DRAWING NUMBER		SHEET NO.		REV. NO.	
00 13 04			FOR APPROVAL				RIYADH SAUDI ARABIA		-		C421		CD322934		SHT 056		CONT. 211	
REV. NO.			DATE		DESCRIPTION		OPRG. DEPT. CTPD		ENG. DEPT. AUT-PSAC								01	

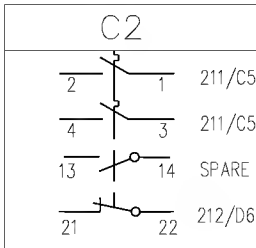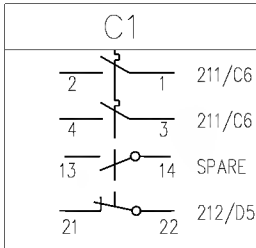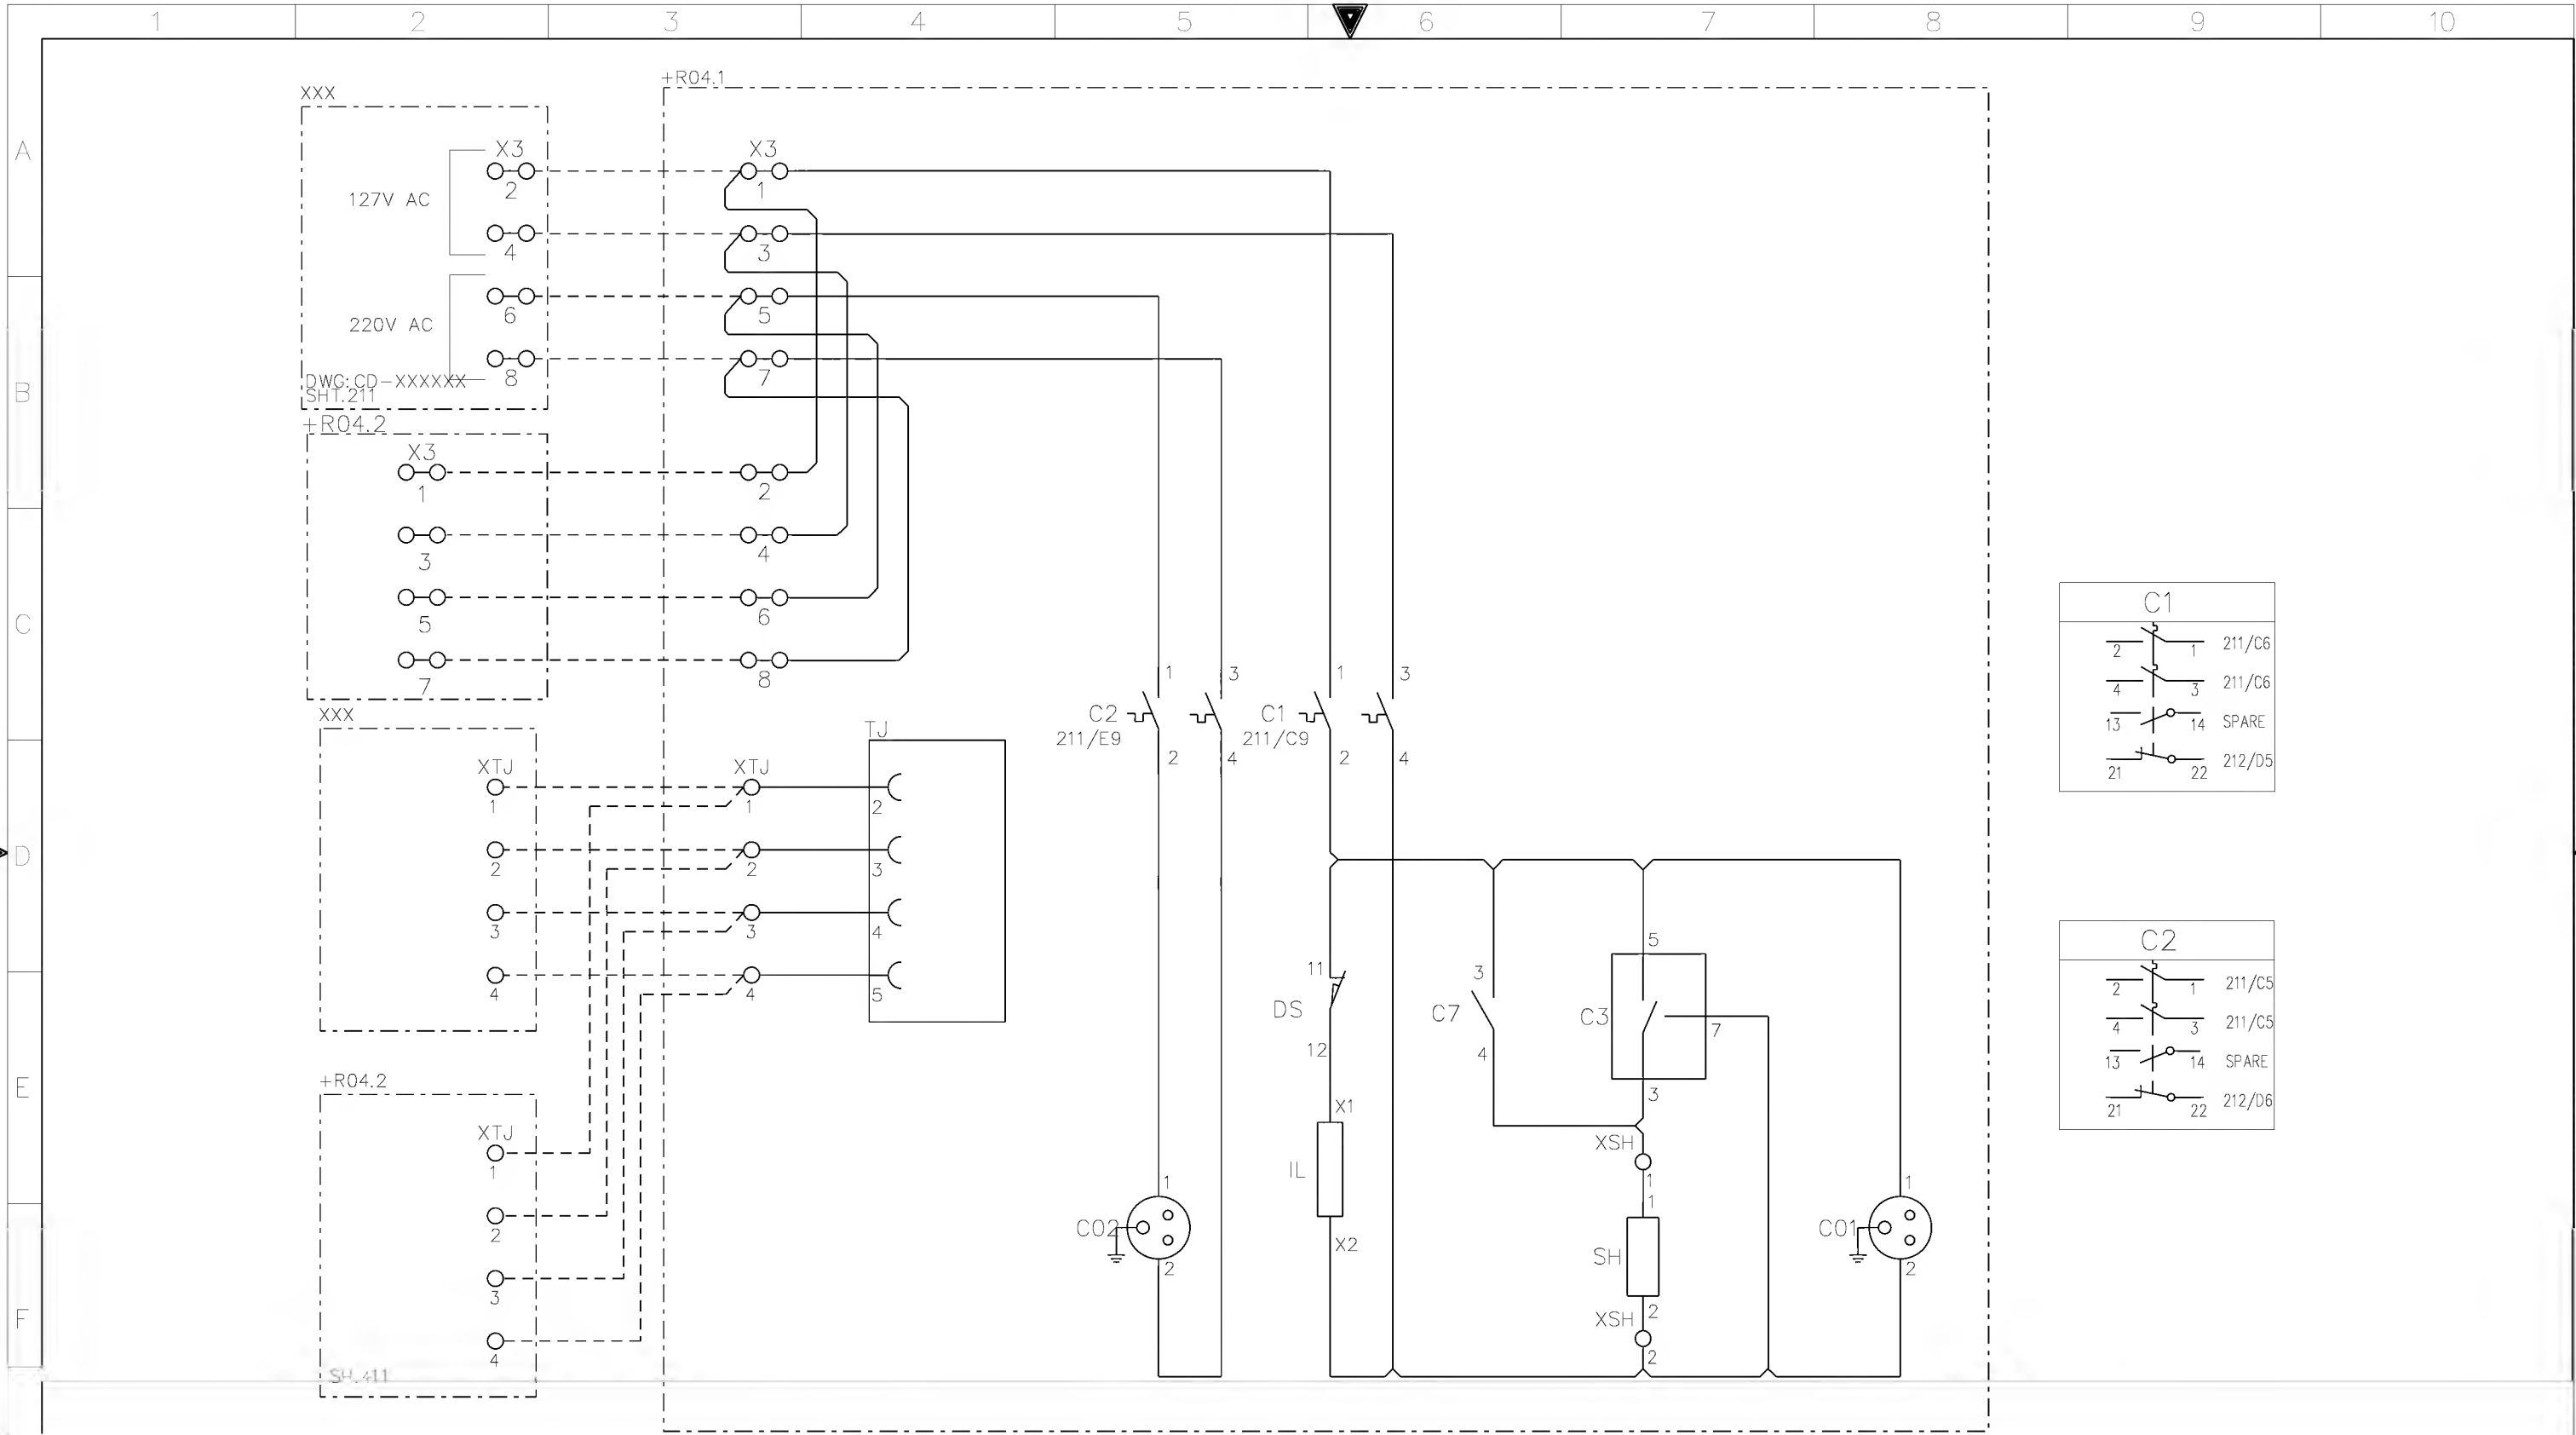


AS-BUILT BY _____ DATE _____ CONTRACT NO. 11131113/00 JOB ORDER NO. S-13656

01	13 49	FACTORY ASBUILT	DRAWN BY RIZ	CHECKED BY JKR
00	13 04	FOR APPROVAL	DATE STARTED 24.01.2013	DATE COMPLETED
REV. NO.	DATE	DESCRIPTION	OPRG. DEPT. CTPD	ENG. DEPT. AUT-PSAC

AC SUPPLY FOR ILLUMINATION & POWER SOCKET
132/13.8kV GT-3 RELAY PANEL-1 +R04.1
S/S 8709-132/13.8KV IN AL-KHARJ CITY
RIYADH SAUDI ARABIA

الشركة الوطنية لنقل الكهرباء
National Grid sa

INDEX	PLANT NO.	DRAWING NUMBER	SHEET NO.	REV. NO.
-	C421	CD322934	SHT 211	CONT. 212
				01

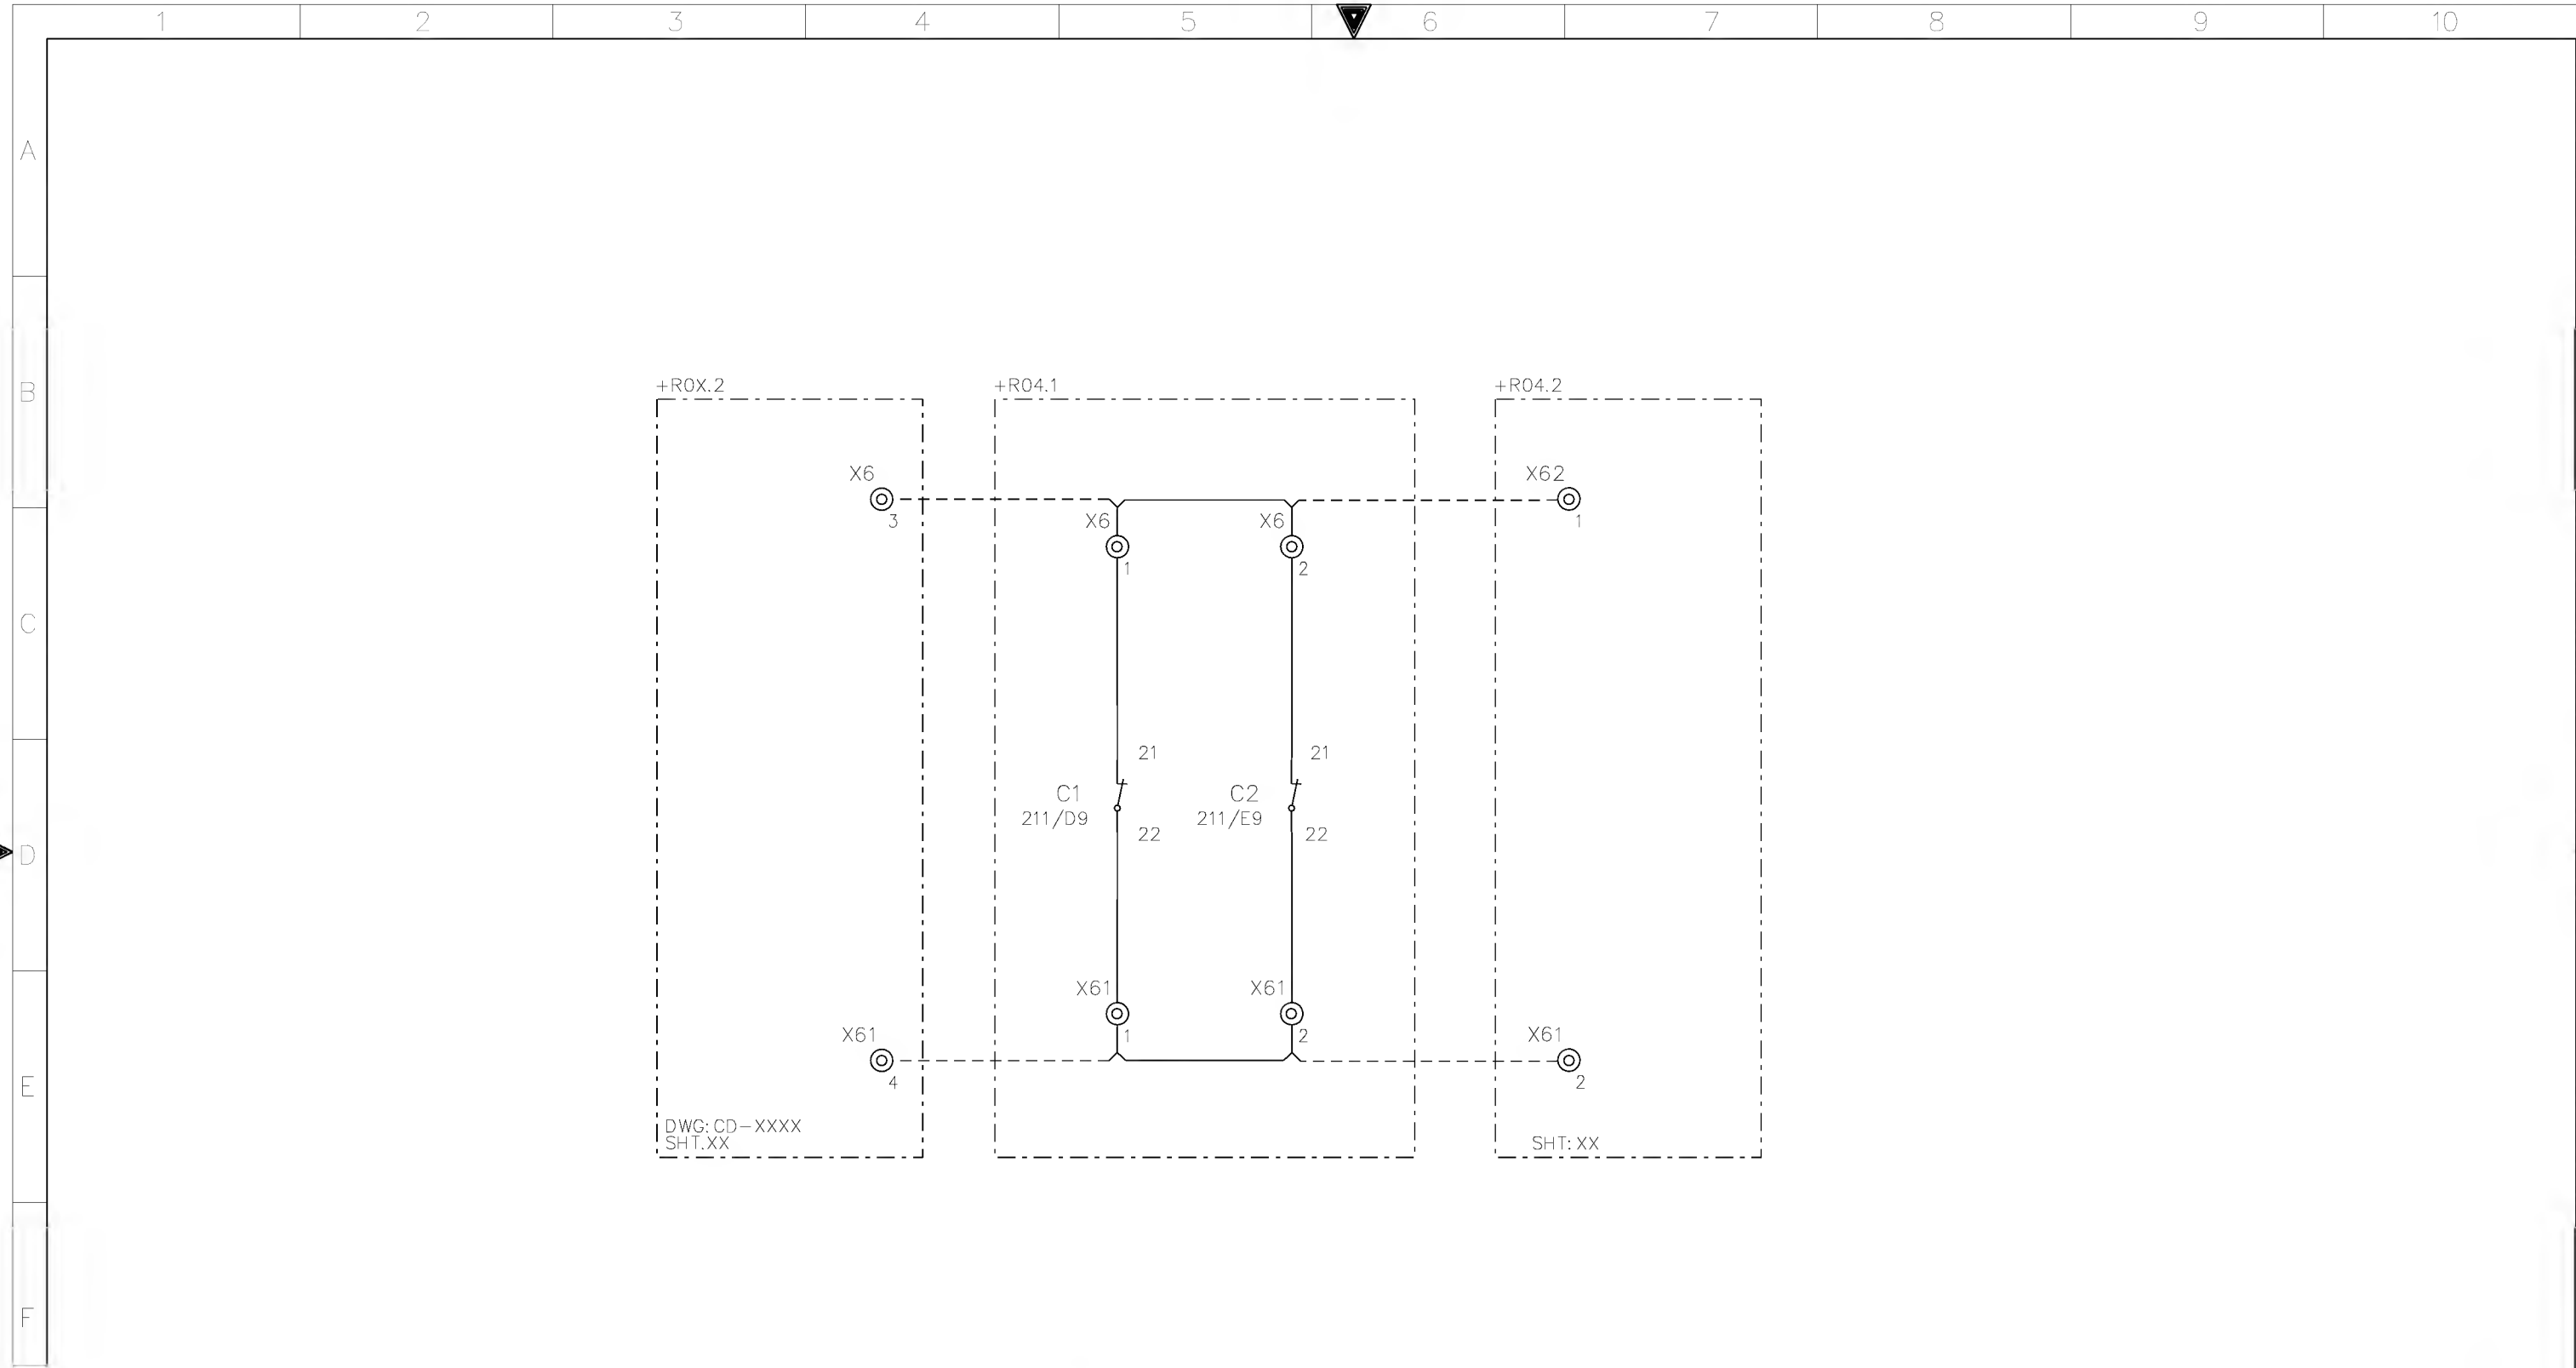


AS-BUILT BY _____ DATE _____ CONTRACT NO. 11131113/00 JOB ORDER NO. S-13656


01	13 49	FACTORY ASBUILT	DRAWN BY RIZ	CHECKED BY JKR
00	13 04	FOR APPROVAL	DATE STARTED 24.01.2013	DATE COMPLETED
REV. NO.	DATE	DESCRIPTION	OPRG. DEPT. CTPD	ENG. DEPT. AUT-PSAC

CUB.LIGHTING,HEATER&SOKET ALARM CKT.
132/13.8kv GT-3 RELAY PANEL-1 +R04.1
S/S 8709-132/13.8KV IN AL-KHARJ CITY
RIYADH SAUDI ARABIA

الشركة الوطنية لنقل الكهرباء		نقل الكهرباء		National Grid sa	
INDEX	PLANT NO.	DRAWING NUMBER	SHEET NO.	REV. NO.	
-	C421	CD322934	SHT 212	CONT. 216	01

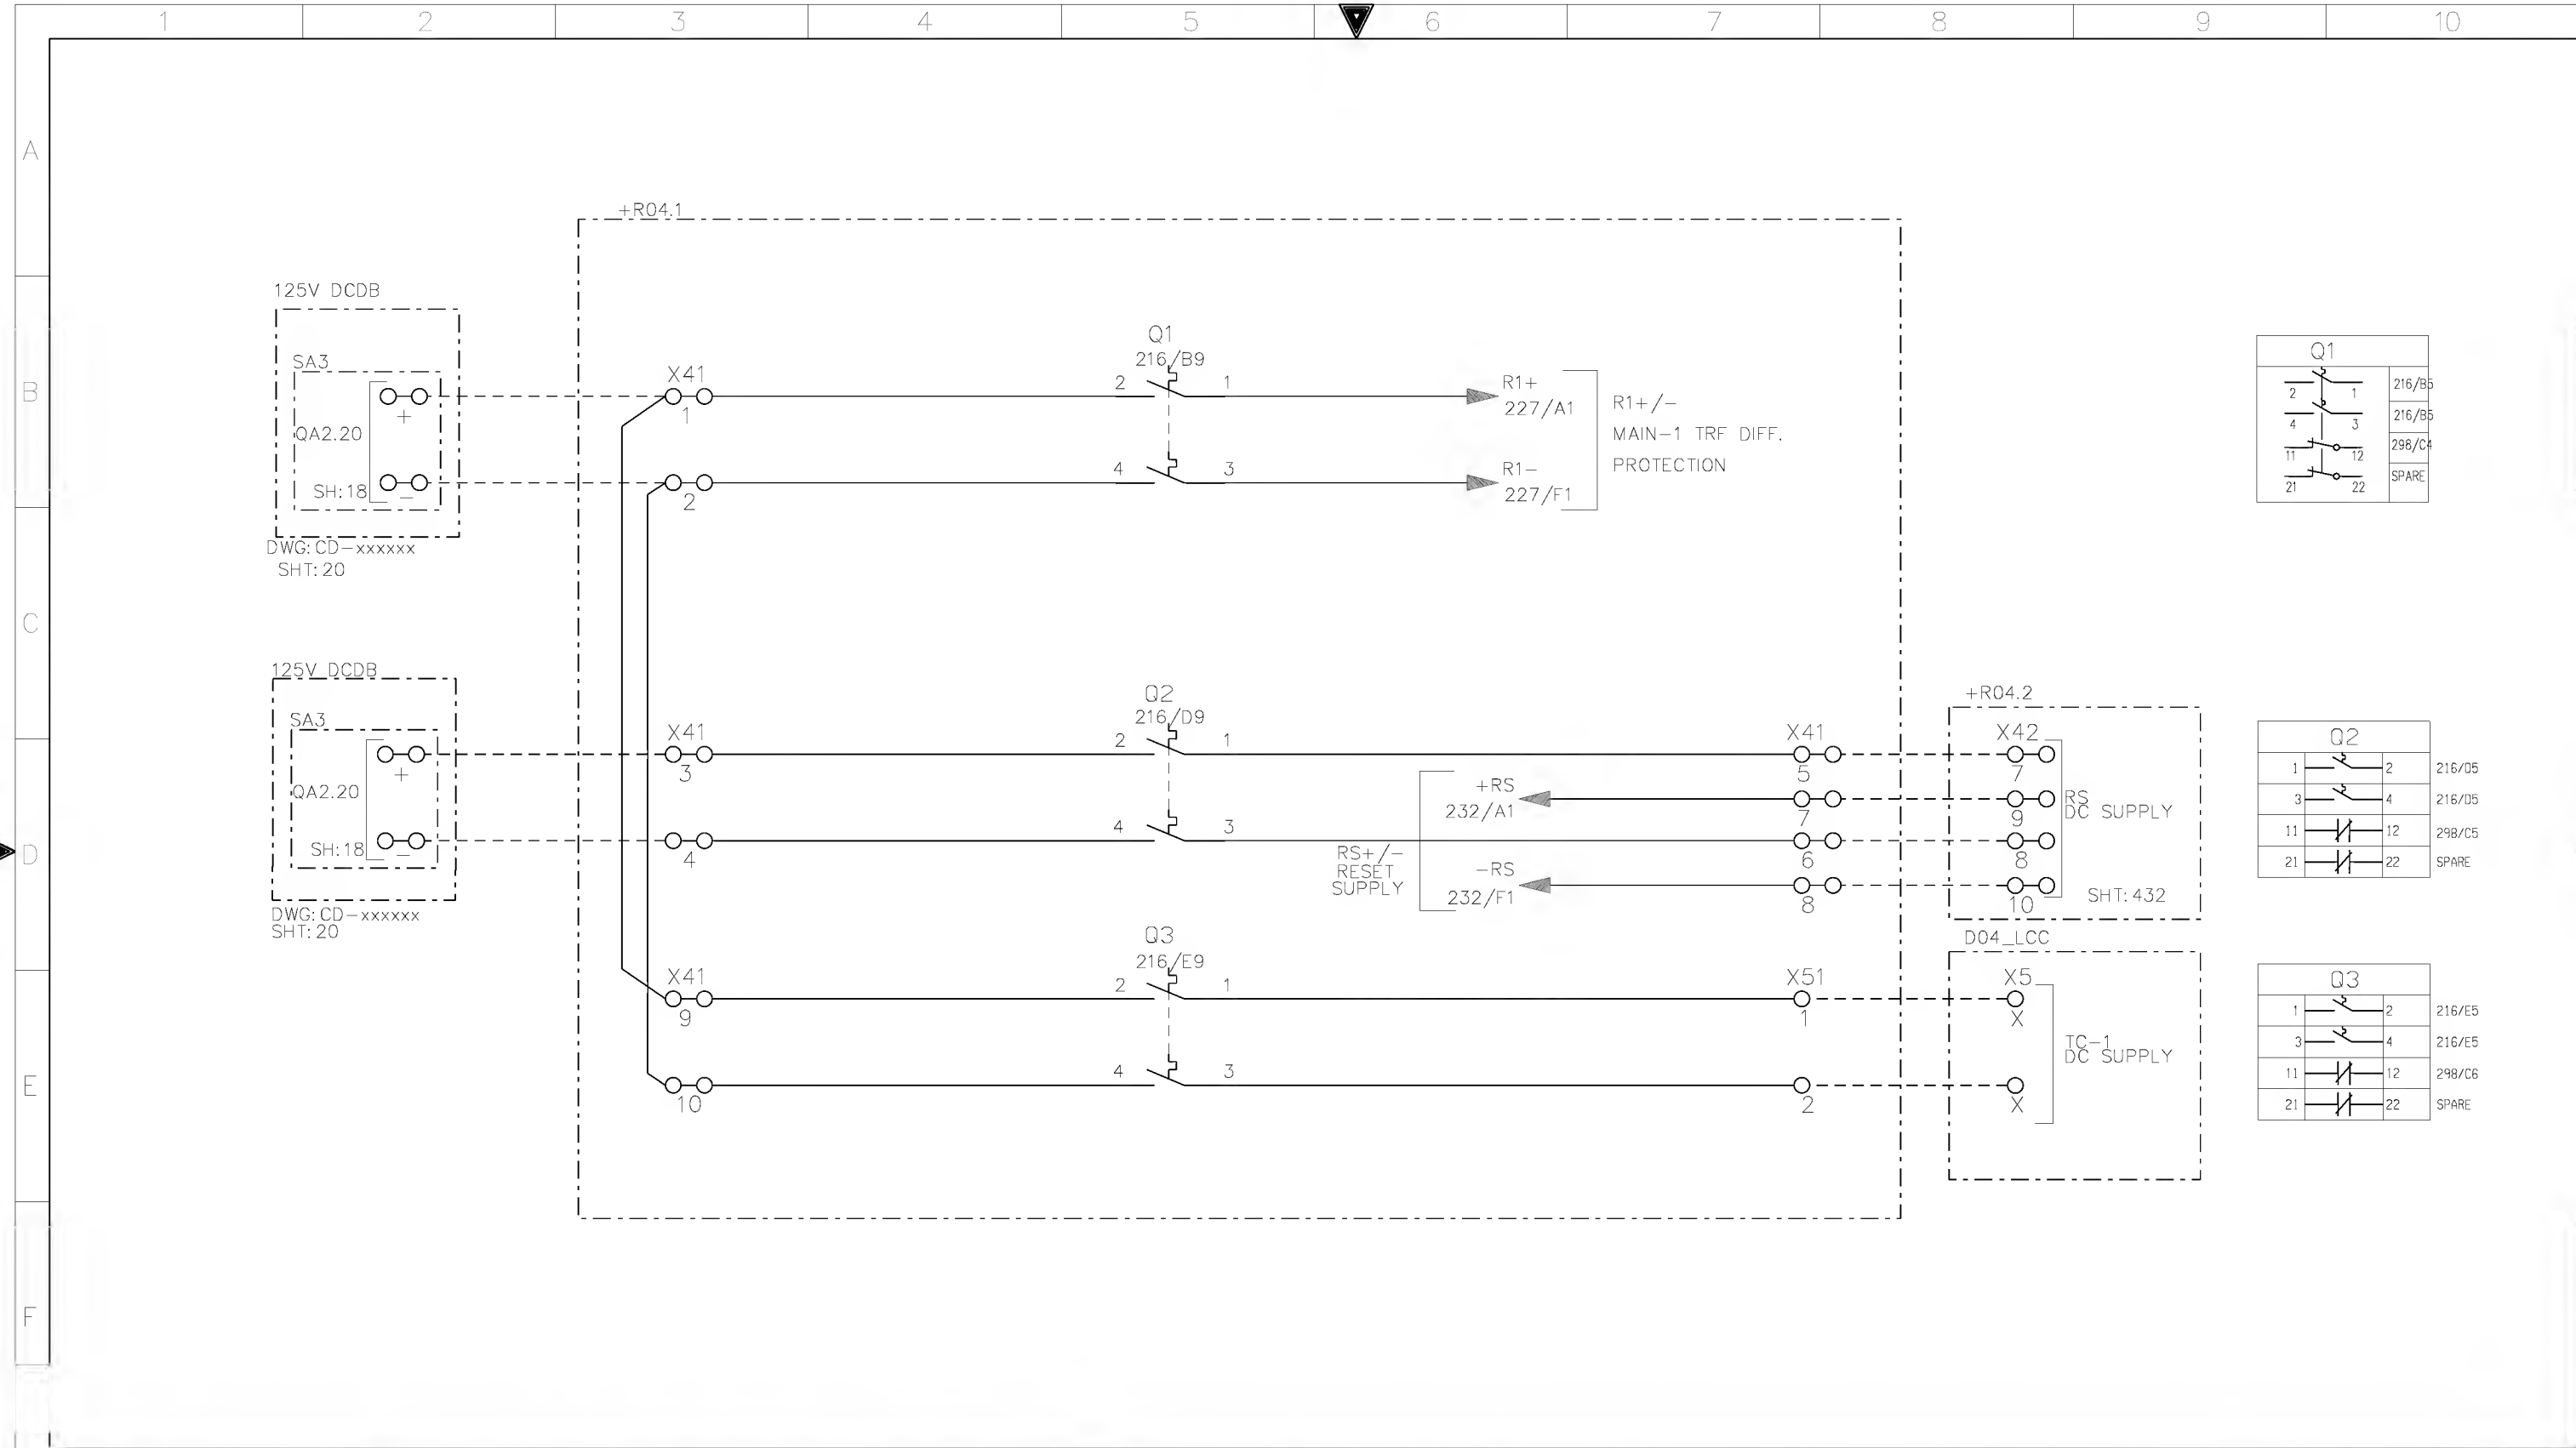

G	AS-BUILT BY _____ DATE _____		CONTRACT NO. 11131113/00		JOB ORDER NO. S-13656		DC SUPPLY DISTRIBUTION		<div>الشركة الوطنية لنقل الكهرباء</div> <div>National Grid sa</div>				
					DRAWN BY <u>RIZ</u> CHECKED BY <u>JKR</u>		132/13.8kv GT-3 RELAY PANEL-1 +R04.1						
	01	13 49	FACTORY ASBUILT		DATE STARTED <u>24.01.2013</u> DATE COMPLETED _____		S/S 8709-132/13.8KV IN AL-KHARJ CITY		INDEX	PLANT NO.			
	00	13 04	FOR APPROVAL		OPRG. DEPT. <u>CTPD</u> ENG. DEPT. <u>AUT-PSAC</u>		RIYADH SAUDI ARABIA		-	C421			
		REV. NO.	DATE	DESCRIPTION				DRAWING NUMBER		SHEET NO.		REV. NO.	
										SHT		CONT.	
										216		221	
												01	

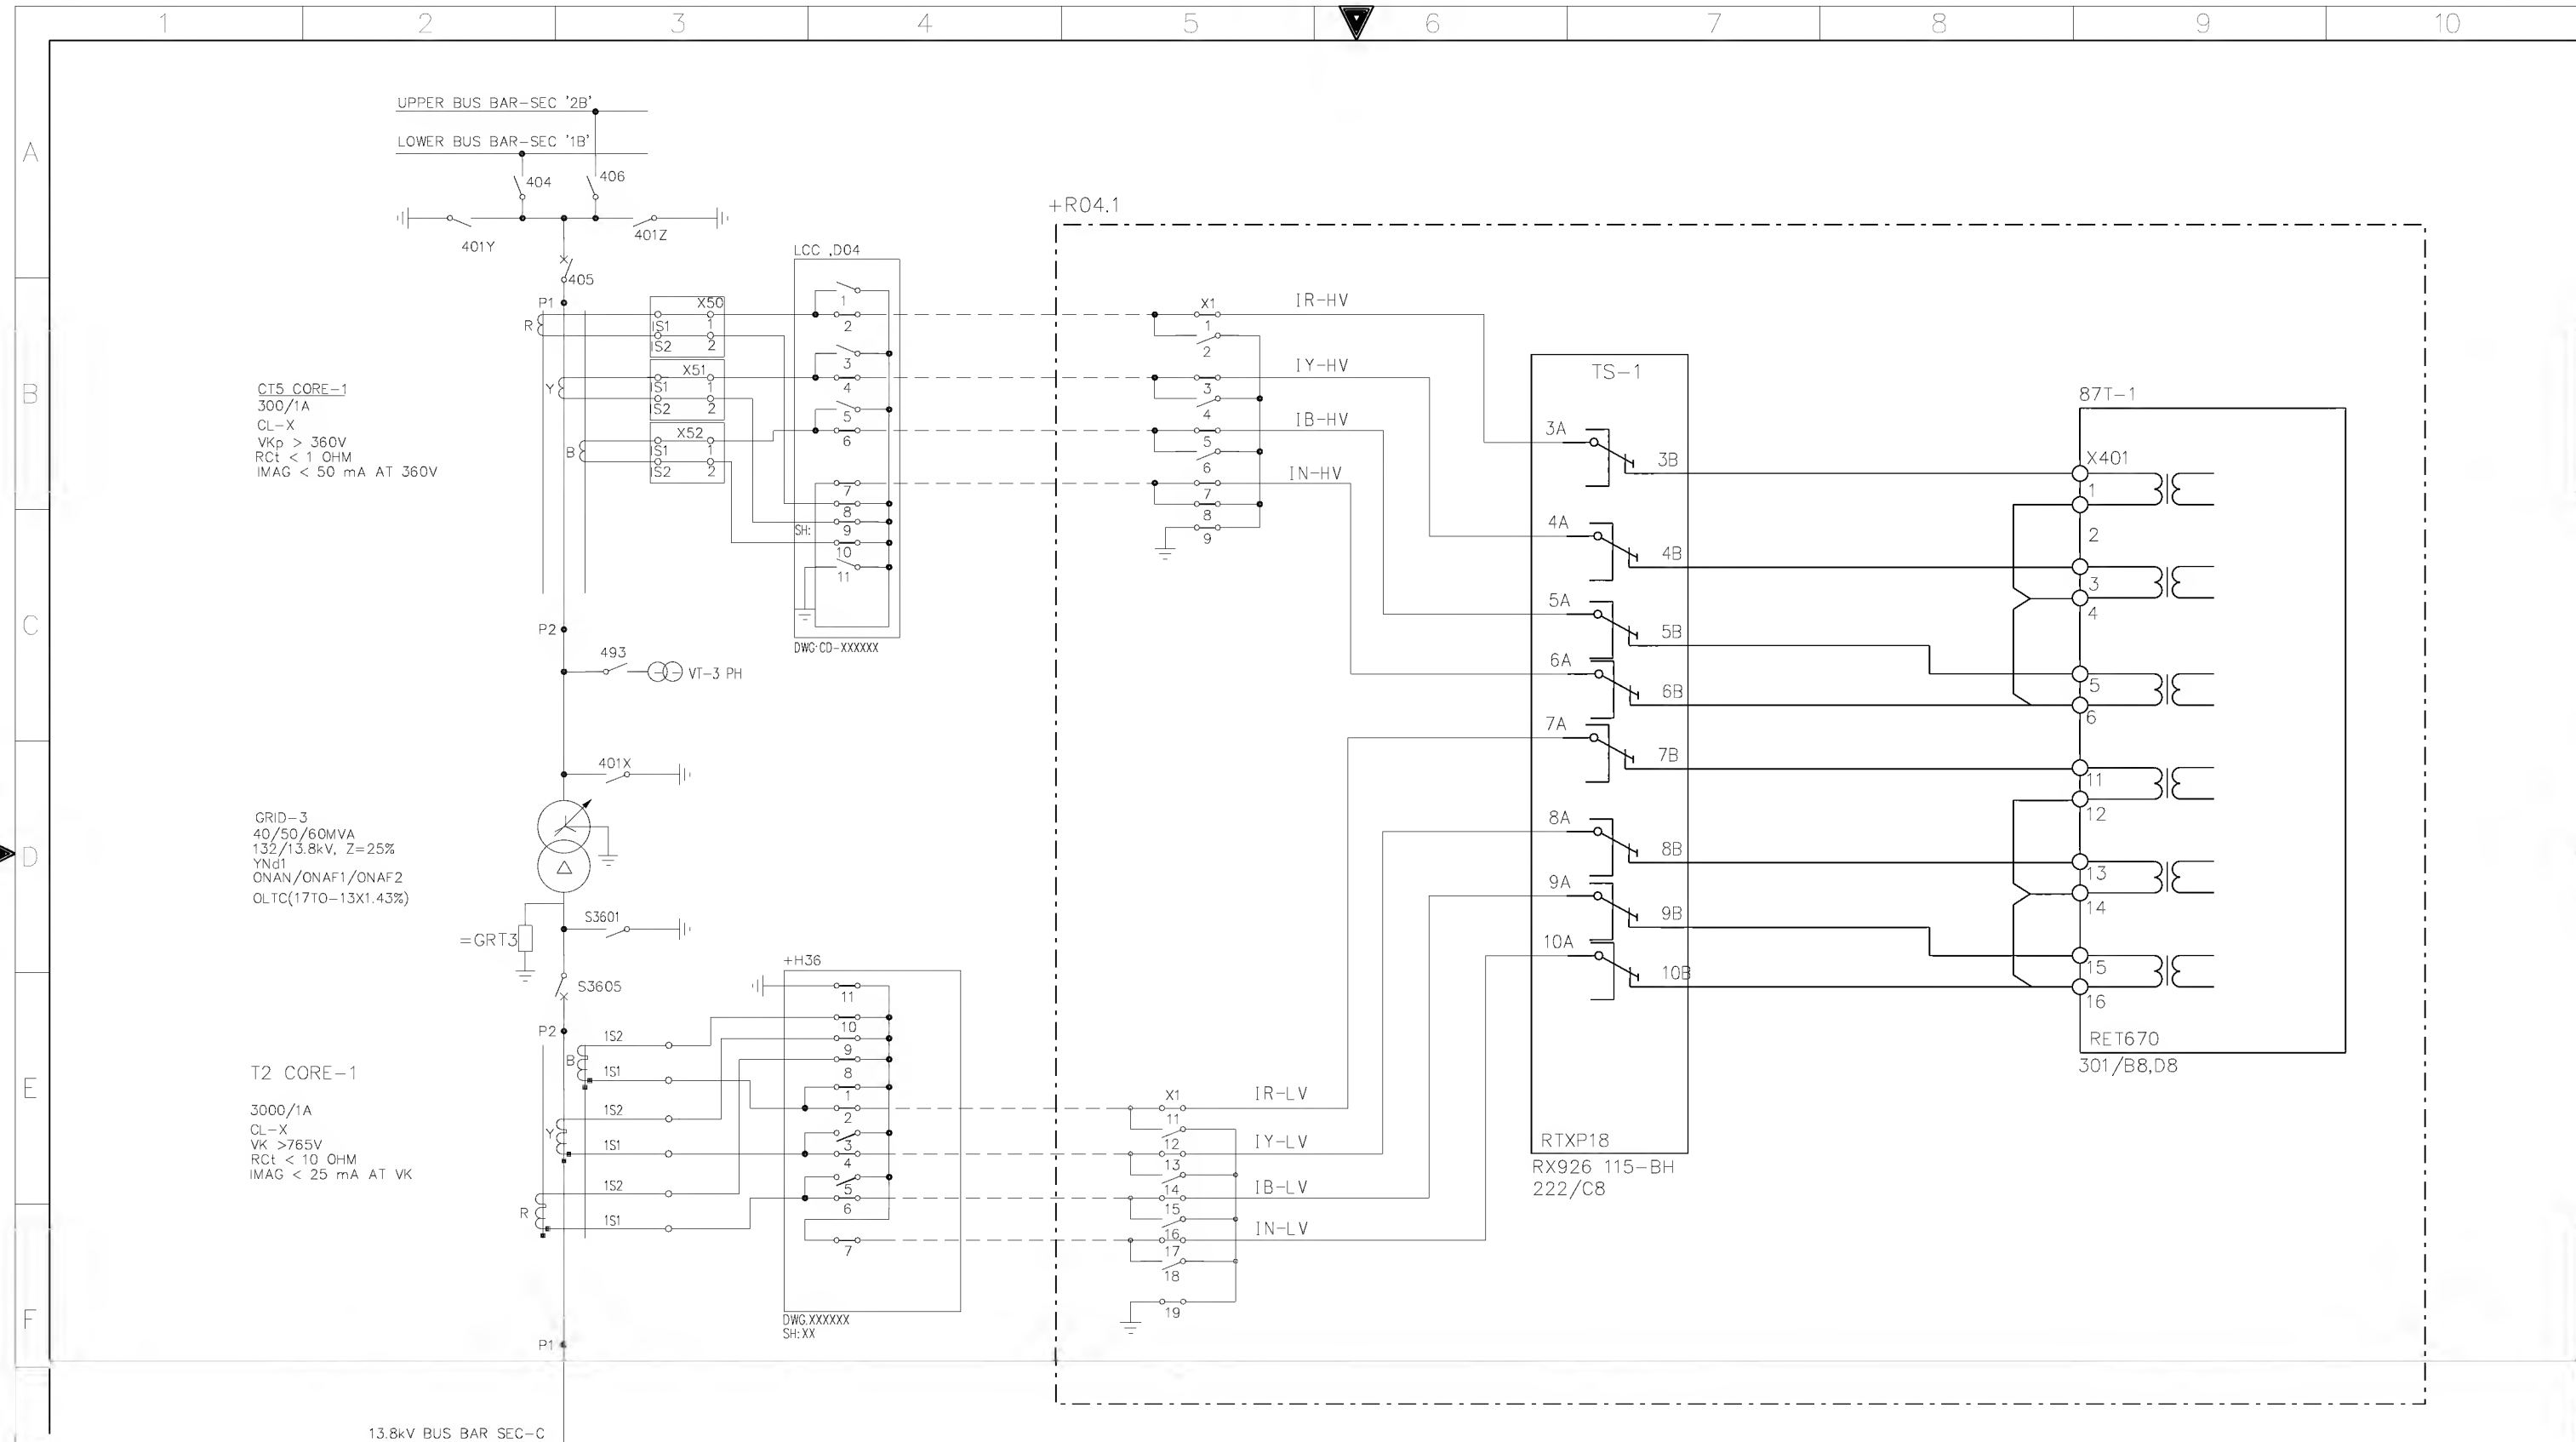


AS-BUILT BY _____ DATE _____ CONTRACT NO. 11131113/00 JOB ORDER NO. S-13656

REV. NO.	DATE	DESCRIPTION
01	13 49	FACTORY ASBUILT
00	13 04	FOR APPROVAL

DRAWN BY RIZ CHECKED BY JKR
DATE STARTED 24.01.2013 DATE COMPLETED _____
OPRG. DEPT. CTPD ENG. DEPT. AUT-PSAC

CT CIRCUITS 87T-1 RELAY
132/13.8kV GT-3 RELAY PANEL-1 +R04.1
S/S 8709-132/13.8KV IN AL-KHARJ CITY
RIYADH SAUDI ARABIA


الشركة الوطنية لنقل الكهرباء			نقل الكهرباء		
			National Grid sa		
INDEX	PLANT NO.	DRAWING NUMBER	SHEET NO.		REV. NO.
-	C421	CD322934	SHT	CONT.	01
			221	222	

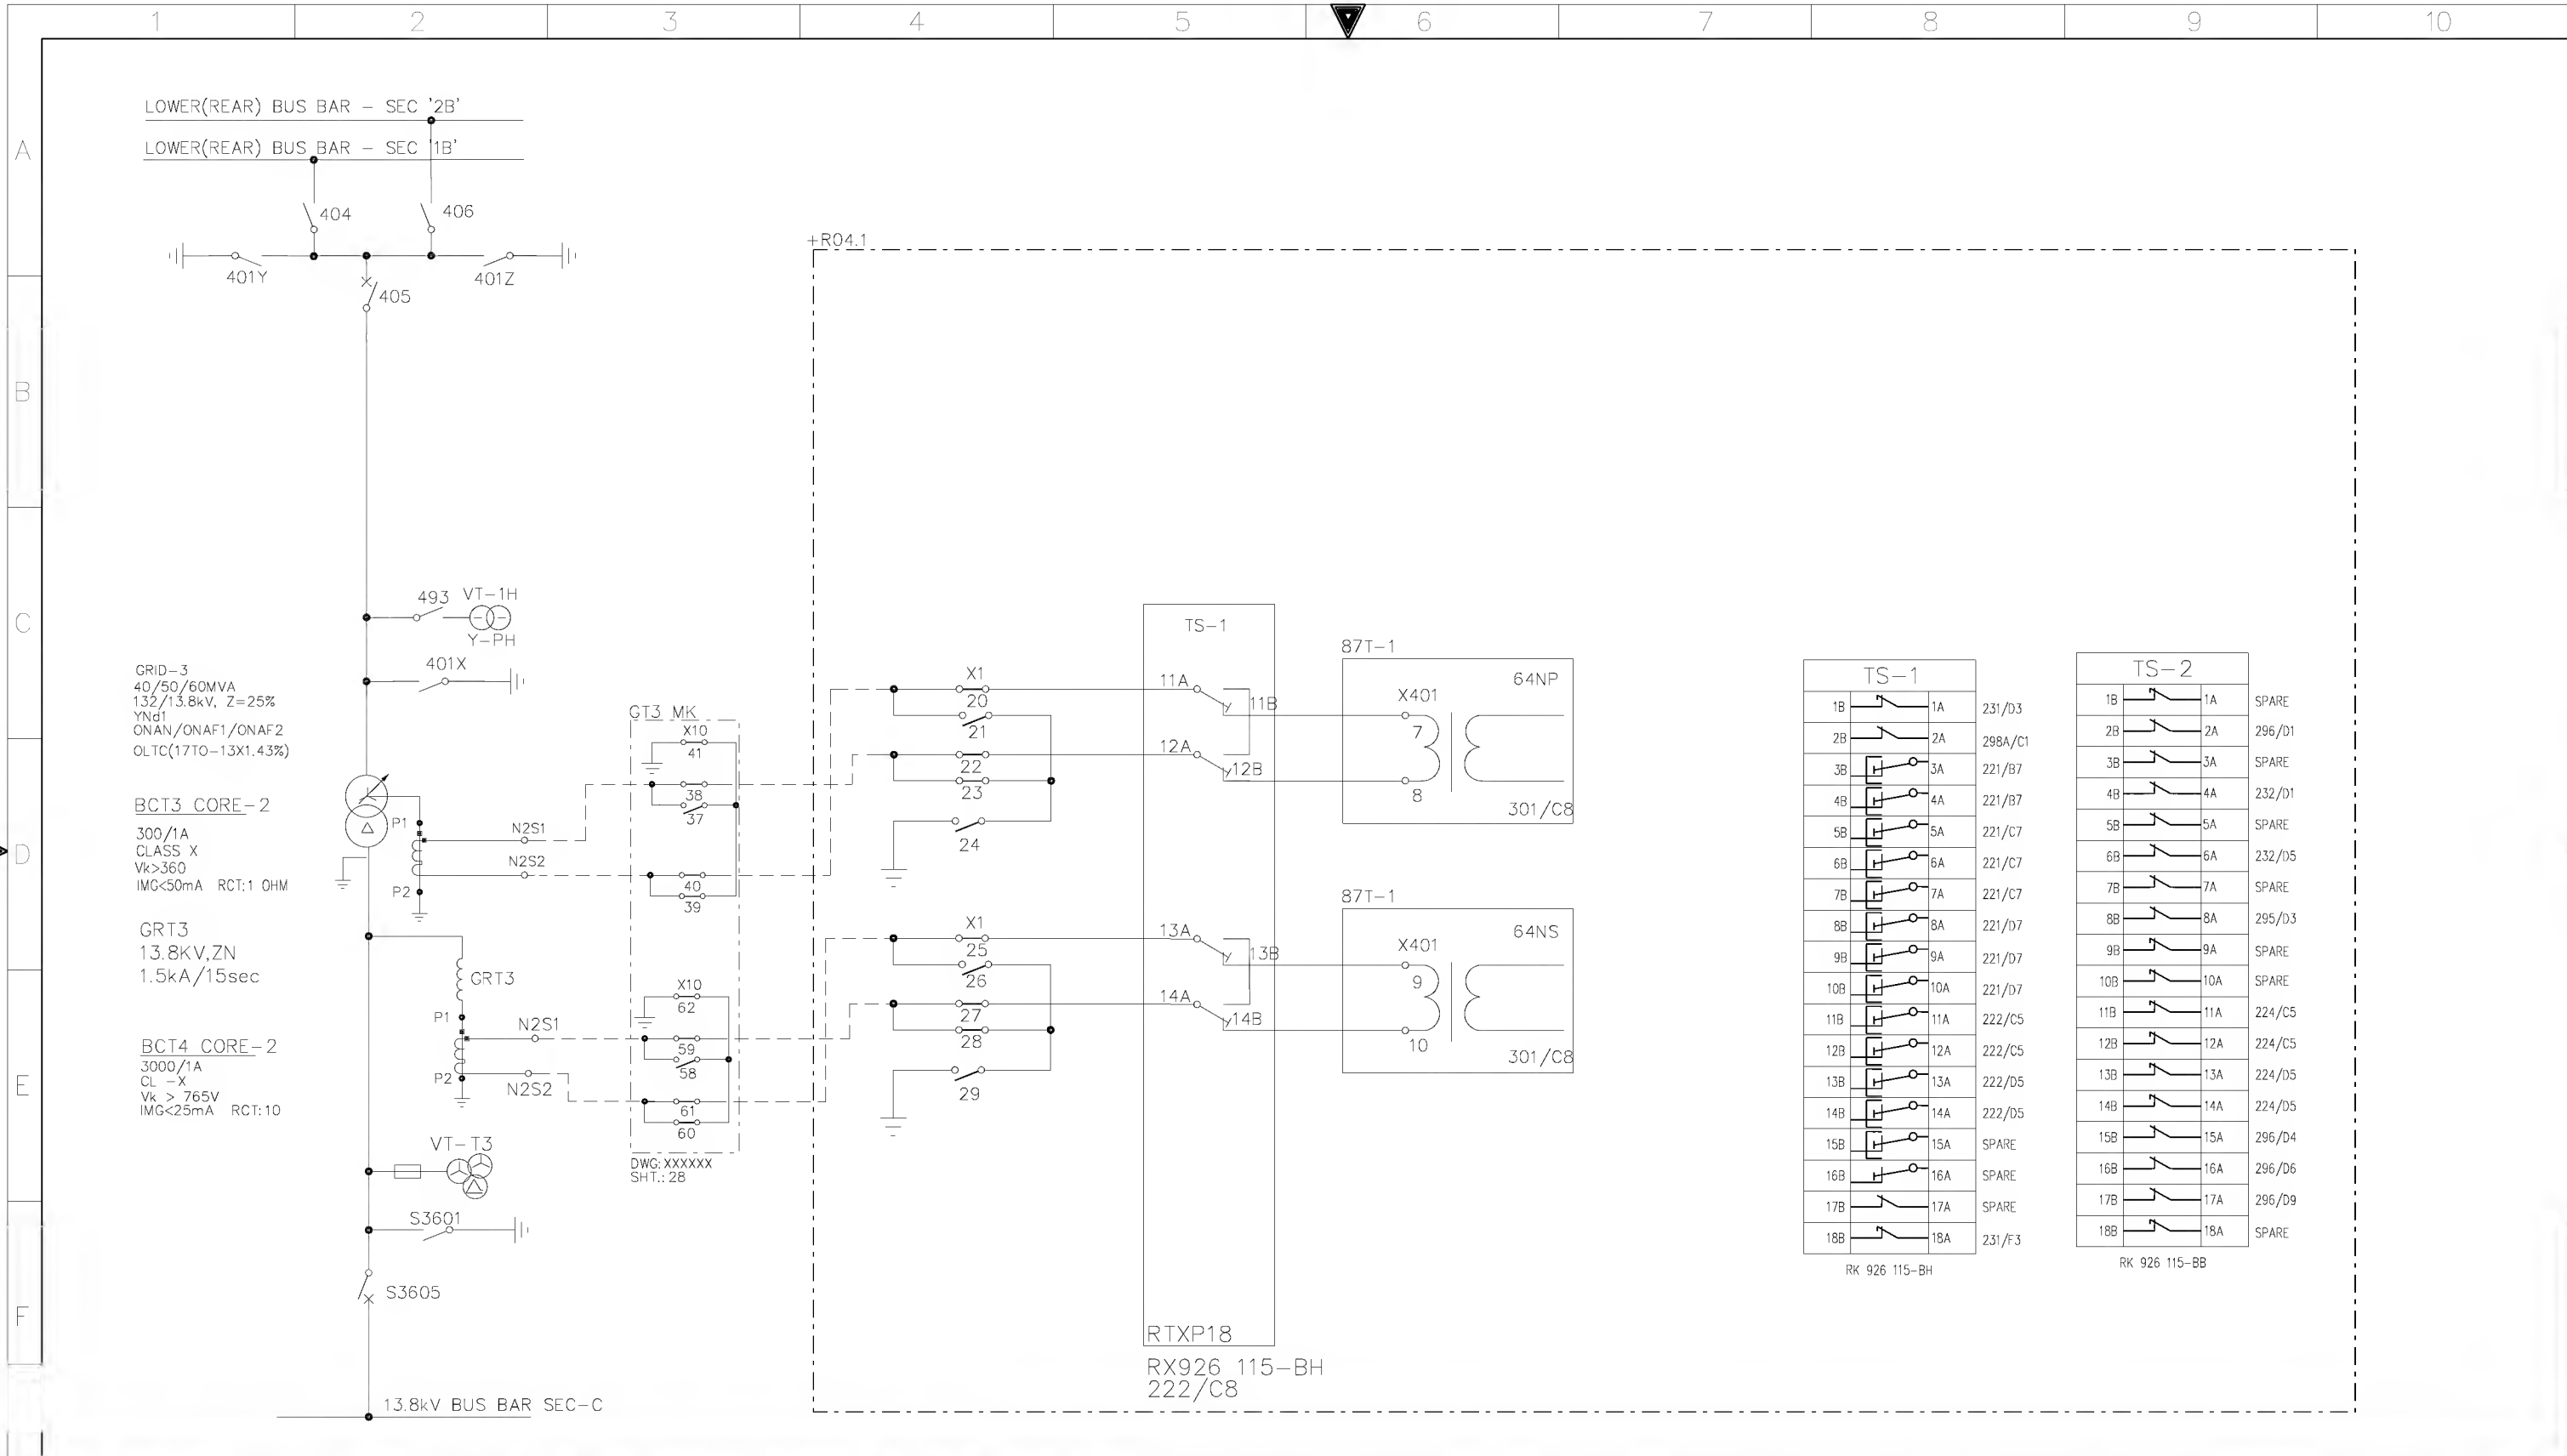


AS-BUILT BY _____ DATE _____			CONTRACT NO. 11131113/00		JOB ORDER NO. S-13656	
01	13 49	FACTORY ASBUILT	DRAWN BY RIZ		CHECKED BY JKR	
00	13 04	FOR APPROVAL	DATE STARTED 24.01.2013		DATE COMPLETED _____	
REV. NO.	DATE	DESCRIPTION	OPRG. DEPT. CTPD		ENG. DEPT. AUT-PSAC	

CT CIRCUITS 87T-1 RELAY	
132/13.8kV GT-3 RELAY PANEL-1 +R04.1	
S/S 8709-132/13.8KV IN AL-KHARJ CITY	
RIYADH	SAUDI ARABIA


الشركة الوطنية لنقل الكهرباء				نقل الكهرباء	
				National Grid sa	
INDEX	PLANT NO.	DRAWING NUMBER		SHEET NO.	
-	C421	CD322934		SHT	CONT.
				222	223
				REV. NO. 01	

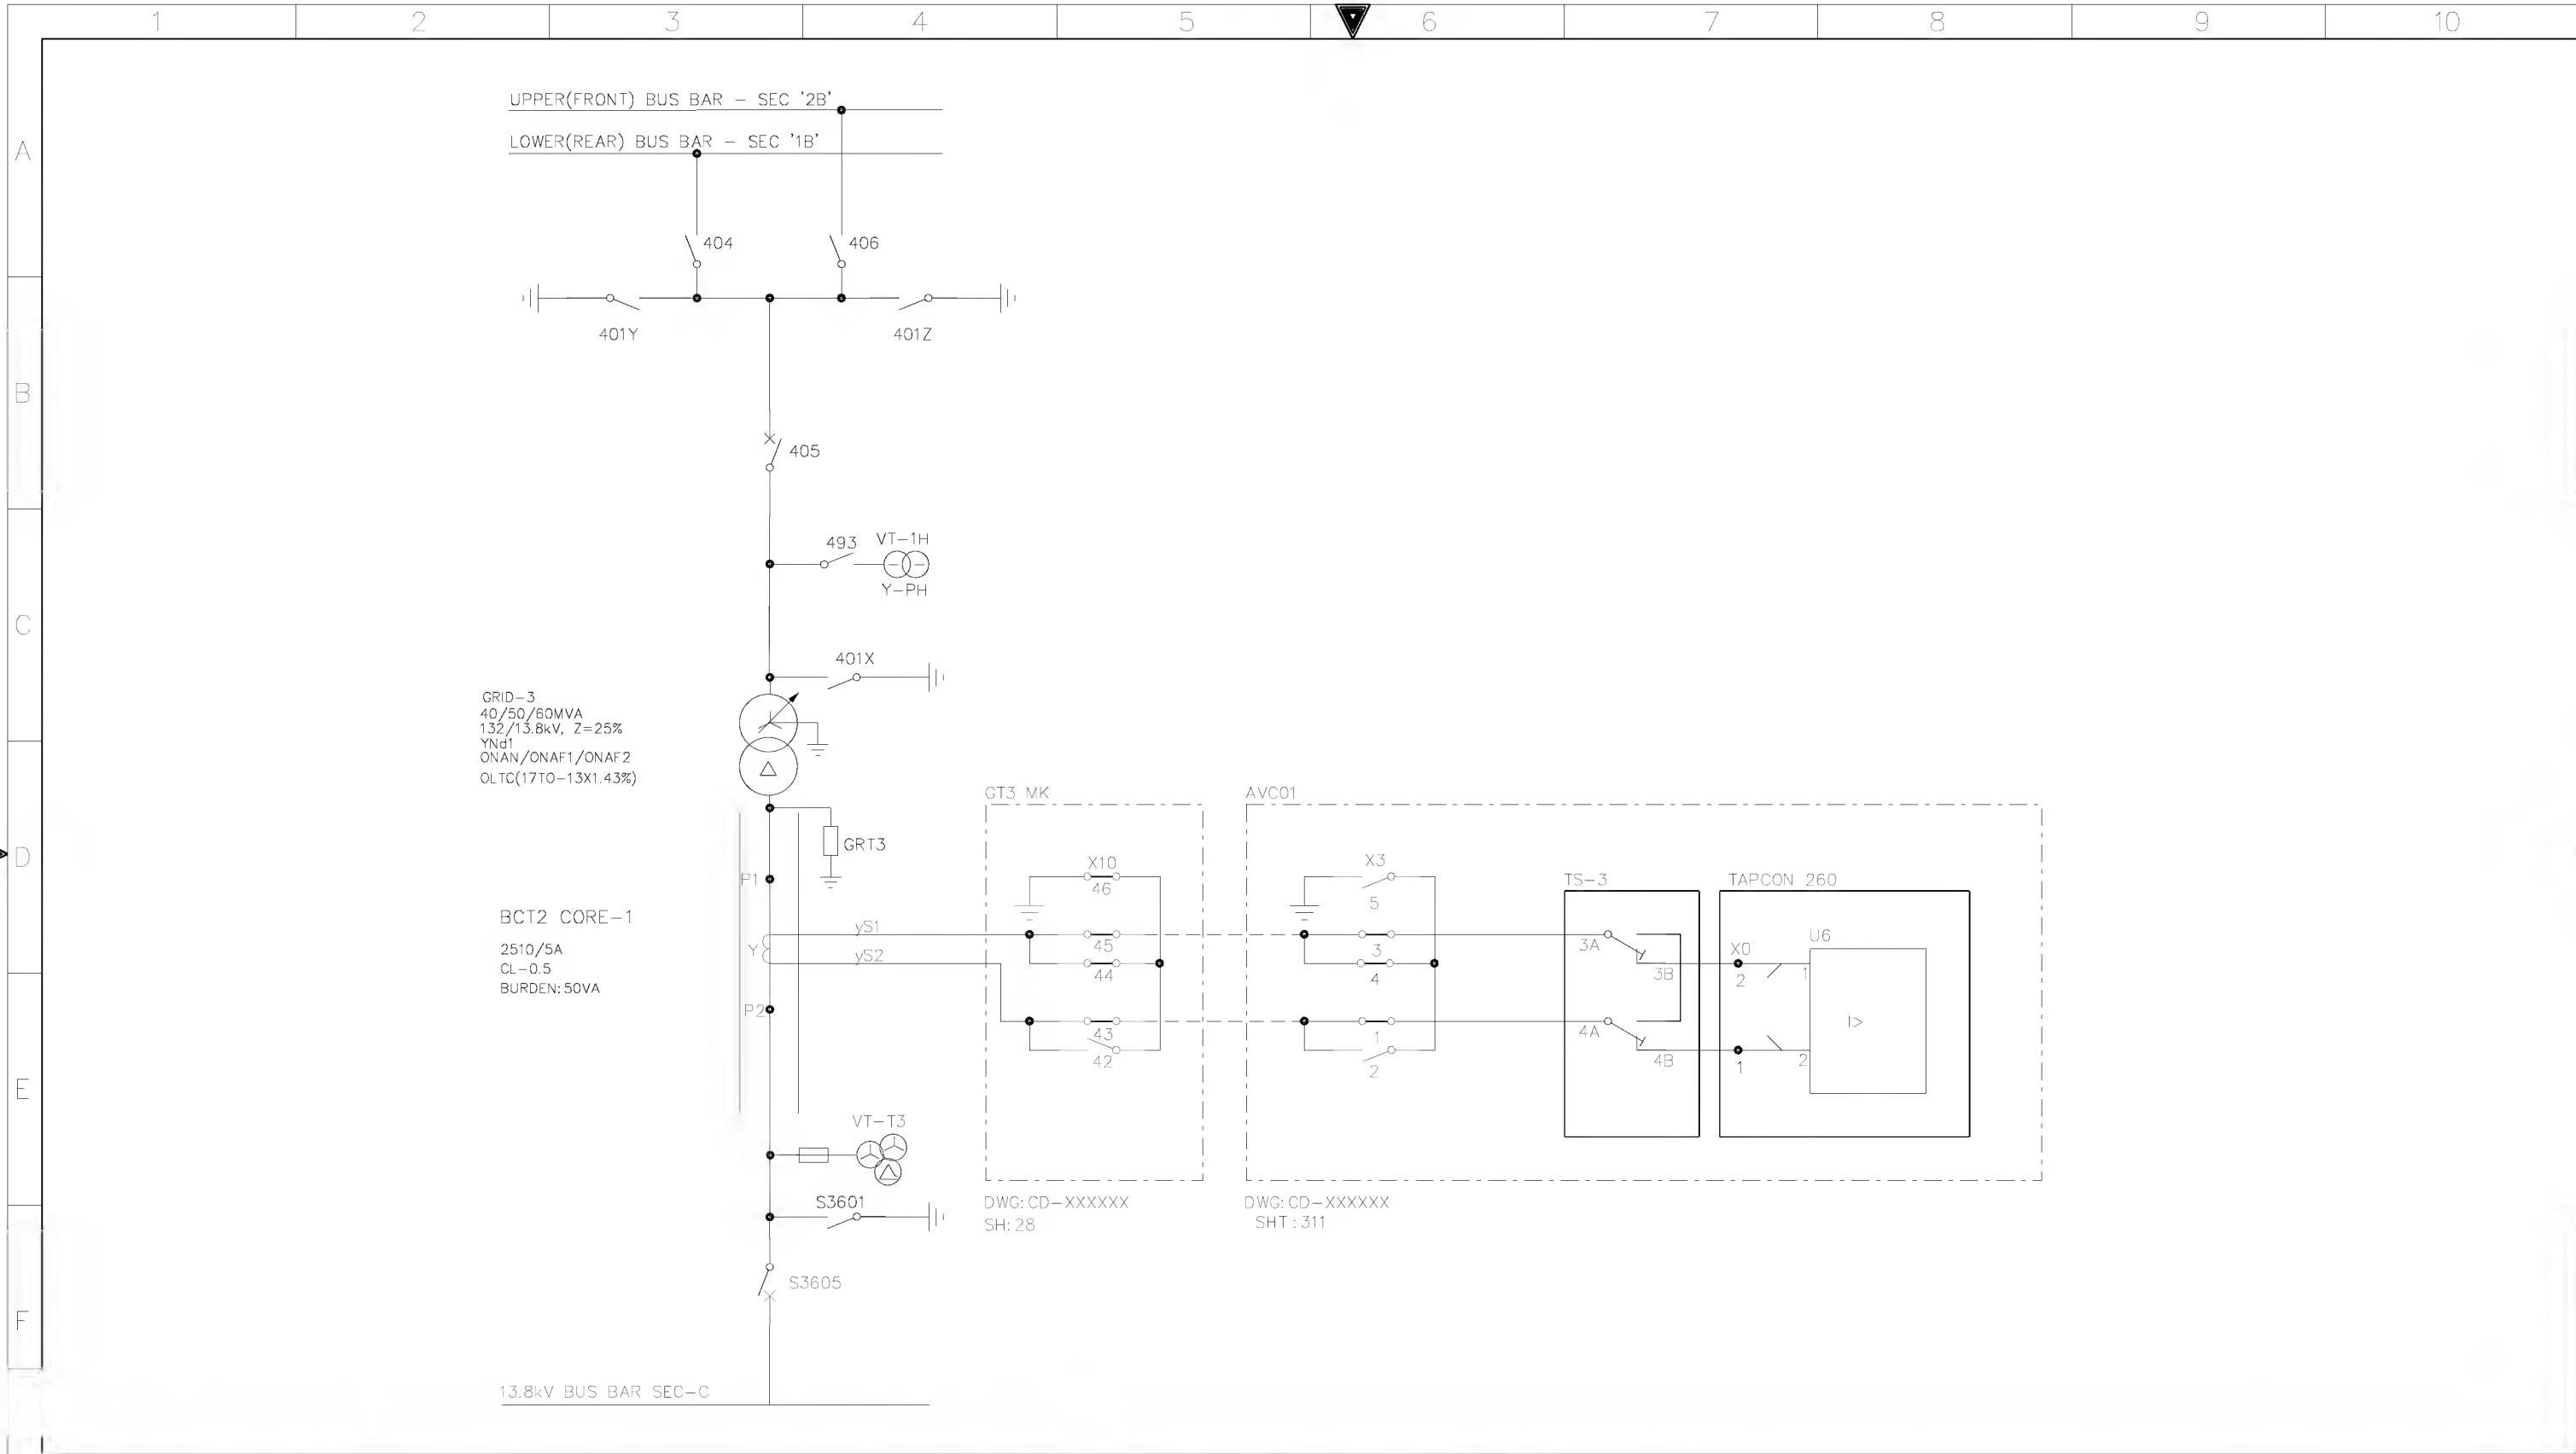


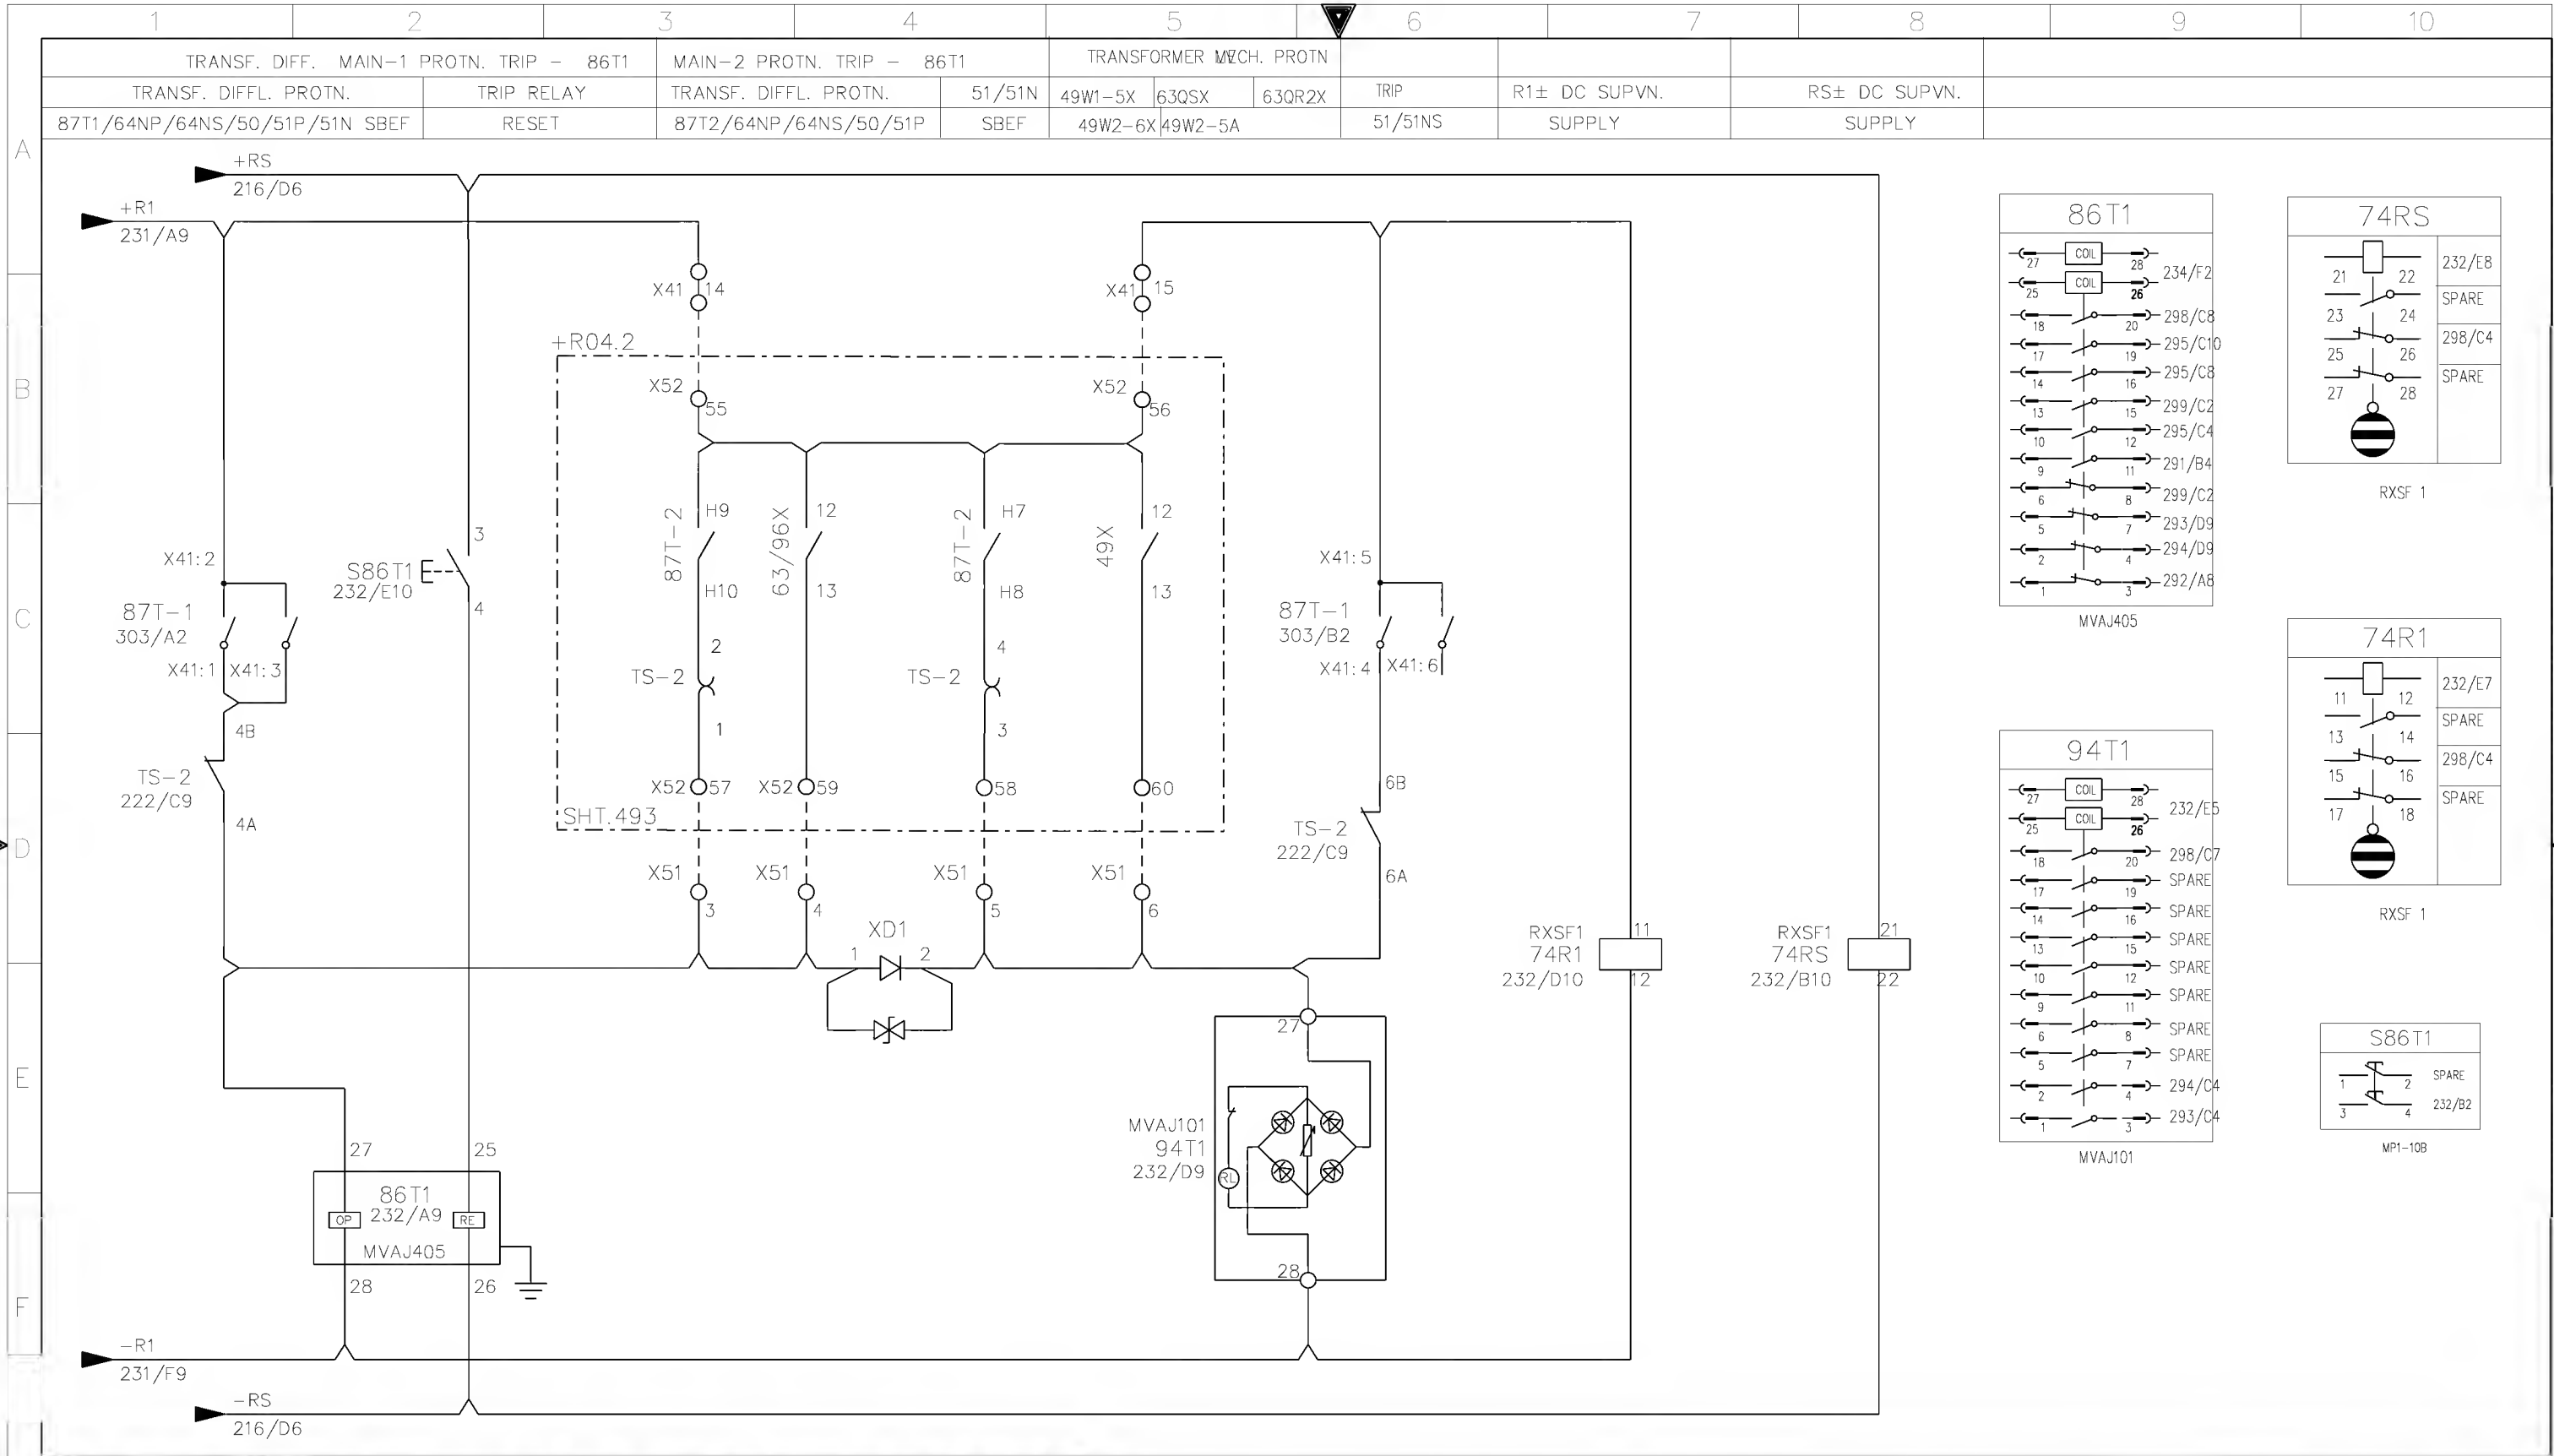
AS-BUILT BY _____ DATE _____			CONTRACT NO. 1113/113/00		JOB ORDER NO. S-13656		CT CIRCUITS 87T-1 RELAY		<div>الشركة الوطنية لنقل الكهرباء</div> <div>نقل الكهرباء</div> <div>National Grid sa</div>															
			DRAWN BY RIZ		CHECKED BY JKR		132/13.8kV GT-3 RELAY PANEL-1 +R04.1																	
01 13 49			FACTORY ASBUILT		DATE STARTED 24.01.2013		DATE COMPLETED _____																	
00 13 04			FOR APPROVAL		OPRG. DEPT. CTPD		ENG. DEPT. AUT-PSAC		S/S 8709-132/13.8KV IN AL-KHARJ CITY		INDEX		PLANT NO.		DRAWING NUMBER		SHEET NO.		REV. NO.					
REV. NO.			DATE			DESCRIPTION			RIYADH		SAUDI ARABIA		-		C421		CD322934		SHT		CONT.		01	
																	223		224					

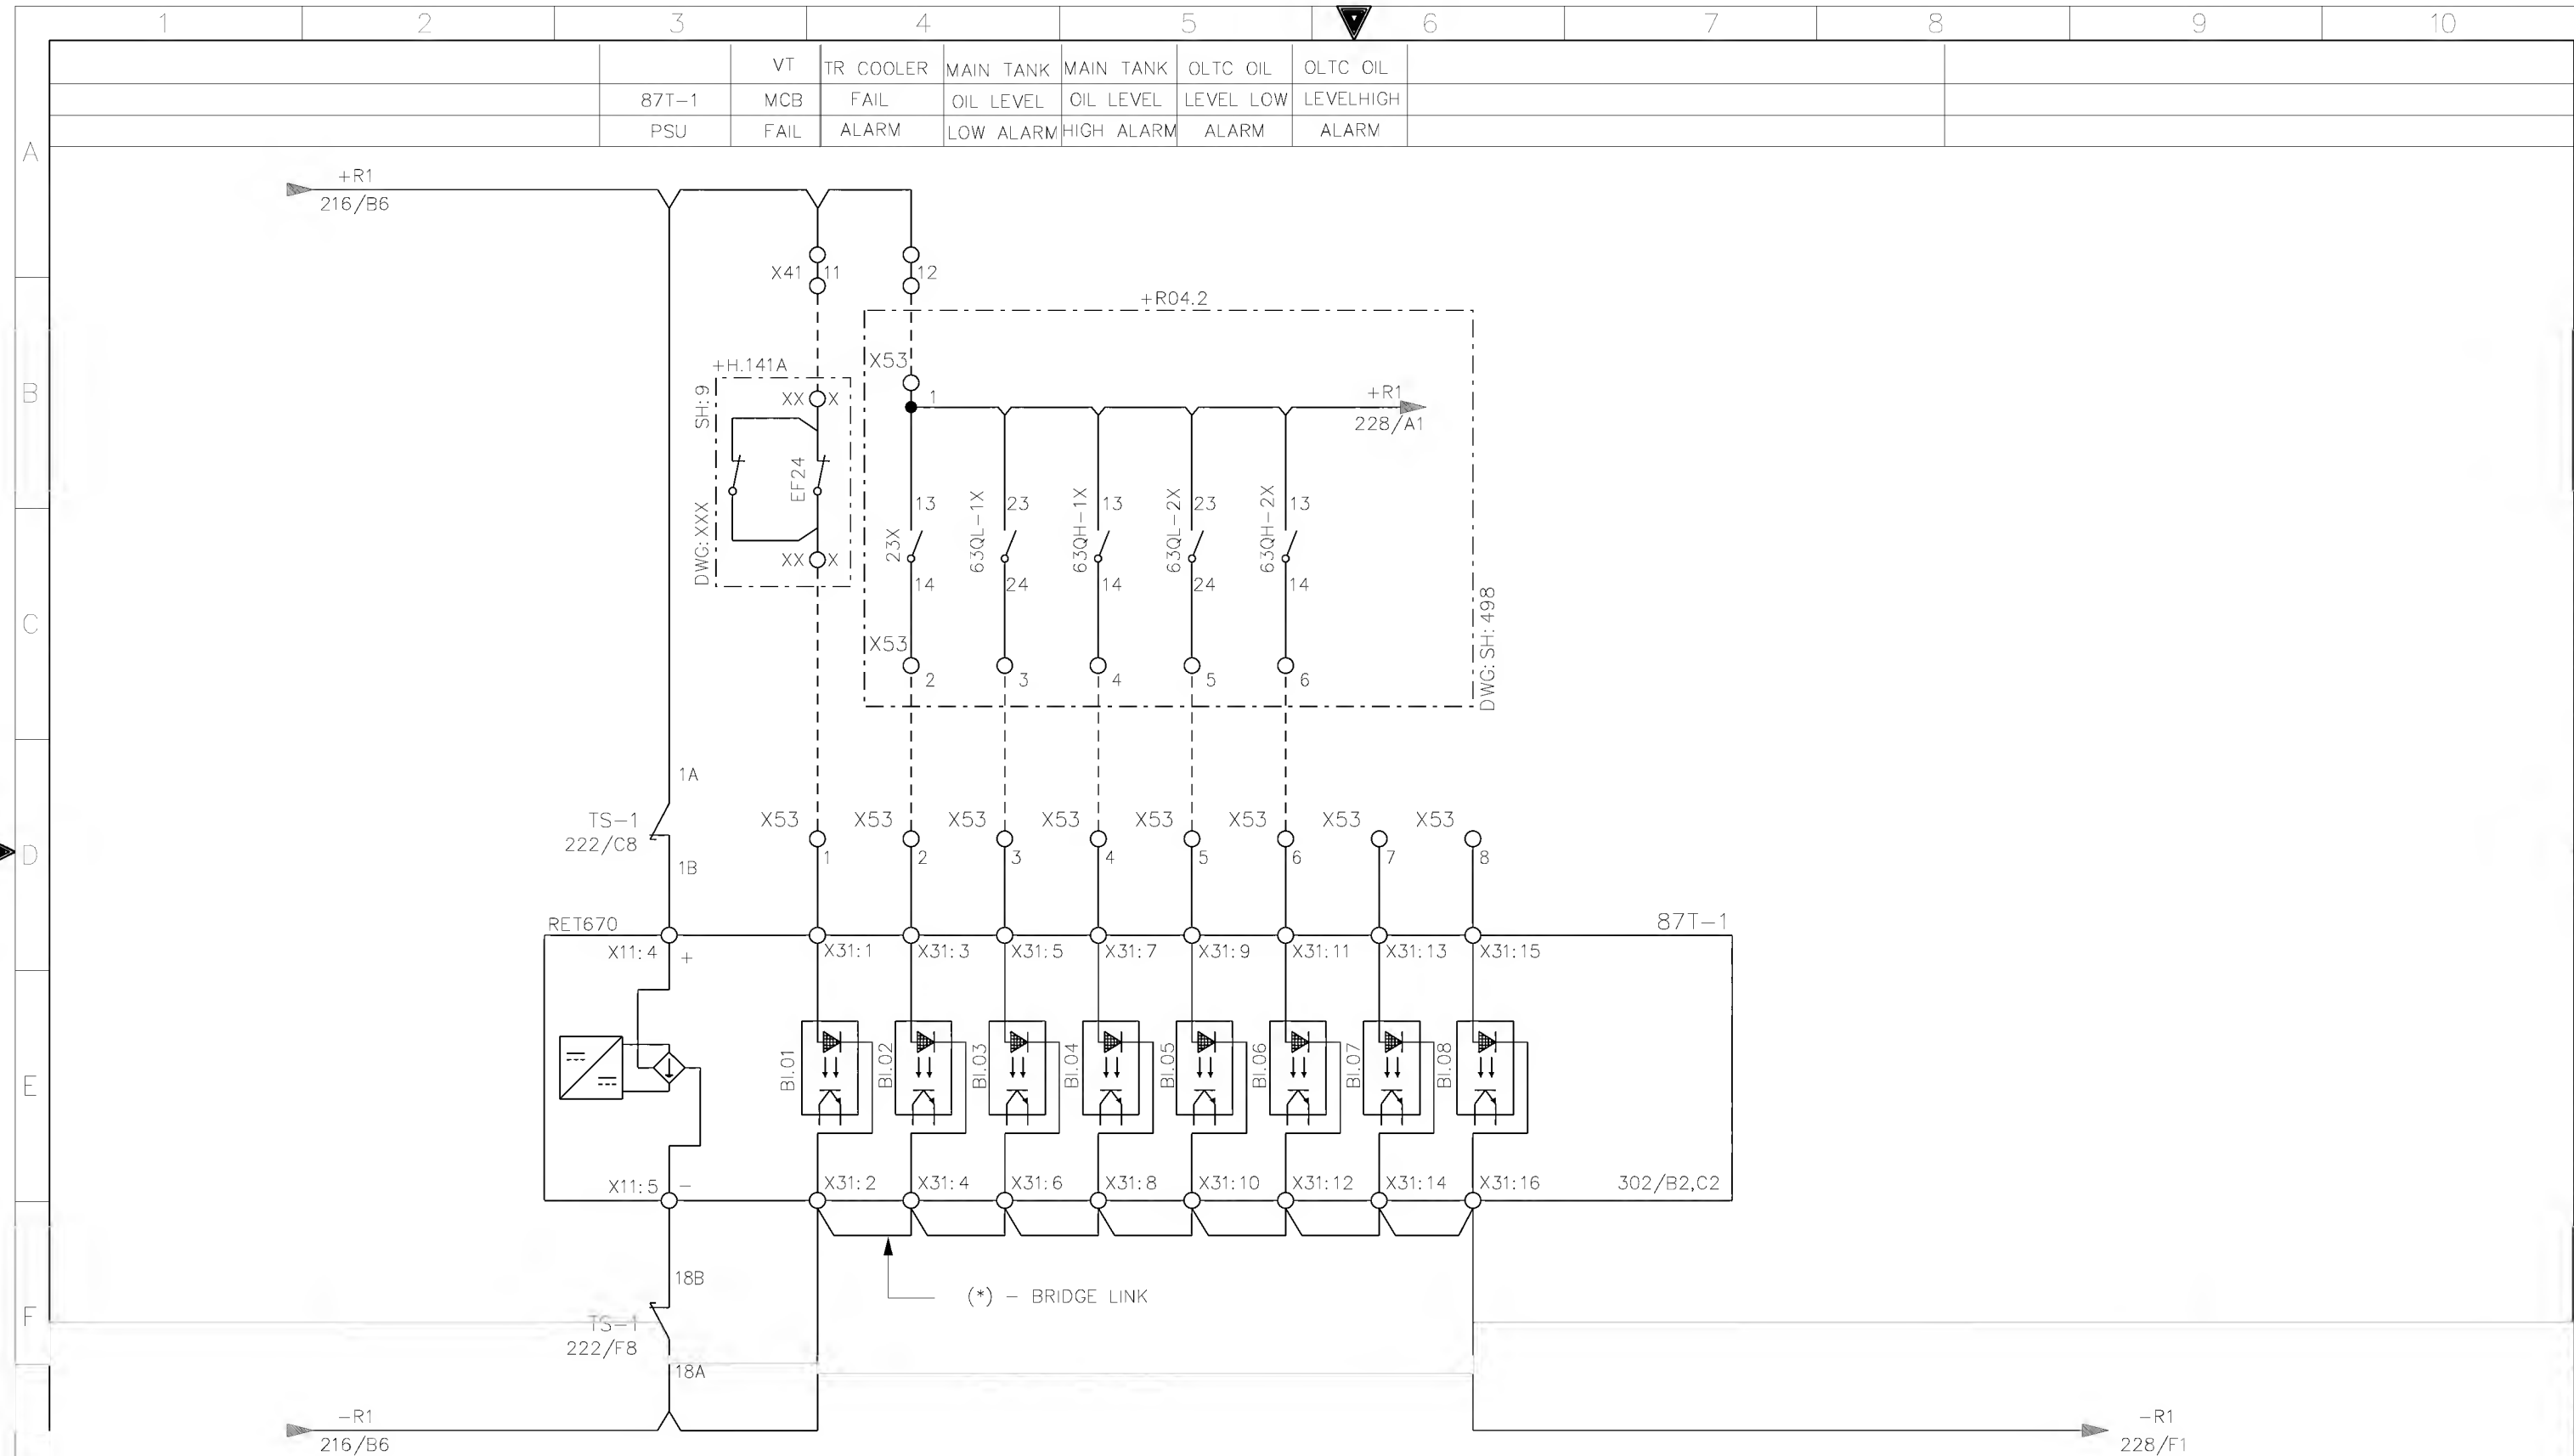

AS-BUILT BY _____ DATE _____			CONTRACT NO. 11131113/00		JOB ORDER NO. S-13656		87T-1 BINARY INPUTS		<div>الشركة الوطنية لنقل الكهرباء</div> <div>National Grid sa</div>									
			DRAWN BY RIZ		CHECKED BY JKR		132/13.8kV GT-3 RELAY PANEL-1 +R04.1											
			DATE STARTED 24.01.2013		DATE COMPLETED _____		S/S 8709-132/13.8KV IN AL-KHARJ CITY											
01 13 49			FACTORY ASBUILT				S/S 8709-132/13.8KV IN AL-KHARJ CITY		INDEX		PLANT NO.		DRAWING NUMBER		SHEET NO.		REV. NO.	
00 13 04			FOR APPROVAL				RIYADH		-		C421		CD322934		SHT 227		CONT. 228	
REV. NO.			DATE		DESCRIPTION		OPRG. DEPT. CTPD		ENG. DEPT. AUT-PSAC								01	

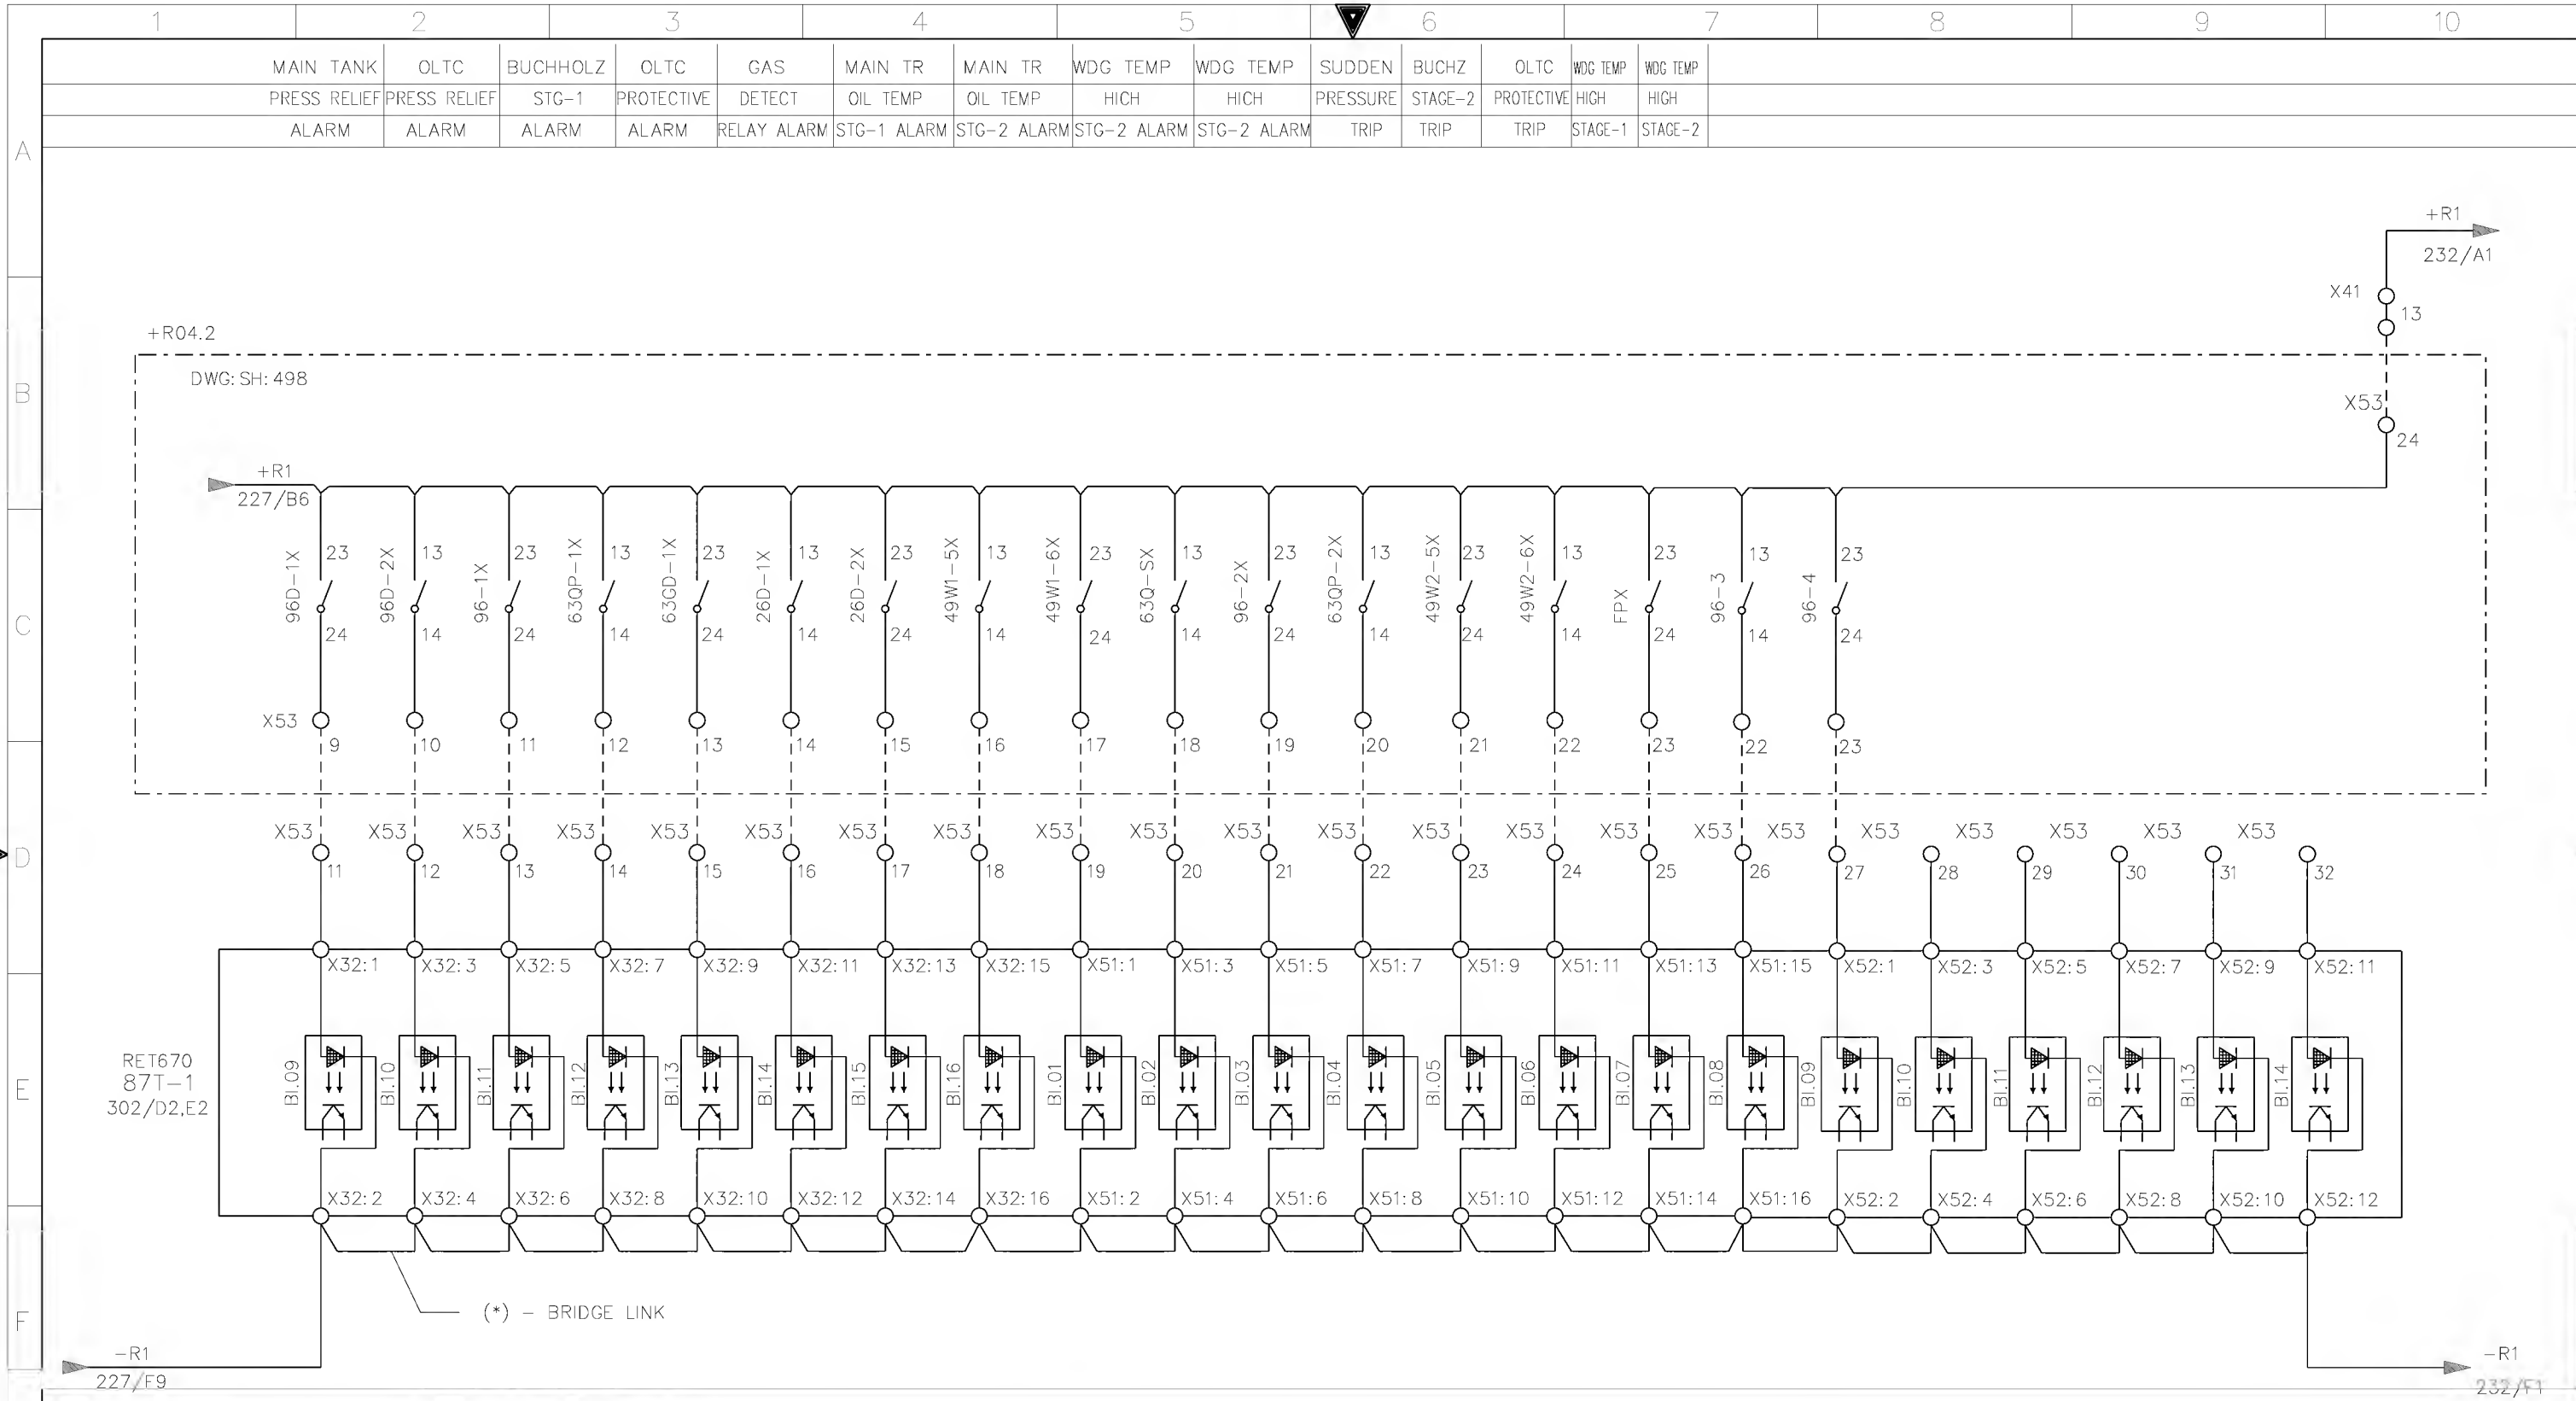


AS-BUILT BY _____ DATE _____			CONTRACT NO. 11131113/00		JOB ORDER NO. S-13656		87T-1 BINARY INPUTS		<div>الشركة الوطنية لنقل الكهرباء</div> <div> نقل الكهرباء</div> <div>National Grid sa</div>								
			DRAWN BY <u>RIZ</u> CHECKED BY <u>JKR</u>				132/13.8kV GT-3 RELAY PANEL-1 +R04.1										
01	13 49	FACTORY ASBUILT	DATE STARTED <u>24.01.2013</u> DATE COMPLETED _____				S/S 8709-132/13.8KV IN AL-KHARJ CITY		INDEX		PLANT NO.	DRAWING NUMBER		SHEET NO.		REV. NO.	
00	13 04	FOR APPROVAL	OPRG. DEPT. <u>CTPD</u> ENG. DEPT. <u>AUT-PSAC</u>				RIYADH SAUDI ARABIA		-		C421	CD322934		SHT		CONT.	01
REV. NO.	DATE	DESCRIPTION												228		232	




AS-BUILT BY _____ DATE _____			CONTRACT NO. 11131113/00		JOB ORDER NO. S-13656		MAIN-1 TRANSF DIFFL PROT TRIP RELAY CIRCUIT			<div>نقل الكهرباء</div> <div>الشركة الوطنية لنقل الكهرباء</div> <div>National Grid sa</div>						
			DRAWN BY _____ RIZ _____ CHECKED BY _____ JKR		132/13.8kV GT-3 RELAY PANEL-1 +R04.1											
			DATE STARTED 24.01.2013 DATE COMPLETED _____		S/S 8709-132/13.8KV IN AL-KHARJ CITY											
01 13 49			FACTORY ASBUILT					S/S 8709-132/13.8KV IN AL-KHARJ CITY								
00 13 04			FOR APPROVAL					RIYADH			SAUDI ARABIA					
REV. NO.			DATE		DESCRIPTION		OPRG. DEPT. _____ CTPD _____ ENG. DEPT. _____ AUT-PSAC									


INDEX	PLANT NO.	DRAWING NUMBER	SHEET NO.		REV. NO.
-	C421	CD322934	SHT	CONT.	01
			232	276	

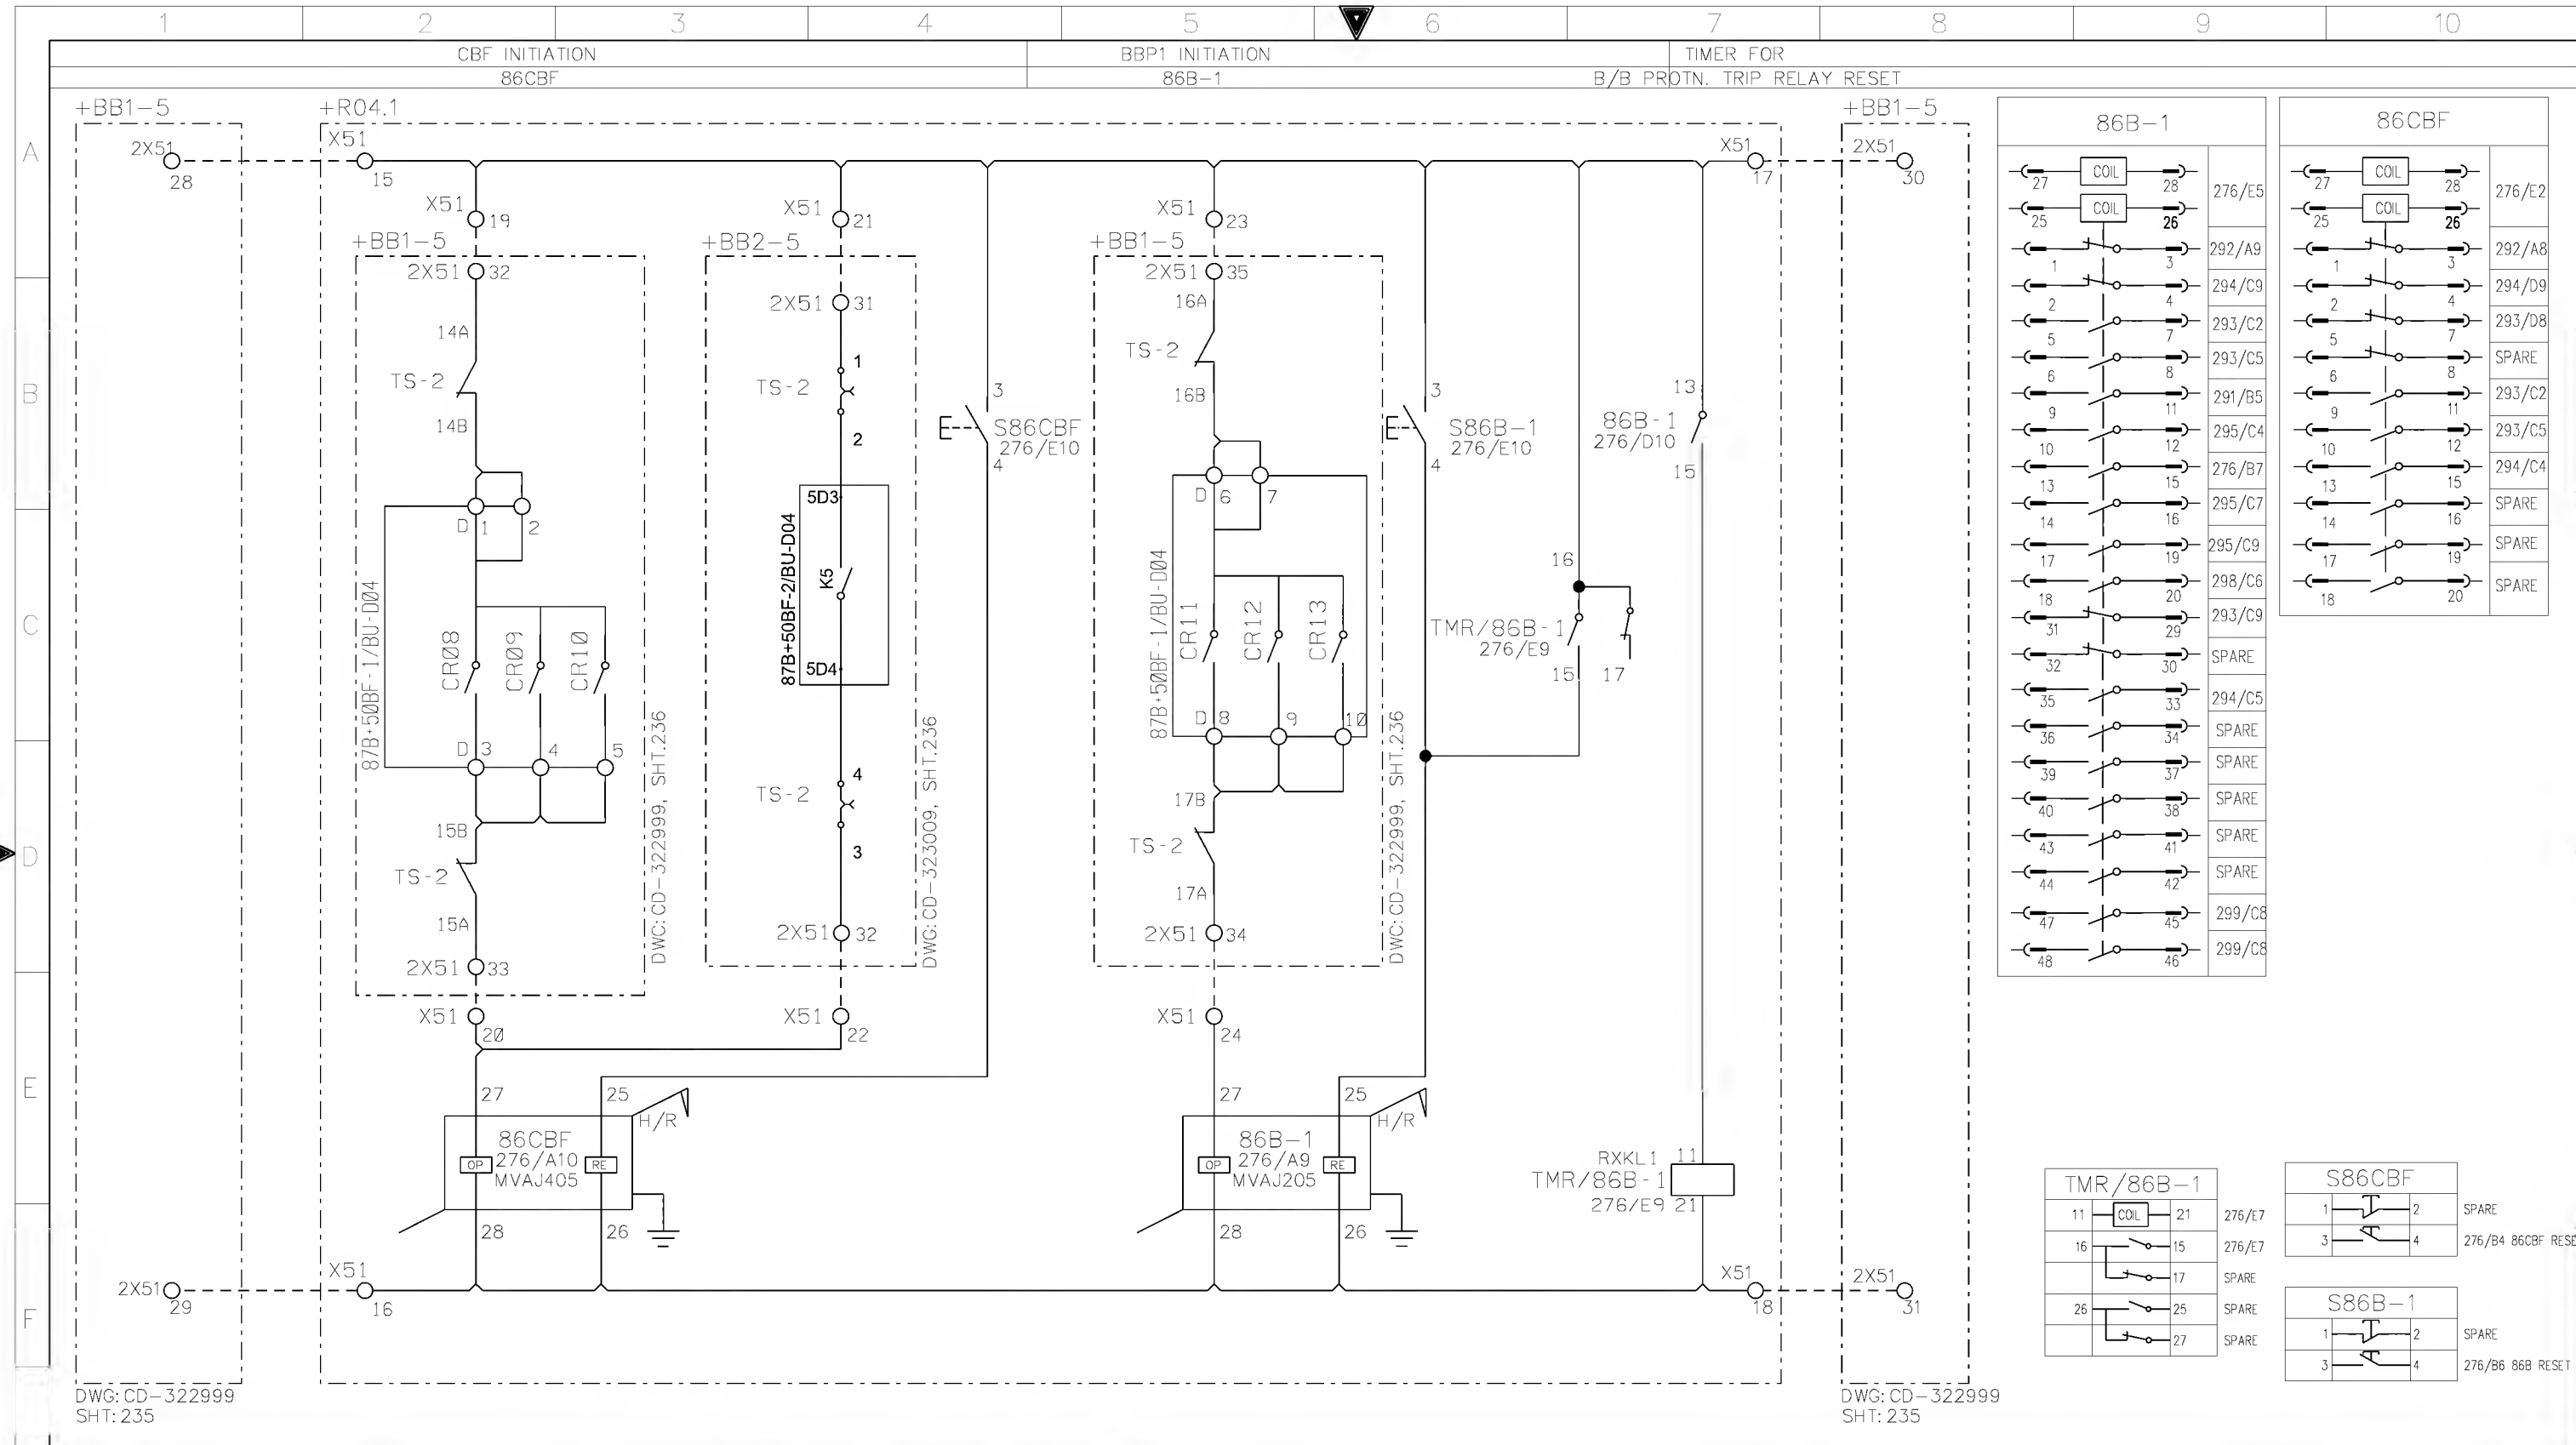

AS-BUILT BY _____ DATE _____		CONTRACT NO. 11131113/00		JOB ORDER NO. S-13656		CBF-1/2 & BUSBAR PROTN-1 TRIP RELAY CIRCUIT		<div>الشركة الوطنية لنقل الكهرباء</div> <div>National Grid sa</div>	
01 13 49		FACTORY ASBUILT		DRAWN BY RIZ CHECKED BY JKR		132/13.8kV GT-3 RELAY PANEL-1 +R04.1			
00 13 04		FOR APPROVAL		DATE STARTED 24.01.2013 DATE COMPLETED _____		S/S 8709-132/13.8KV IN AL-KHARJ CITY		INDEX PLANT NO. DRAWING NUMBER SHEET NO. REV. NO.	
REV. NO. DATE DESCRIPTION		OPRG. DEPT. CTPD ENG. DEPT. AUT-PSAC		RIYADH SAUDI ARABIA		- C421 CD322934 276 277 01		NG/D2-D (2012/01) DMS VECTOR NGD200	

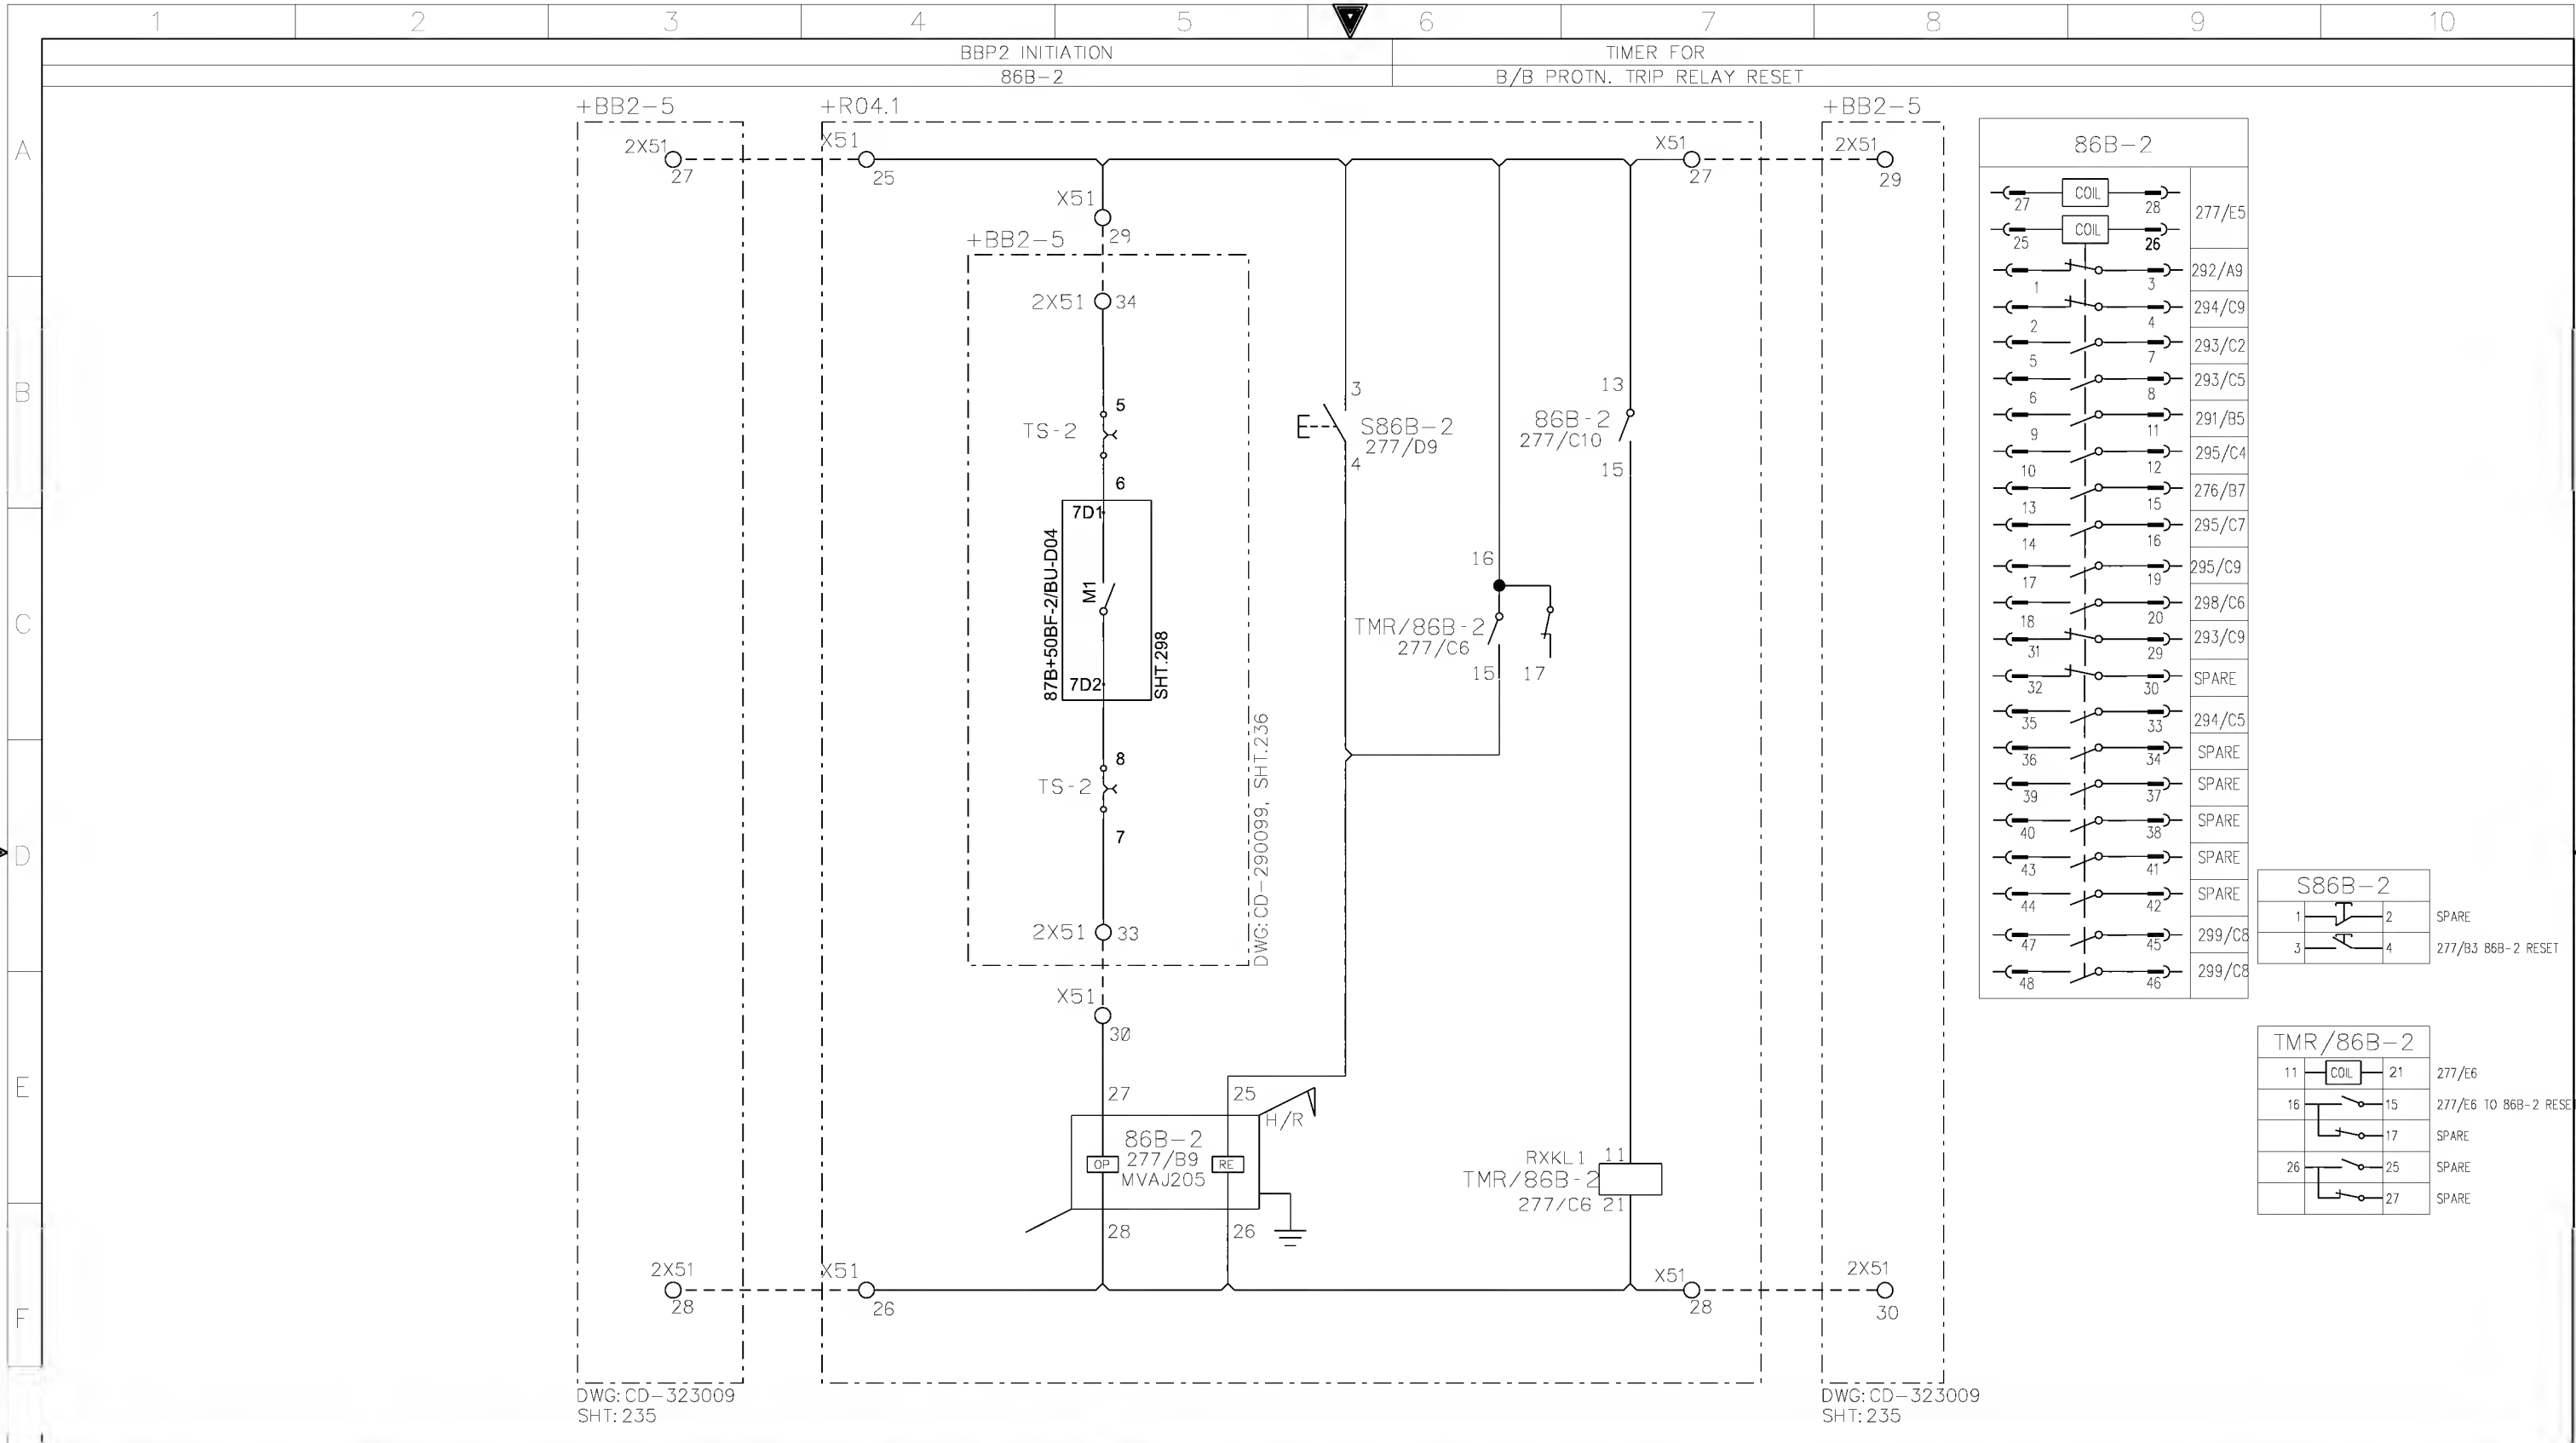

AS-BUILT BY _____ DATE _____			CONTRACT NO. 11131113/00		JOB ORDER NO. S-13656		BUSBAR PROTN-2 TRIP RELAY CIRCUIT			<div>نقل الكهرباء</div> <div>الشركة الوطنية لنقل الكهرباء</div> <div>National Grid sa</div>					
			DRAWN BY <u> RIZ </u> CHECKED BY <u> JKR </u>		132/13.8kV GT-3 RELAY PANEL-1 +R04.1										
Ø1 13 49 FACTORY ASBUILT			DATE STARTED <u>24.01.2013</u> DATE COMPLETED _____			S/S 8709-132/13.8KV IN AL-KHARJ CITY									
Ø0 13 04 FOR APPROVAL			OPRG. DEPT. <u> CTPD </u> ENG. DEPT. <u> AUT-PSAC </u>			RIYADH SAUDI ARABIA									
REV. NO.			DATE			DESCRIPTION			INDEX	PLANT NO.	DRAWING NUMBER		SHEET NO.		REV. NO.
									-	C421	CD322934		SHT	CONT.	Ø1
													277	291	

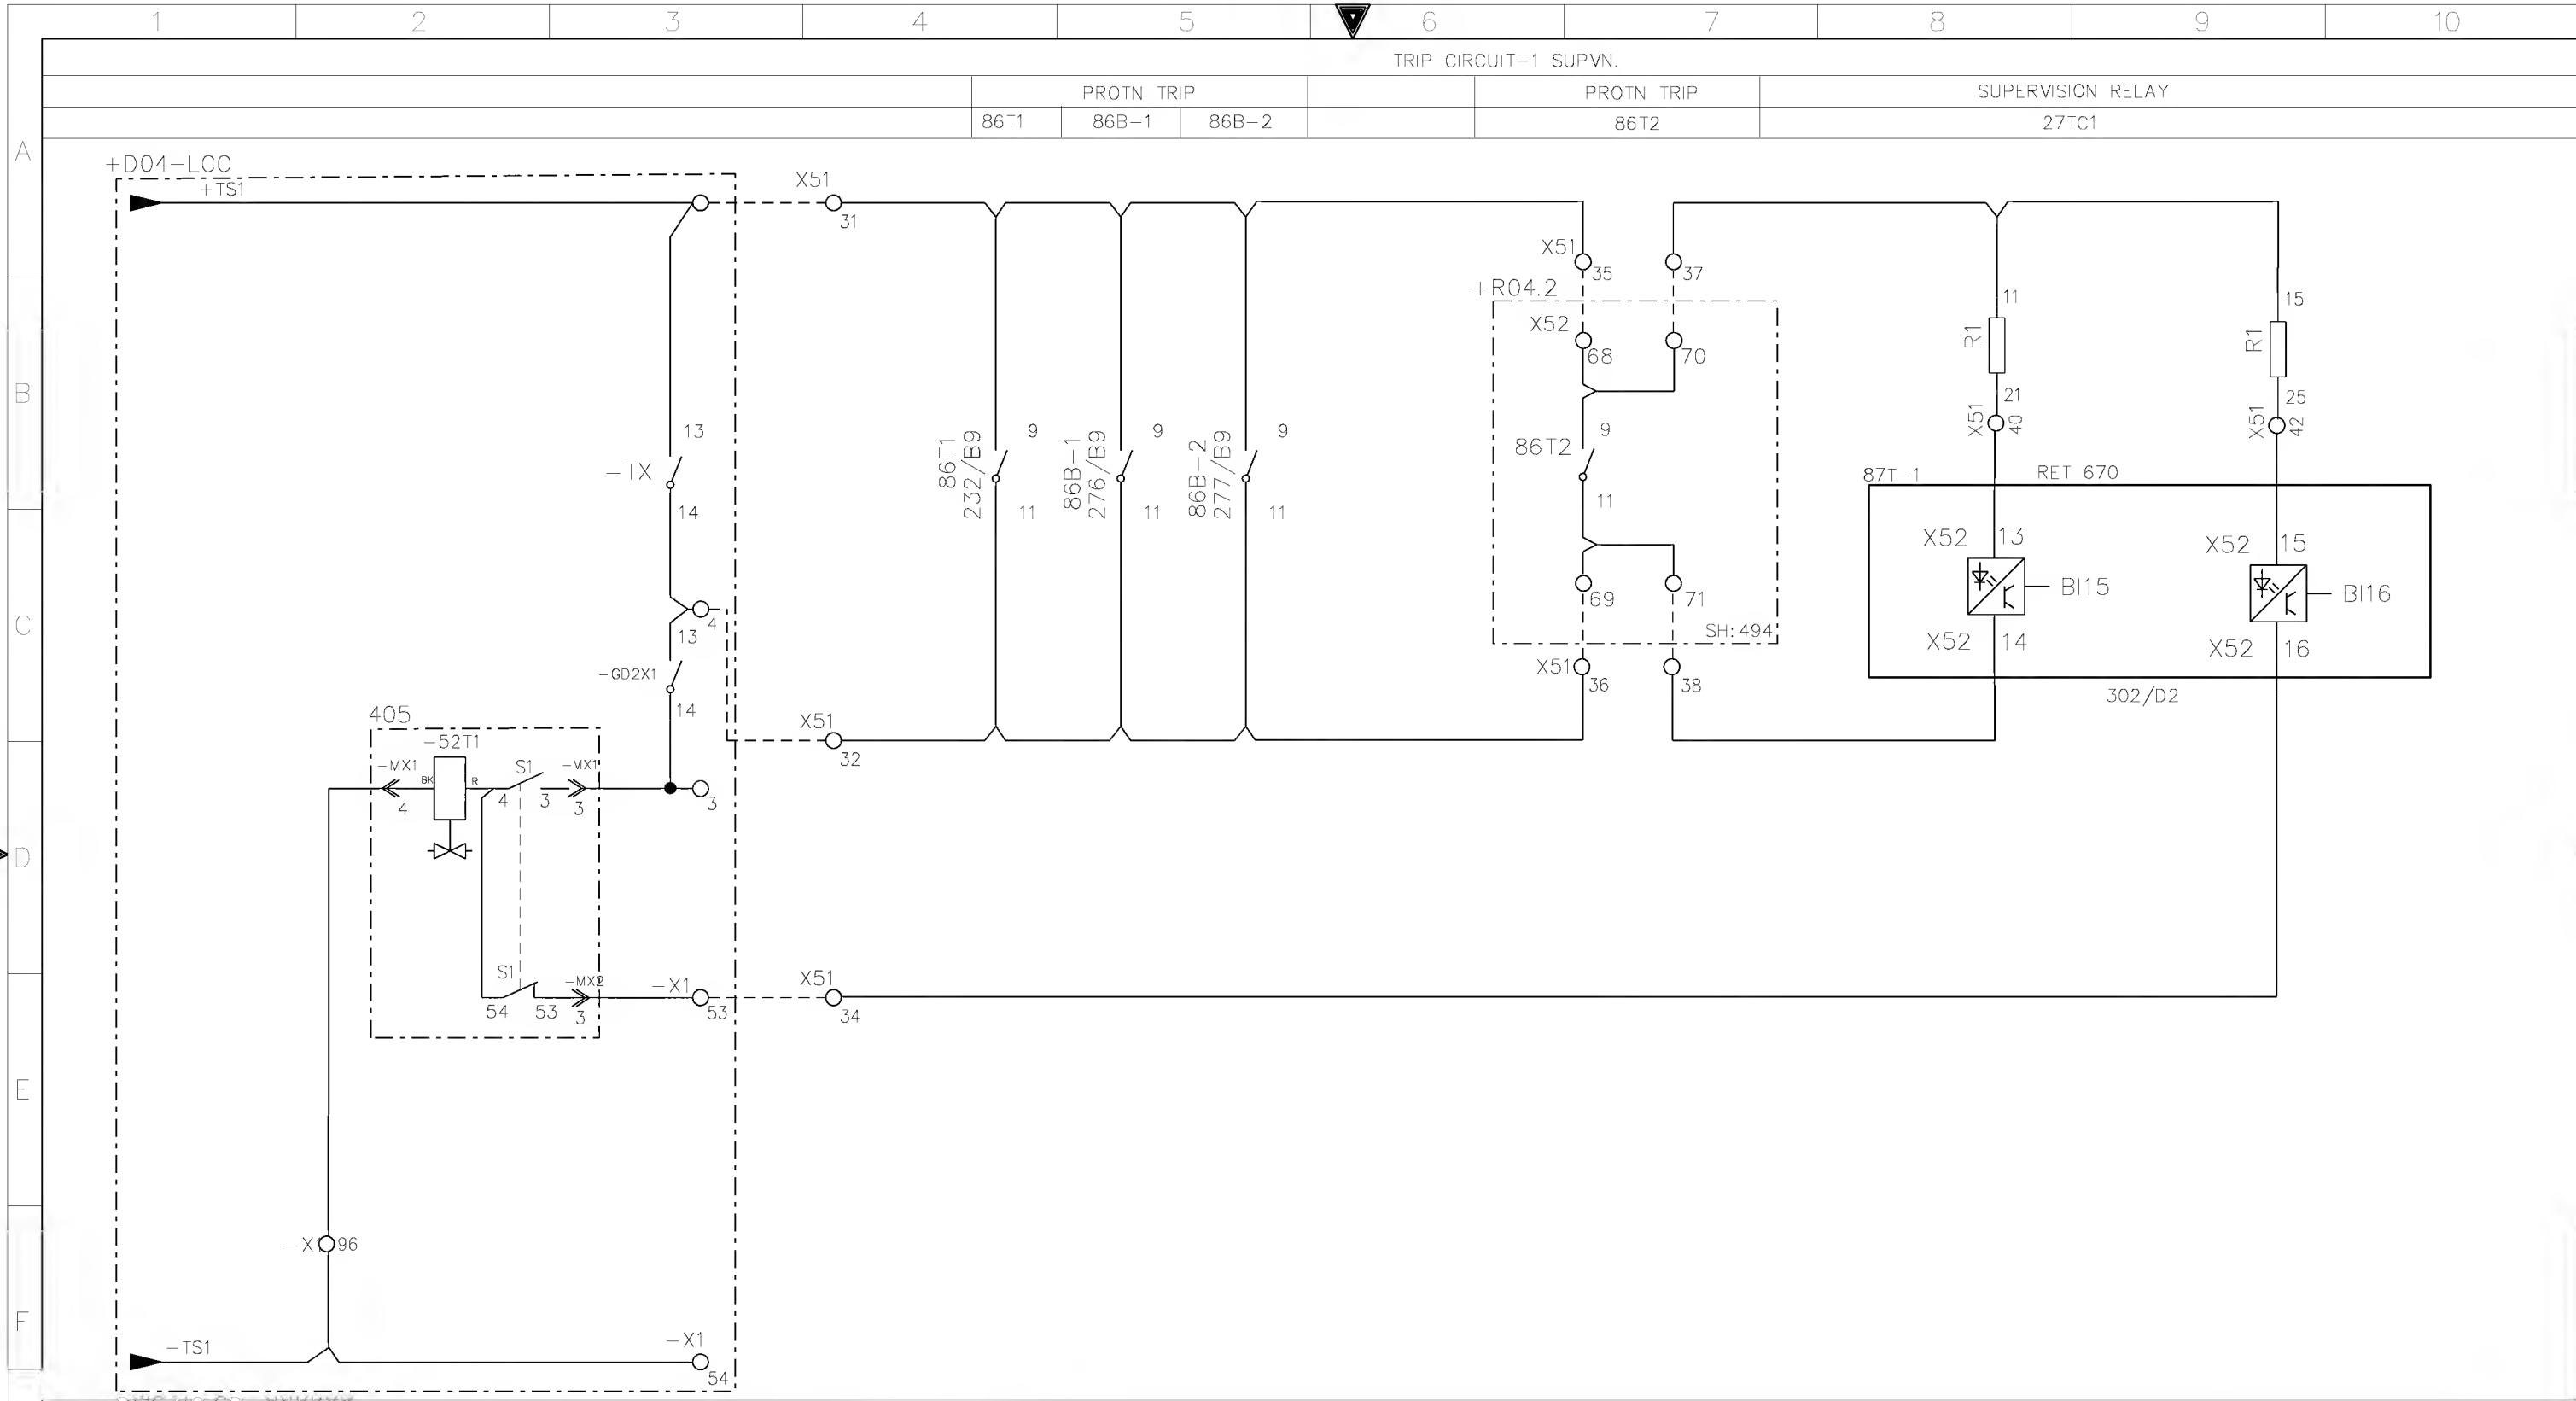

DWG. NO. CD=XXXXXX
SHT. XX


+R04.1

AS-BUILT BY _____ DATE _____ CONTRACT NO. 11131113/00 JOB ORDER NO. S-13656

01	13 49	FACTORY ASBUILT	DRAWN BY RIZ	CHECKED BY JKR
00	13 04	FOR APPROVAL	DATE STARTED 24.01.2013	DATE COMPLETED
REV. NO.	DATE	DESCRIPTION	OPRG. DEPT. CTPD	ENG. DEPT. AUT-PSAC

TRIP COIL-1 SUPERVSION CIRCUIT
132/13.8kV GT-3 RELAY PANEL-1 +R04.1
S/S 8709-132/13.8KV IN AL-KHARJ CITY
RIYADH SAUDI ARABIA

الشركة الوطنية لنقل الكهرباء				نقل الكهرباء	
				National Grid sa	
INDEX	PLANT NO.	DRAWING NUMBER		SHEET NO.	
-	C421	CD322934		SHT	CONT.
				291	292
				01	

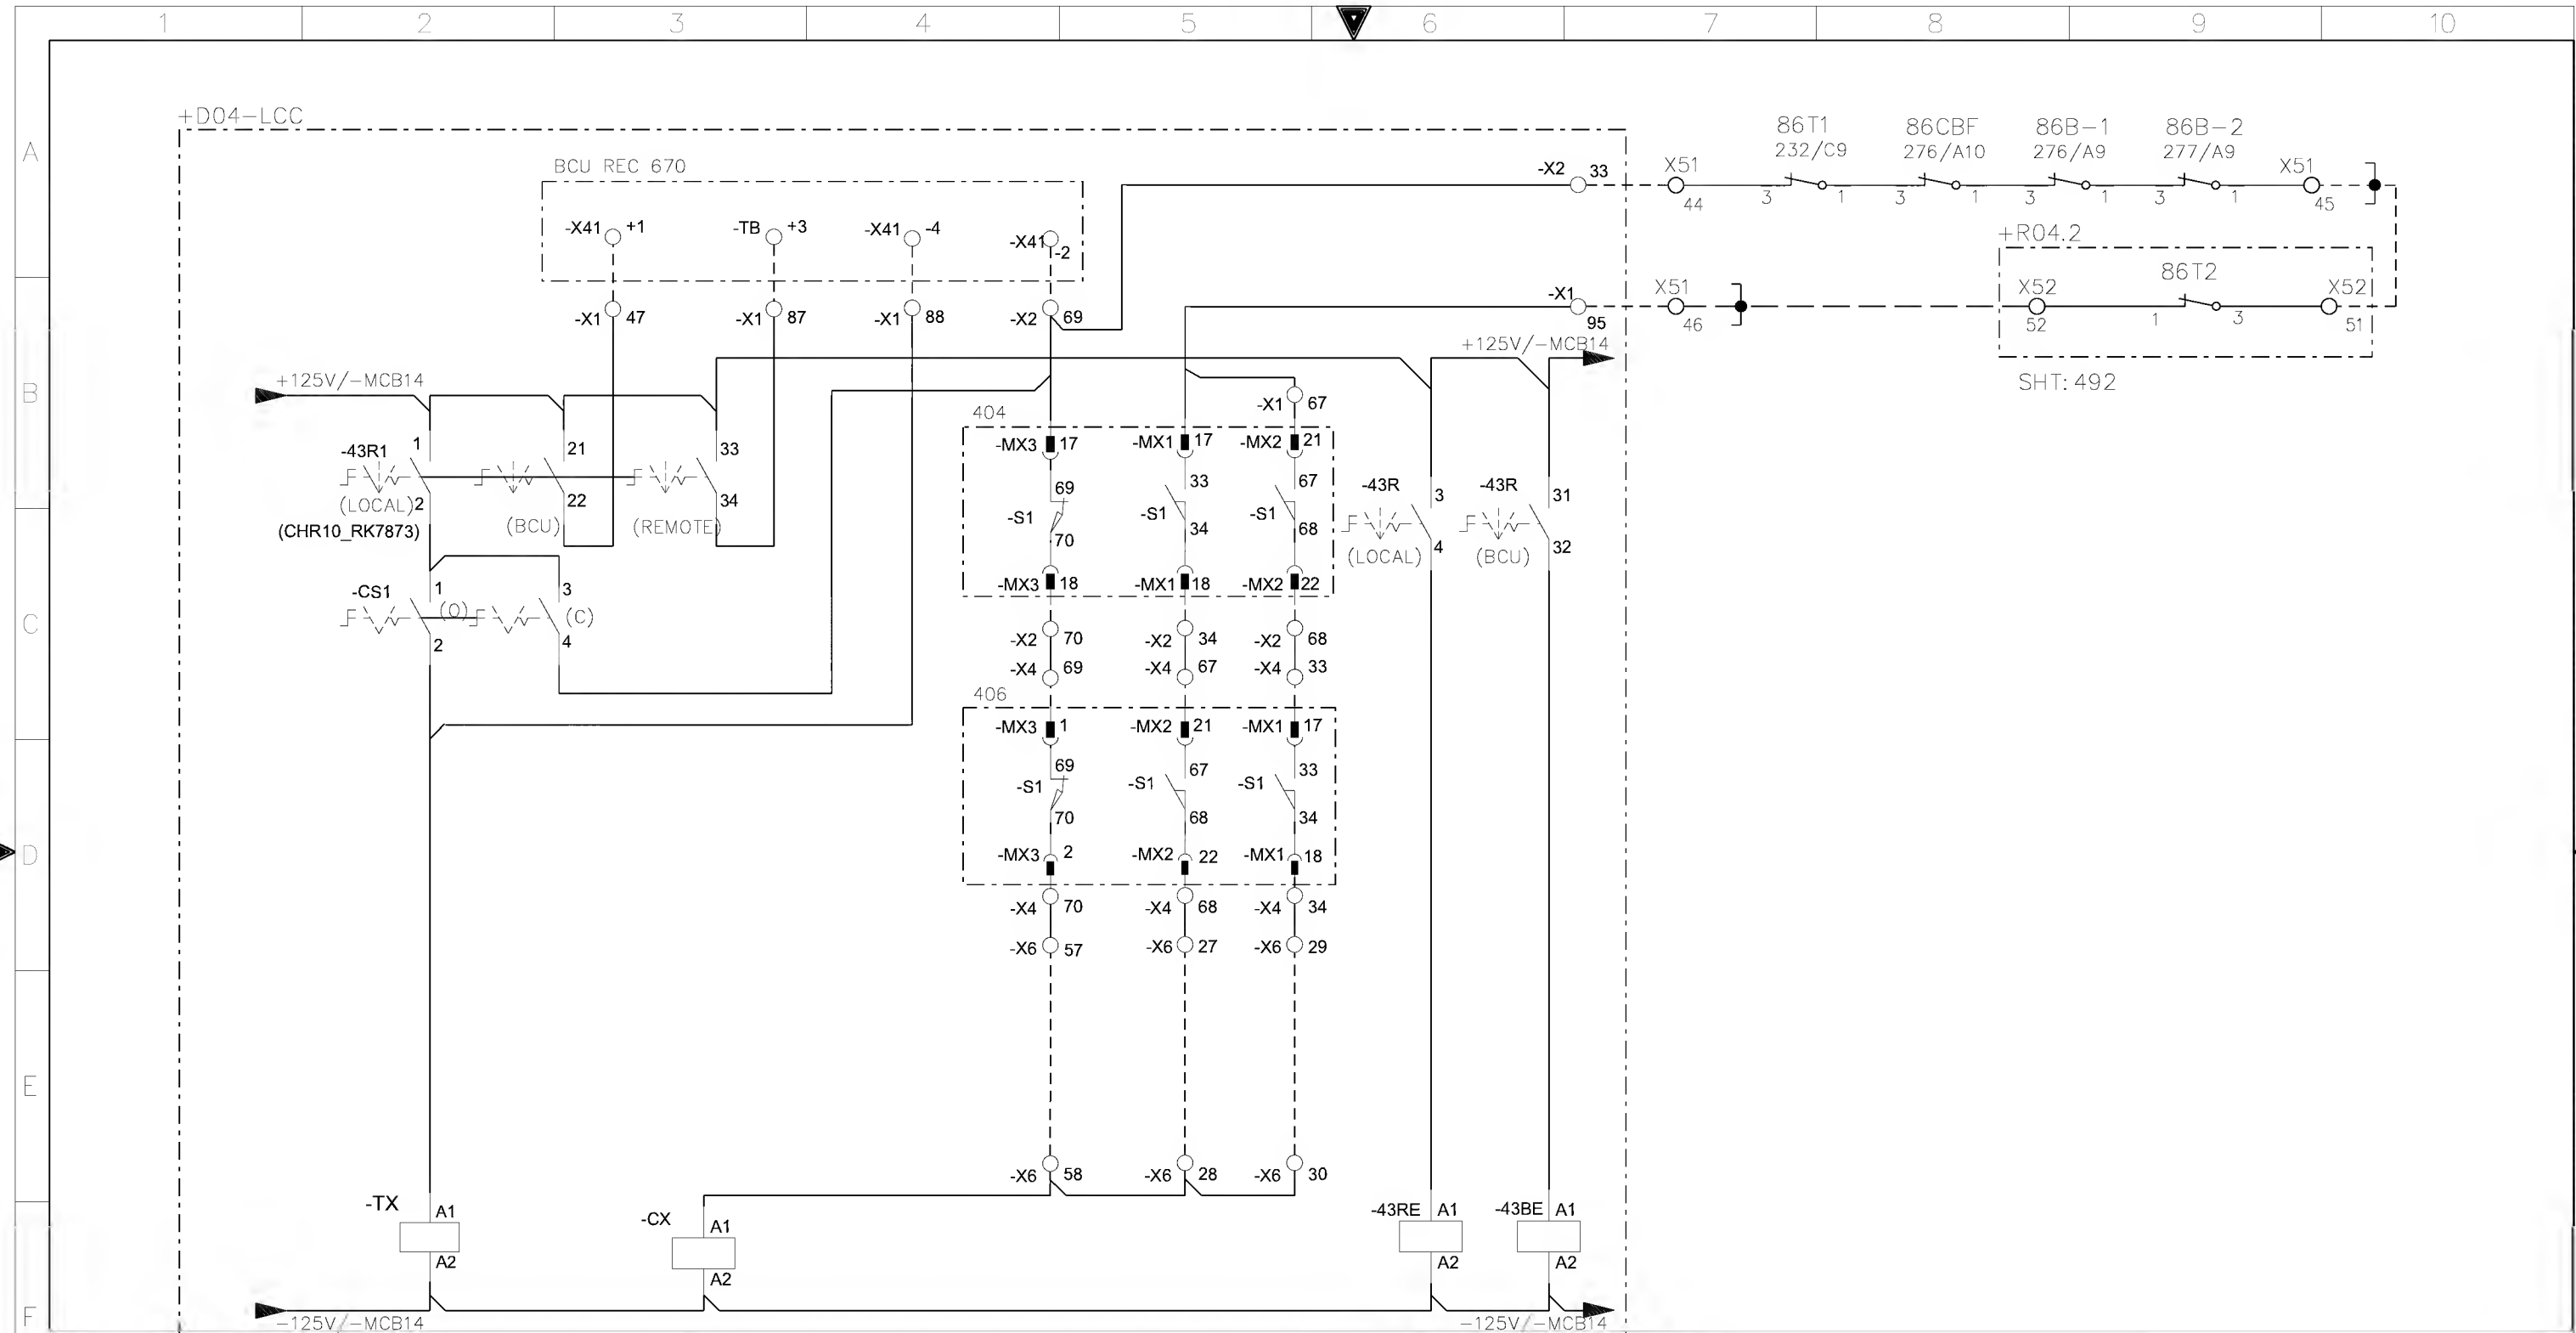



DRG.NO.CD-XXXXXX
SHT: XX


AS-BUILT BY _____ DATE _____			CONTRACT NO. 11131113/00		JOB ORDER NO. S-13656	
01	13 49	FACTORY ASBUILT	DRAWN BY RIZ		CHECKED BY JKR	
00	13 04	FOR APPROVAL	DATE STARTED 24.01.2013		DATE COMPLETED _____	
REV. NO.	DATE	DESCRIPTION	OPRG. DEPT. CTPD		ENG. DEPT. AUT-PSAC	

CB K305 CLOSE BLOCK CIRCUIT	
132/13.8kV GT-3 RELAY PANEL-1 +R04.1	
S/S 8709-132/13.8KV IN AL-KHARJ CITY	
RIYADH SAUDI ARABIA	


الشركة الوطنية لنقل الكهرباء				نقل الكهرباء	
				National Grid SA	
INDEX	PLANT NO.	DRAWING NUMBER	SHEET NO.		REV. NO.
-	C421	CD322934	SHT	CONT.	01
			292	293	

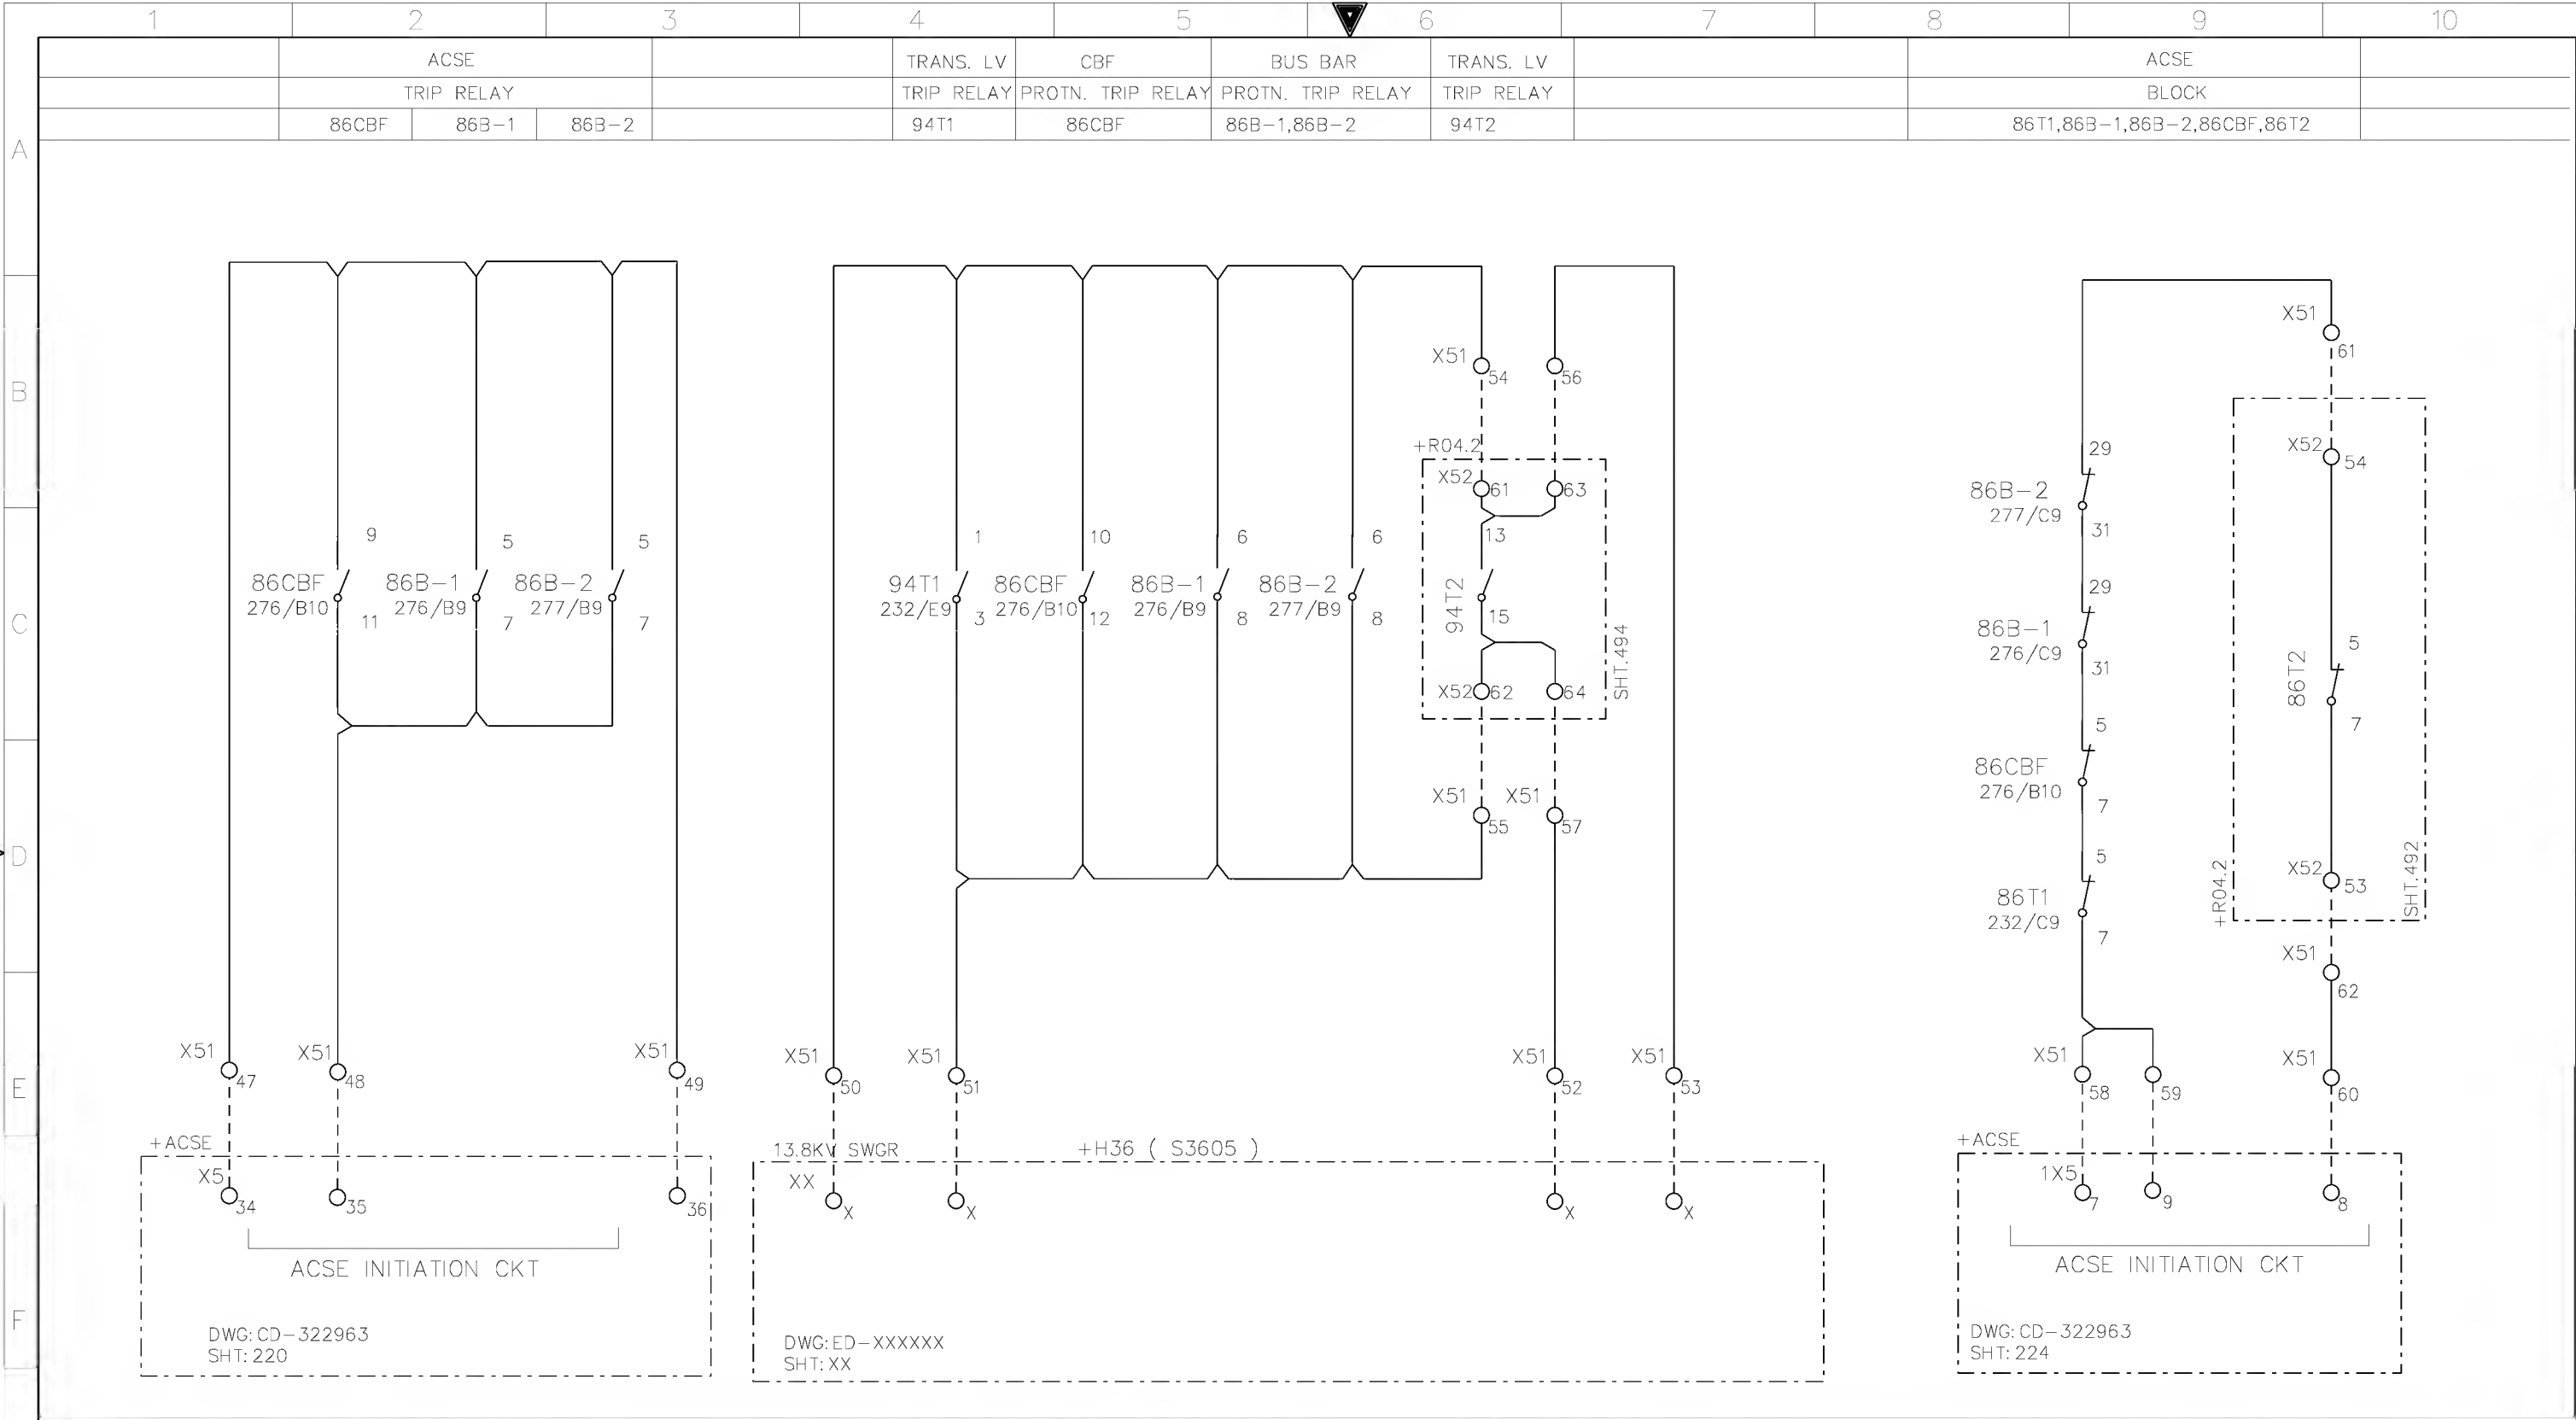

G	AS-BUILT BY _____ DATE _____		CONTRACT NO. 11131113/00		JOB ORDER NO. S-13656		CONTACTS FOR ACSE INITIATION & LV TRIPPING TC		<div><div></div><div>نقل الكهرباء</div><div>الشركة الوطنية لنقل الكهرباء</div><div>National Grid sa</div></div>						
							132/13.8kV GT-3 RELAY PANEL-1 +R04.1								
	01	13 49	FACTORY ASBUILT		DRAWN BY RIZ CHECKED BY JKR		S/S 8709-132/13.8KV IN AL-KHARJ CITY		INDEX	PLANT NO.	DRAWING NUMBER		SHEET NO.		REV. NO.
	00	13 04	FOR APPROVAL		DATE STARTED 24.01.2013 DATE COMPLETED _____		RIYADH SAUDI ARABIA		-	C421	CD322934		SHT CONT.		01
	REV. NO.	DATE	DESCRIPTION		OPRG. DEPT. CTPD ENG. DEPT. AUT-PSAC								293	294	

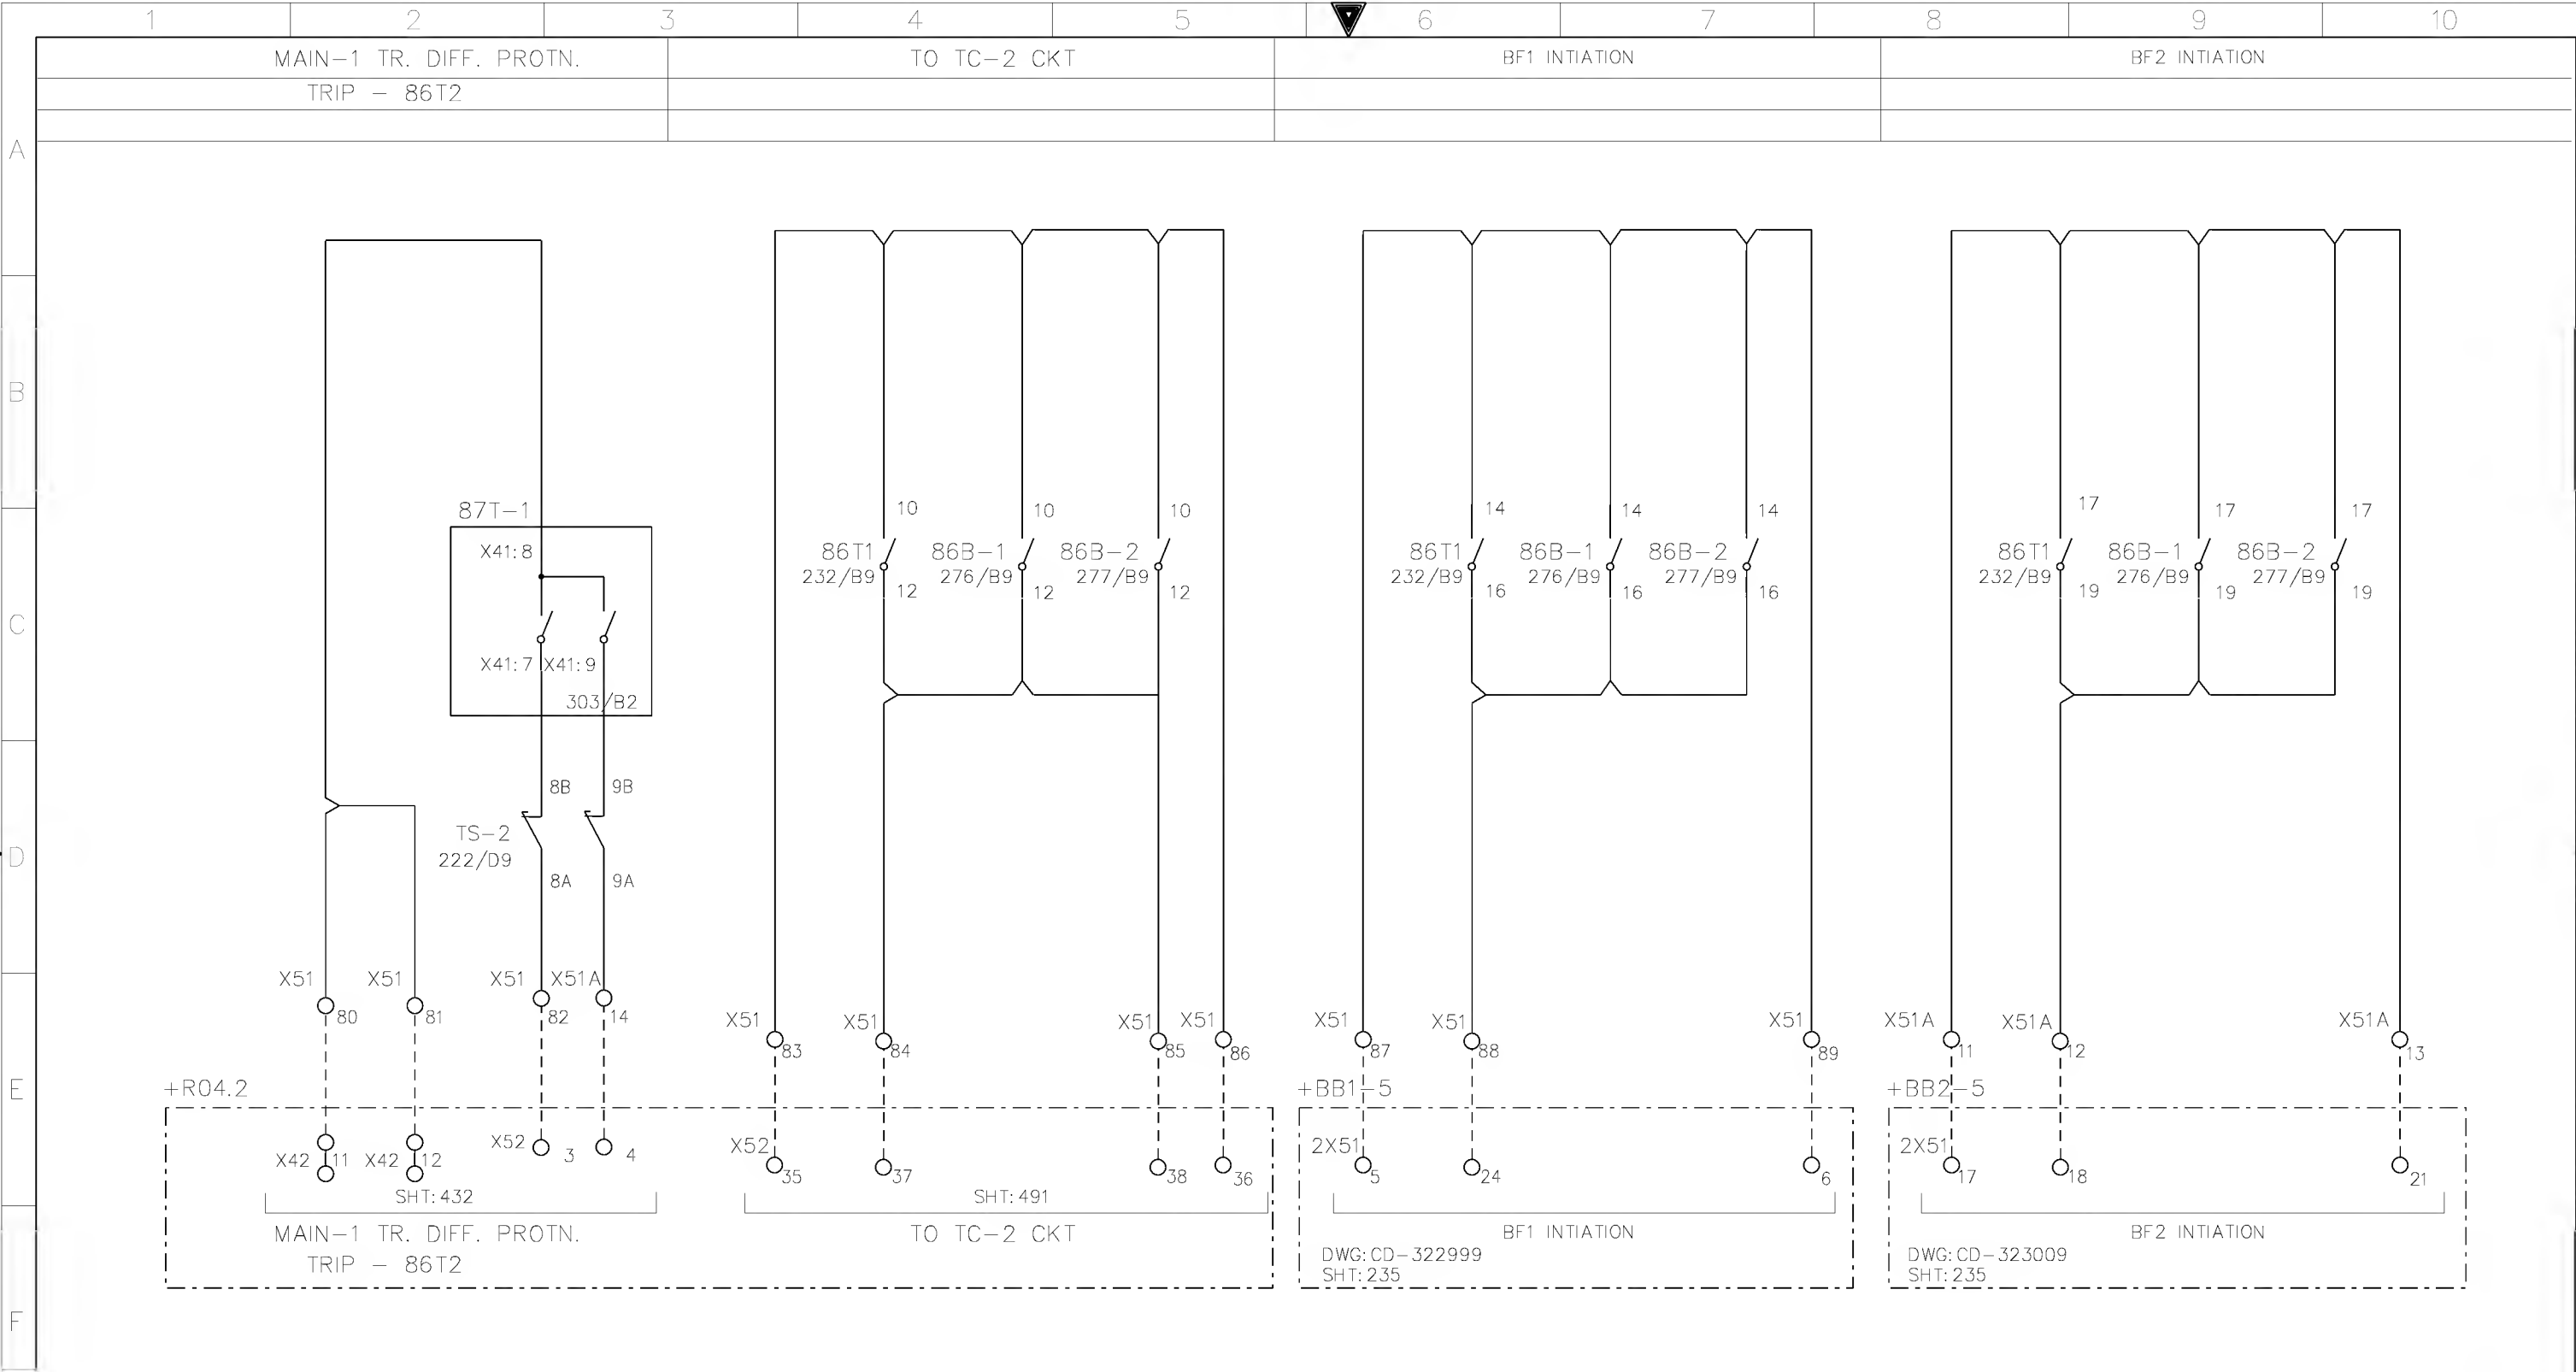

AS-BUILT BY _____ DATE _____			CONTRACT NO. 11131113/00		JOB ORDER NO. S-13656		CONTACTS FOR TRIP CIRCUIT-2 & BF1½		<div>نقل الكهرباء</div> <div>الشركة الوطنية لنقل الكهرباء</div> <div>National Grid sa</div>				
			DRAWN BY <u>RIZ</u> CHECKED BY <u>JKR</u>		132/13.8kv GT-3 RELAY PANEL-1 +R04.1								
01 13 49 FACTORY ASBUILT			DATE STARTED <u>24.01.2013</u> DATE COMPLETED _____		S/S 8709-132/13.8KV IN AL-KHARJ CITY		INDEX		PLANT NO.	DRAWING NUMBER	SHEET NO.		REV. NO.
00 13 04 FOR APPROVAL			OPRG. DEPT. <u>CTPD</u> ENG. DEPT. <u>AUT-PSAC</u>		RIYADH SAUDI ARABIA		-		C421	CD322934	SHT CONT.		01
REV. NO. DATE DESCRIPTION											295 296		

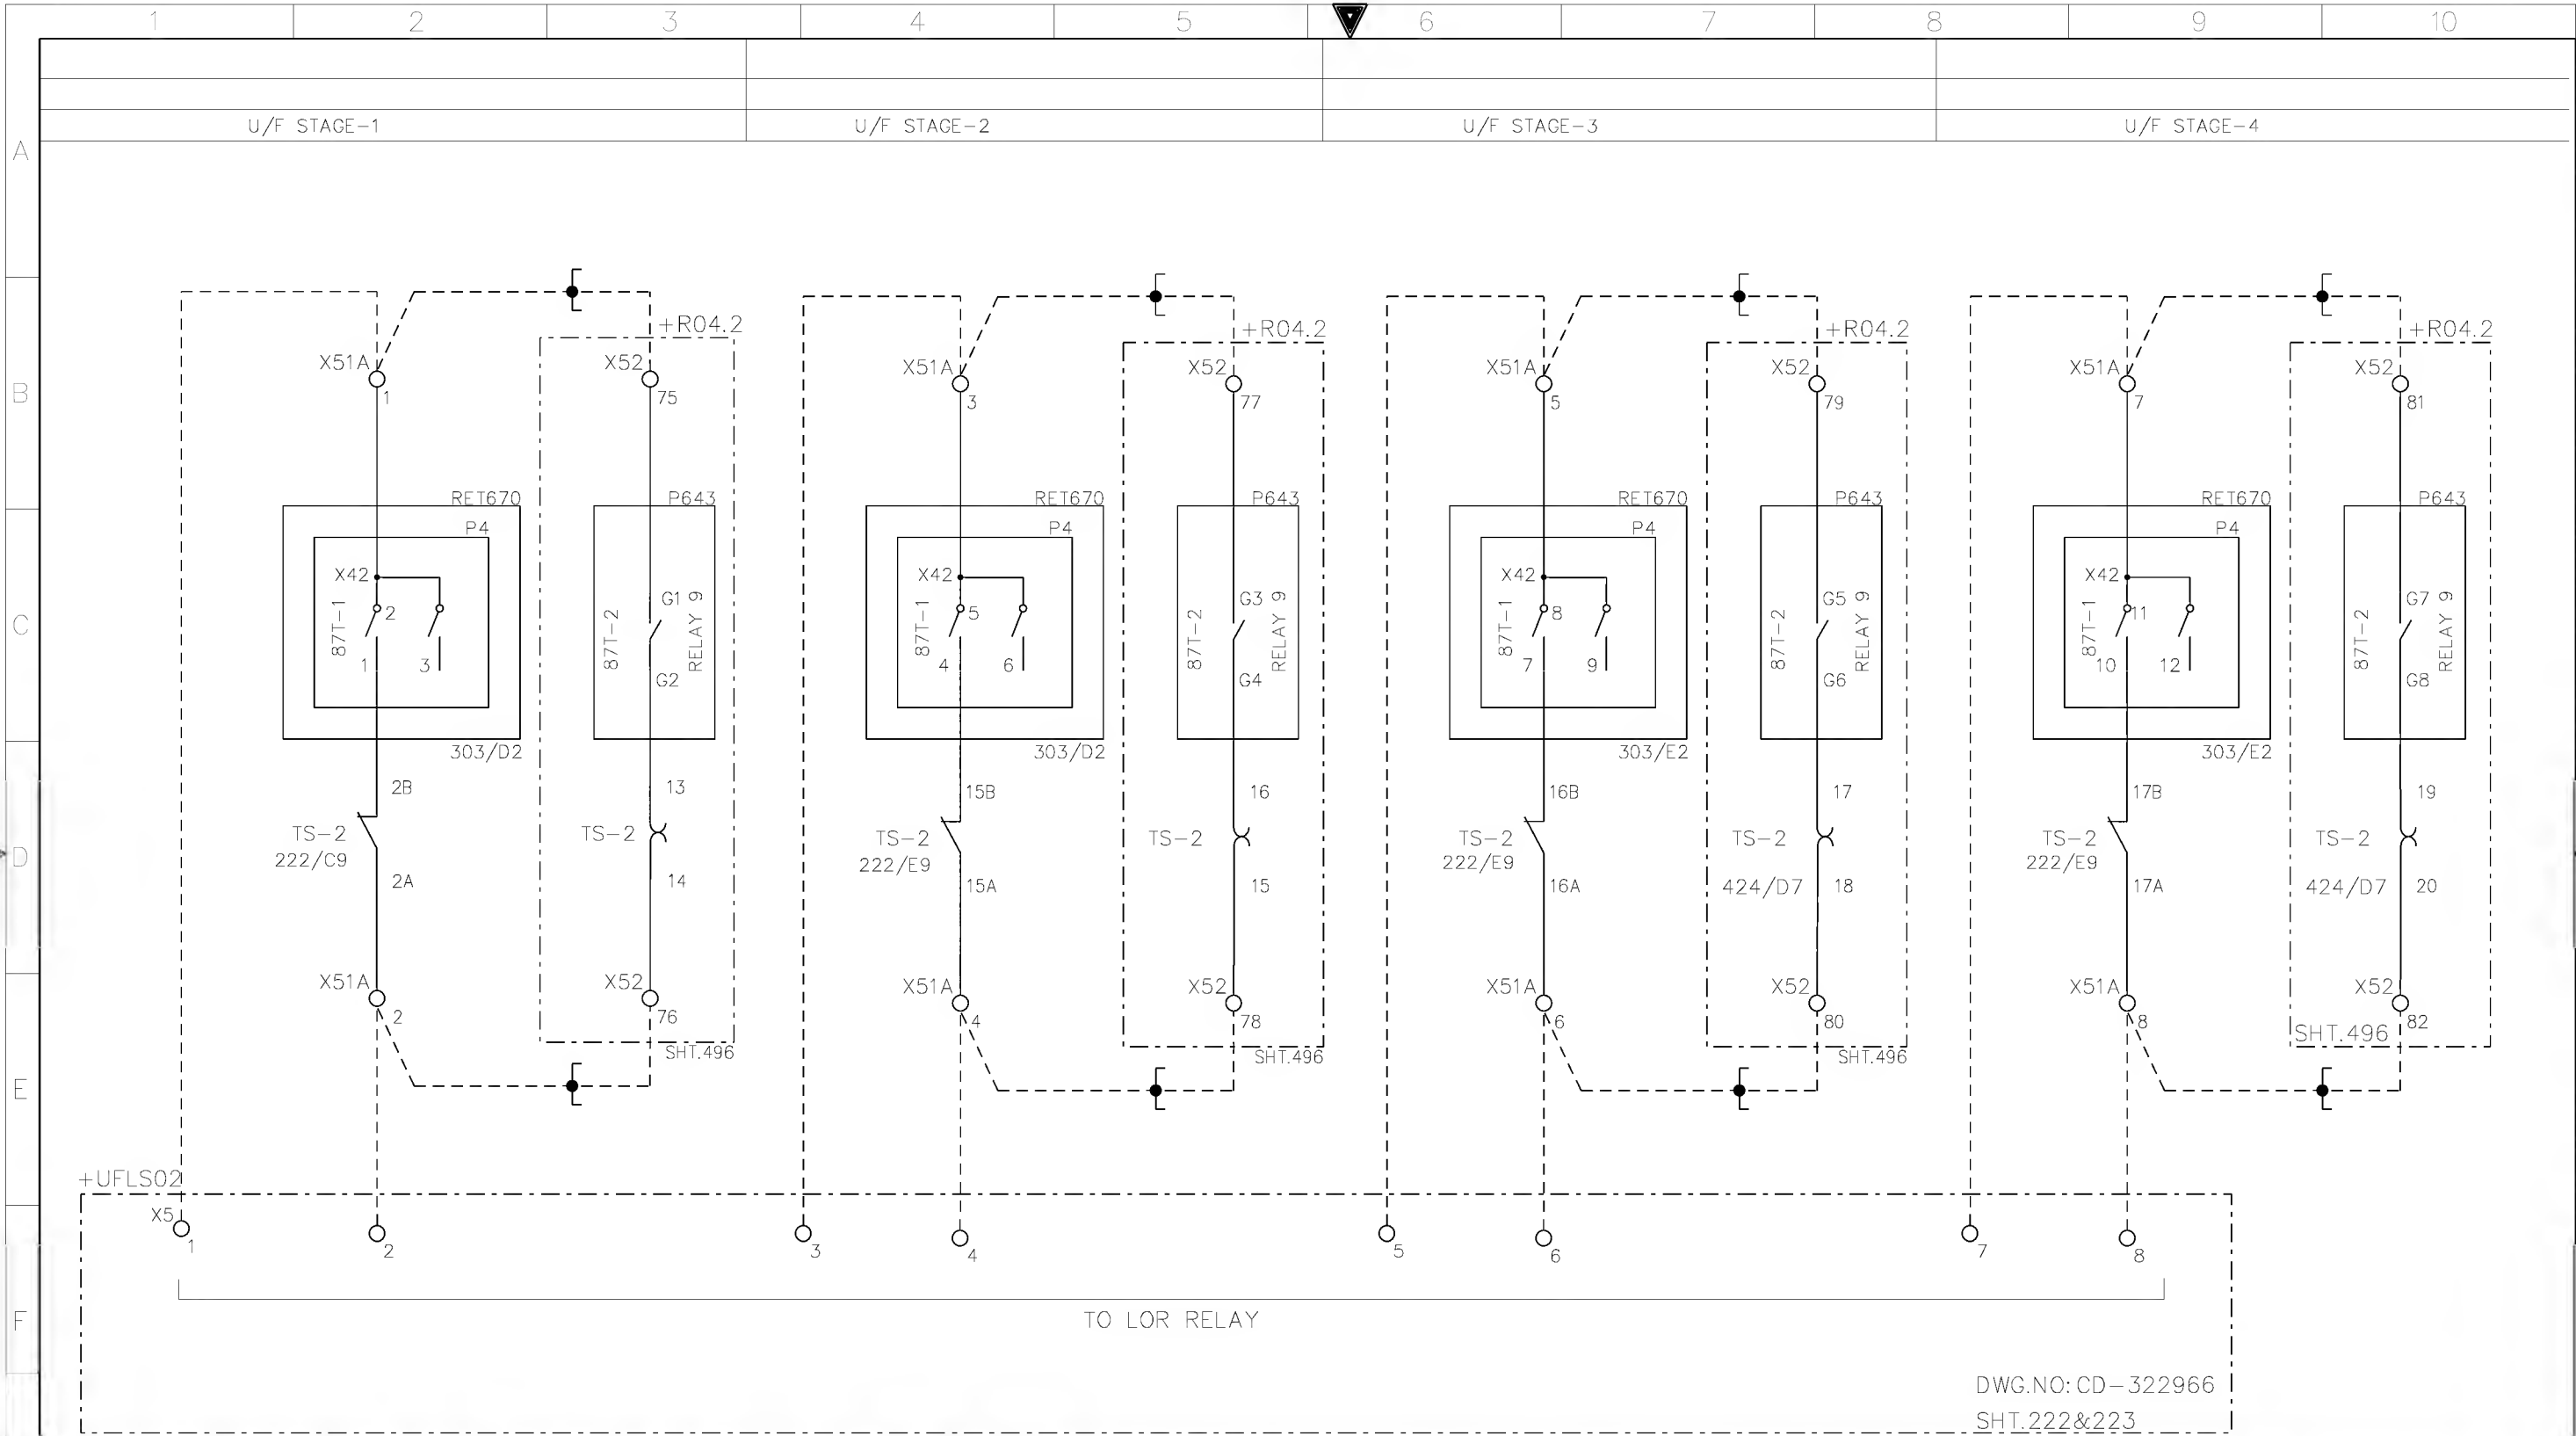

AS-BUILT BY _____ DATE _____ CONTRACT NO. 11131113/00 JOB ORDER NO. S-13656

01	13 49	FACTORY ASBUILT	DRAWN BY RIZ	CHECKED BY JKR
00	13 04	FOR APPROVAL	DATE STARTED 24.01.2013	DATE COMPLETED _____
REV. NO.	DATE	DESCRIPTION	OPRG. DEPT. CTPD	ENG. DEPT. AUT-PSAC

CONTACTS FOR U/F LOAD SHEDDING


132/13.8kV GT-3 RELAY PANEL-1 +R04.1
S/S 8709-132/13.8KV IN AL-KHARJ CITY
RIYADH SAUDI ARABIA

الشركة الوطنية لنقل الكهرباء
National Grid SA

INDEX	PLANT NO.	DRAWING NUMBER	SHEET NO.	REV. NO.
-	C421	CD322934	296/298	01

NG/D2-D (2012/01)

DMS VECTOR NGD200

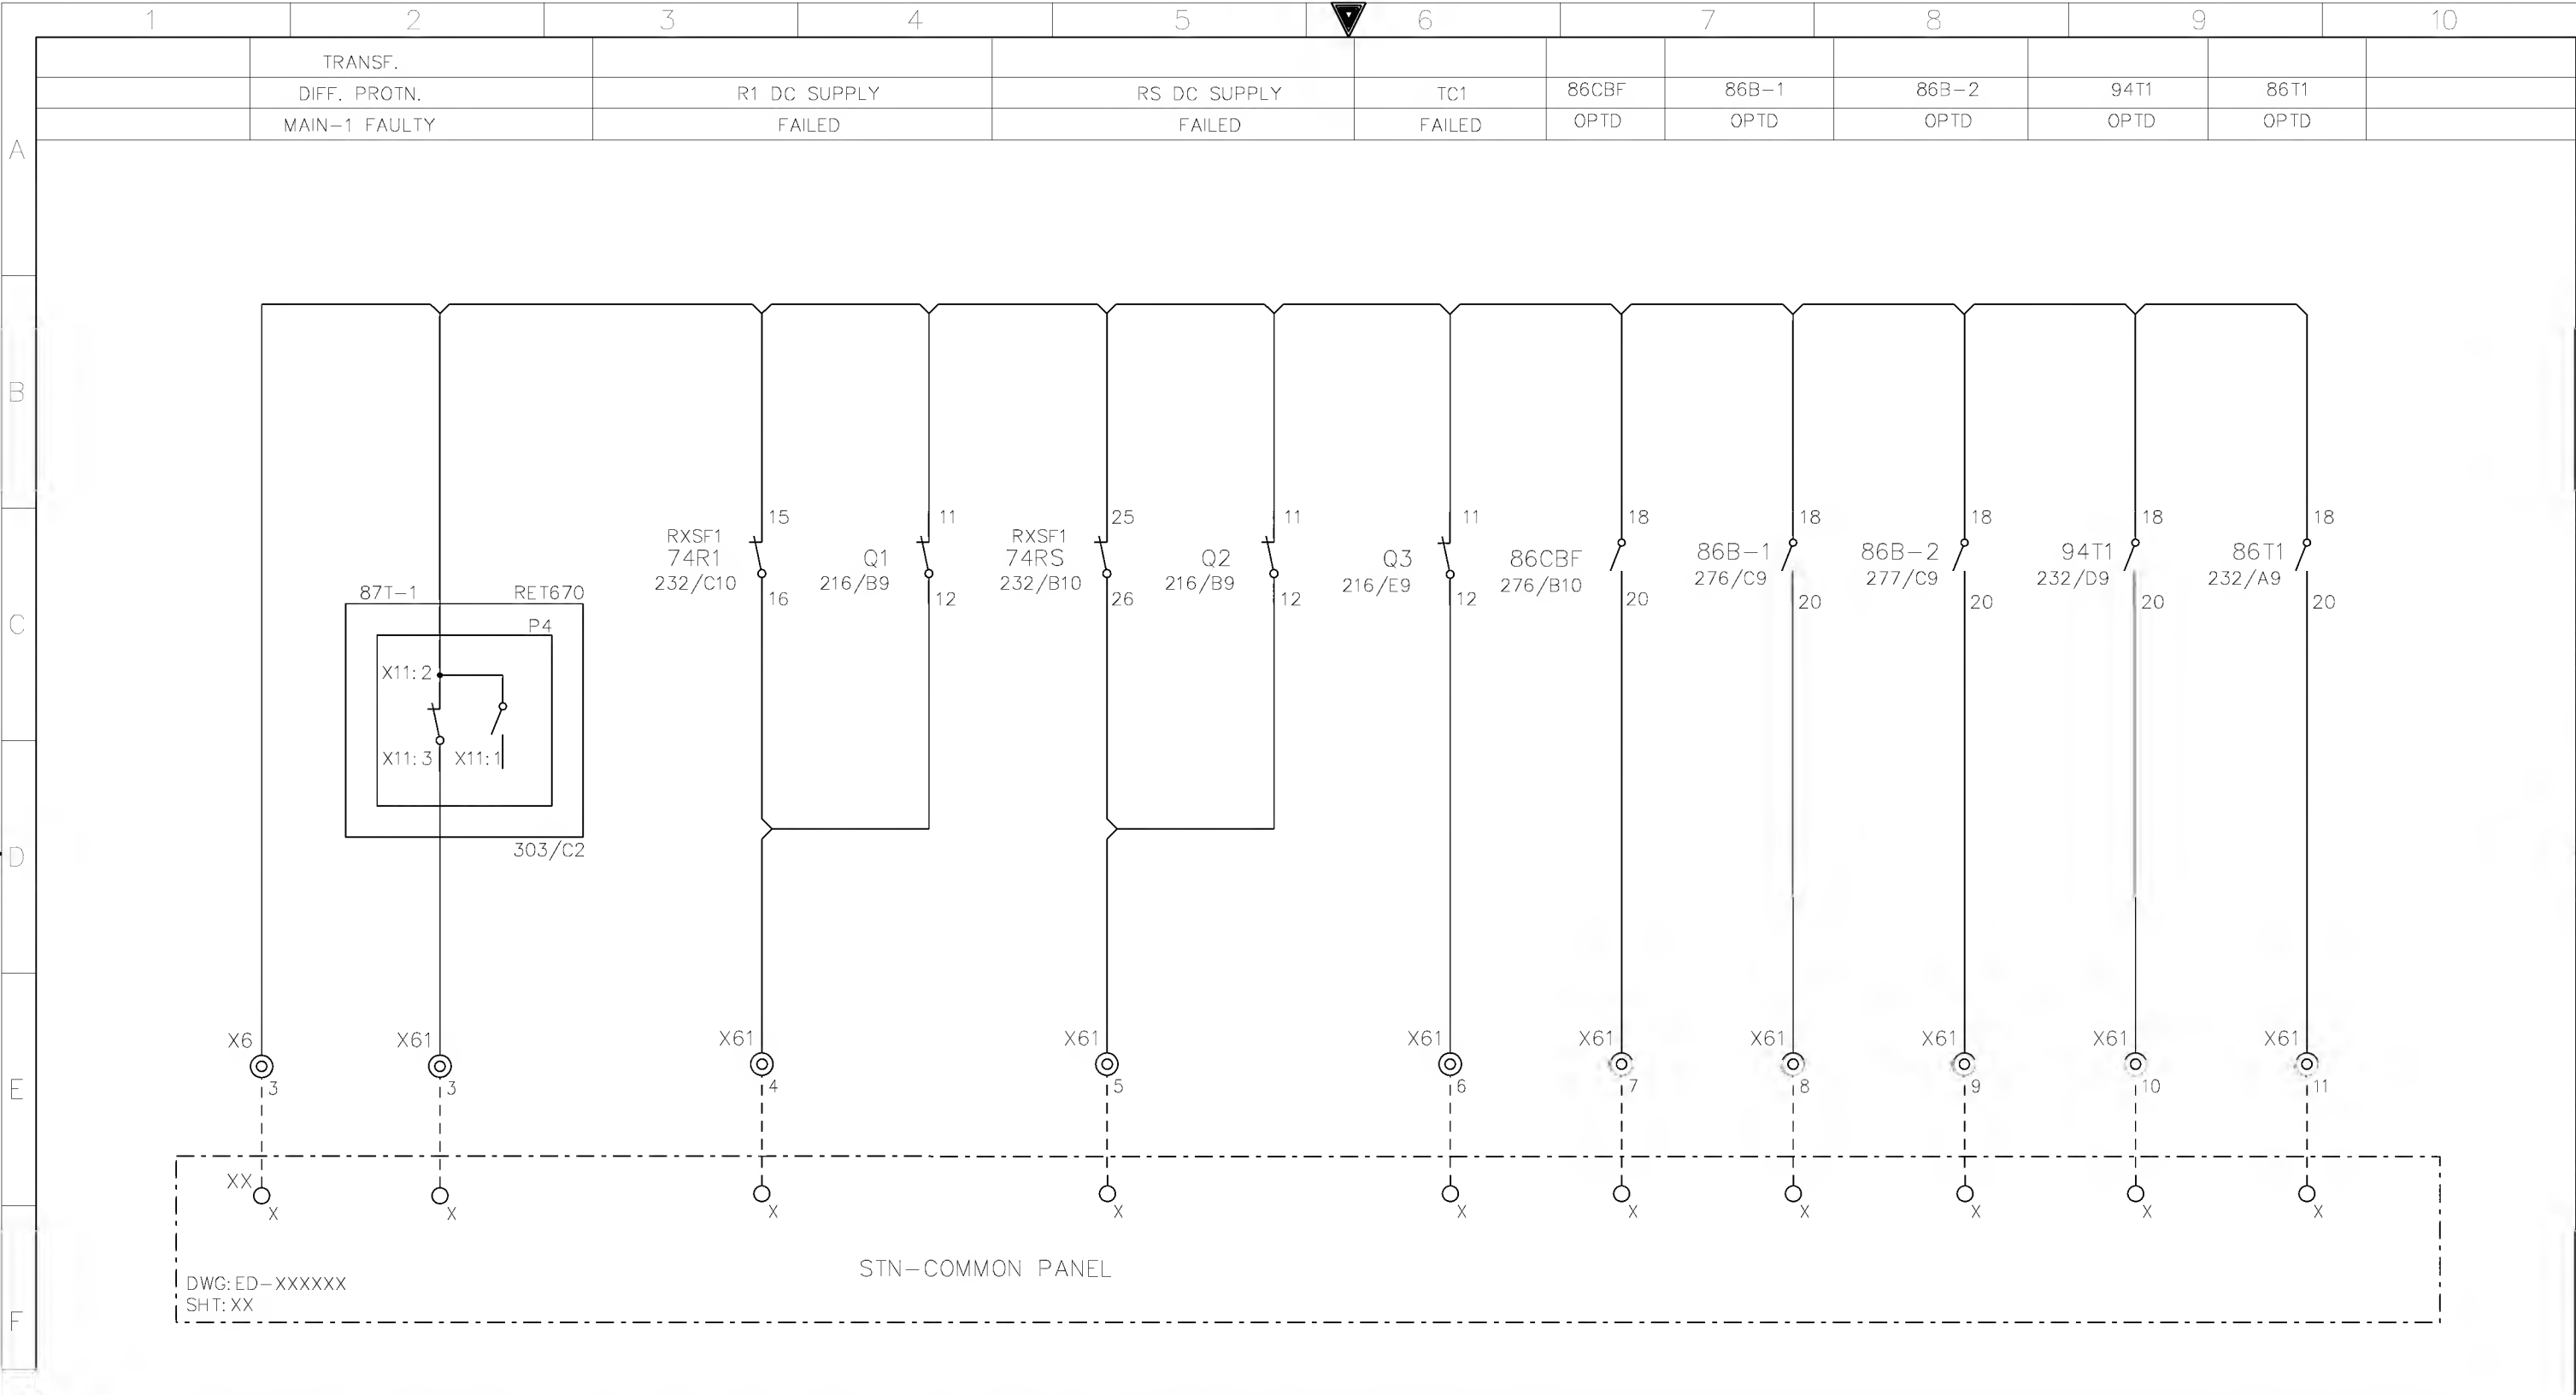

AS-BUILT BY _____ DATE _____

CONTRACT NO. 11131113/00

JOB ORDER NO. S-13656


STN-COMMON ALARM CIRCUIT

132/13.8kV GT-3 RELAY PANEL-1 +R04.1

S/S 8709-132/13.8KV IN AL-KHARJ CITY

RIYADH SAUDI ARABIA

الشركة الوطنية لنقل الكهرباء

 **نقل الكهرباء**
National Grid sa

INDEX

PLANT NO.

DRAWING NUMBER

SHEET NO.

SHTCONT.

REV. NO.


-

C421

CD322934

298299

01

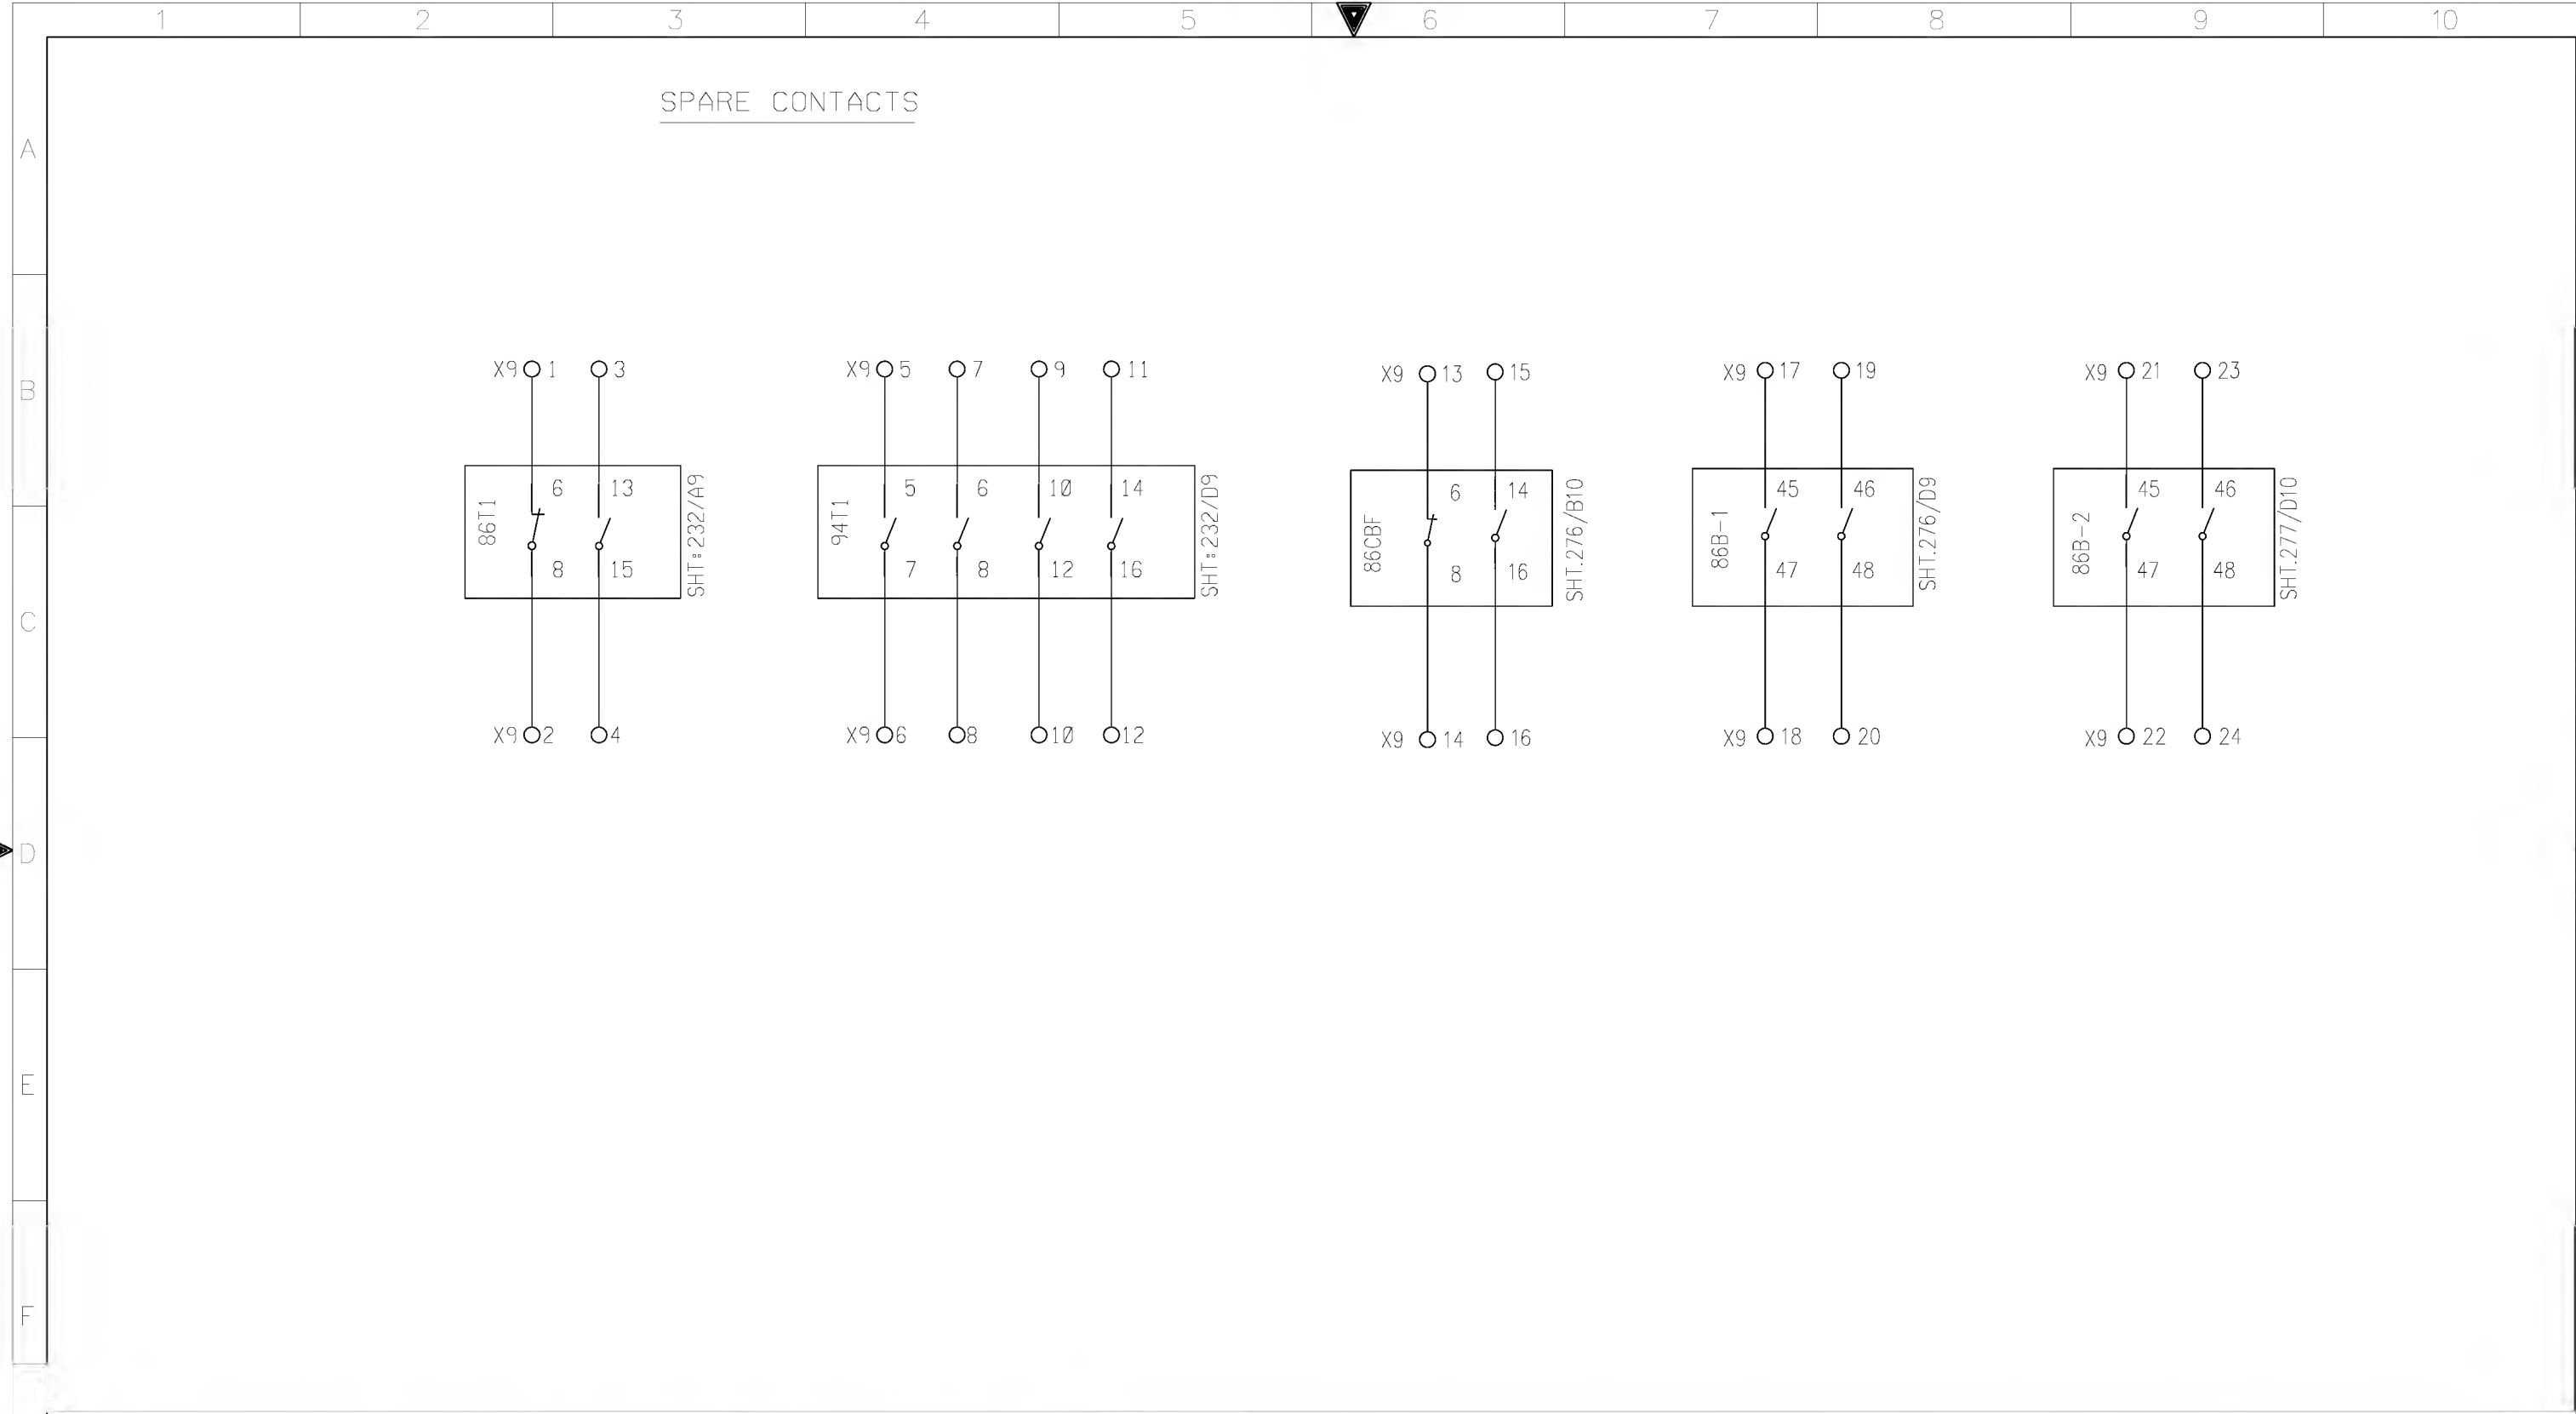

AS-BUILT BY _____ DATE _____ CONTRACT NO. 11131113/00 JOB ORDER NO. S-13656

01	13 49	FACTORY ASBUILT	DRAWN BY RIZ	CHECKED BY JKR
00	13 04	FOR APPROVAL	DATE STARTED 24.01.2013	DATE COMPLETED
REV. NO.	DATE	DESCRIPTION	OPRG. DEPT. CTPD	ENG. DEPT. AUT-PSAC

LOR SPARE CONTACTS

132/13.8kV GT-3 RELAY PANEL-1 +R04.1

S/S 8709-132/13.8KV IN AL-KHARJ CITY
RIYADH SAUDI ARABIA

الشركة الوطنية لنقل الكهرباء



National Grid sa


INDEX	PLANT NO.	DRAWING NUMBER	SHEET NO.		REV. NO.
-	C421	CD322934	SHT	CONT.	01
			299	301	

NG/D2-D (2012/01)

DMS

VECTOR

NGD200

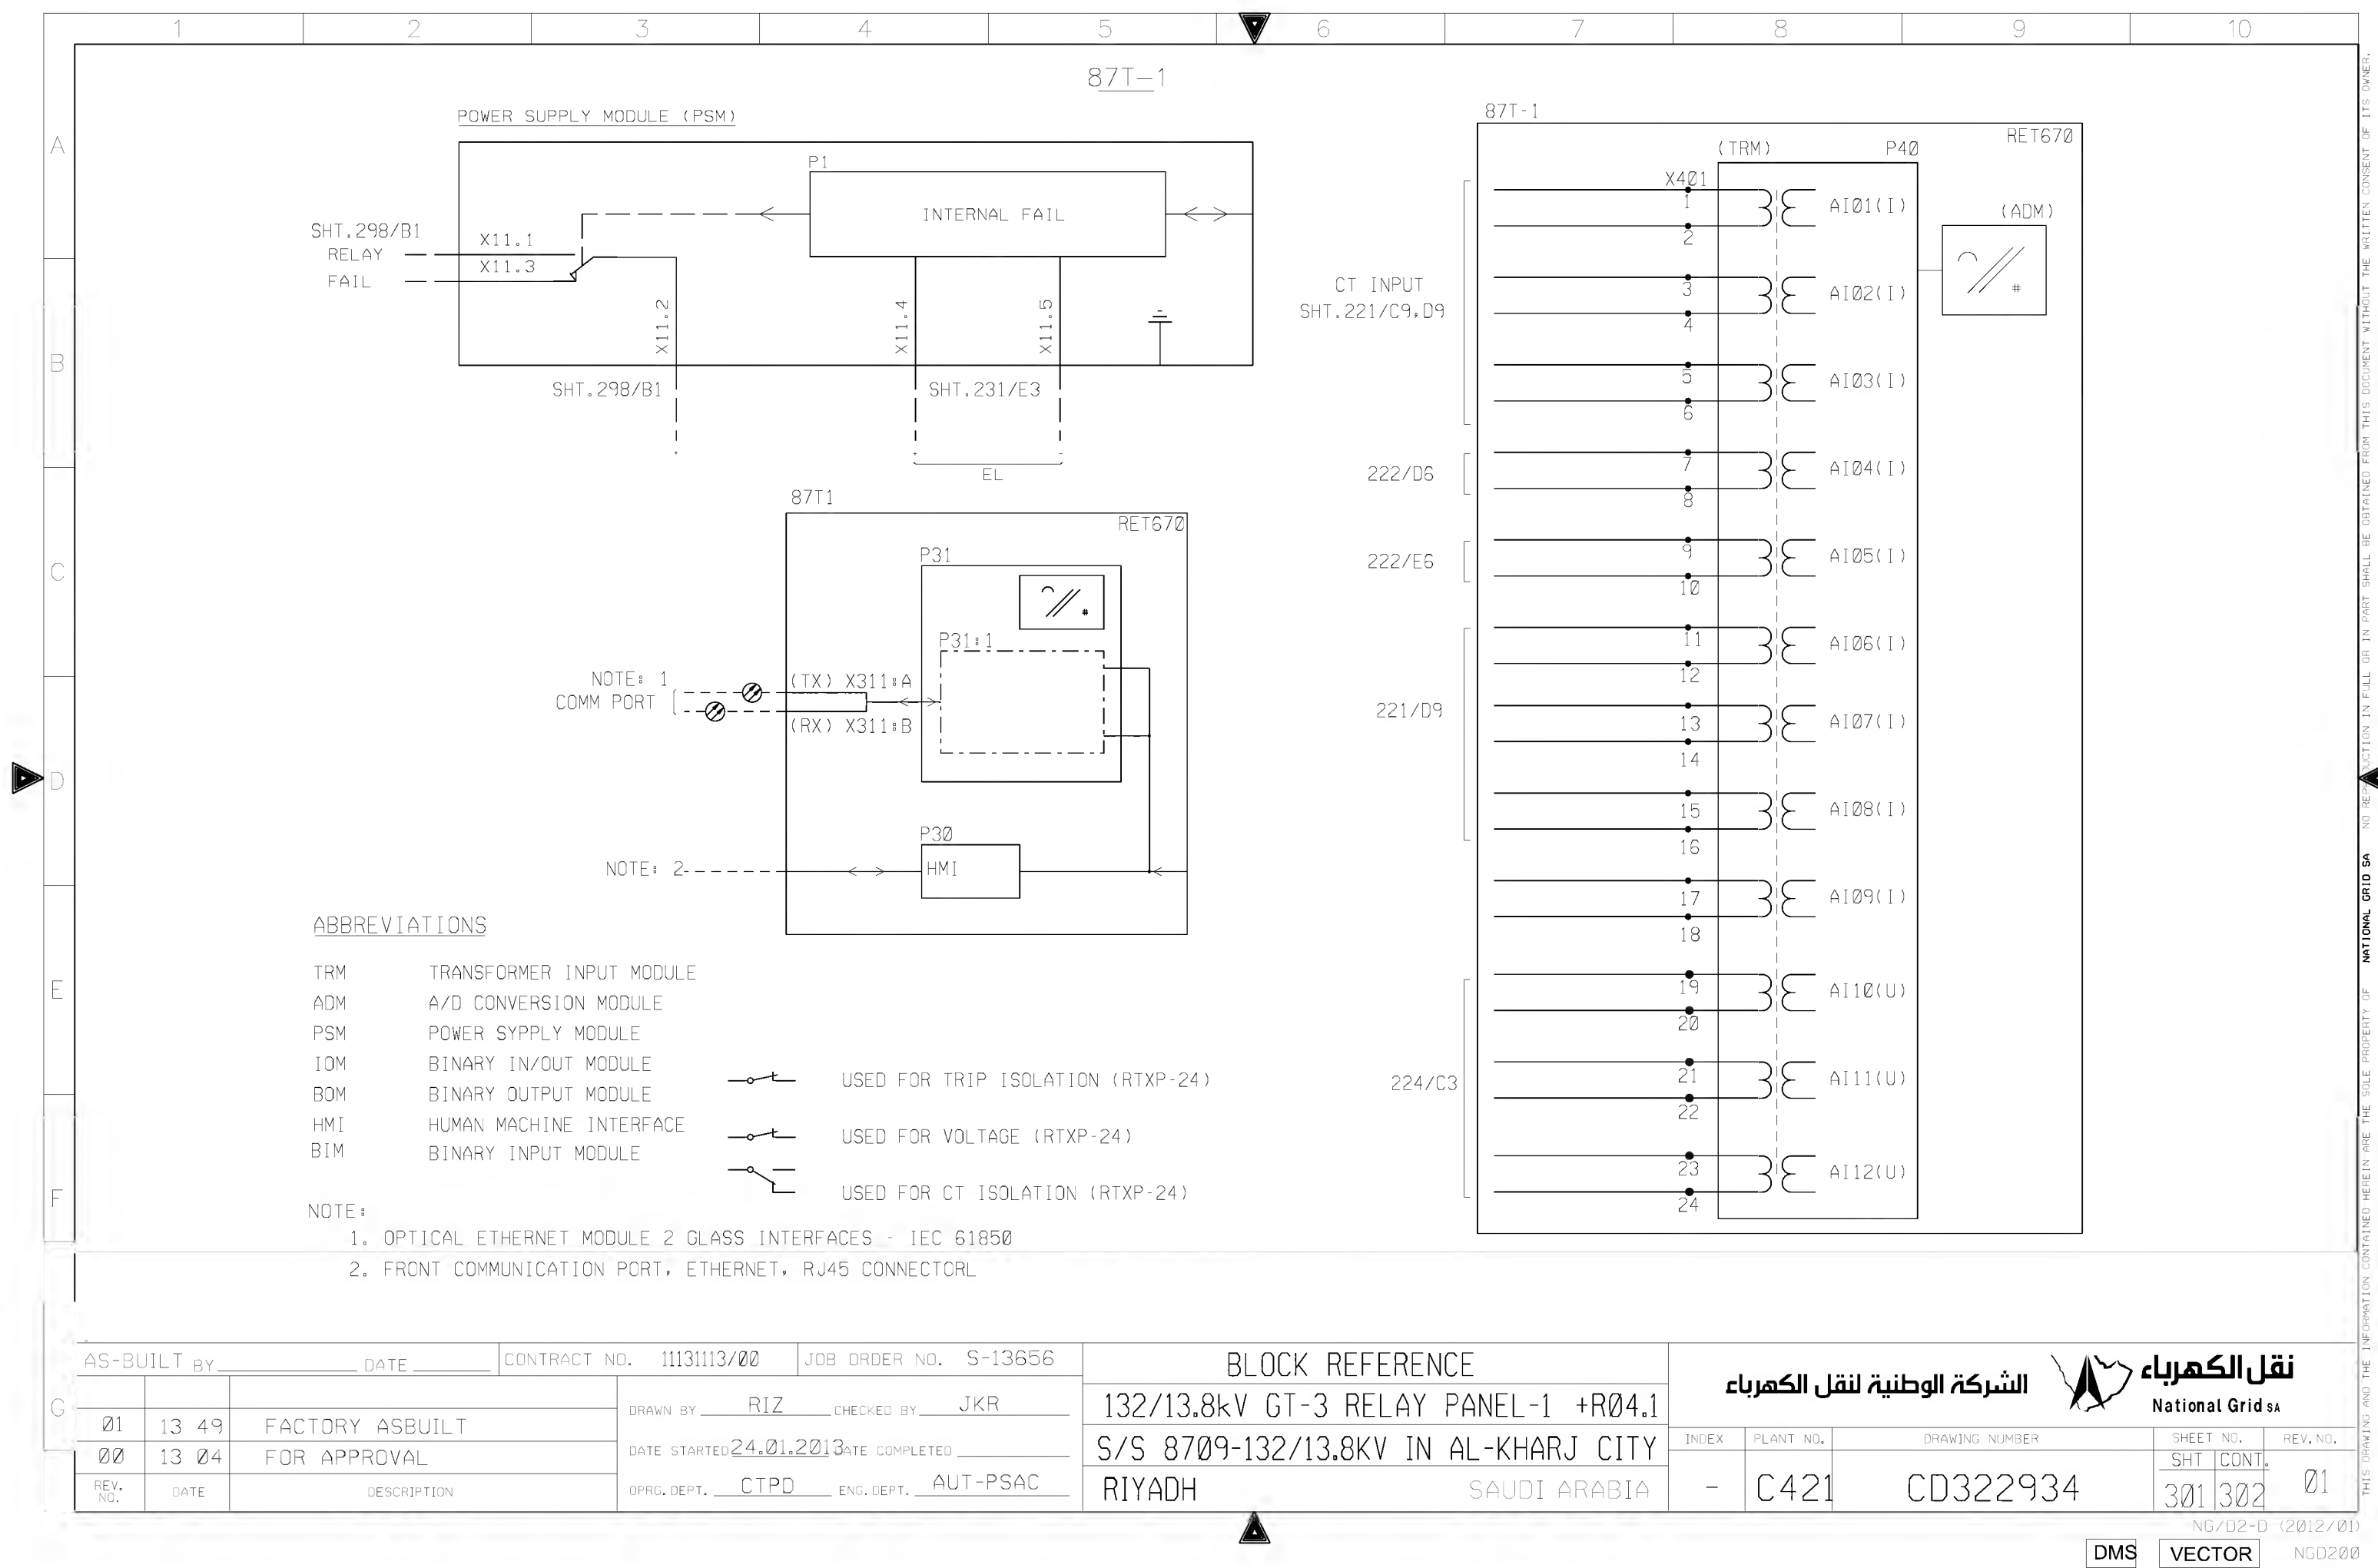

1

2

3

4

5

6

7

8

9

10

A

B

C

D

E

F

BINARY INPUT CARD

87T-1

BIM P3
RET670

LOCATION=P3

PLANT ADAPTED
CONFIGURATION

X31

1

2

3

BI.01

BI.02

BI.03

BI.04

BI.05

BI.06

BI.07

BI.08

//

//

VT MCB FAIL

SPARE

SPARE

CBF1 INITIATION

SPARE

X32

1

2

3

BI.09

BI.10

BI.11

BI.12

BI.13

BI.14

BI.15

BI.16

//

//

SPARE

SPARE

SHT.227/E3

SHT.228/E4

BINARY INPUT CARD

87T-1

BIM P5
RET670

LOCATION=P6

PLANT ADAPTED
CONFIGURATION

X51

1

2

3

BI.01

BI.02

BI.03

BI.04

BI.05

BI.06

BI.07

BI.08

//

//

SPARE

SPARE

X52

1

2

3

BI.09

BI.10

BI.11

BI.12

BI.13

BI.14

BI.15

BI.16

//

//

SPARE

SPARE

SHT.228/E8

SHT.291/C9, C10

AS-BUILT BY _____ DATE _____

CONTRACT NO. 11131113/00

JOB ORDER NO. S-13656

01

13 49

FACTORY ASBUILT

00

13 04

FOR APPROVAL

REV. NO.

DATE

DESCRIPTION

DRAWN BY RIZ

CHECKED BY JKR

DATE STARTED 24.01.2013

DATE COMPLETED _____

OPRG. DEPT. CTPD

ENG. DEPT. AUT-PSAC

BLOCK REFERENCE

132/13.8kV GT-3 RELAY PANEL-1 +R04.1

S/S 8709-132/13.8KV IN AL-KHARJ CITY

RIYADH SAUDI ARABIA

الشركة الوطنية لنقل الكهرباء

National Grid sa

INDEX

PLANT NO.

DRAWING NUMBER

SHEET NO.

SHT

CONT.

REV. NO.

-


C421

CD322934

302

303


01

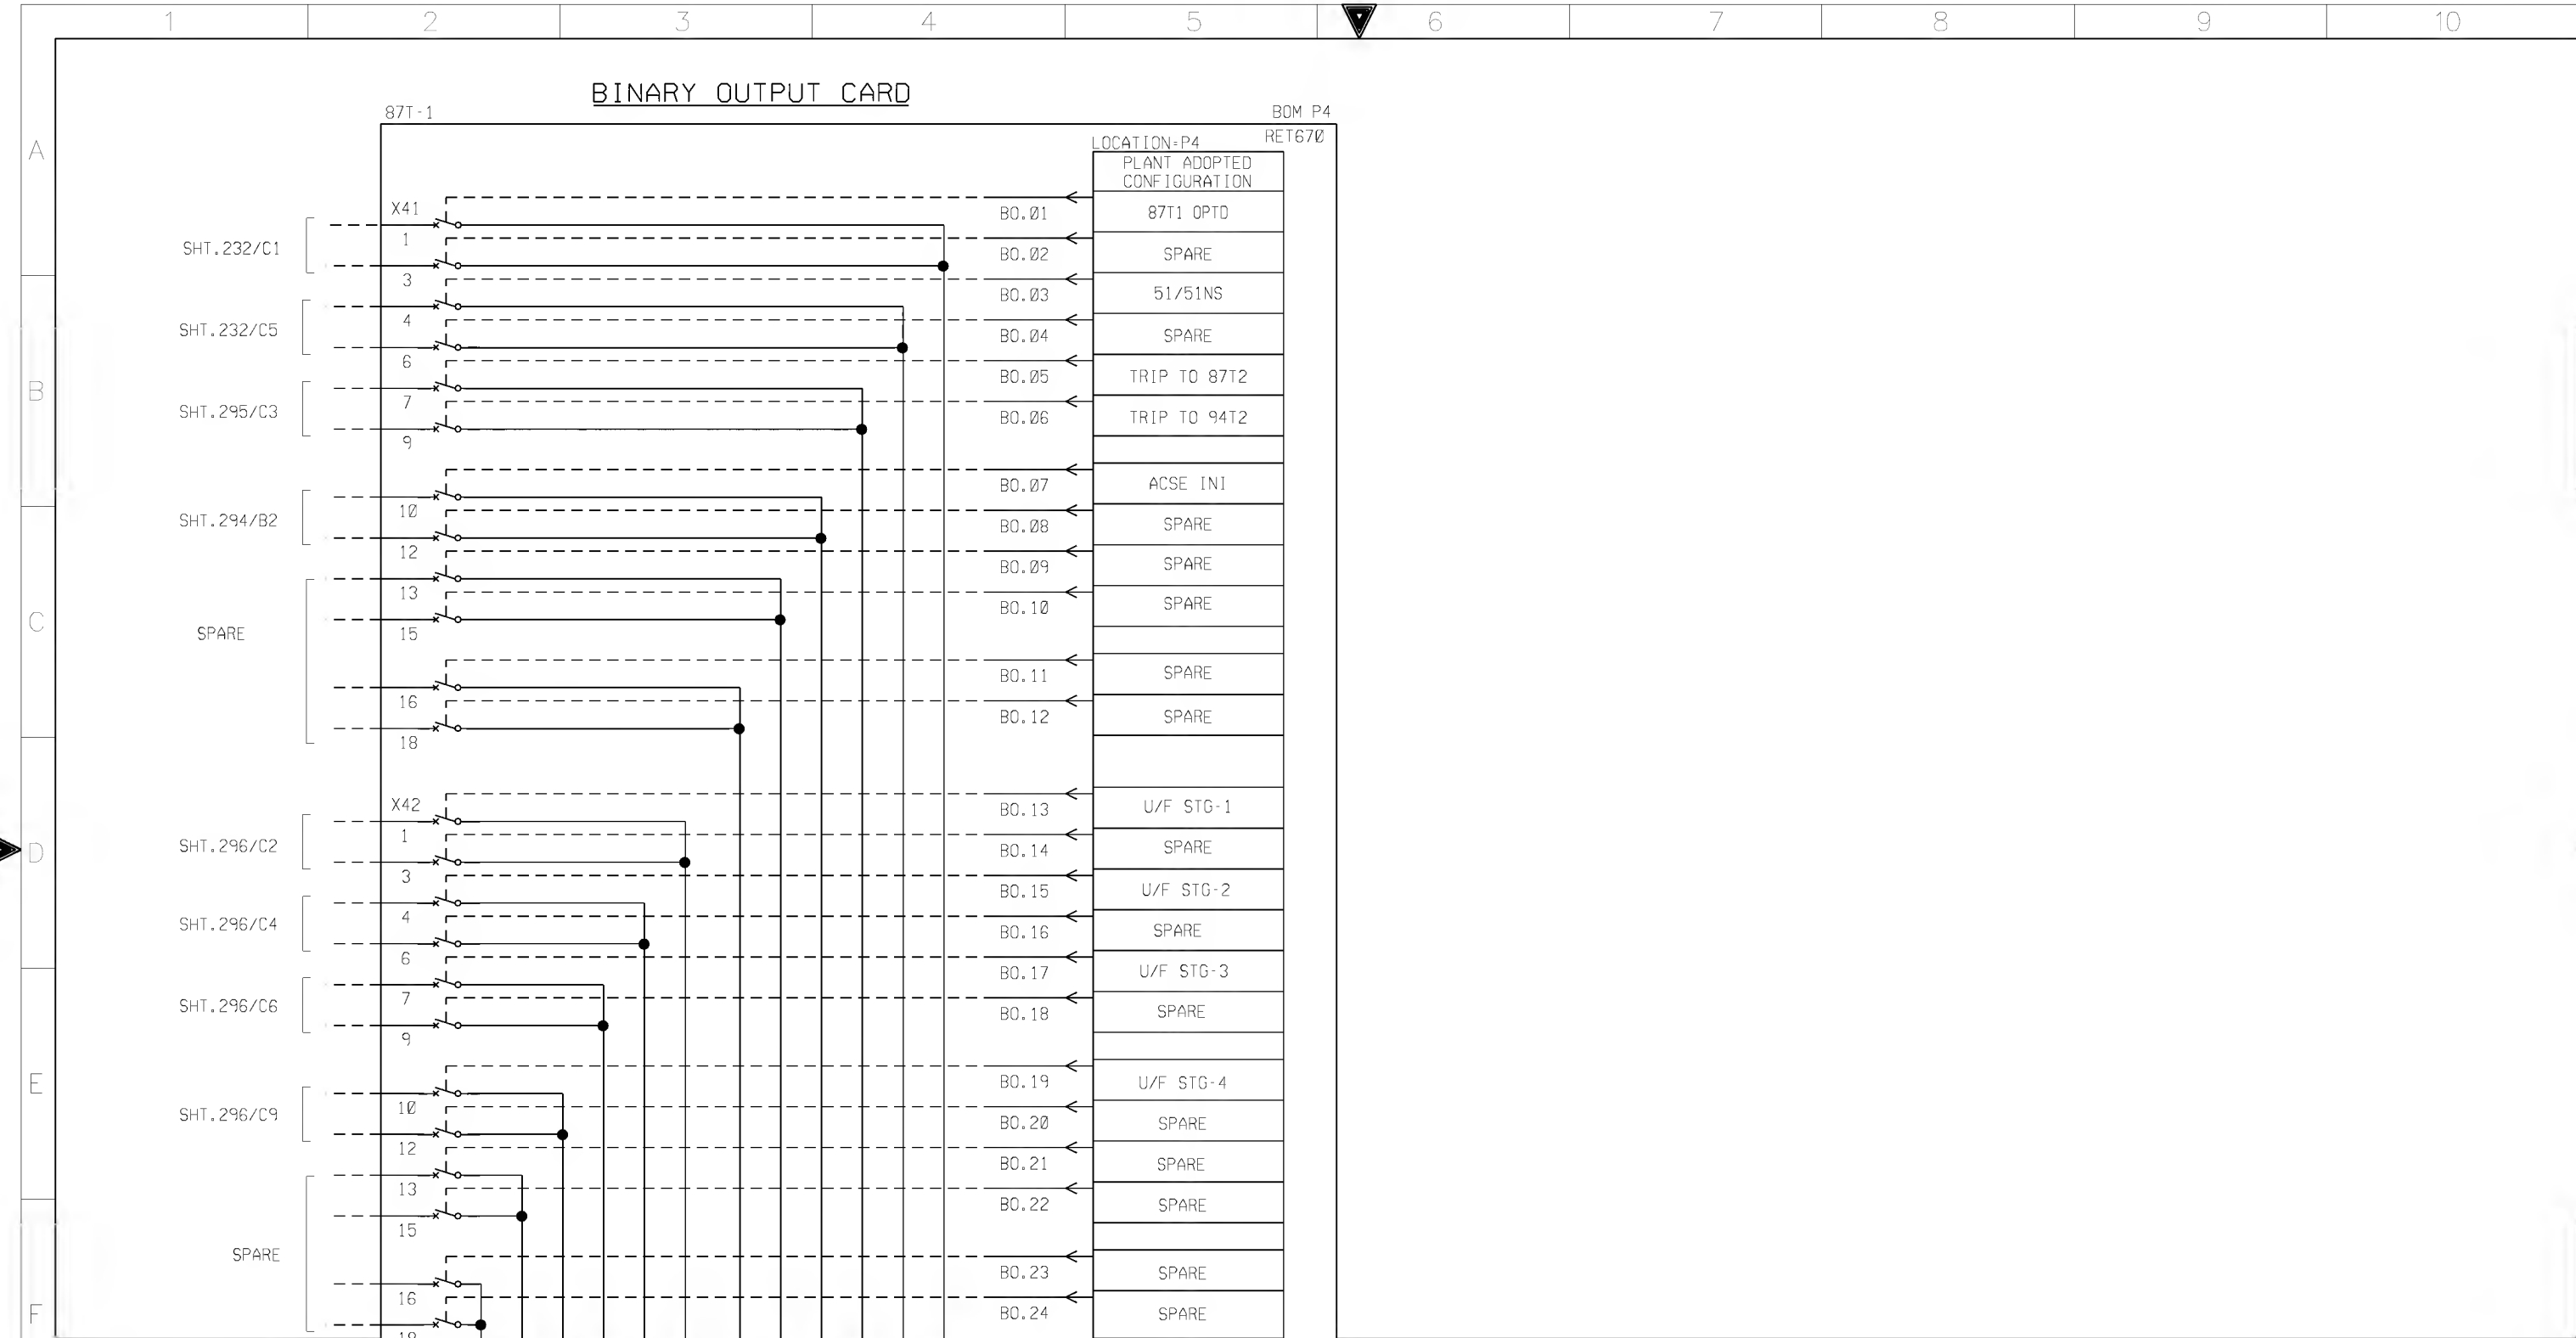

AS-BUILT BY _____ DATE _____		CONTRACT NO. 11131113/00		JOB ORDER NO. S-13656	
01		FACTORY ASBUILT		DRAWN BY RIZ CHECKED BY JKR	
00	13 04	FOR APPROVAL		DATE STARTED 24.01.2013 DATE COMPLETED _____	
REV. NO.	DATE	DESCRIPTION		OPRG. DEPT. CTPC ENG. DEPT. AUT-PSAC	

BLOCK REFERENCE	
132/13.8kV GT-3 RELAY PANEL-1 +R04.1	
S/S 8709-132/13.8KV IN AL-KHARJ CITY	
RIYADH	SAUDI ARABIA

الشركة الوطنية لنقل الكهرباء National Grid sa				
INDEX	PLANT NO.	DRAWING NUMBER	SHEET NO.	REV. NO.
-	C421	CD322934	SHT CONT.	01
			303	304

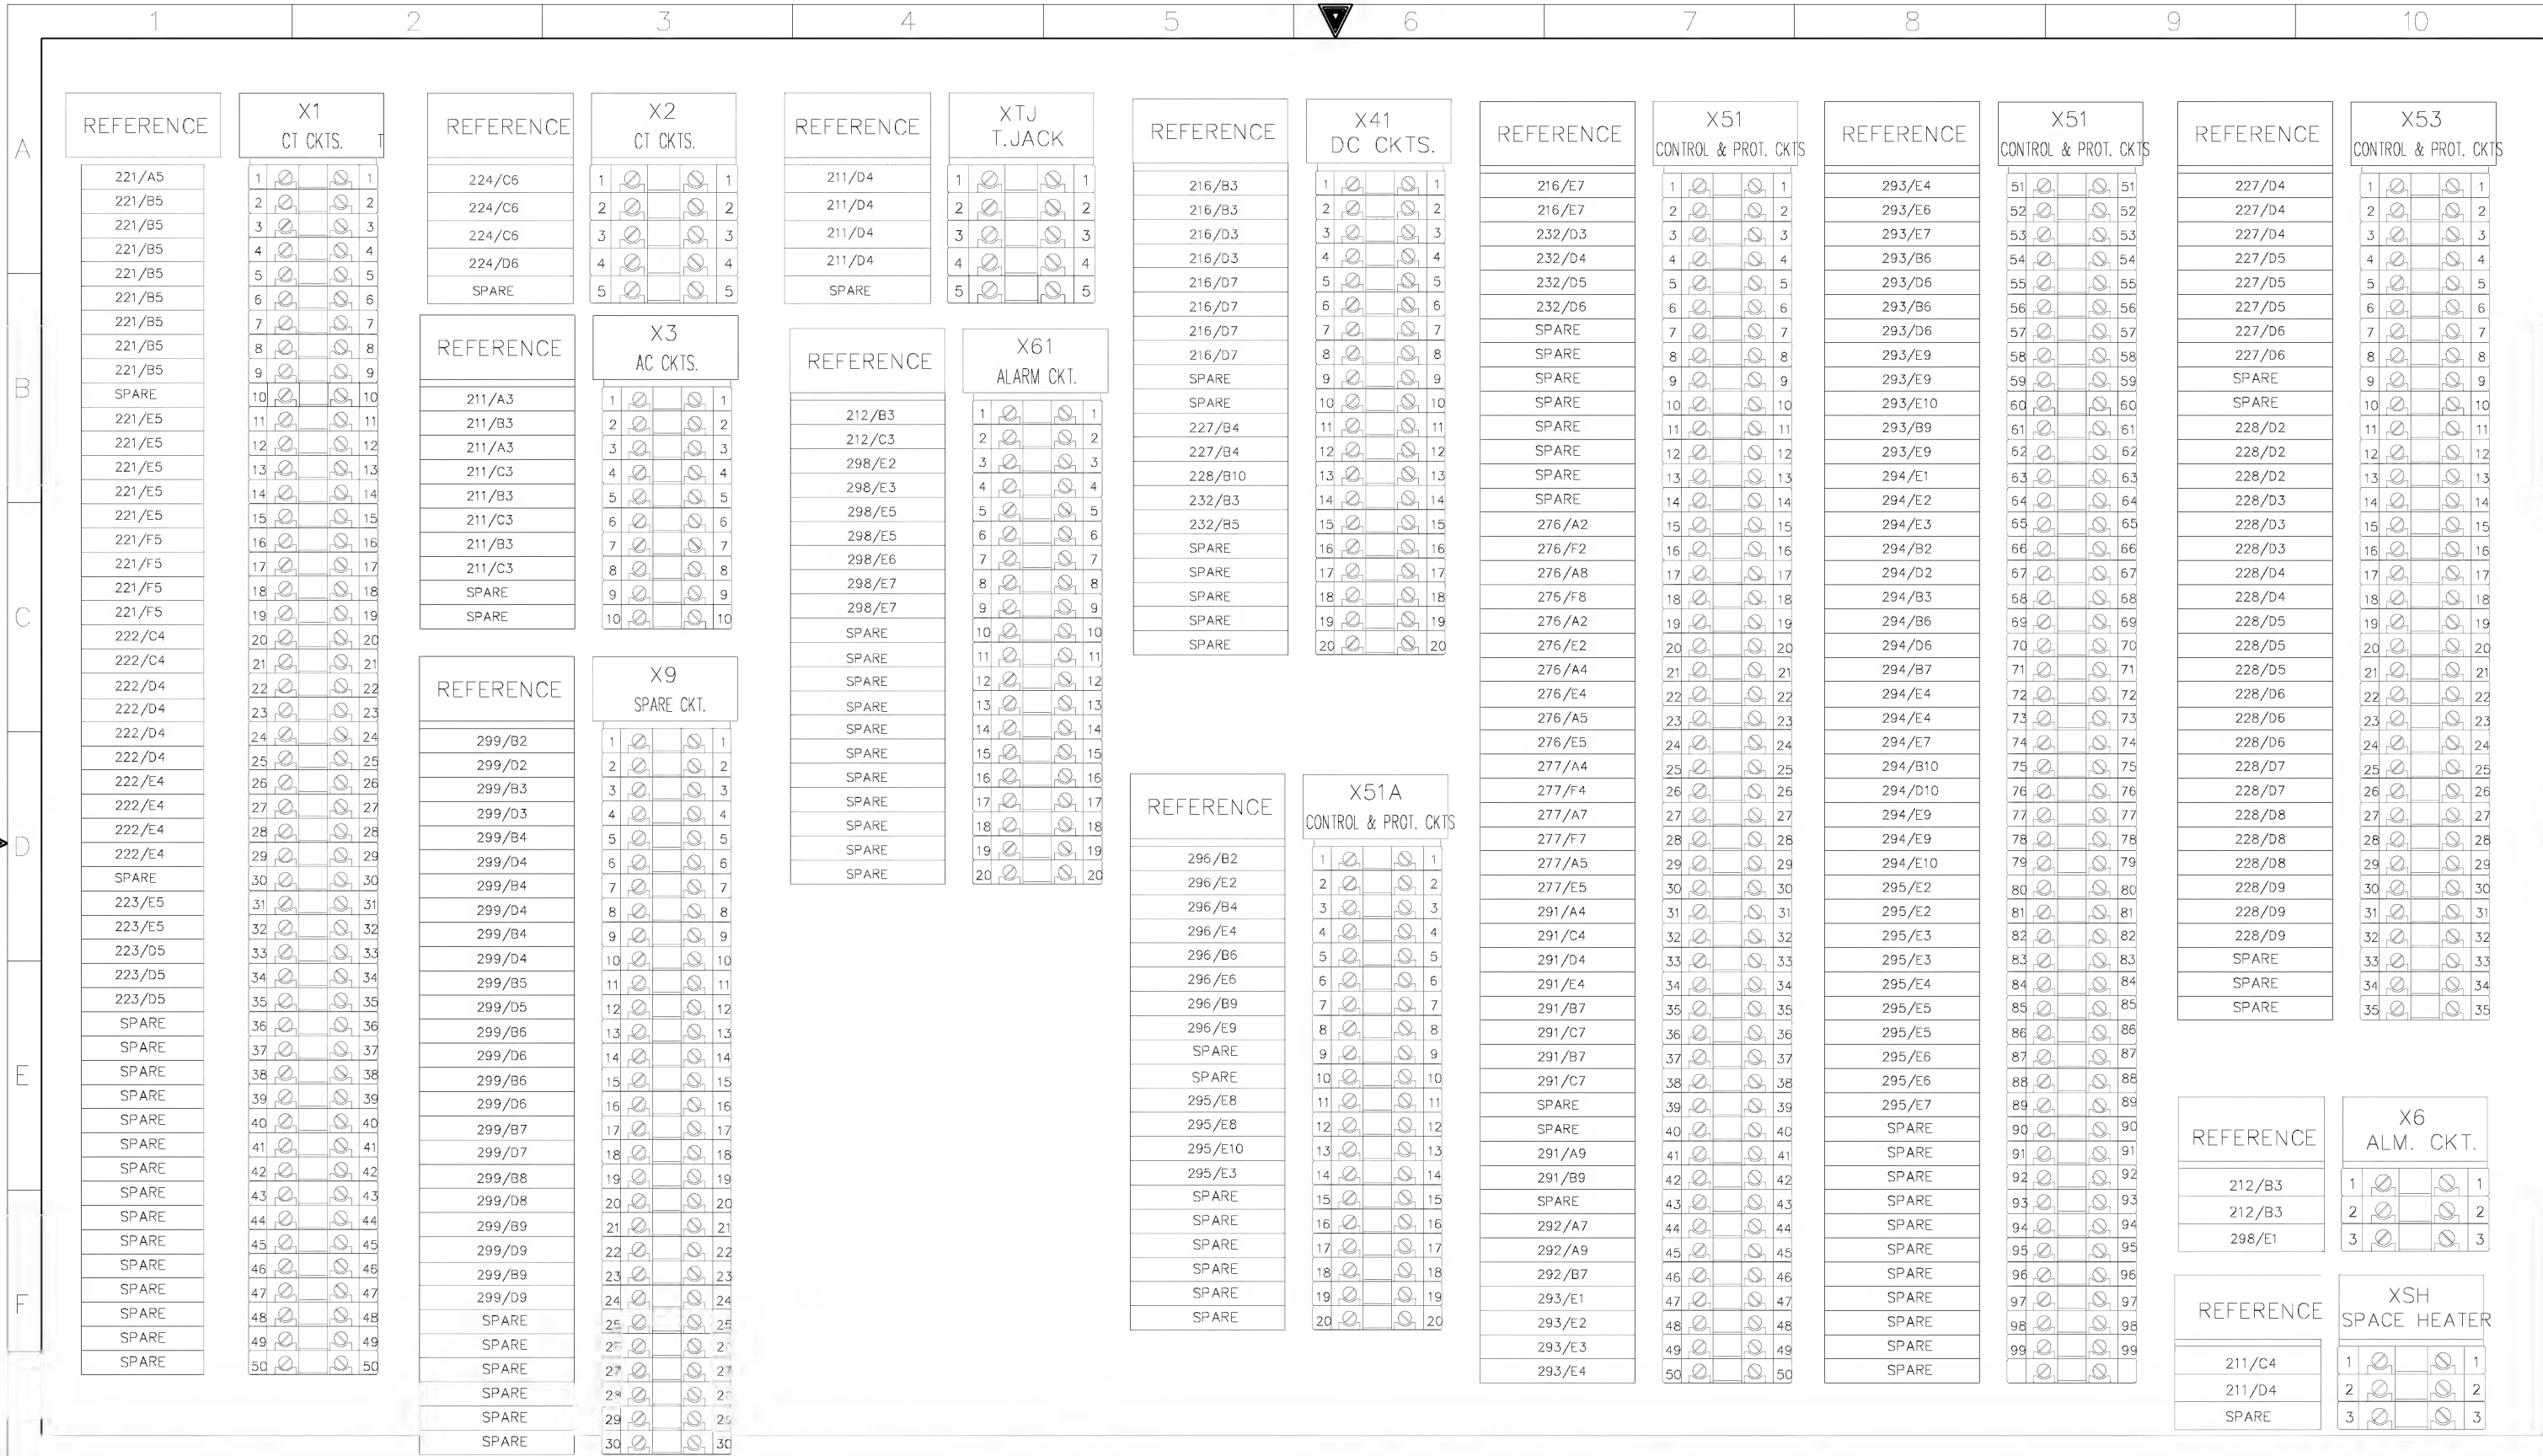




AS-BUILT BY _____ DATE _____ CONTRACT NO. 11131113/00 JOB ORDER NO. S-13656

01	13 49	FACTORY ASBUILT	DRAWN BY RIZ	CHECKED BY JKR
00	13 04	FOR APPROVAL	DATE STARTED 24.01.2013	DATE COMPLETED _____
REV. NO.	DATE	DESCRIPTION	OPRG. DEPT. CTPD	ENG. DEPT. AUT-PSAC

TERMINAL BLOCK REFERENCE
132/13.8kV GT-3 RELAY PANEL-1 +R04.1
S/S 8709-132/13.8KV IN AL-KHARJ CITY
RIYADH SAUDI ARABIA

الشركة الوطنية لنقل الكهرباء
National Grid sa

INDEX PLANT NO. DRAWING NUMBER SHEET NO. REV. NO.
- C421 CD322934 304 411 01

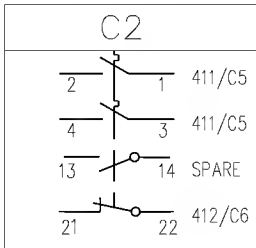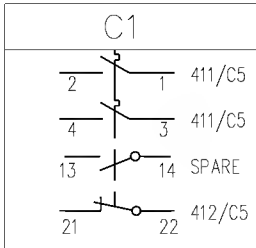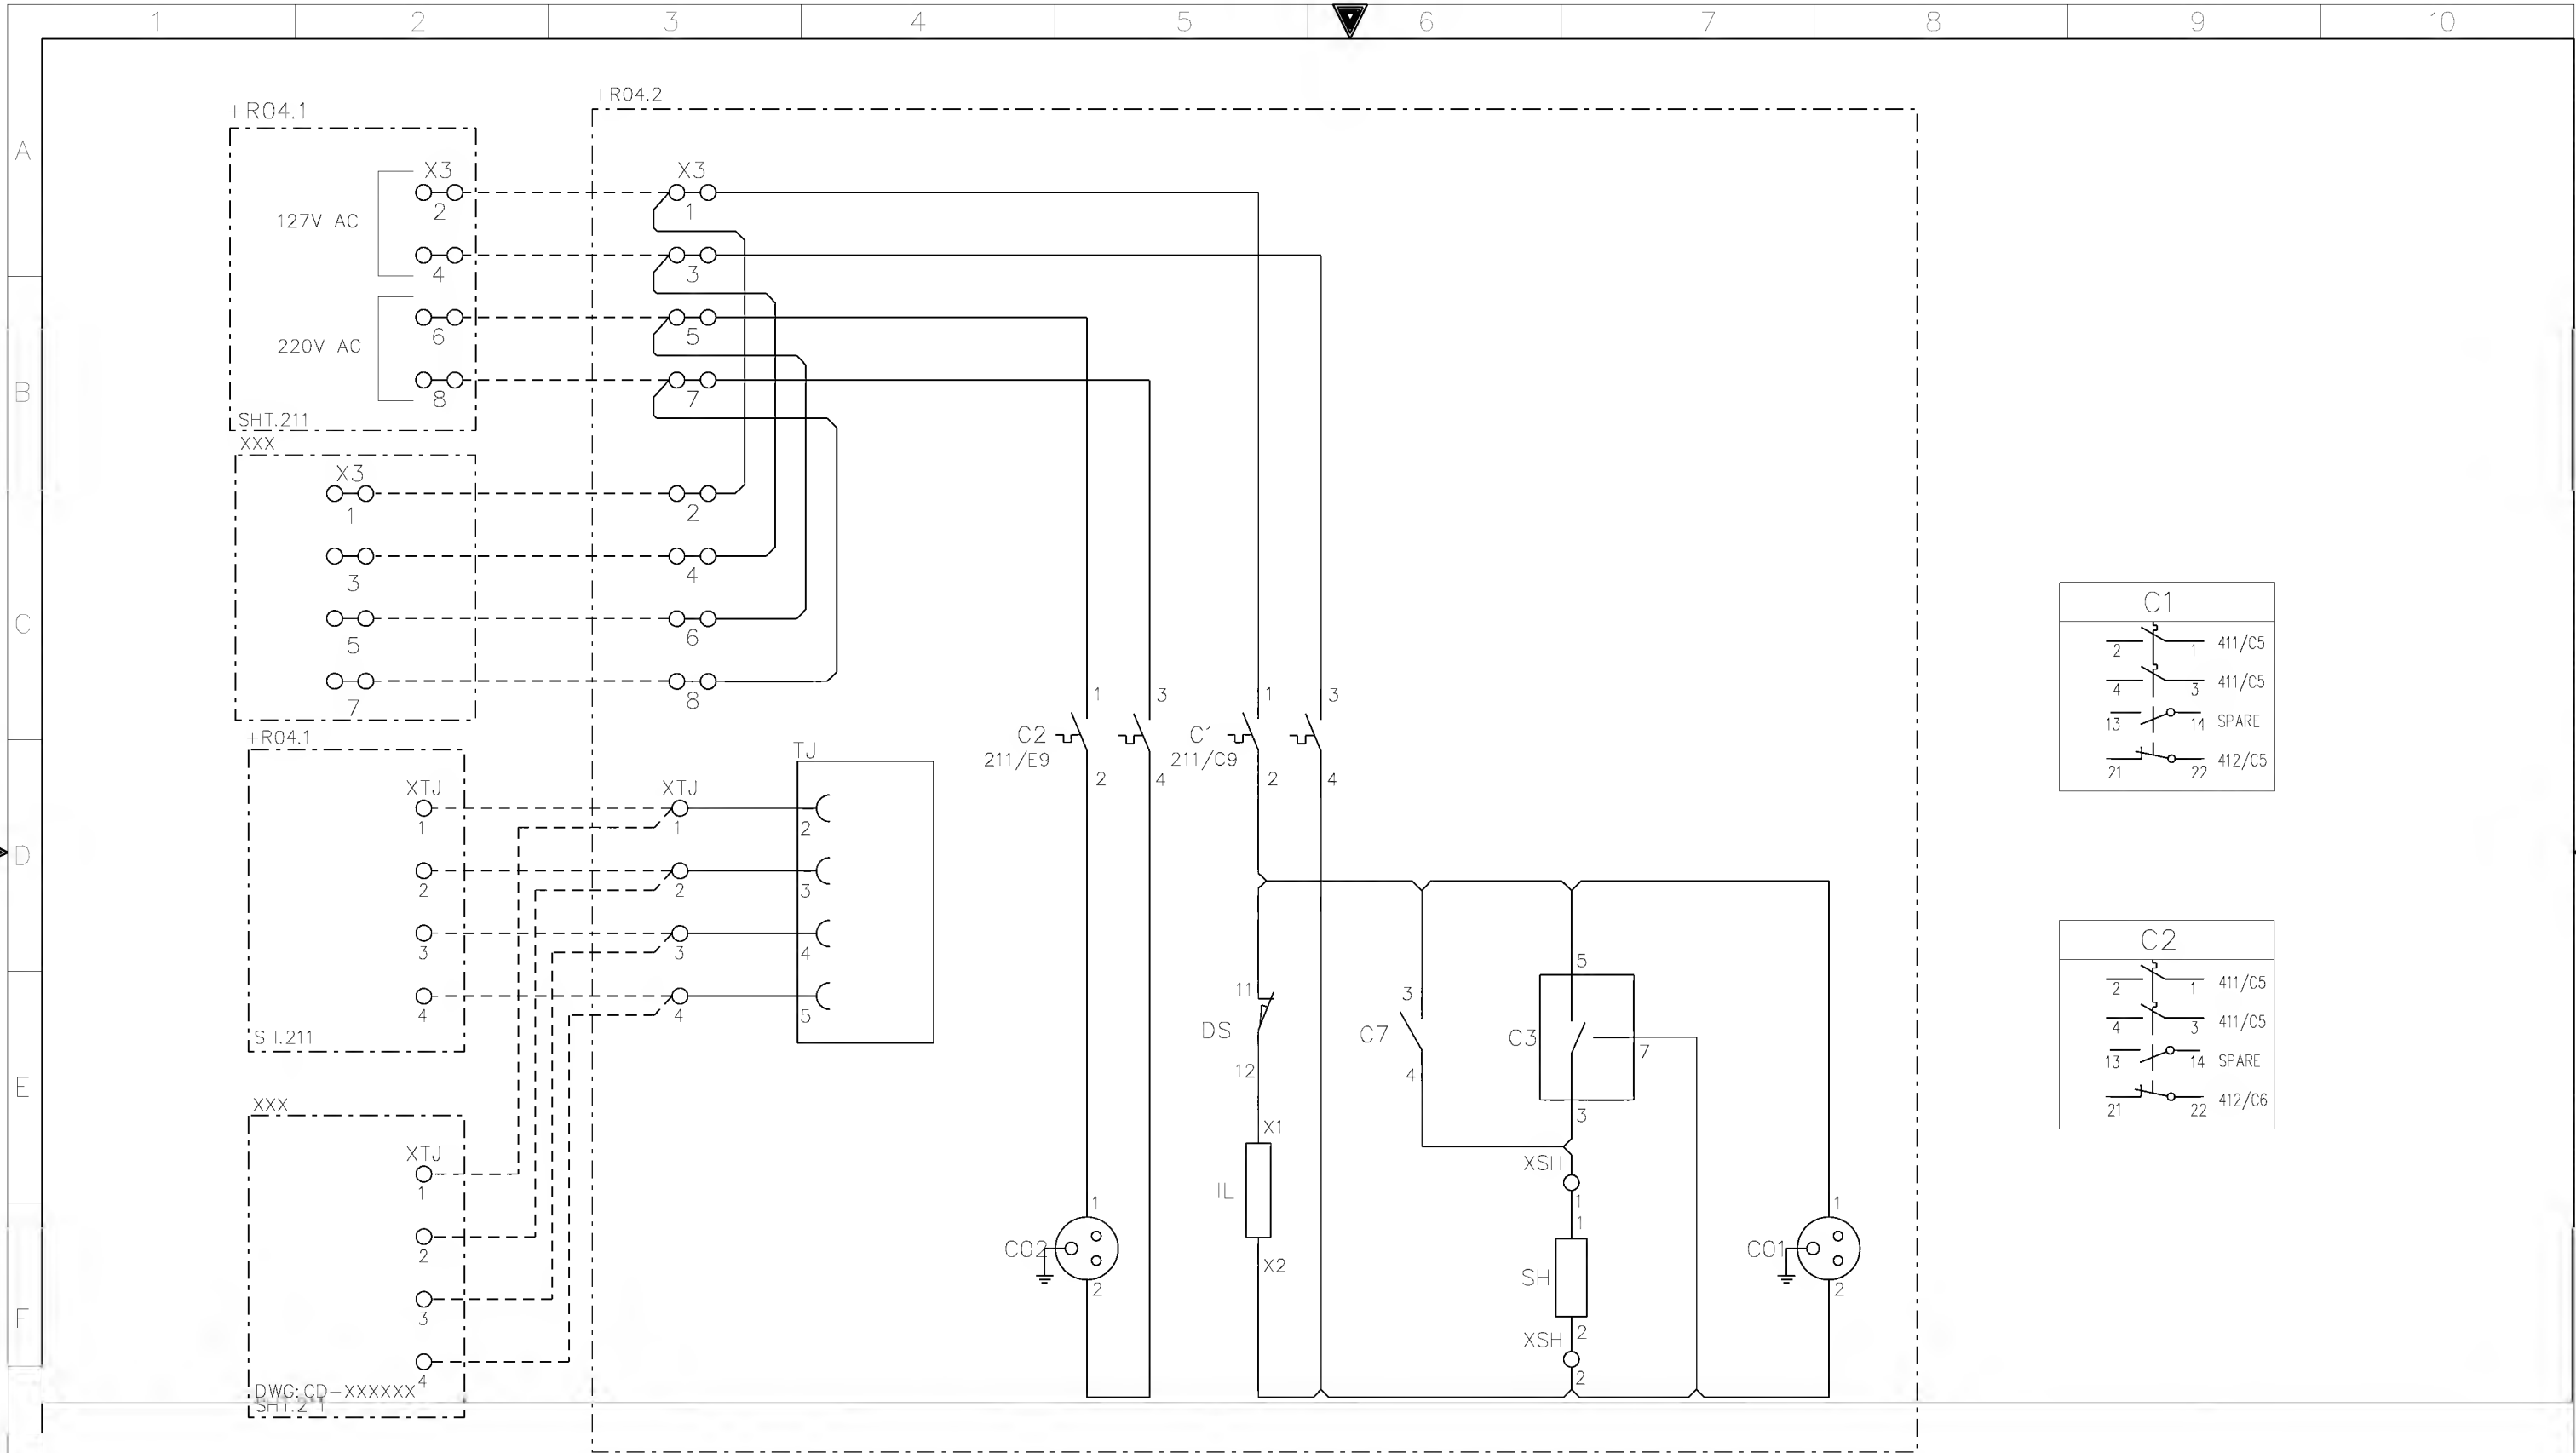


AS-BUILT BY _____ DATE _____			CONTRACT NO. 11131113/00		JOB ORDER NO. S-13656	
01	13 49	FACTORY ASBUILT	DRAWN BY RIZ		CHECKED BY JKR	
00	13 04	FOR APPROVAL	DATE STARTED 24.01.2013		DATE COMPLETED _____	
REV. NO.	DATE	DESCRIPTION	OPRG. DEPT. CTPD		ENG. DEPT. AUT-PSAC	

AC SUPPLY FOR ILLUMINATION & POWER SOCKET
132/13.8kv GT-3 RELAY PANEL-2 +R04.2
S/S 8709-132/13.8KV IN AL-KHARJ CITY
RIYADH SAUDI ARABIA

الشركة الوطنية لنقل الكهرباء
National Grid sa

INDEX	PLANT NO.	DRAWING NUMBER	SHEET NO.		REV. NO.
-	C421	CD322934	SHT	CONT.	01
			411	412	

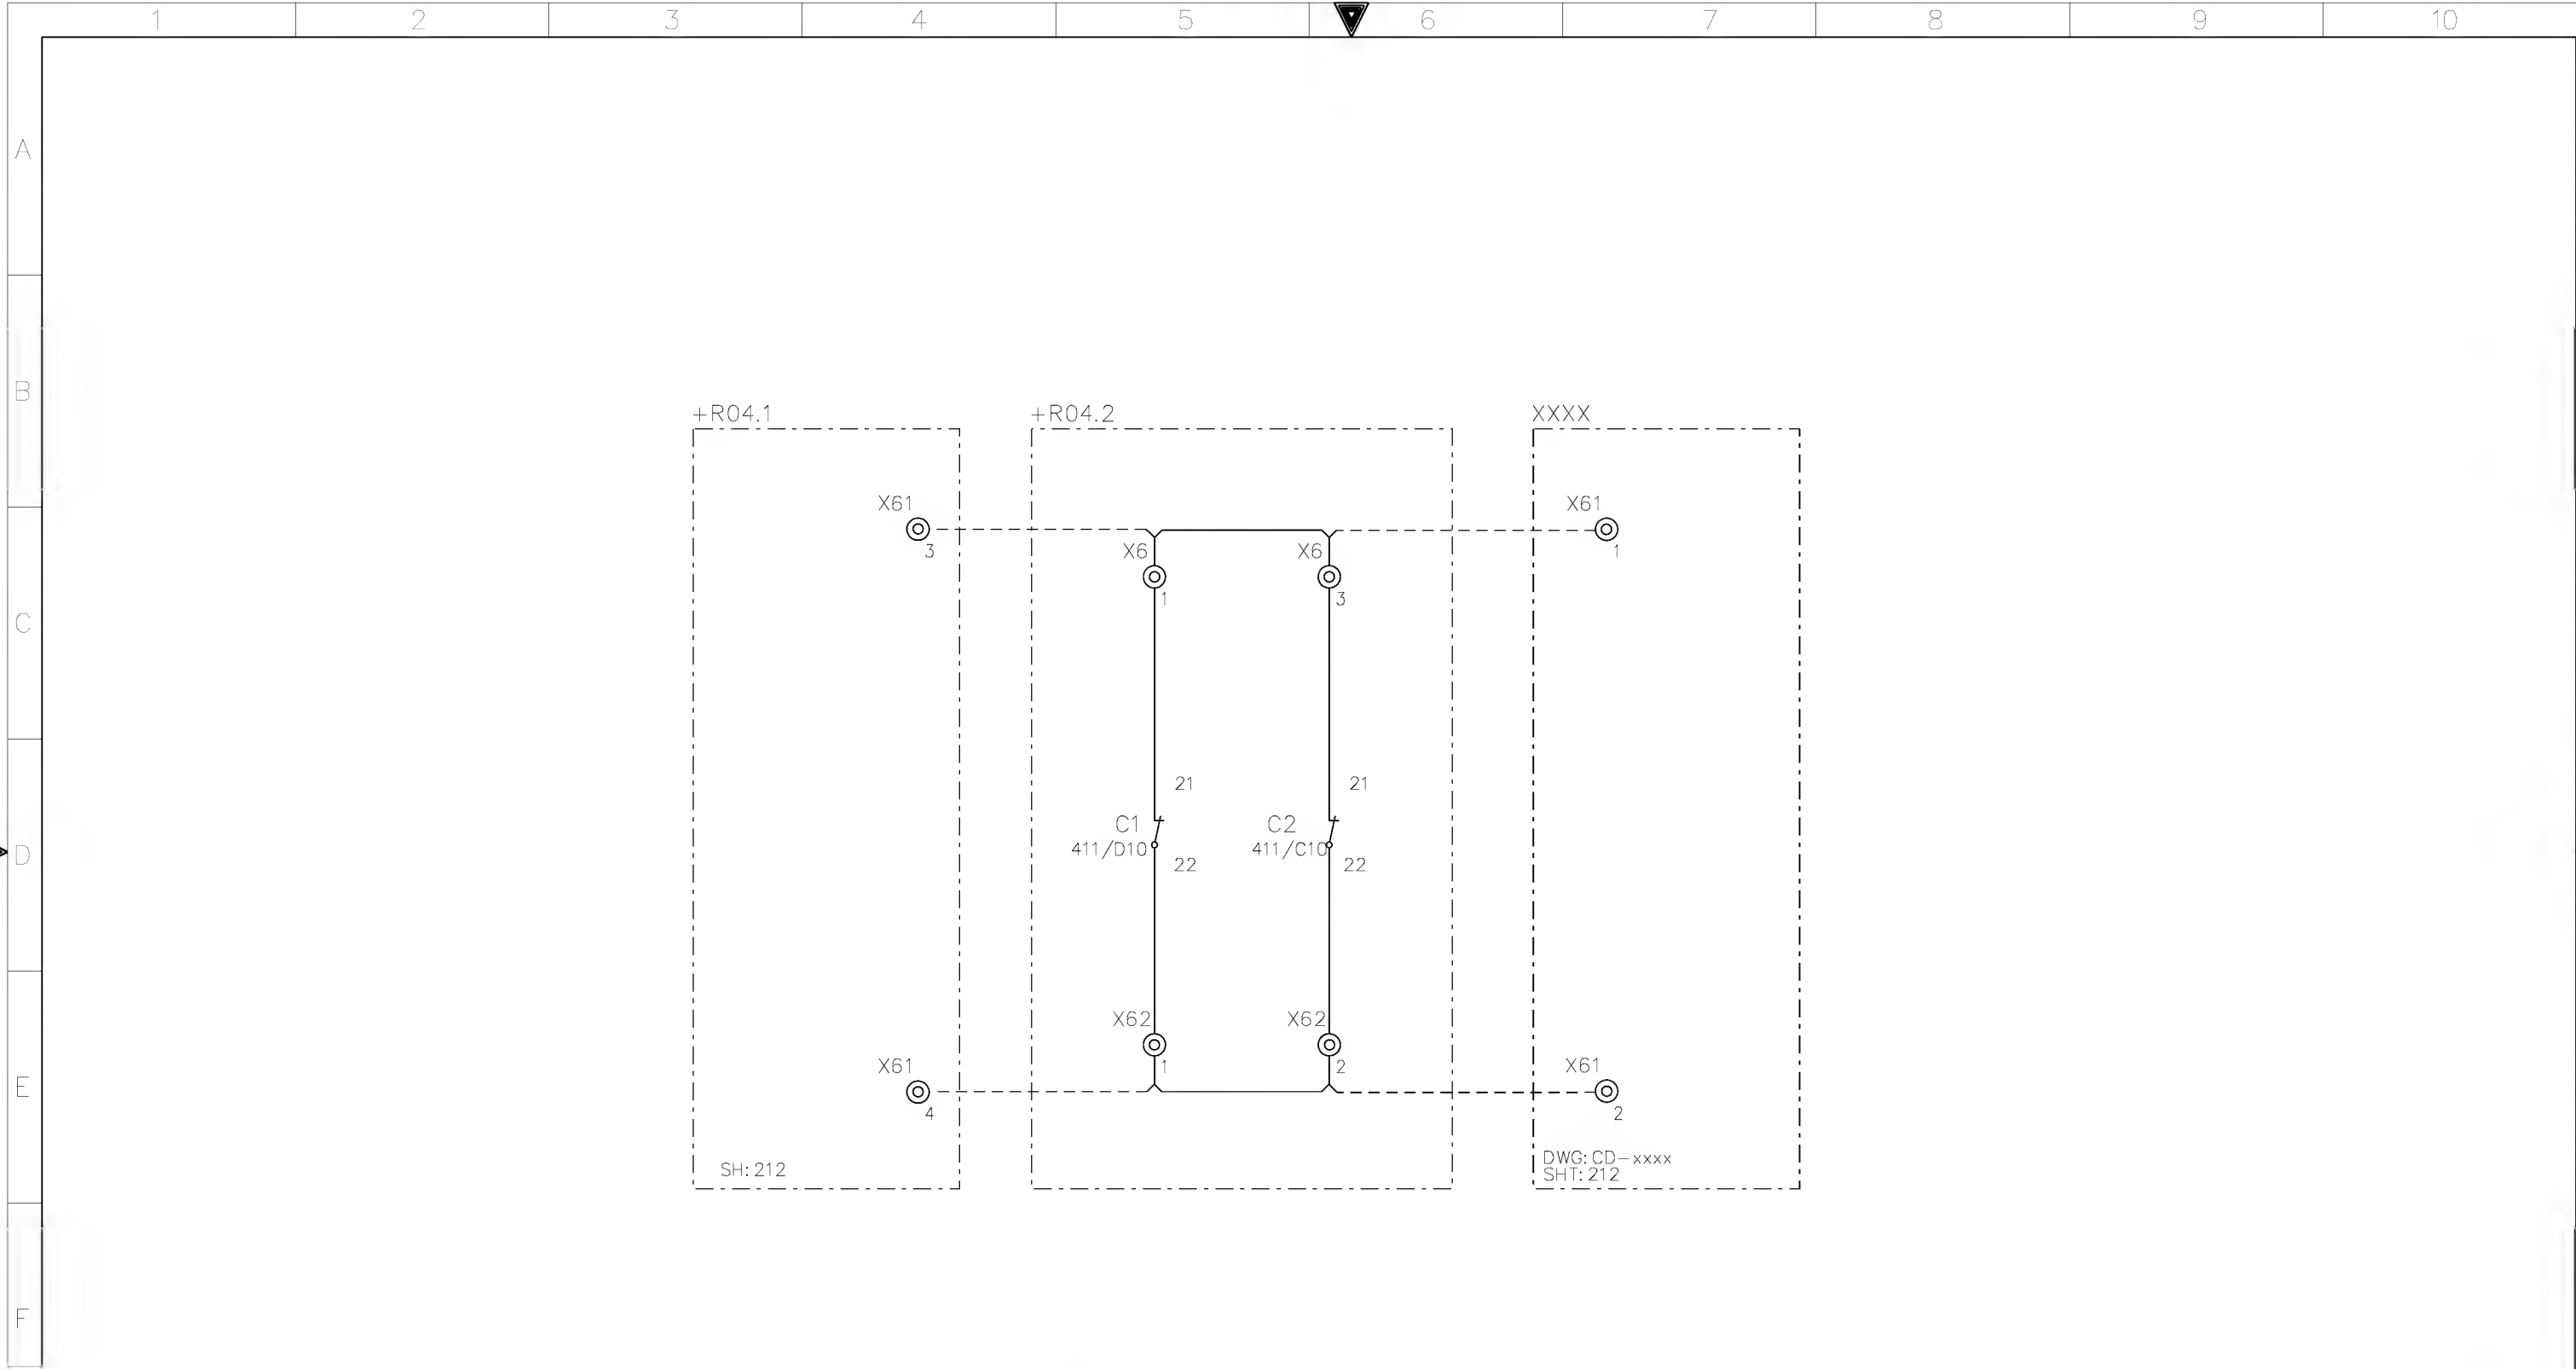





AS-BUILT BY _____ DATE _____ CONTRACT NO. 11131113/00 JOB ORDER NO. S-13656

01	13 49	FACTORY ASBUILT	DRAWN BY RIZ	CHECKED BY JKR
00	13 04	FOR APPROVAL	DATE STARTED 24.01.2013	DATE COMPLETED
REV. NO.	DATE	DESCRIPTION	OPRG. DEPT. CTPD	ENG. DEPT. AUT-PSAC


CUB.LIGHTING,HEATER&SOKET ALARM CKT.
132/13.8kv GT-3 RELAY PANEL-2 +R04.2
S/S 8709-132/13.8KV IN AL-KHARJ CITY
RIYADH SAUDI ARABIA

الشركة الوطنية لنقل الكهرباء
National Grid sa

INDEX	PLANT NO.	DRAWING NUMBER	SHEET NO.	REV. NO.
-	C421	CD322934	SHT 412	CONT. 416
				01

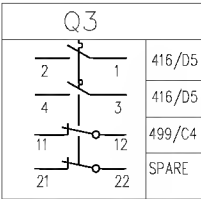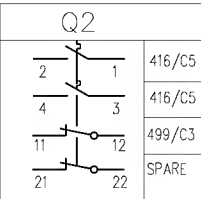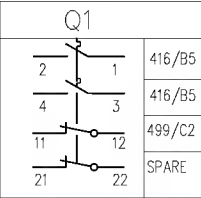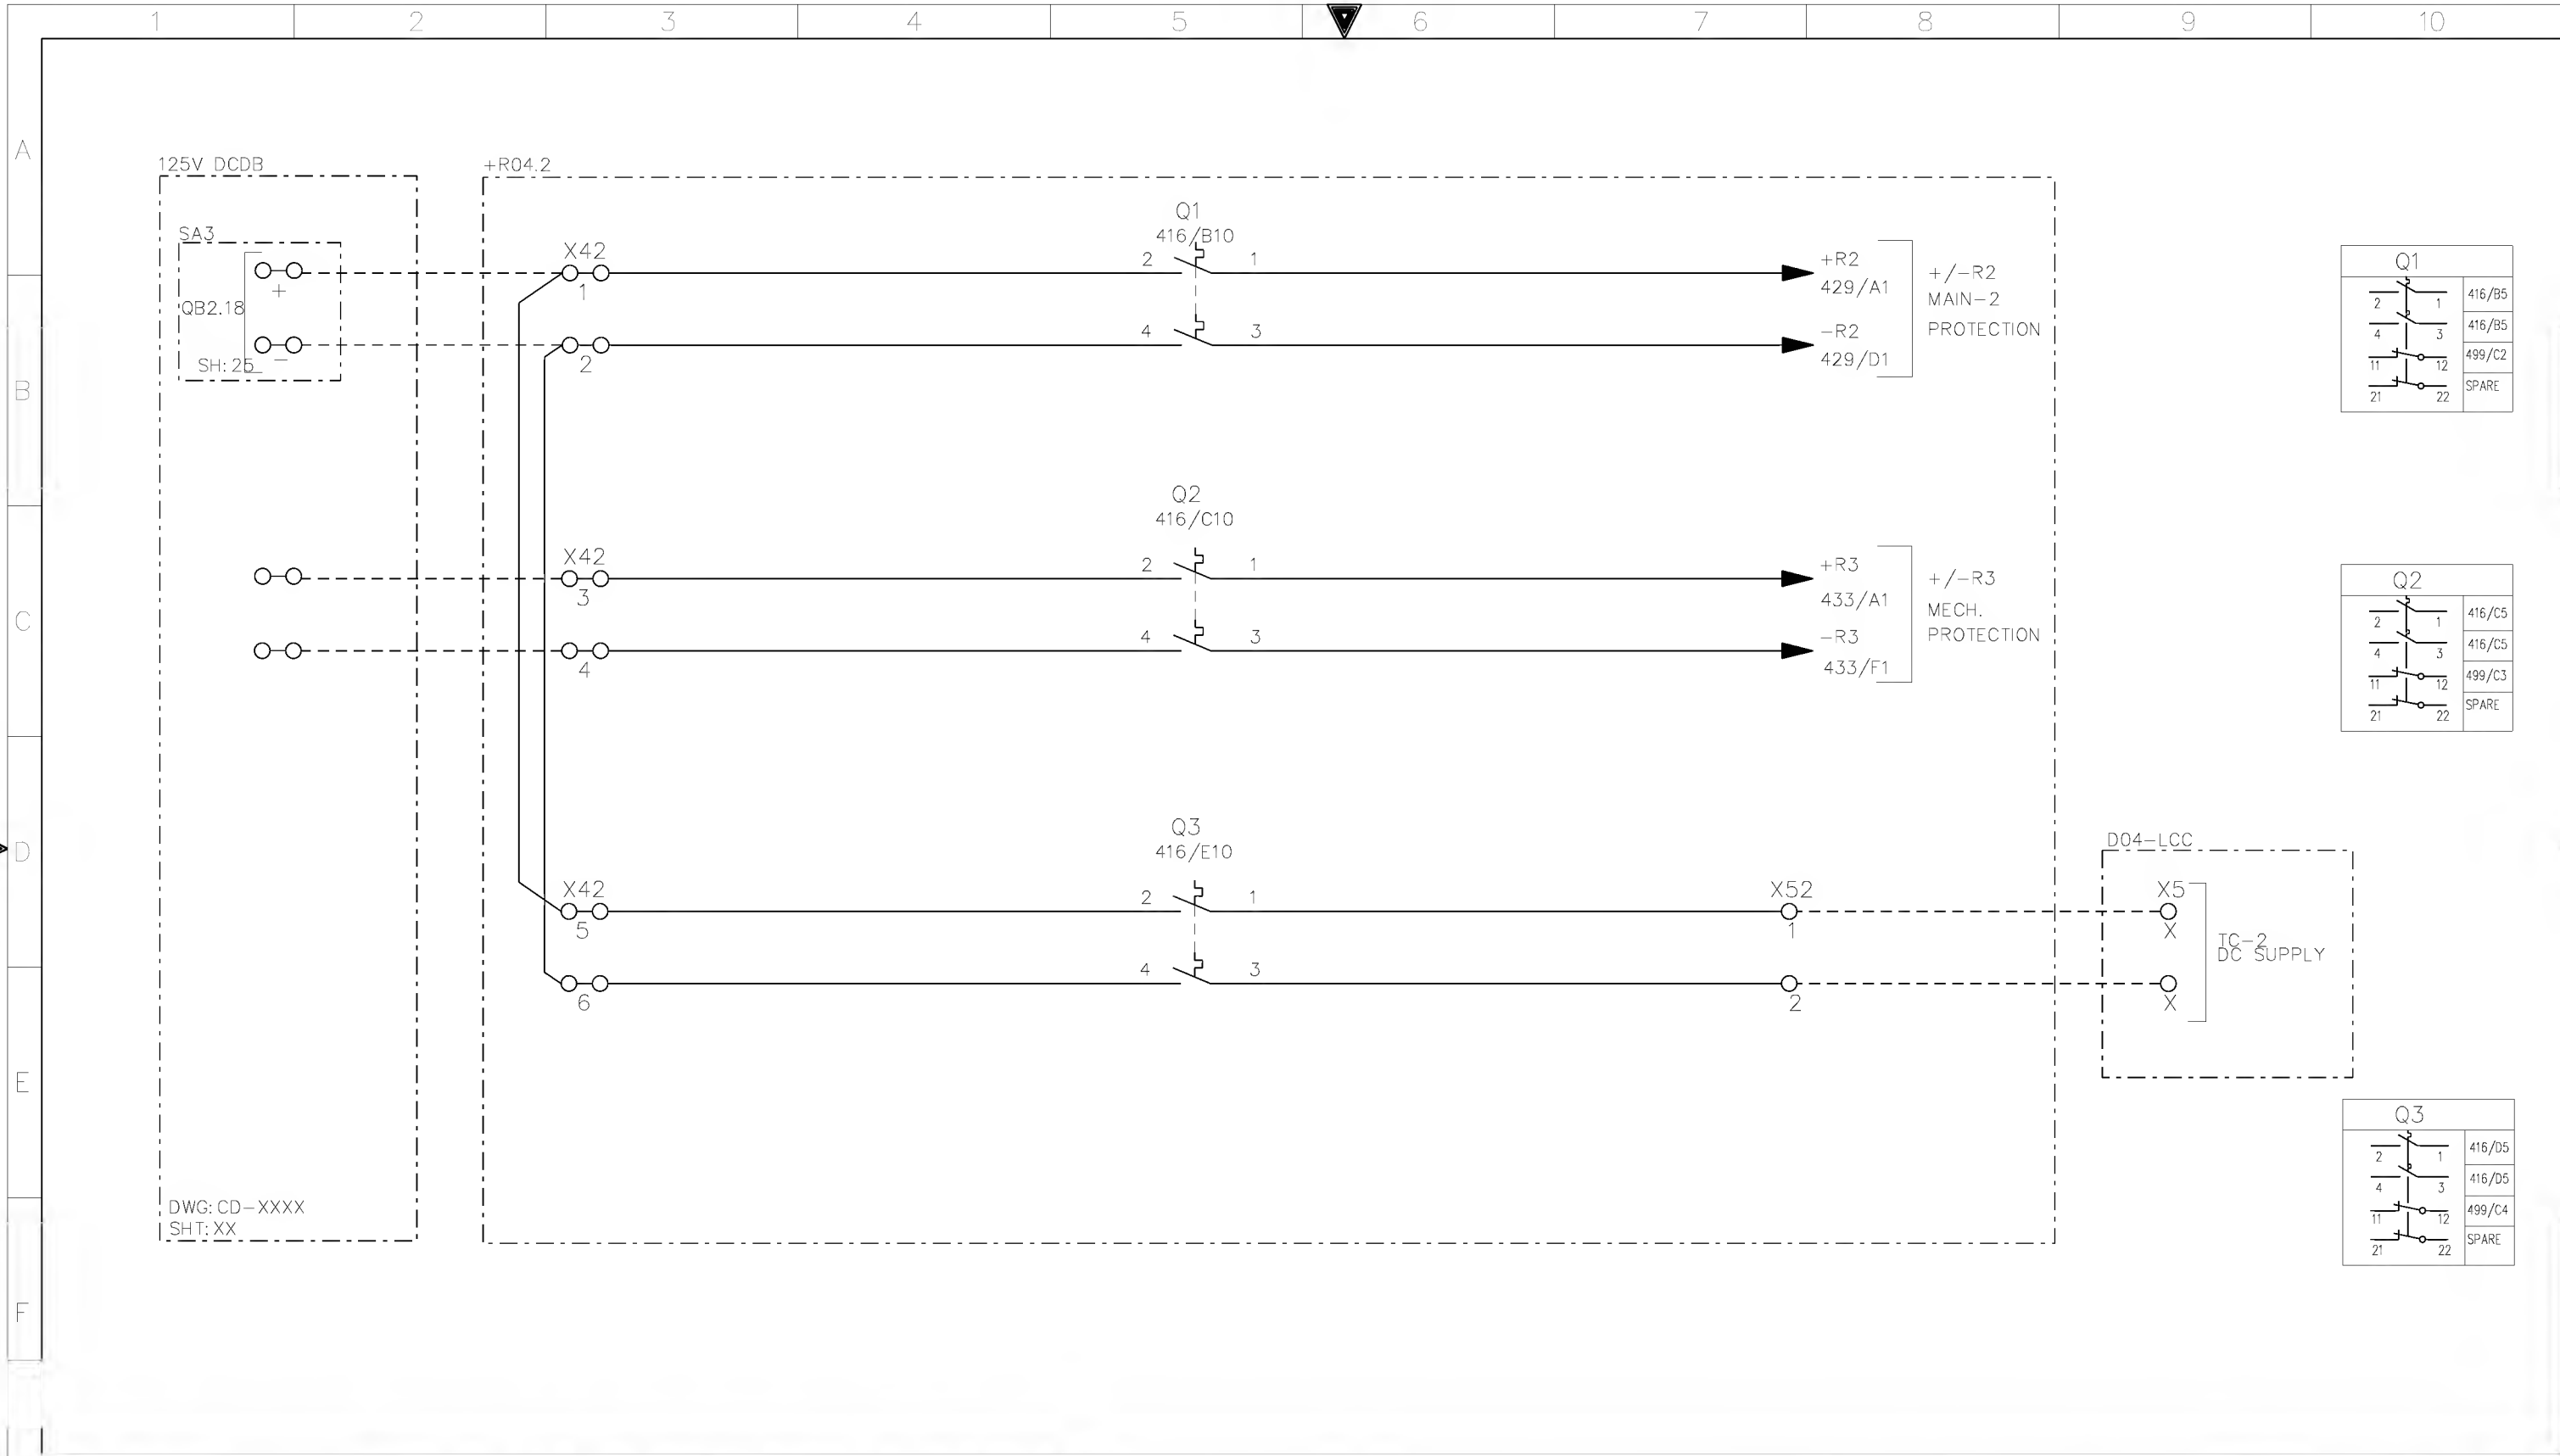


G	AS-BUILT BY _____ DATE _____		CONTRACT NO. 11131113/00		JOB ORDER NO. S-13656		DC SUPPLY DISTRIBUTION		<div>الشركة الوطنية لنقل الكهرباء</div> <div>National Grid sa</div>							
							132/13.8kV GT-3 RELAY PANEL-2 +R04.2									
	01	13 49	FACTORY ASBUILT	DRAWN BY RIZ		CHECKED BY JKR		S/S 8709-132/13.8KV IN AL-KHARJ CITY								
	00	13 04	FOR APPROVAL	DATE STARTED 24.01.2013		DATE COMPLETED _____		SAUDI ARABIA								
	REV. NO.	DATE	DESCRIPTION		OPRG. DEPT. CTPD		ENG. DEPT. AUT-PSAC		INDEX	PLANT NO.	DRAWING NUMBER		SHEET NO.		REV. NO.	
									-	C421	CD322934		SHT 416		CONT. 421	
															01	

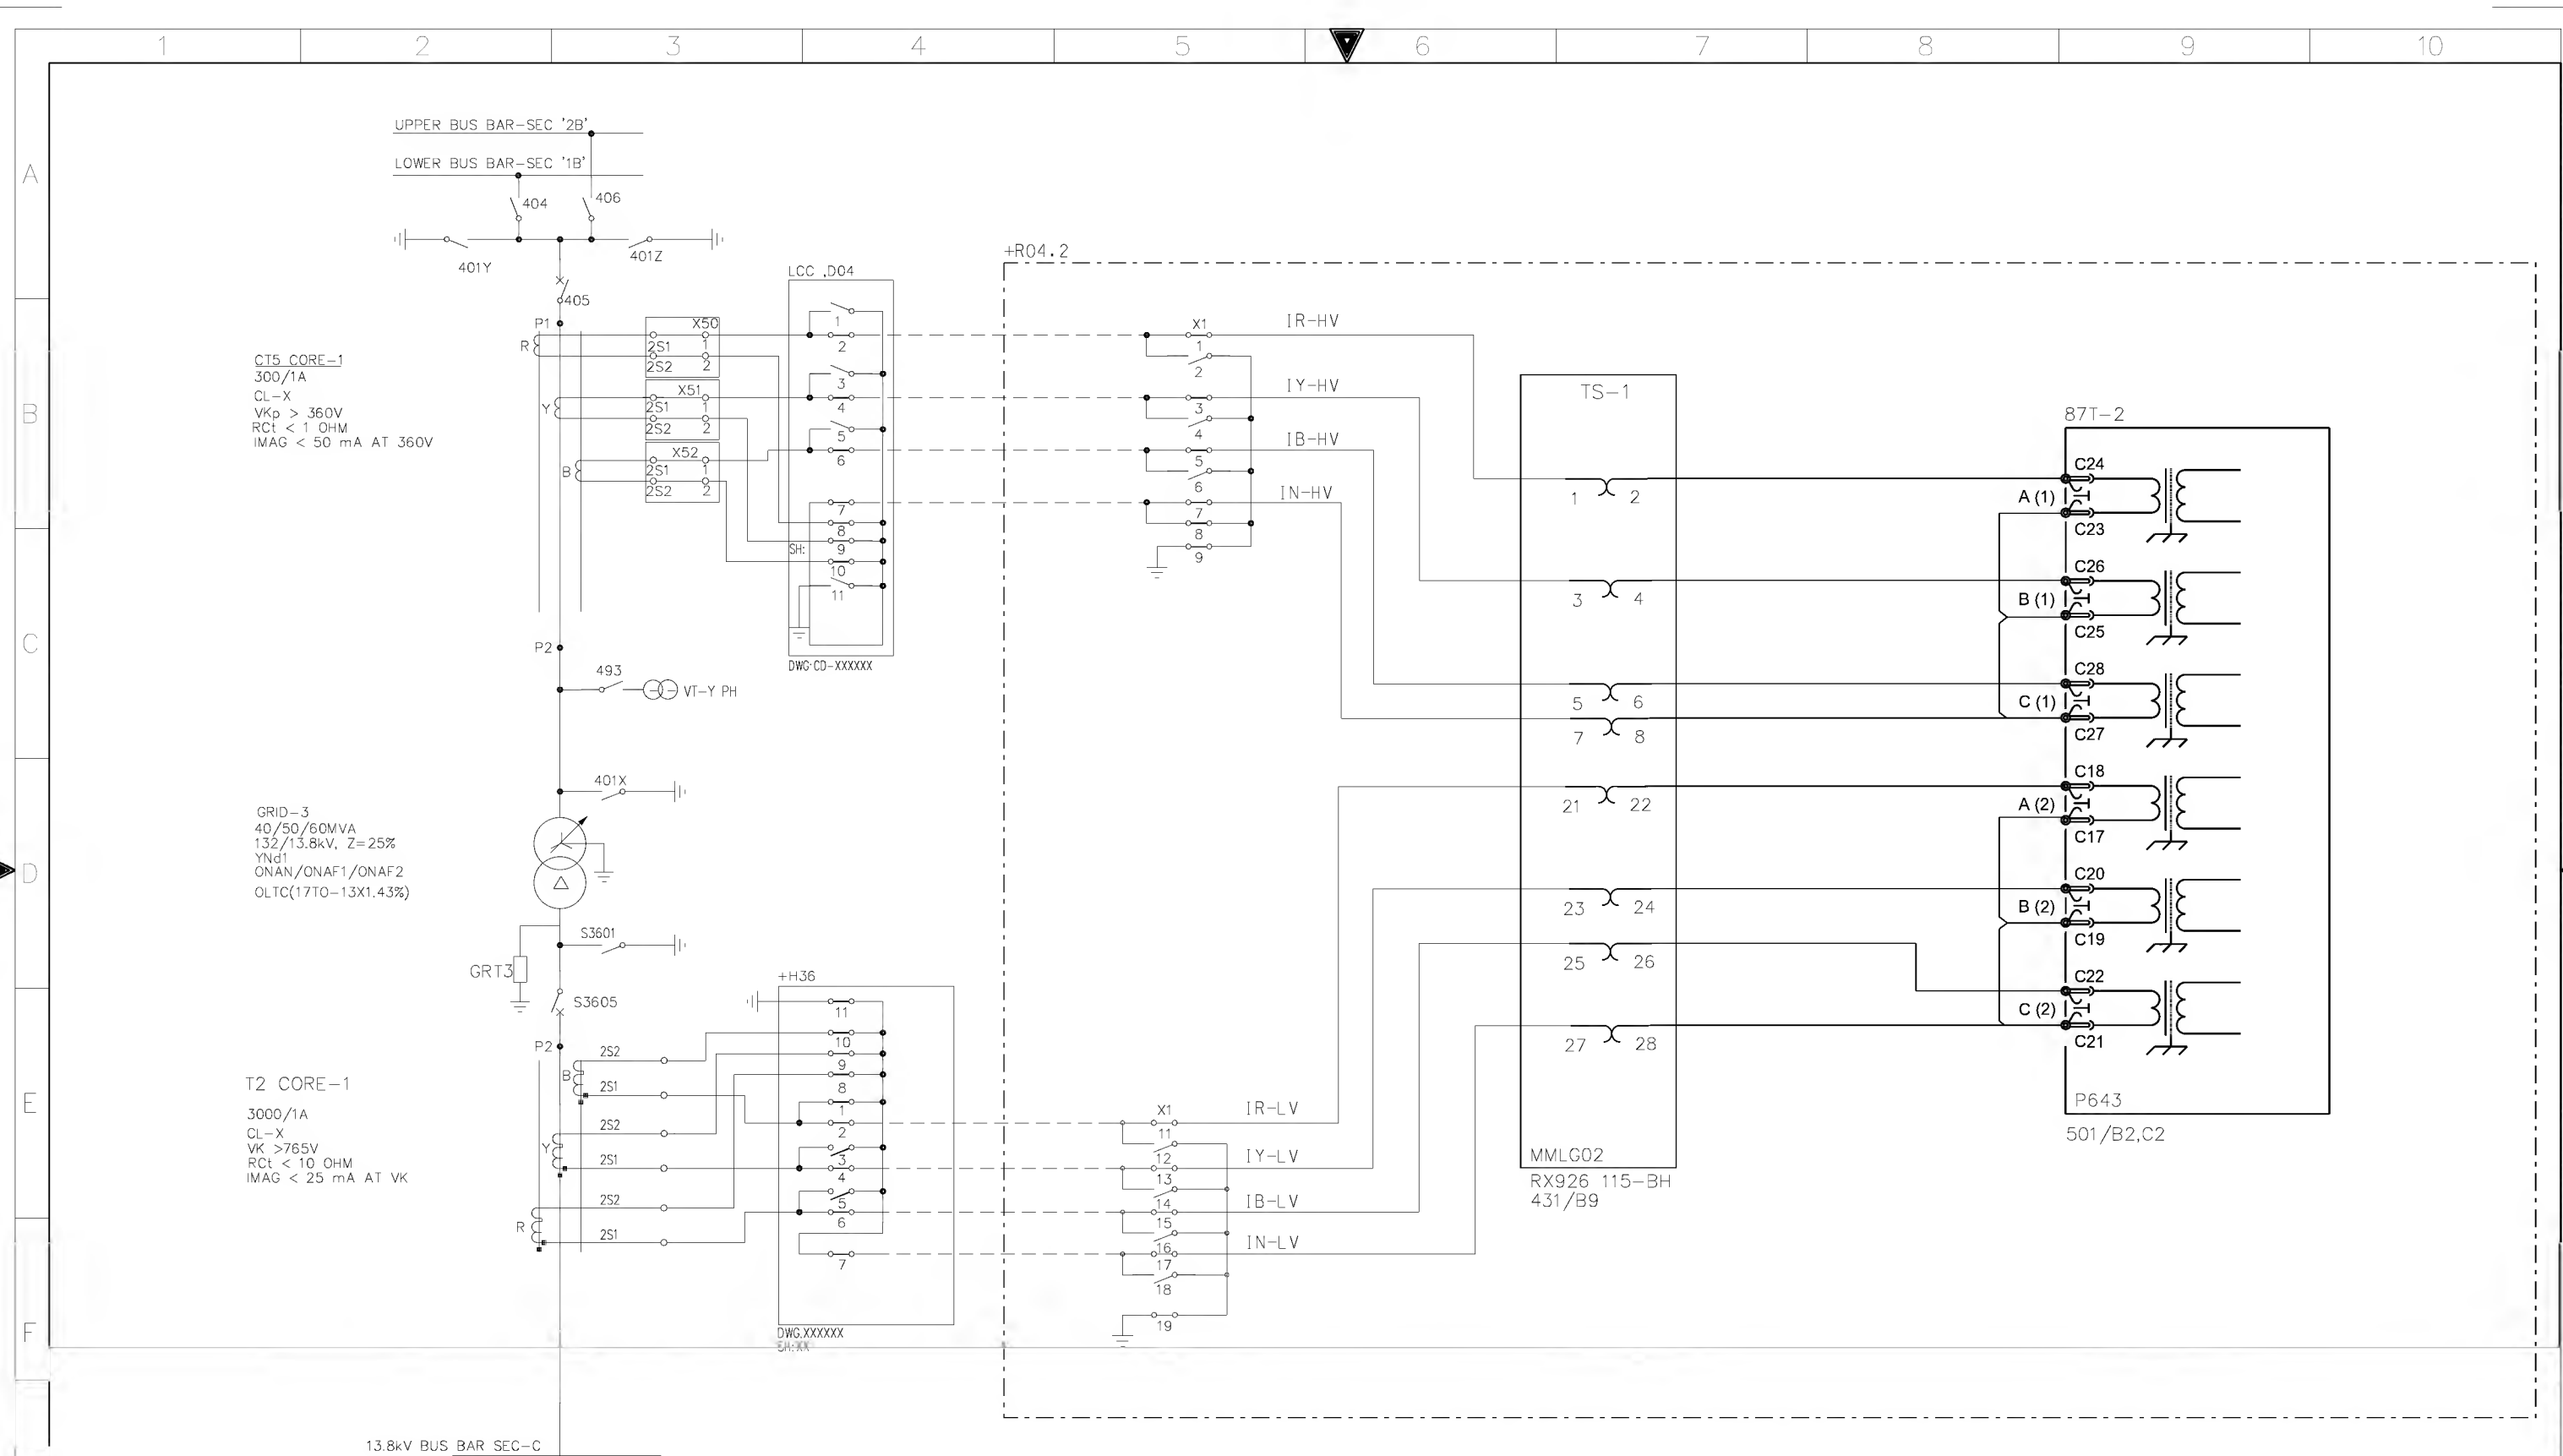

AS-BUILT BY _____ DATE _____			CONTRACT NO. 11131113/00		JOB ORDER NO. S-13656	
01	13 49	FACTORY ASBUILT	DRAWN BY RIZ		CHECKED BY JKR	
00	13 04	FOR APPROVAL	DATE STARTED 24.01.2013		DATE COMPLETED _____	
REV. NO.	DATE	DESCRIPTION	OPRG. DEPT. CTPD		ENG. DEPT. AUT-PSAC	

CT CIRCUITS 87T-2 RELAY	
132/13.8kV GT-3 RELAY PANEL-2 +R04.2	
S/S 8709-132/13.8KV IN AL-KHARJ CITY	
RIYADH	SAUDI ARABIA

الشركة الوطنية لنقل الكهرباء				نقل الكهرباء		
				National Grid SA		
INDEX	PLANT NO.	DRAWING NUMBER		SHEET NO.		REV. NO.
-	C421	CD322934		SHT	CONT.	01
				421	422	

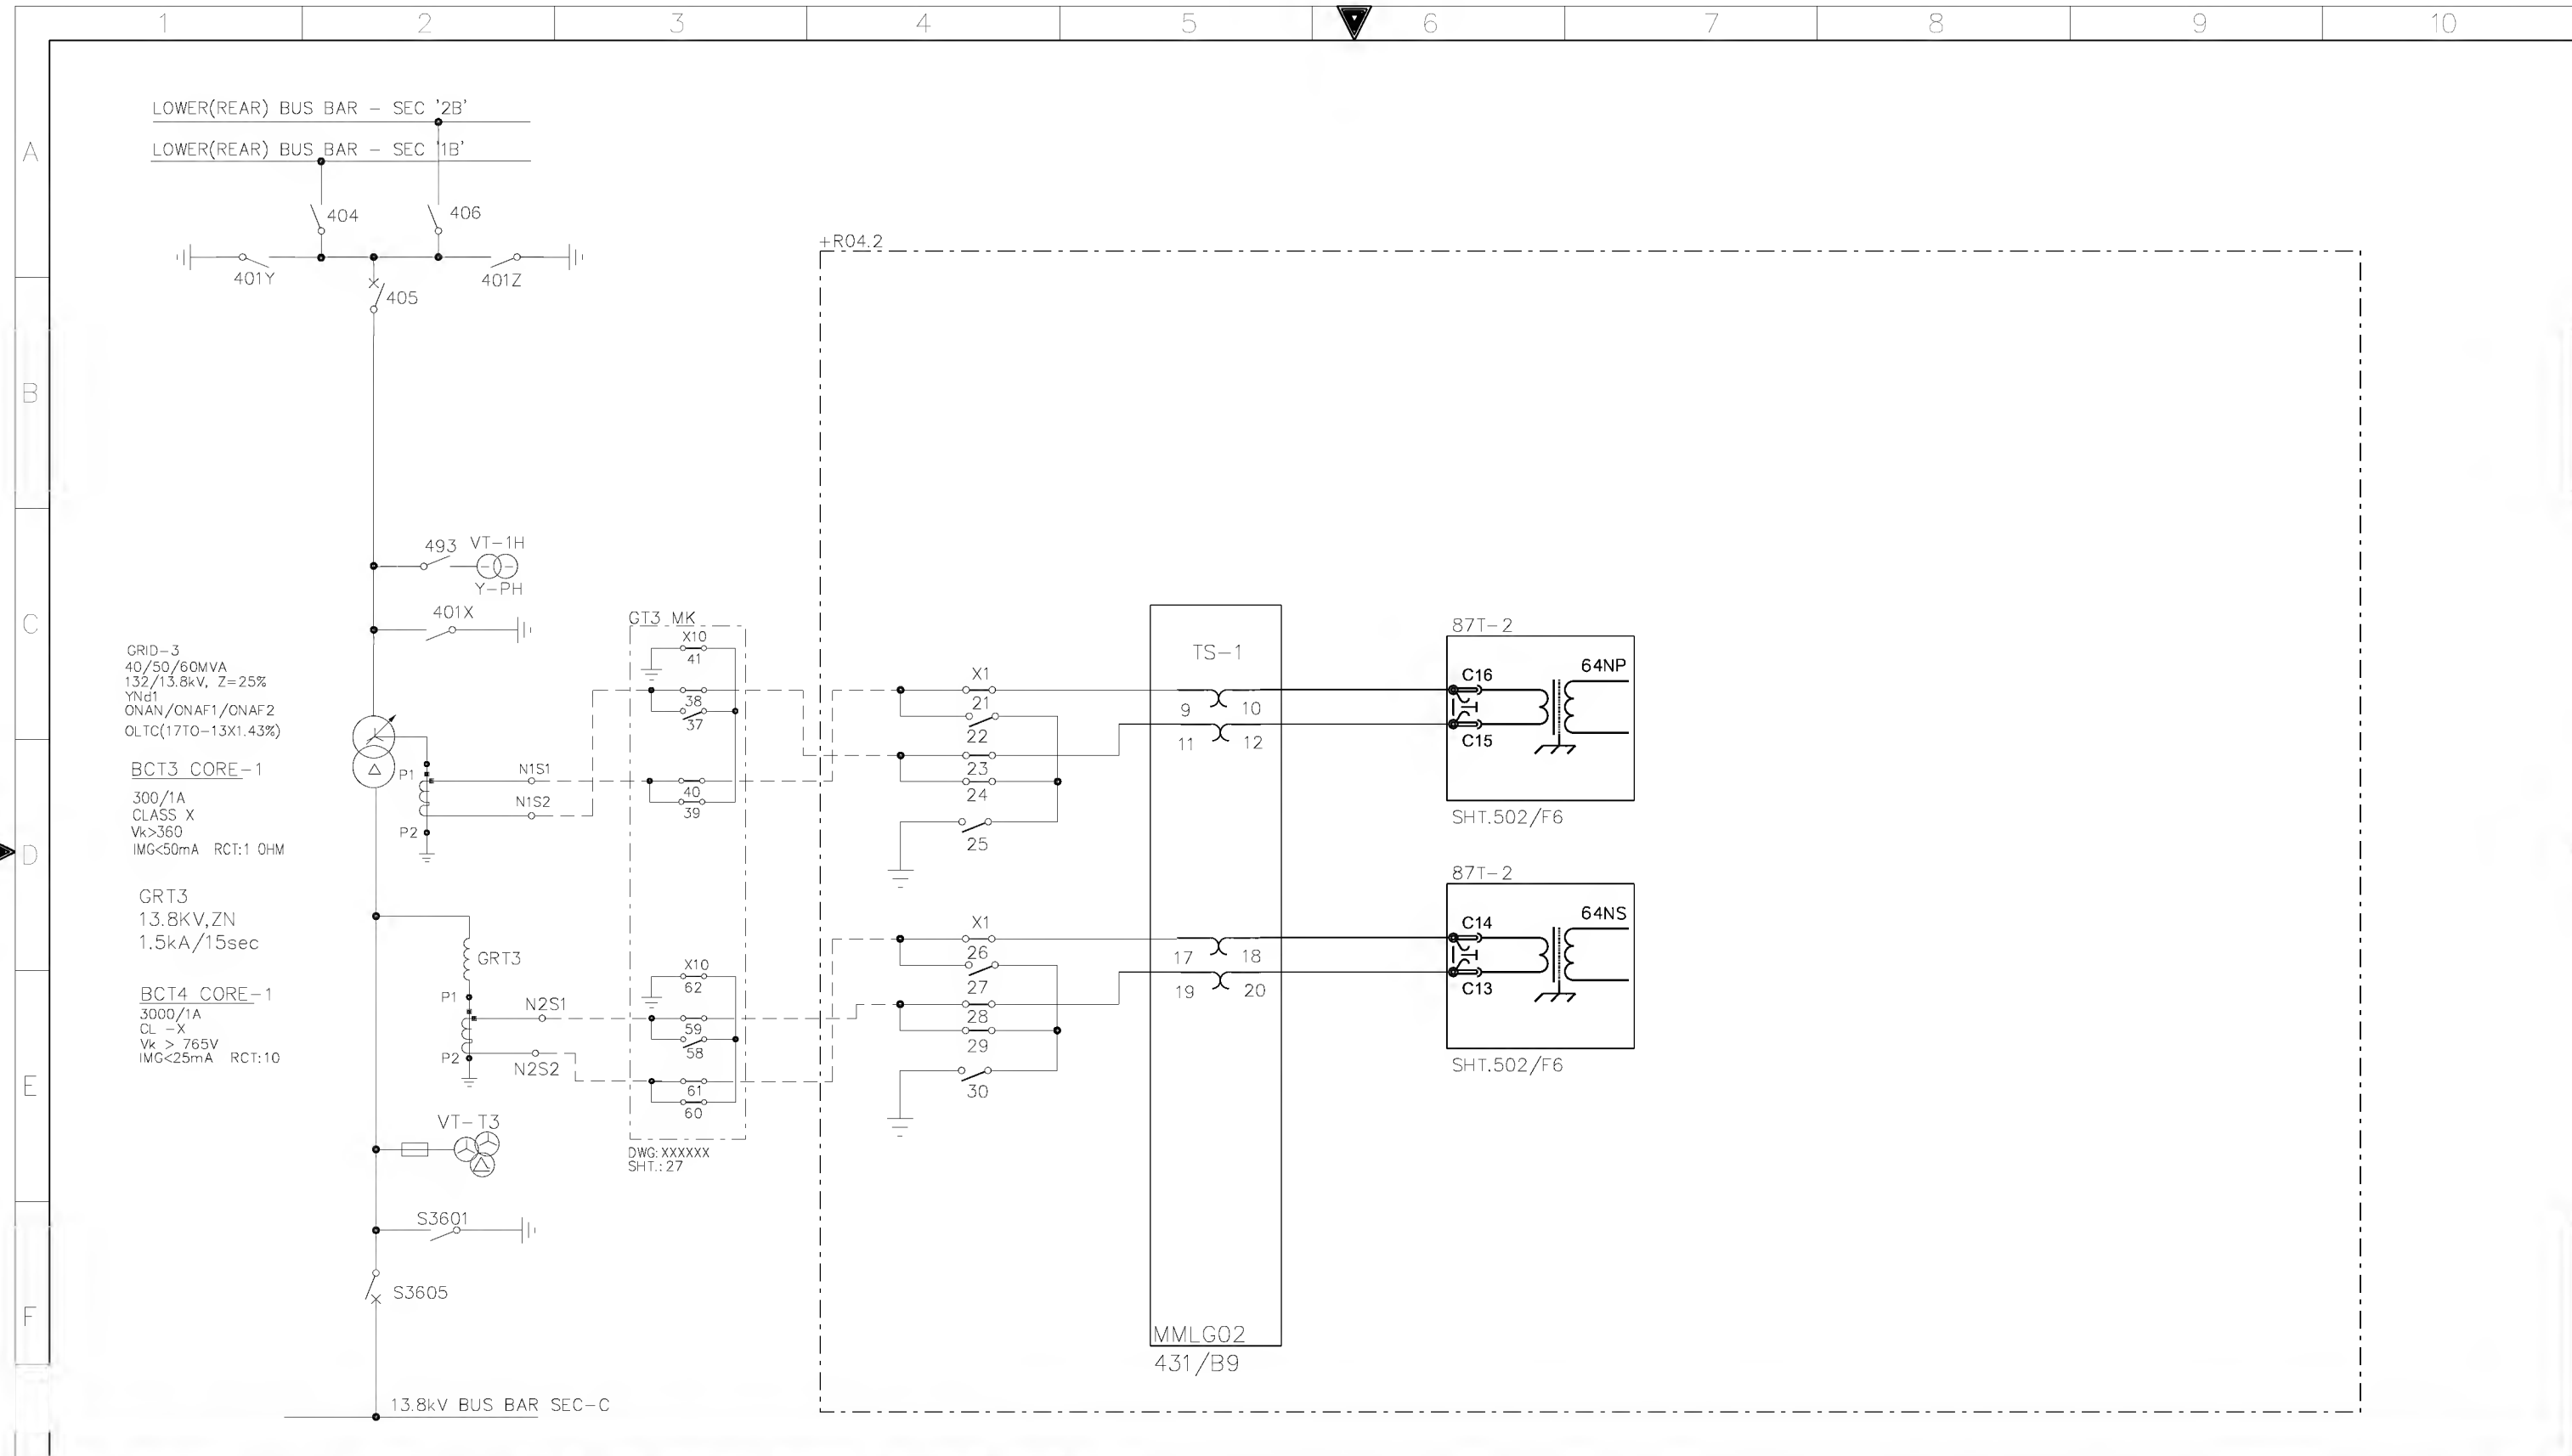

AS-BUILT BY _____ DATE _____ CONTRACT NO. 11131113/00 JOB ORDER NO. S-13656

01	13 49	FACTORY ASBUILT	DRAWN BY RIZ	CHECKED BY JKR
00	13 04	FOR APPROVAL	DATE STARTED 24.01.2013	DATE COMPLETED _____
REV. NO.	DATE	DESCRIPTION	OPRG. DEPT. CTPD	ENG. DEPT. AUT-PSAC


CT CIRCUITS 87T-2 RELAY

132/13.8kV GT-3 RELAY PANEL-2 +R04.2

S/S 8709-132/13.8KV IN AL-KHARJ CITY

RIYADH SAUDI ARABIA

الشركة الوطنية لنقل الكهرباء					نقل الكهرباء				
					National Grid sa				
INDEX	PLANT NO.	DRAWING NUMBER			SHEET NO.		REV. NO.		
-	C421	CD322934			SHT	CONT.	01		
					422	423			

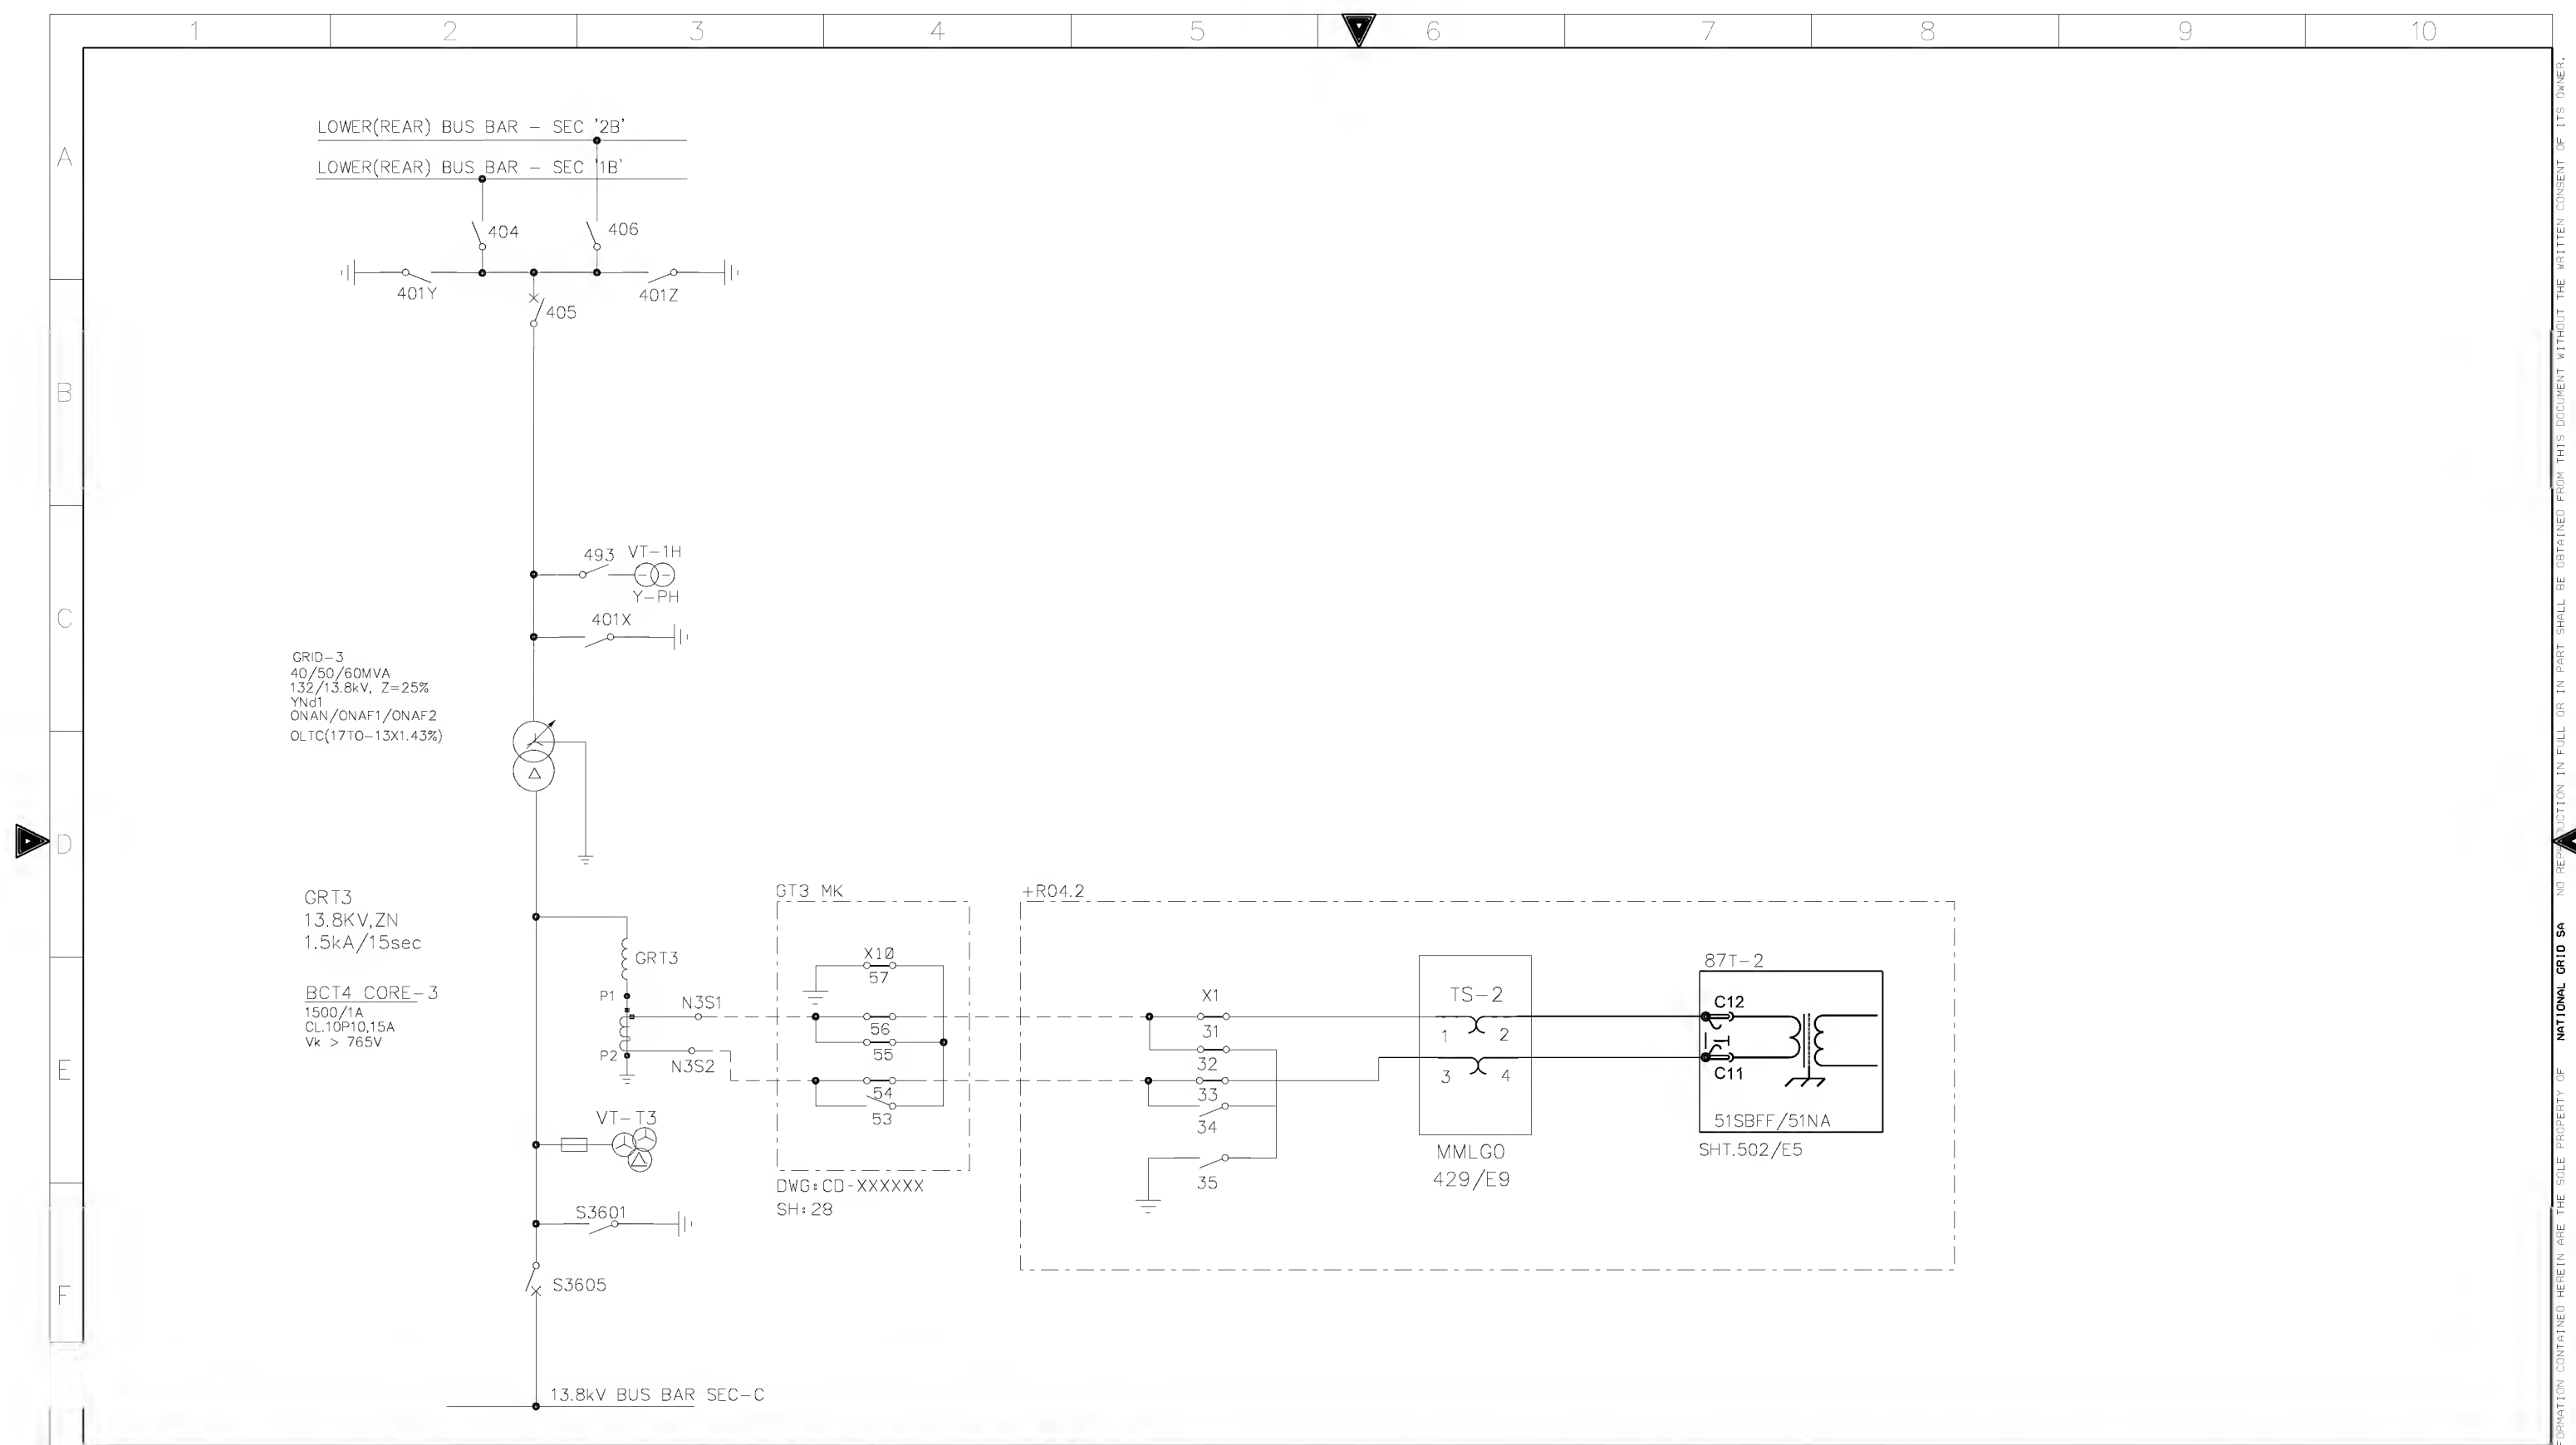

G	AS-BUILT BY _____ DATE _____		CONTRACT NO. 11131113/00		JOB ORDER NO. S-13656		CT CIRCUITS 87T-2 RELAY		<div>الشركة الوطنية لنقل الكهرباء</div> <div>نقل الكهرباء</div> <div>National Grid sa</div>						
				DRAWN BY RIZ CHECKED BY JKR		132/13.8kV GT-3 RELAY PANEL-2 +R04.2									
	01	13 49	FACTORY ASBUILT		DATE STARTED 24.01.2013 DATE COMPLETED _____		S/S 8709-132/13.8KV IN AL-KHARJ CITY		INDEX	PLANT NO.	DRAWING NUMBER		SHEET NO.		REV. NO.
	00	13 04	FOR APPROVAL		OPRG. DEPT. CTPD ENG. DEPT. AUT-PSAC		RIYADH SAUDI ARABIA		-	C421	CD322934		SHT	CONT.	01
	REV. NO.	DATE	DESCRIPTION										423	424	


THIS DRAWING AND THE INFORMATION CONTAINED HEREIN ARE THE PROPERTY OF NATIONAL GRID SAUDI ARABIA. IT IS TO BE USED FOR THE PROJECT AND LOCATION SPECIFICALLY IDENTIFIED IN THE TITLE BLOCK. IT IS NOT TO BE REPRODUCED OR TRANSMITTED IN ANY FORM OR BY ANY MEANS, ELECTRONIC OR MECHANICAL, INCLUDING PHOTOCOPYING, RECORDING, OR BY ANY INFORMATION STORAGE AND RETRIEVAL SYSTEM, WITHOUT THE WRITTEN PERMISSION OF NATIONAL GRID SAUDI ARABIA.

NG/D2-D (2012/01)

DMS

VECTOR

NGD200

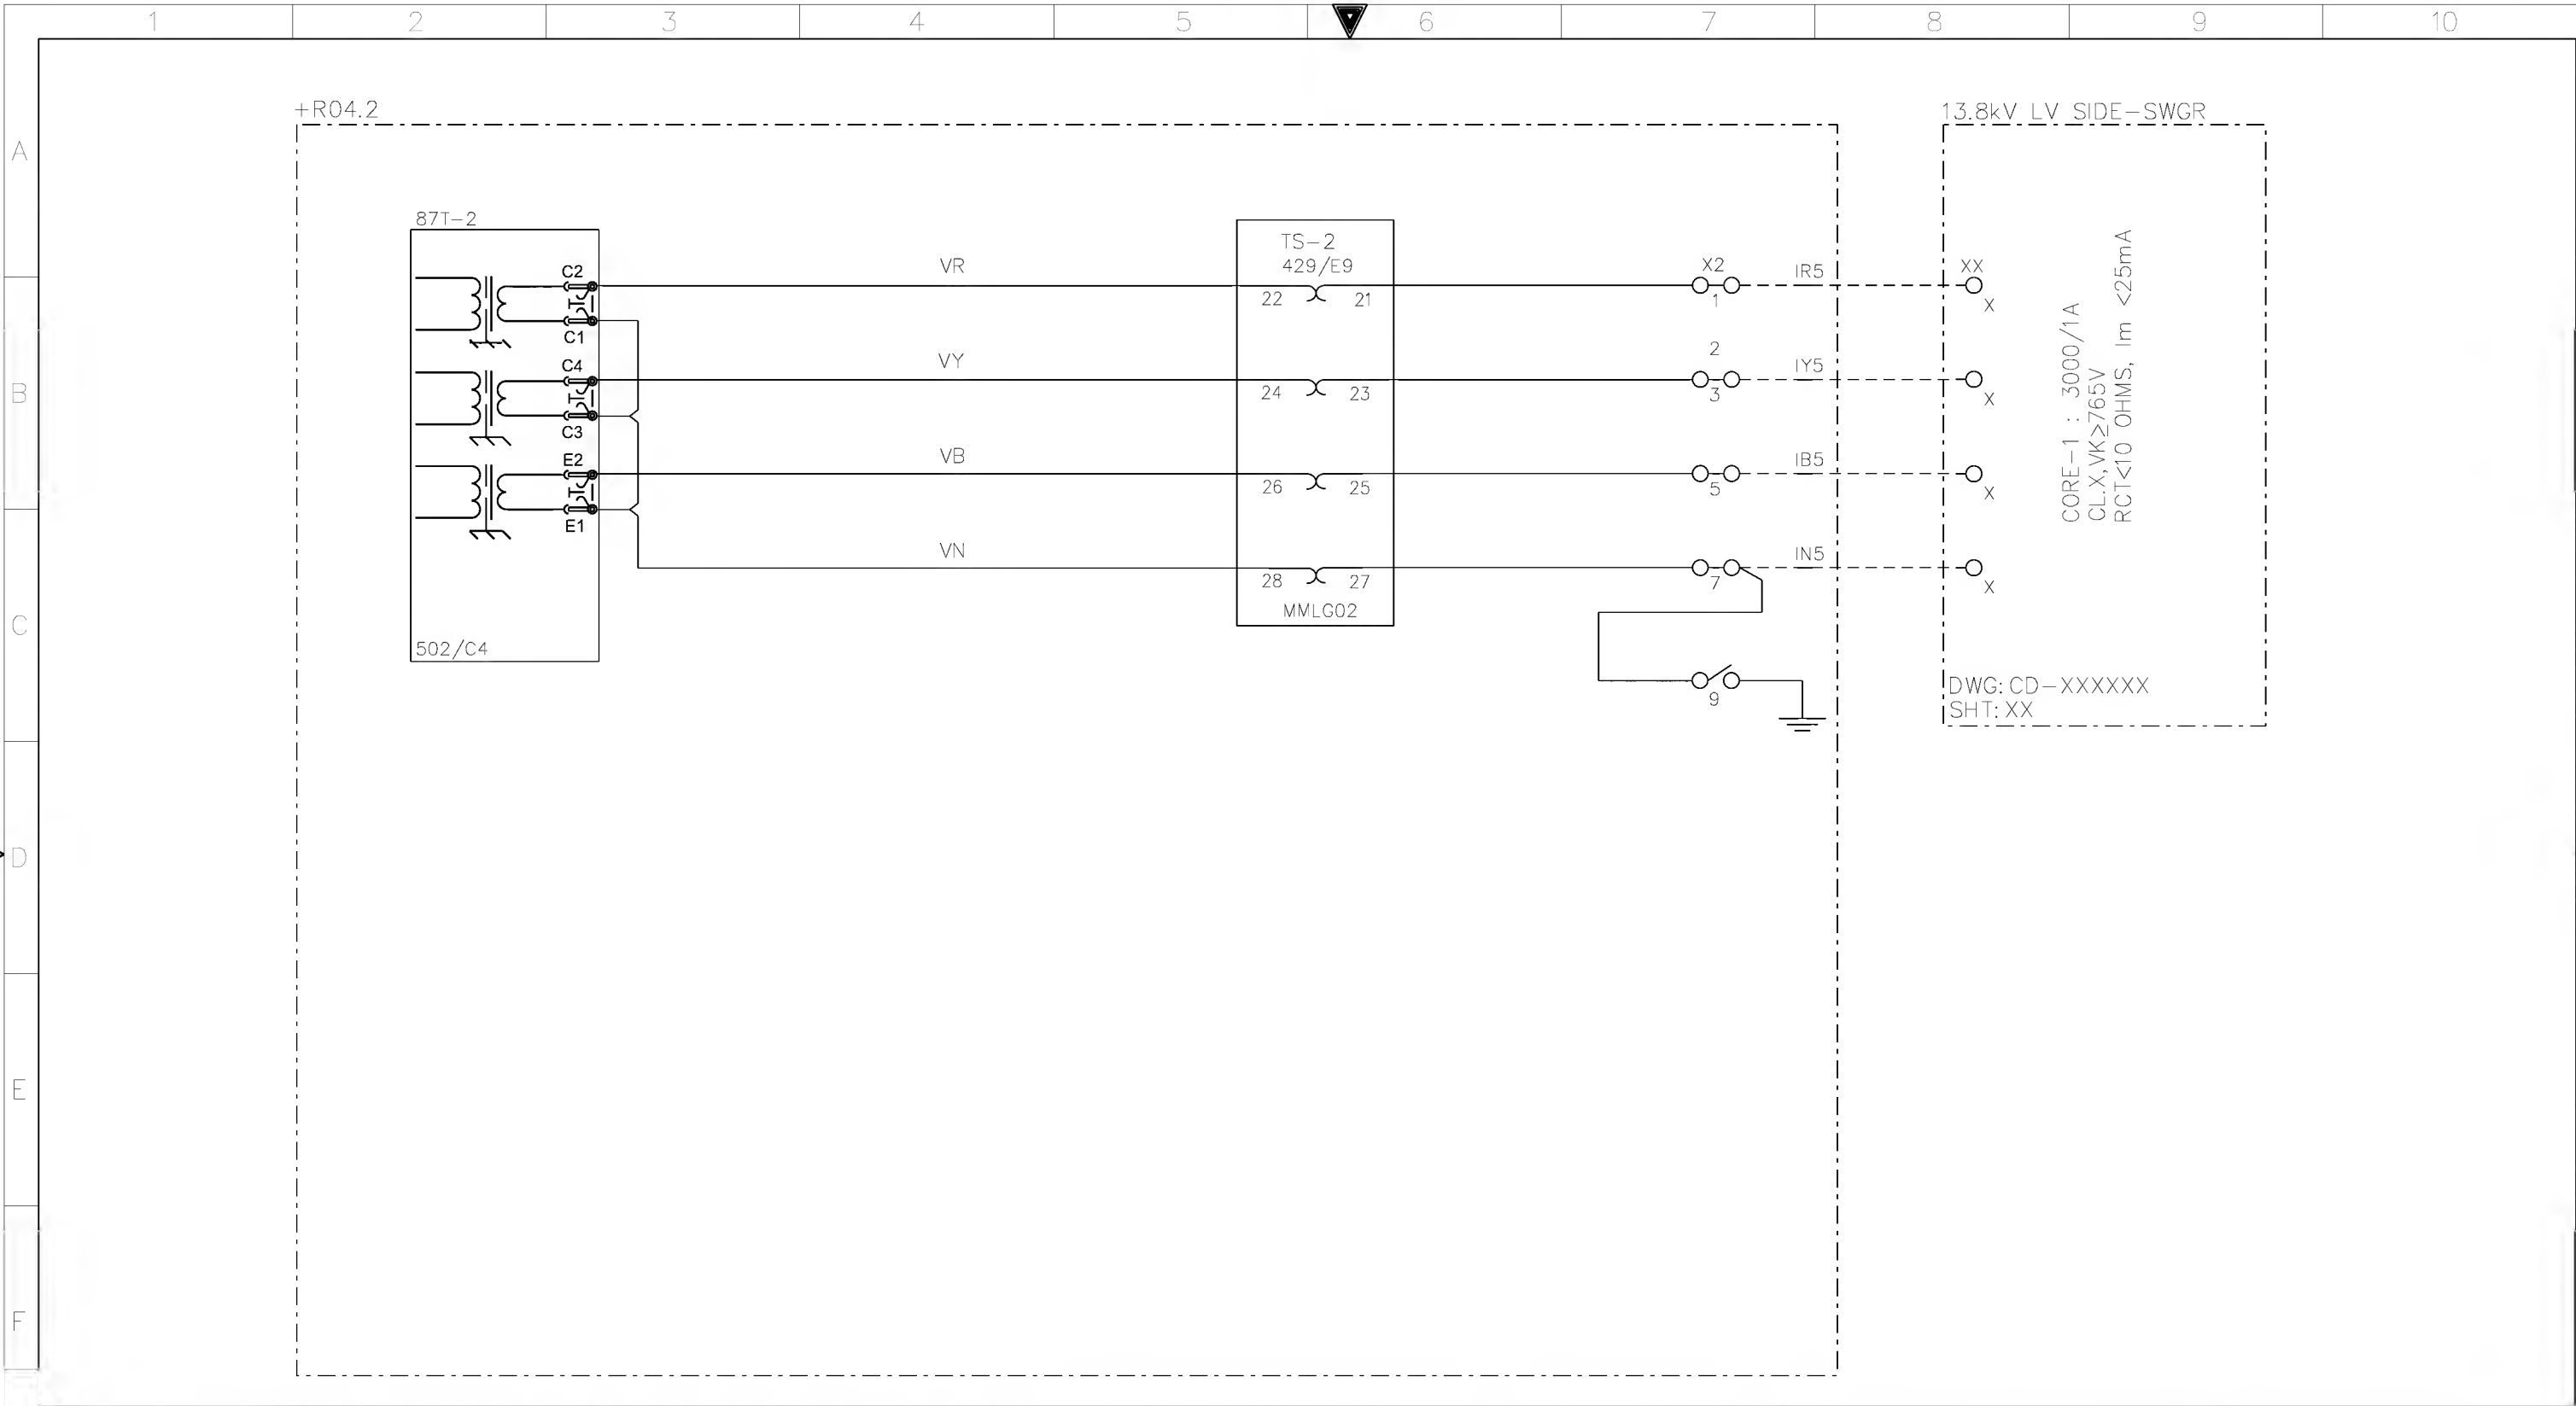

AS-BUILT BY _____ DATE _____ CONTRACT NO. 11131113/00 JOB ORDER NO. S-13656

01	13 49	FACTORY ASBUILT
00	13 04	FOR APPROVAL
REV. NO.	DATE	DESCRIPTION

DRAWN BY RIZ CHECKED BY JKR

DATE STARTED 24.01.2013 DATE COMPLETED _____

OPRG. DEPT. CTPD ENG. DEPT. AUT-PSAC


CT & VT CIRCUITS 87T-2 RELAY


132/13.8kV GT-3 RELAY PANEL-2 +R04.2

S/S 8709-132/13.8KV IN AL-KHARJ CITY

RIYADH SAUDI ARABIA


الشركة الوطنية لنقل الكهرباء		نقل الكهرباء		National Grid sa	
INDEX	PLANT NO.	DRAWING NUMBER	SHEET NO.	REV. NO.	
-	C421	CD322934	SHT 424	CONT. 429	01

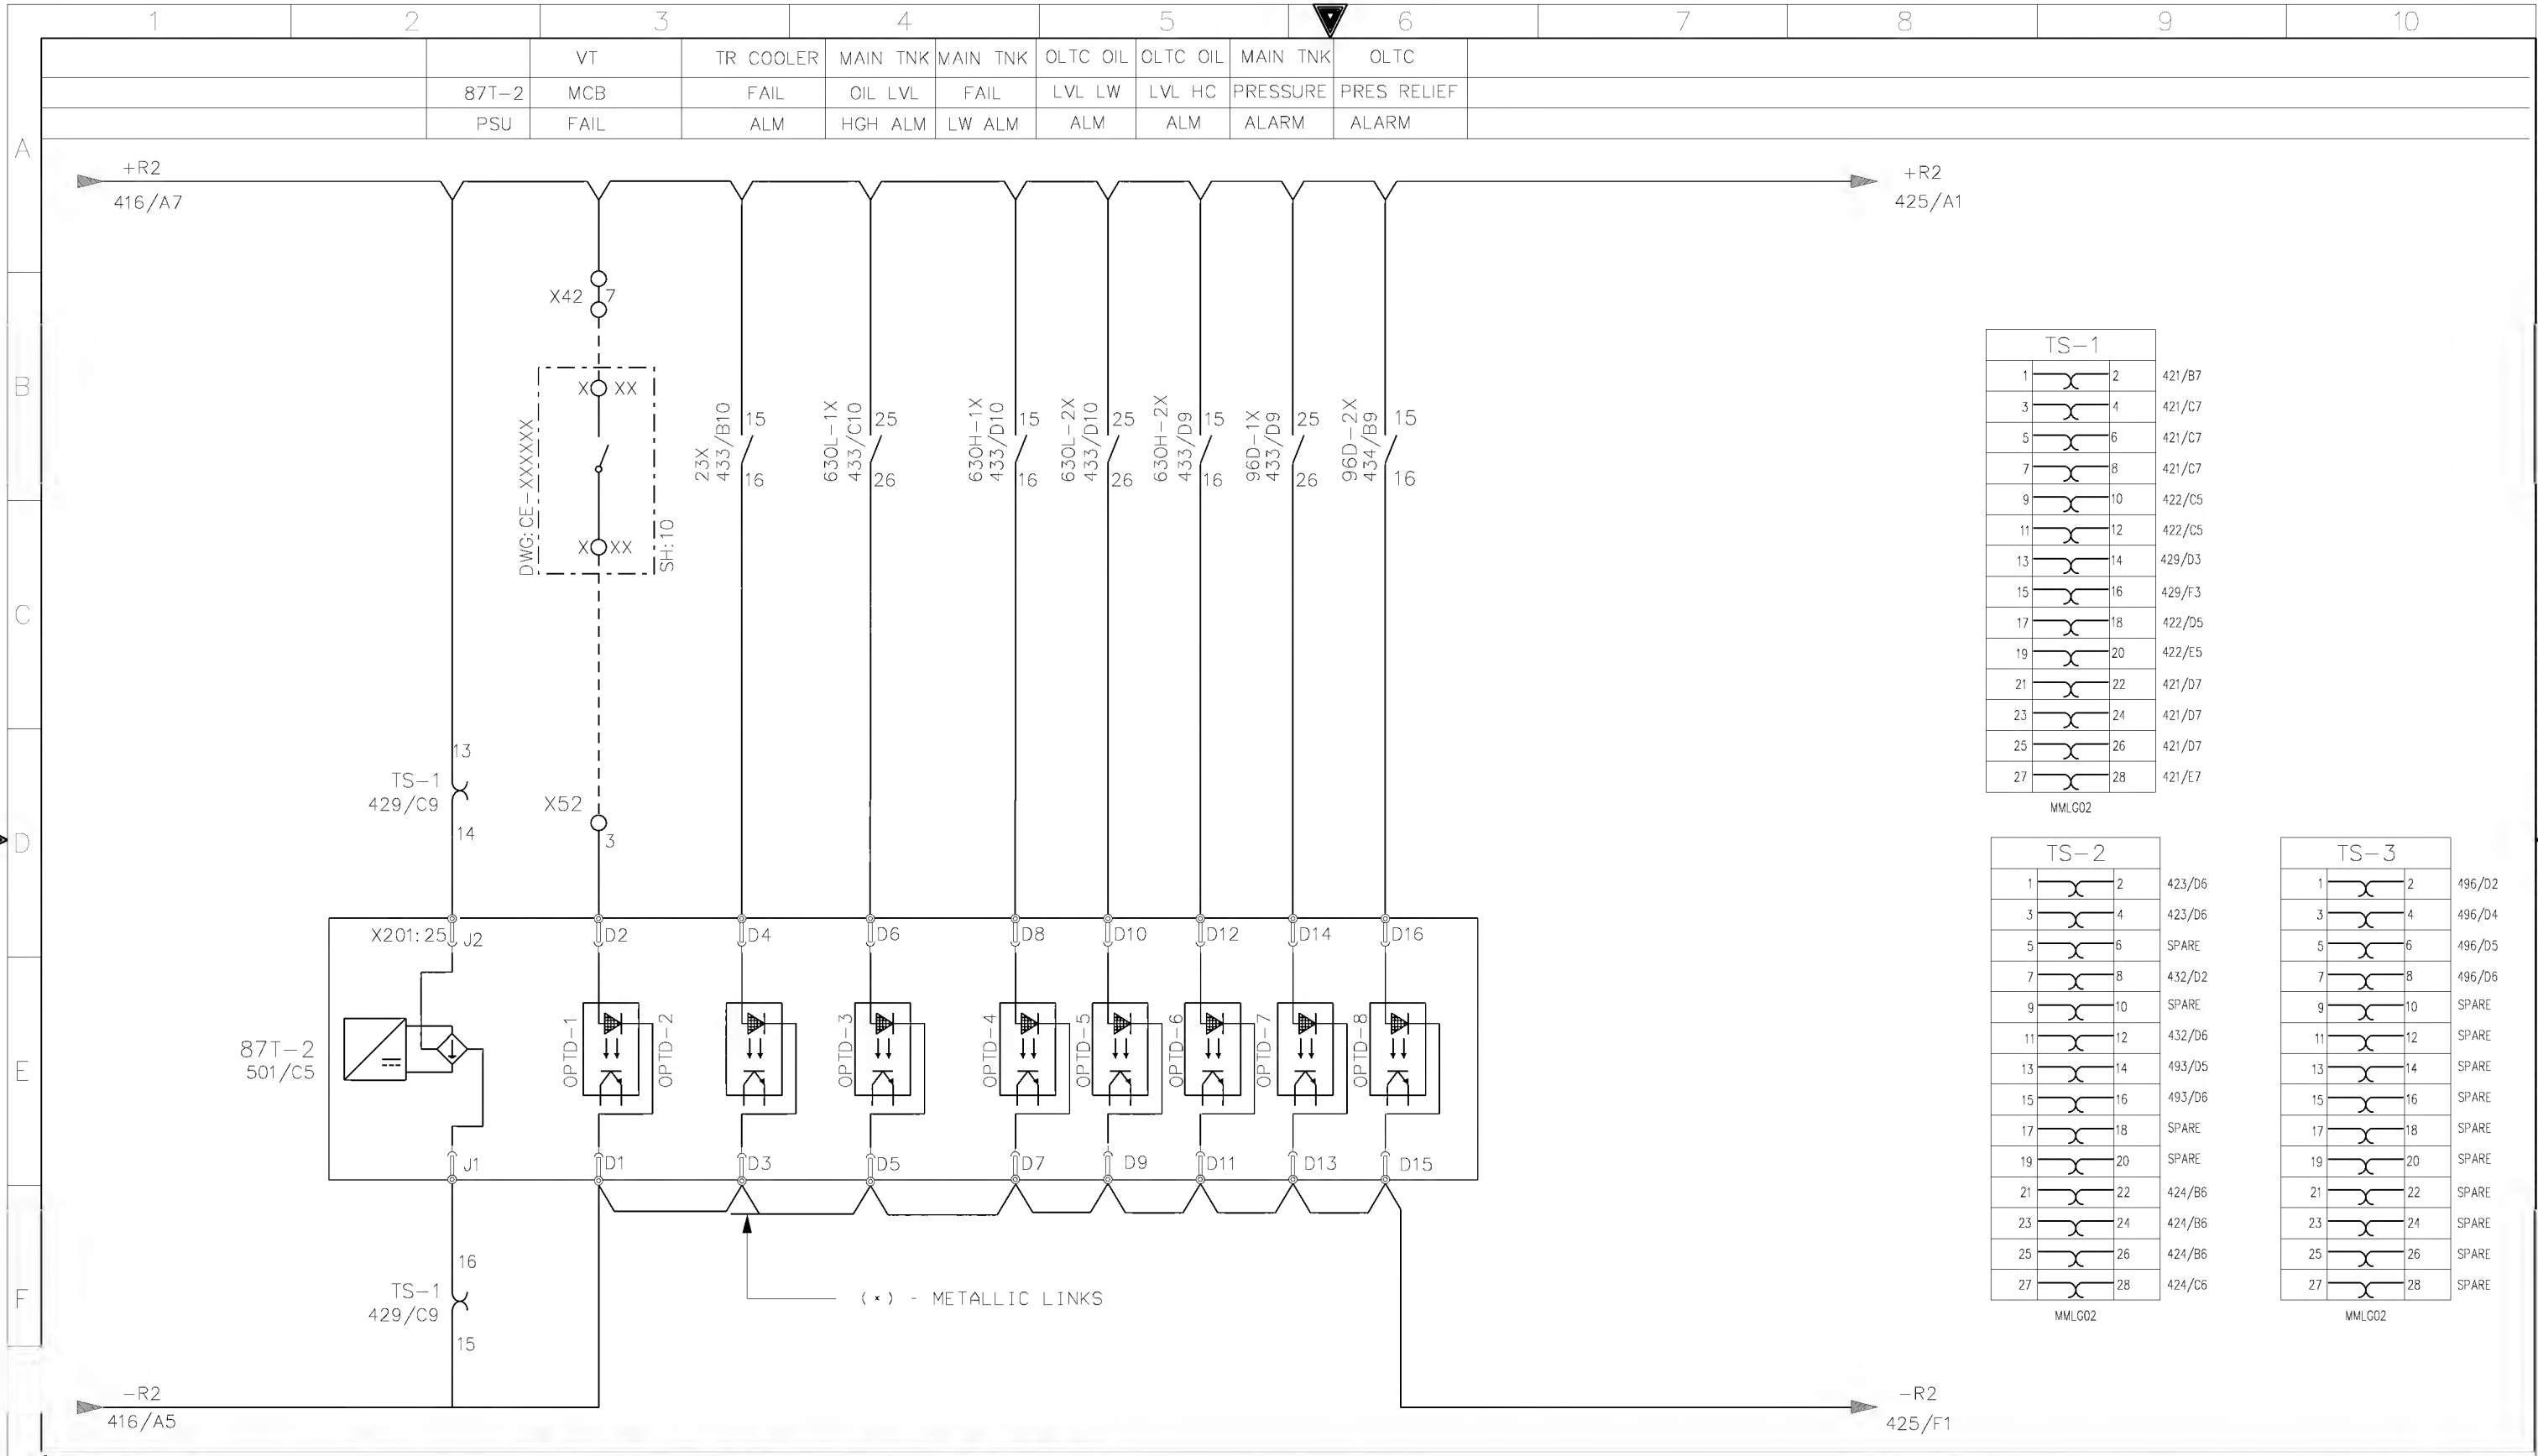

AS-BUILT BY _____ DATE _____			CONTRACT NO. 11131113/00		JOB ORDER NO. S-13656		87T-2 BINARY INPUTS		<div>الشركة الوطنية لنقل الكهرباء</div> <div>نقل الكهرباء</div> <div>National Grid sa</div>						
			DRAWN BY <u>RIZ</u> CHECKED BY <u>JKR</u>		132/13.8kV GT-3 RELAY PANEL-2 +R04.2		132/13.8kV GT-3 RELAY PANEL-2 +R04.2								
01 13 49 FACTORY ASBUILT			DATE STARTED <u>24.01.2013</u> DATE COMPLETED _____		S/S 8709-132/13.8KV IN AL-KHARJ CITY		INDEX		PLANT NO.	DRAWING NUMBER		SHEET NO.		REV. NO.	
00 13 04 FOR APPROVAL			OPRG. DEPT. <u>CTPD</u> ENG. DEPT. <u>AUT-PSAC</u>		RIYADH		-		C421	CD322934		SHT		CONT.	01
REV. NO. DATE DESCRIPTION					SAUDI ARABIA							429		430	

NG/D2-D (2012/01)


DMS VECTOR NGD200



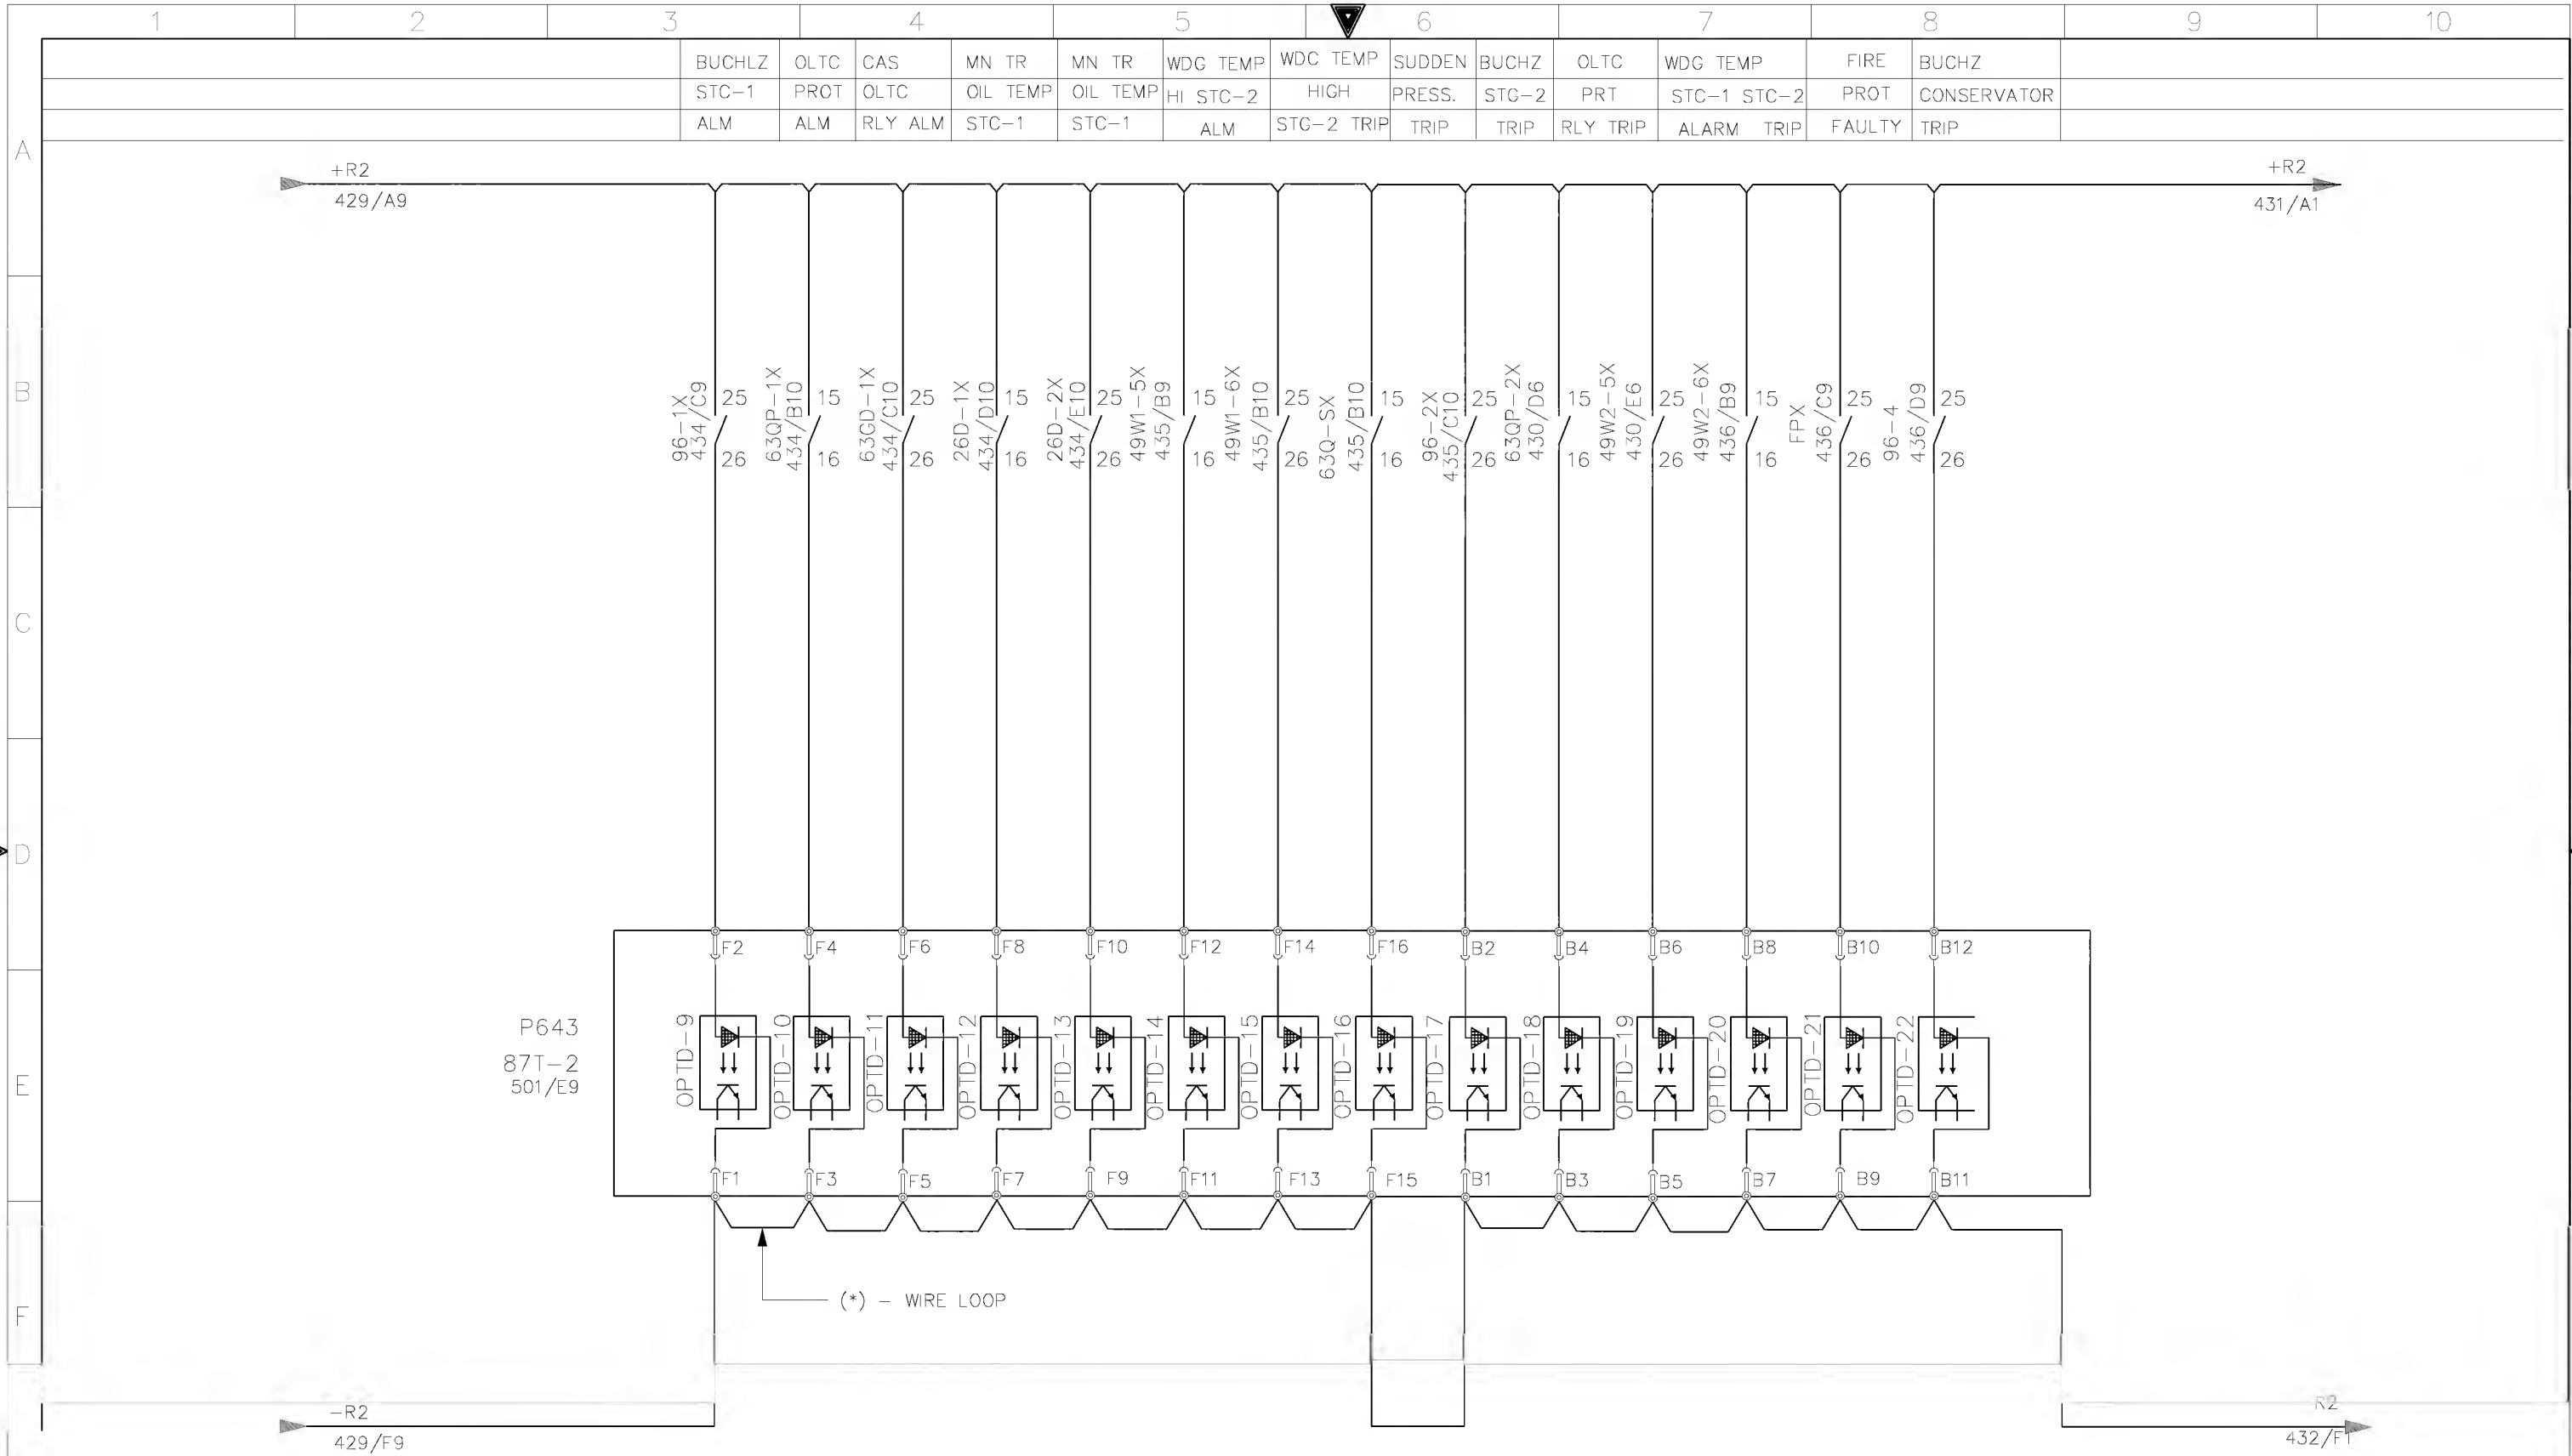


AS-BUILT BY _____ DATE _____			CONTRACT NO. 11131113/00		JOB ORDER NO. S-13656	
01	13 49	FACTORY ASBUILT	DRAWN BY RIZ		CHECKED BY JKR	
00	13 04	FOR APPROVAL	DATE STARTED 24.01.2013		DATE COMPLETED _____	
REV. NO.	DATE	DESCRIPTION	OPRG. DEPT. CTPD		ENG. DEPT. AUT-PSAC	



87T-2 BINARY INPUTS	
132/13.8kV GT-3 RELAY PANEL-2 +R04.2	
S/S 8709-132/13.8KV IN AL-KHARJ CITY	
RIYADH SAUDI ARABIA	

الشركة الوطنية لنقل الكهرباء				نقل الكهرباء		
				National Grid SA		
INDEX	PLANT NO.	DRAWING NUMBER		SHEET NO.		REV. NO.
				SHT	CONT.	
-	C421	CD322934		430	432	01


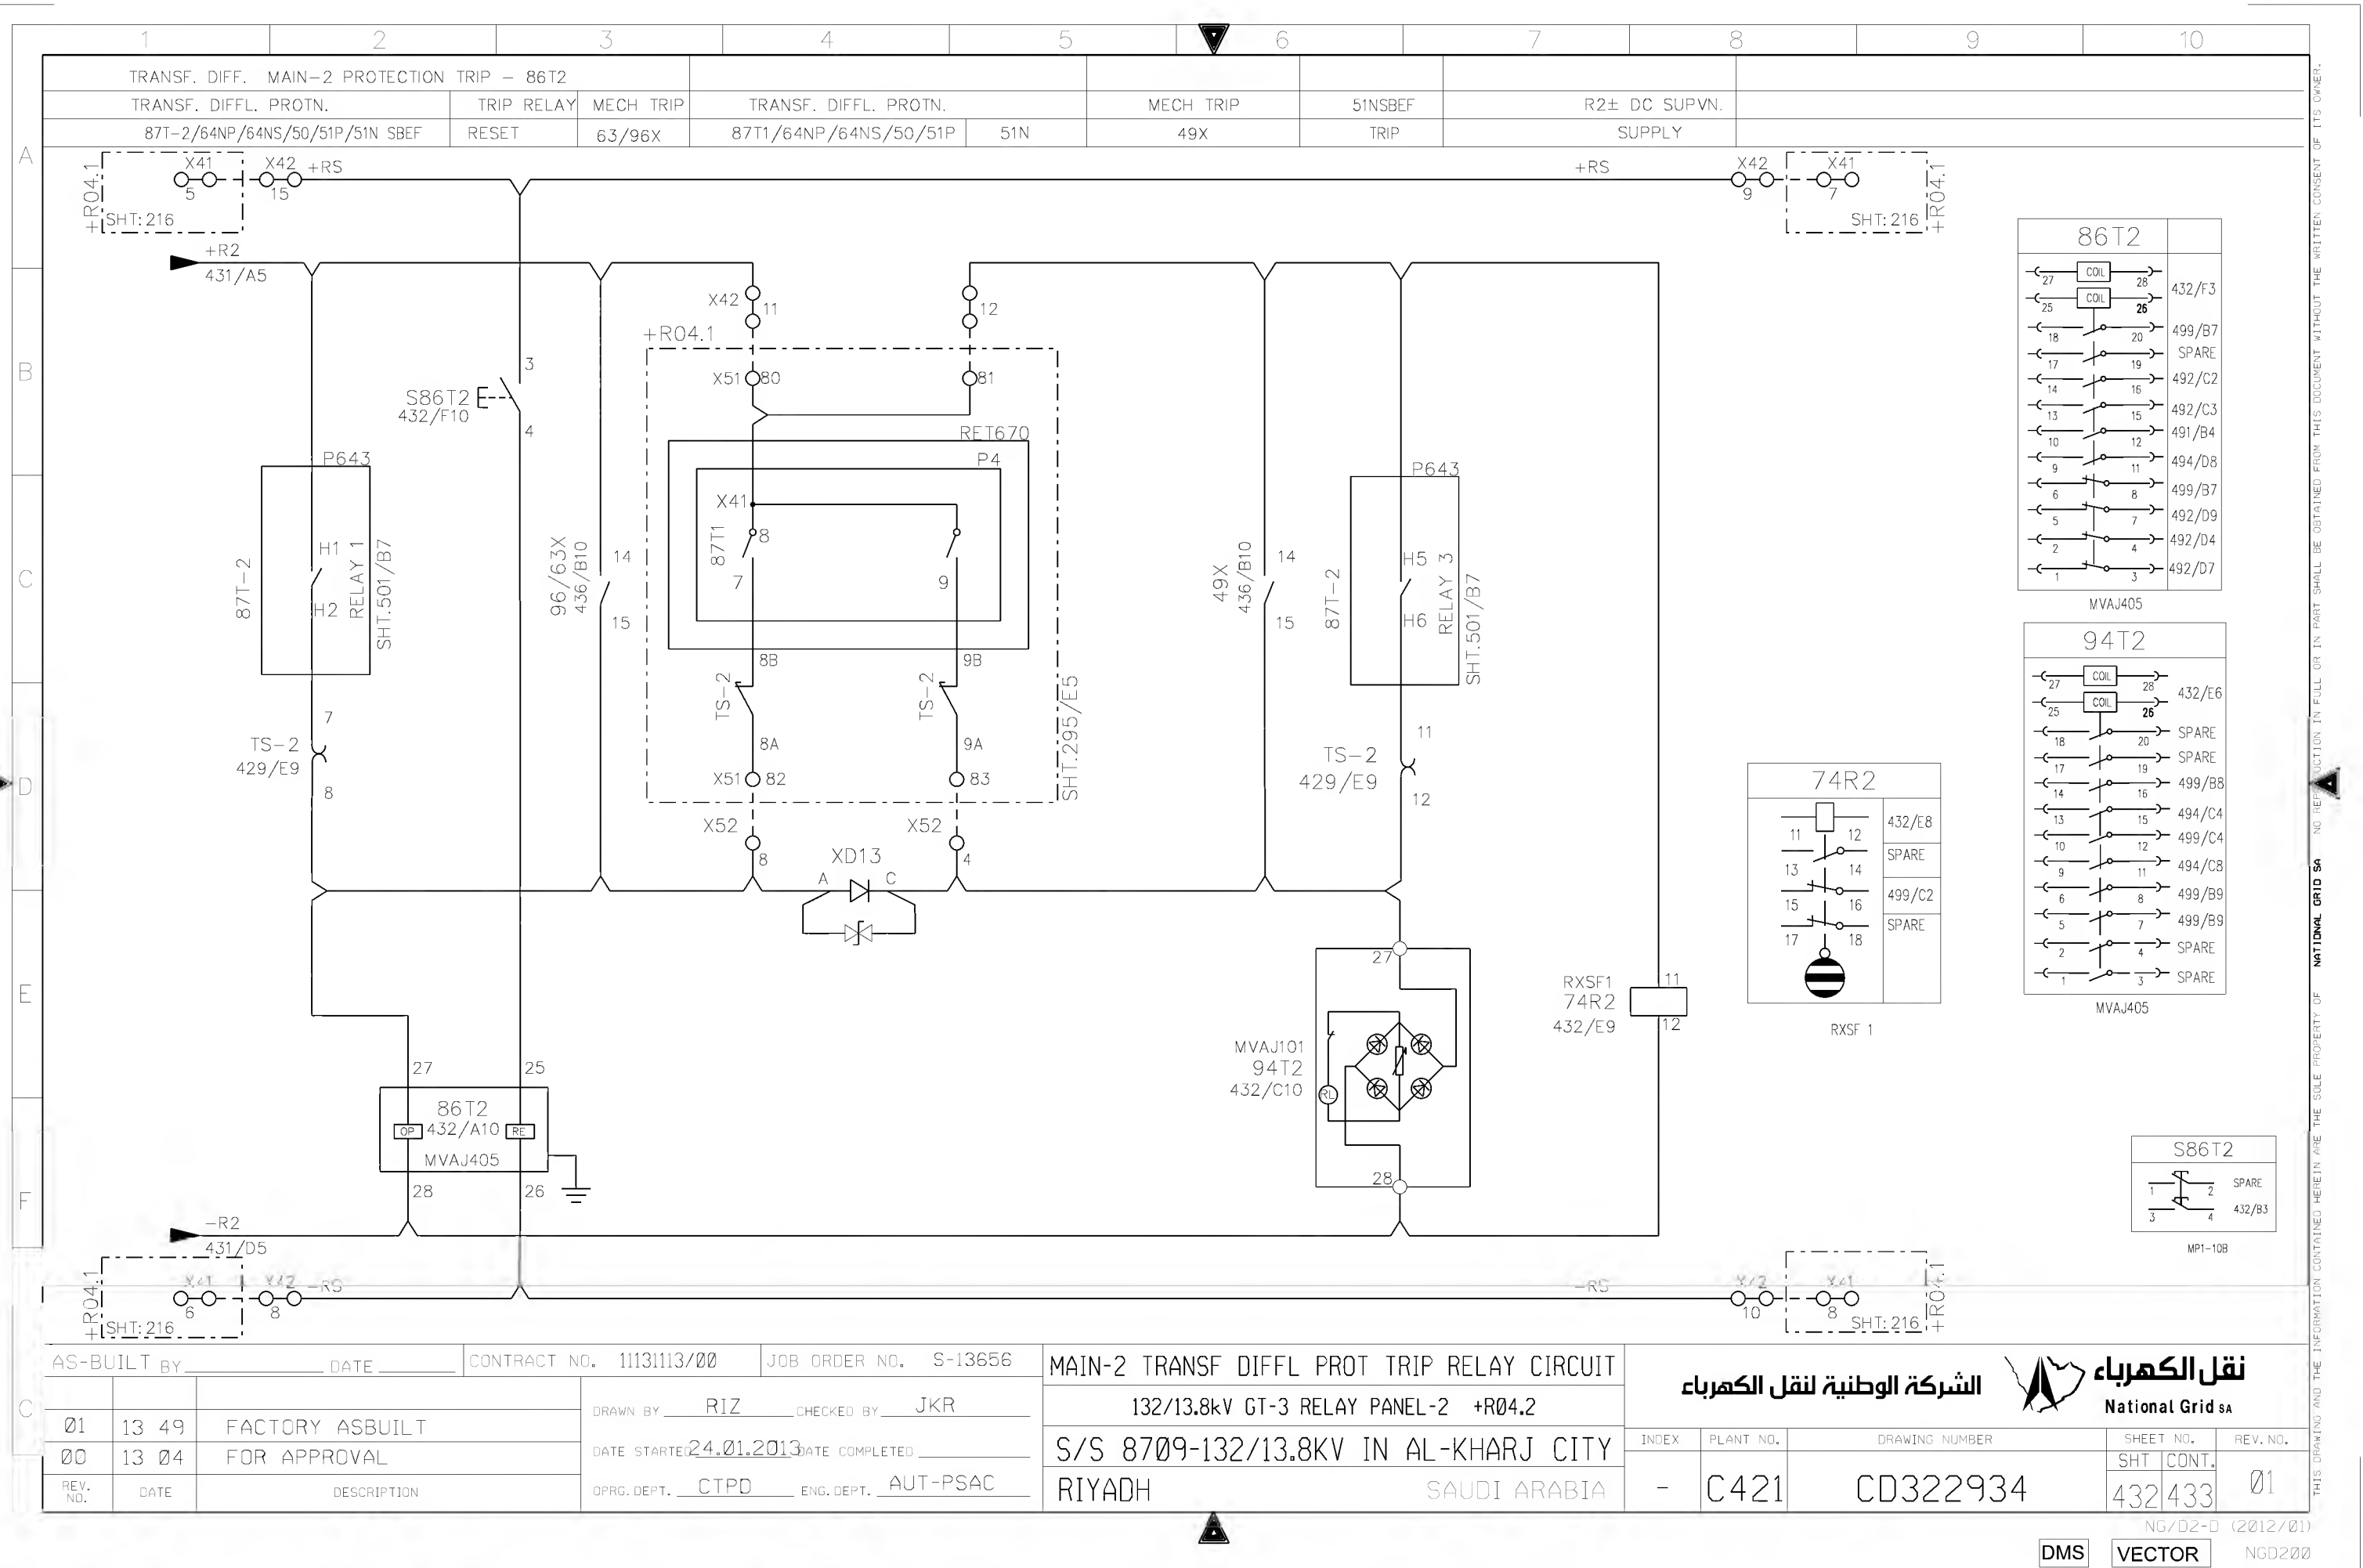


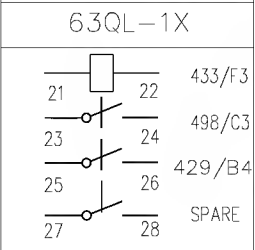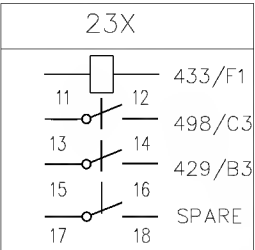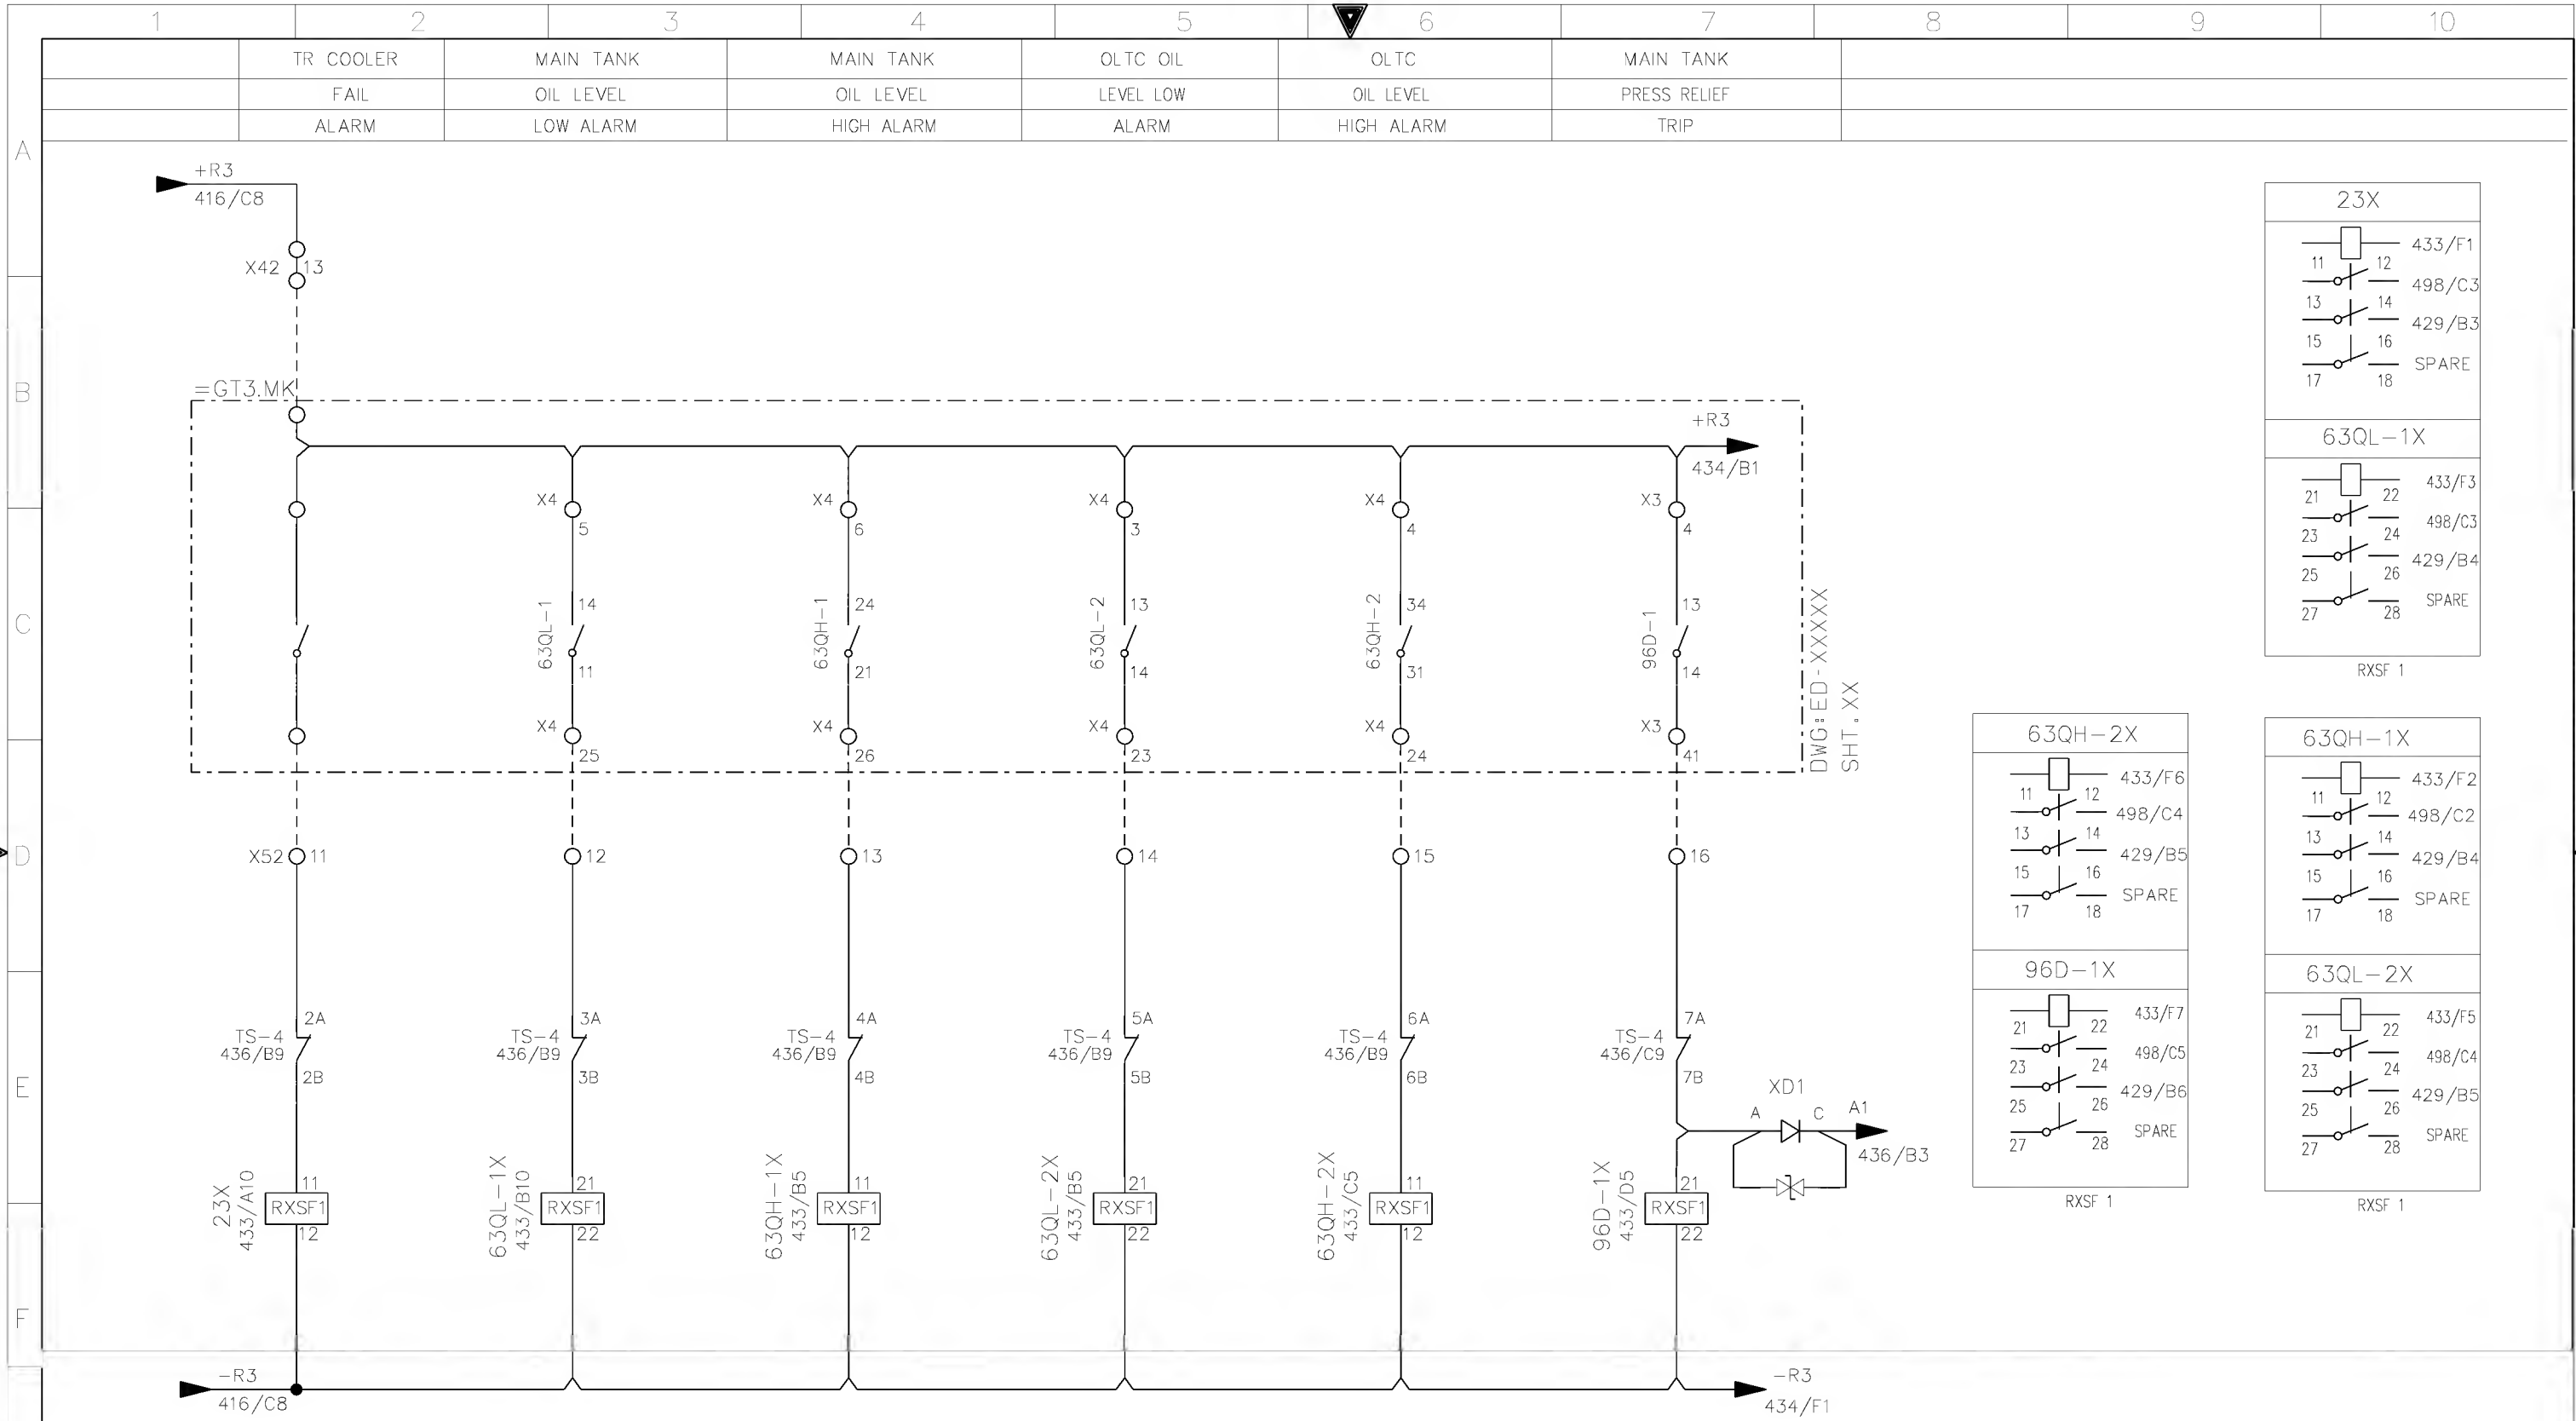

RXS F 1

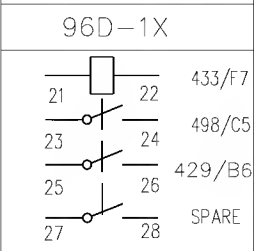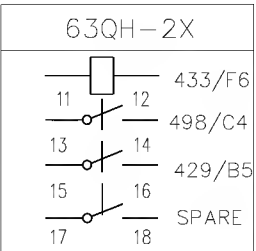

RXS F 1

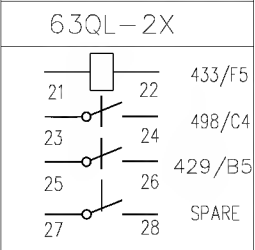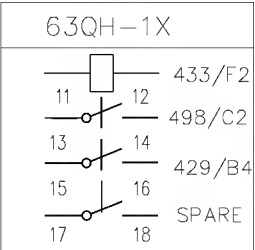

RXS F 1

+R04.2

AS-BUILT BY _____ DATE _____ CONTRACT NO. 11131113/00 JOB ORDER NO. S-13656

01	13 49	FACTORY ASBUILT	DRAWN BY RIZ	CHECKED BY JKR
00	13 04	FOR APPROVAL	DATE STARTED 24.01.2013	DATE COMPLETED
REV. NO.	DATE	DESCRIPTION	OPRG. DEPT. CTPD	ENG. DEPT. AUT-PSAC





TRANS .MECH.PROTN.CONTACT MULTI.CKT

132/13.8kV GT-3 RELAY PANEL-2 +R04.2

S/S 8709-132/13.8KV IN AL-KHARJ CITY
RIYADH SAUDI ARABIA

الشركة الوطنية لنقل الكهرباء
National Grid sa

INDEX	PLANT NO.	DRAWING NUMBER	SHEET NO.	REV. NO.
-	C421	CD322934	SHT 433	CONT. 434
				01

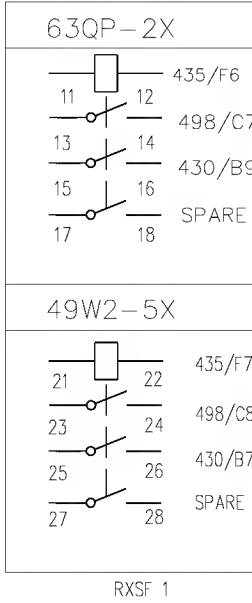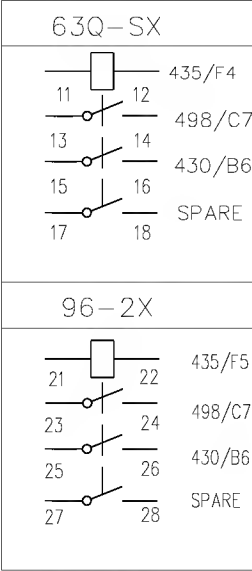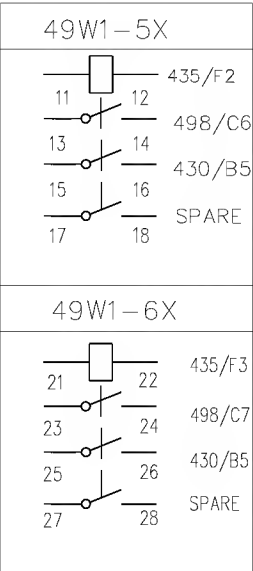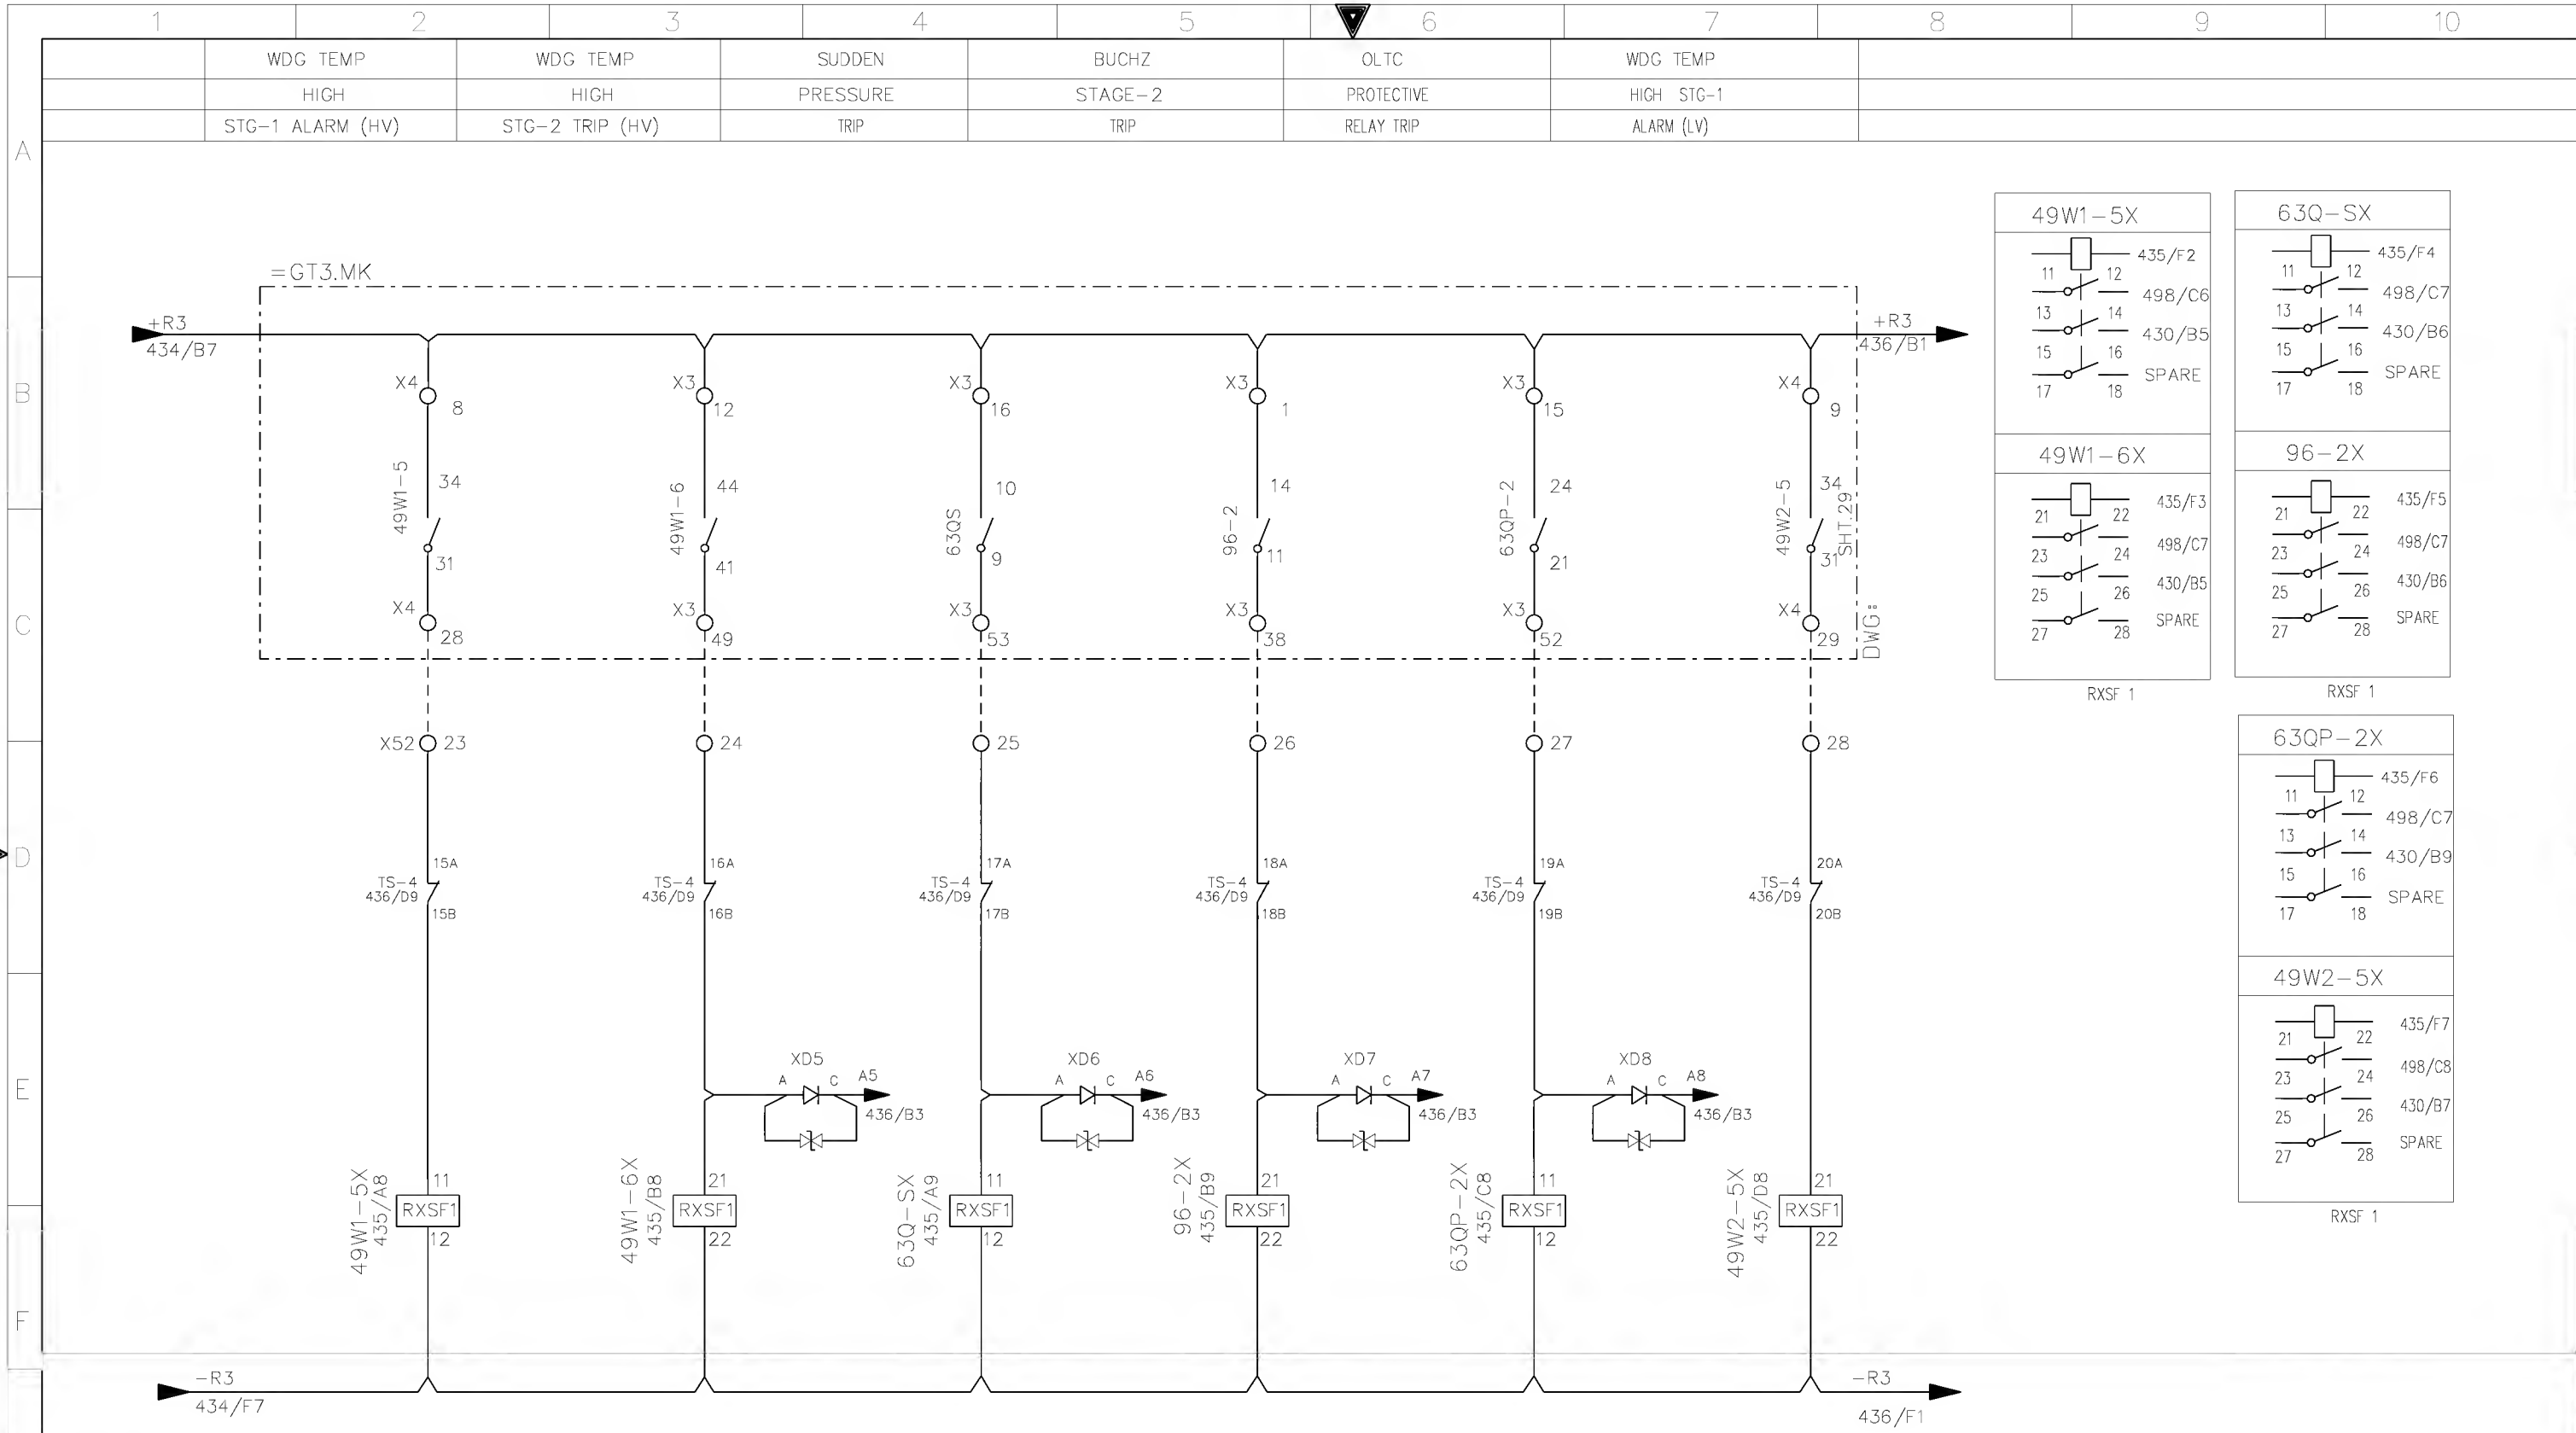

AS-BUILT BY _____ DATE _____			CONTRACT NO. 11131113/00		JOB ORDER NO. S-13656	
01	13 49	FACTORY ASBUILT	DRAWN BY RIZ		CHECKED BY JKR	
00	13 04	FOR APPROVAL	DATE STARTED 24.01.2013		DATE COMPLETED _____	
REV. NO.	DATE	DESCRIPTION	OPRG. DEPT. CTPD		ENG. DEPT. AUT-PSAC	


TRANS.MECH.PROTN.CONTACT.MULTI.CKT

132/13.8kV GT-3 RELAY PANEL-2 +R04.2

S/S 8709-132/13.8KV IN AL-KHARJ CITY

RIYADH SAUDI ARABIA


الشركة الوطنية لنقل الكهرباء		نقل الكهرباء		National Grid sa	
INDEX	PLANT NO.	DRAWING NUMBER		SHEET NO.	REV. NO.
-	C421	CD322934		SHT CONT.	01
				435 436	

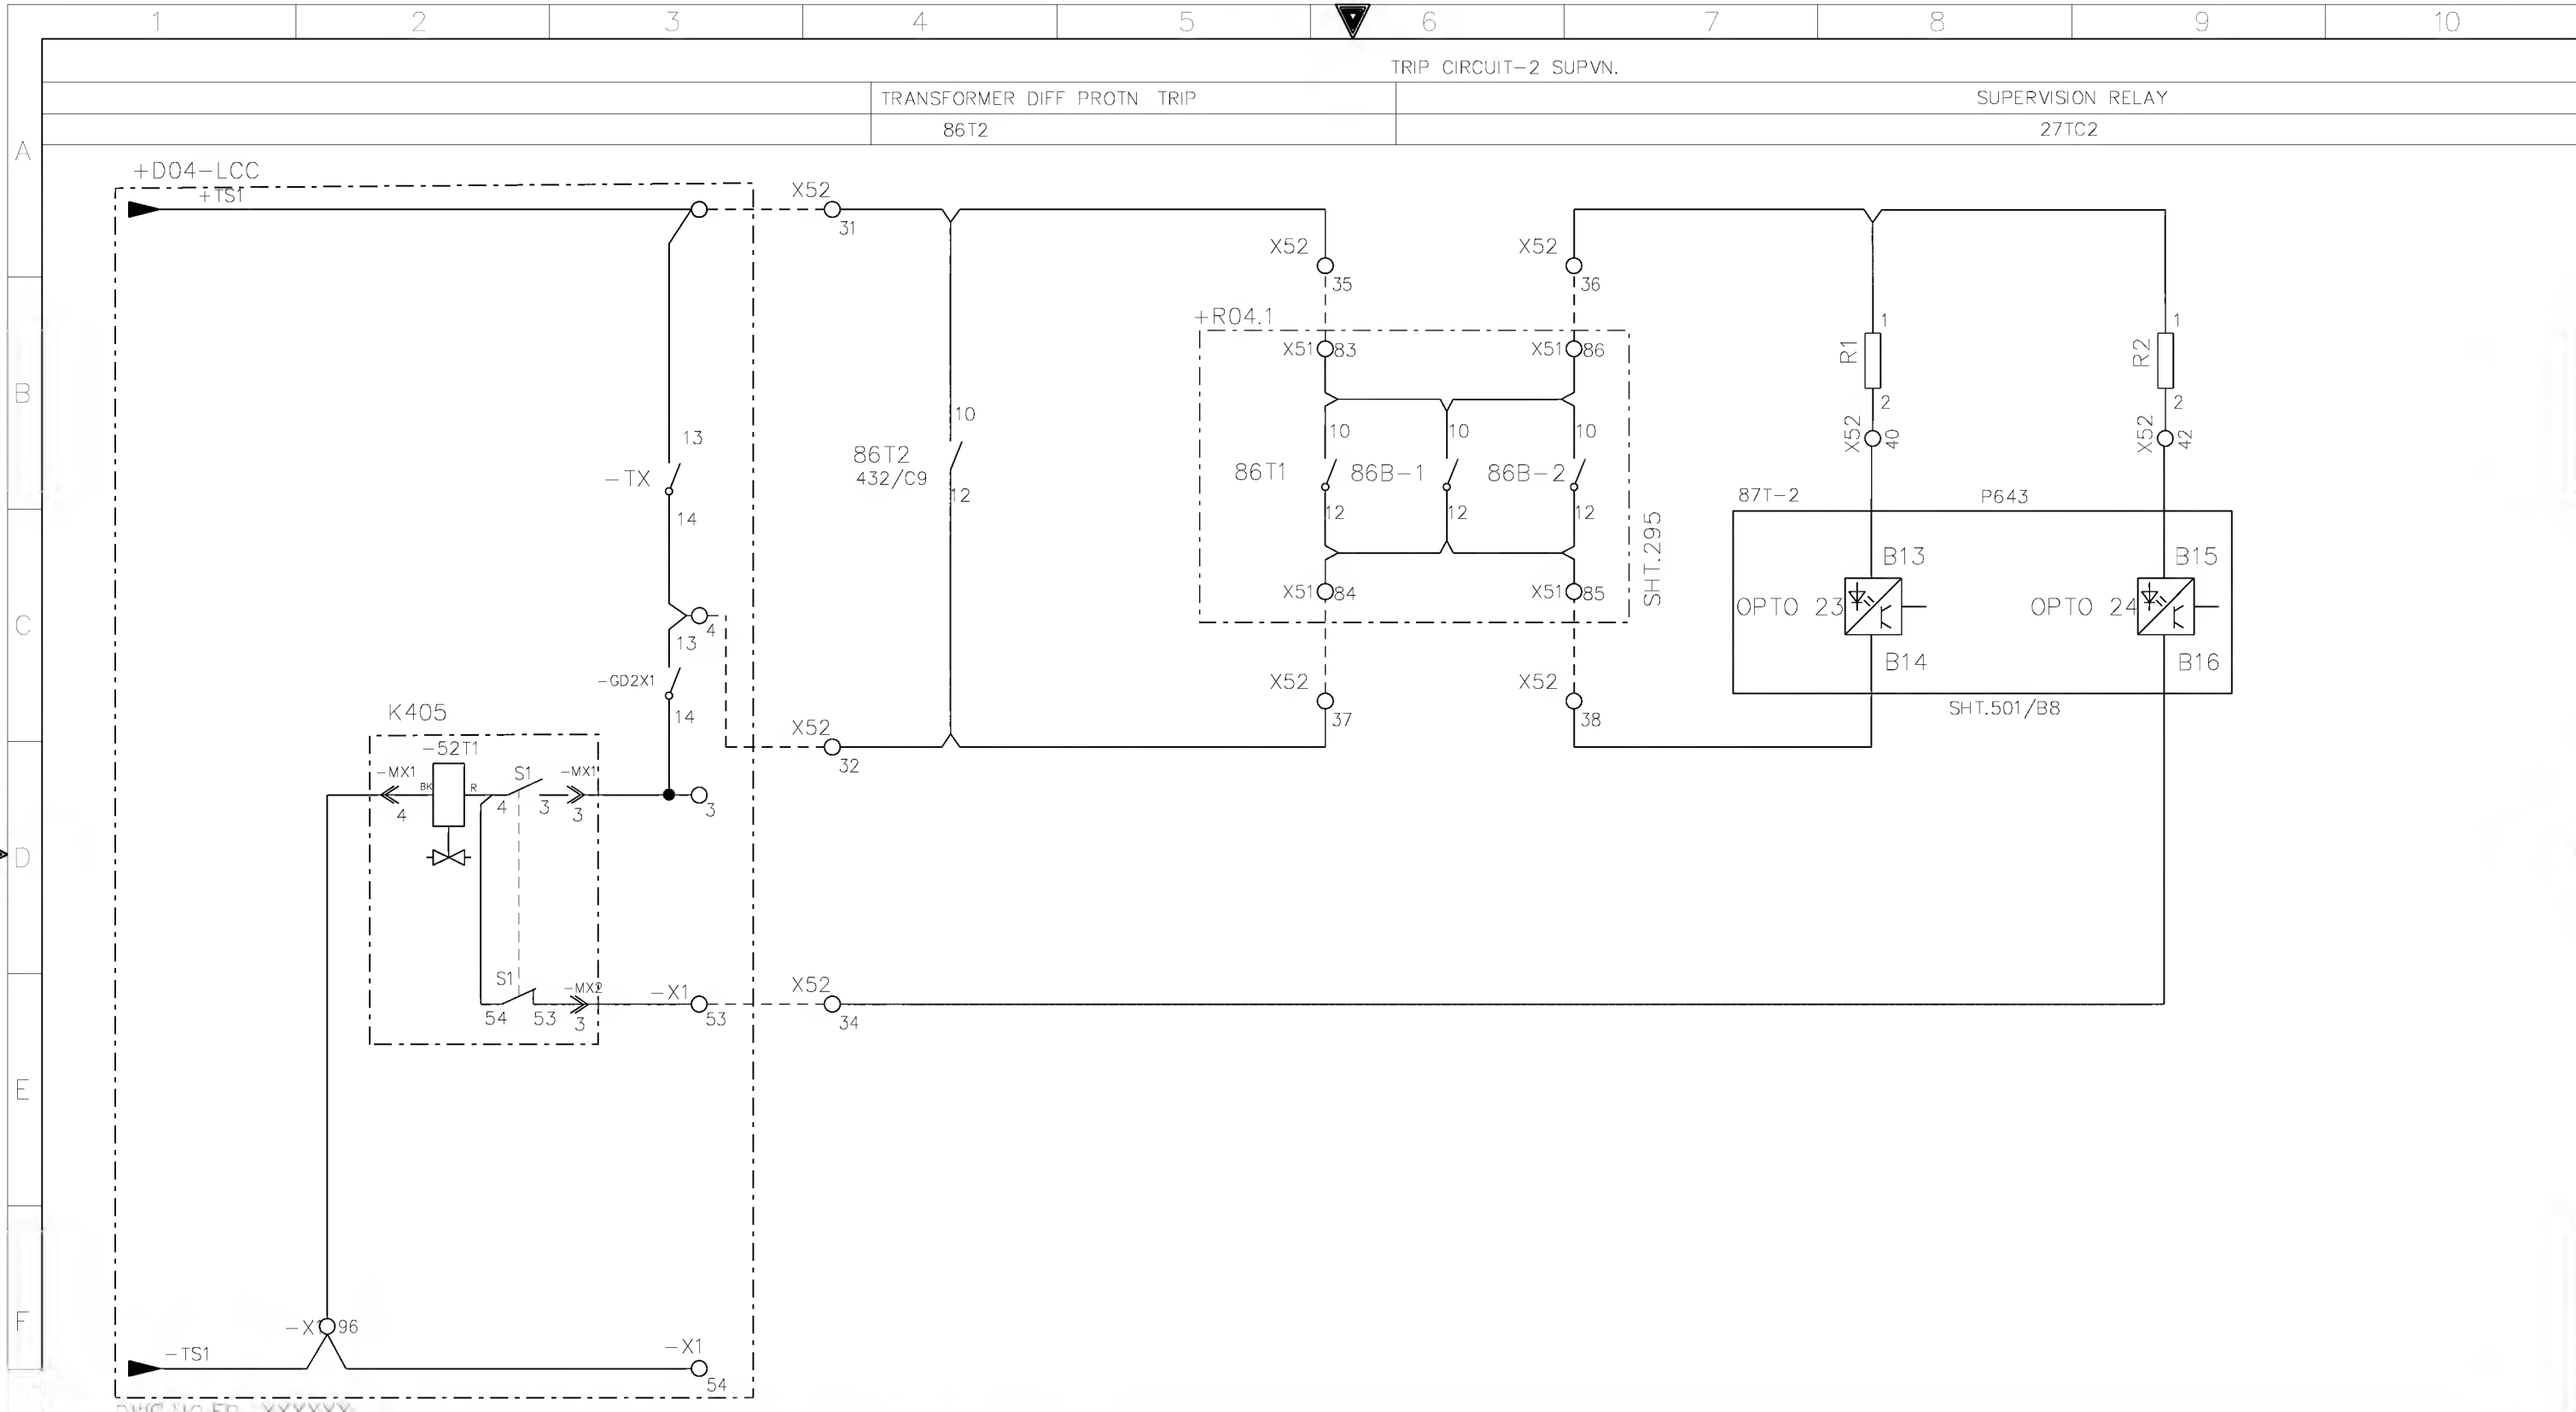

AS-BUILT BY _____ DATE _____			CONTRACT NO. 11131113/00		JOB ORDER NO. S-13656	
01	13 49	FACTORY ASBUILT	DRAWN BY RIZ		CHECKED BY JKR	
00	13 04	FOR APPROVAL	DATE STARTED 24.01.2013		DATE COMPLETED _____	
REV. NO.	DATE	DESCRIPTION	OPRG. DEPT. CTPD		ENG. DEPT. AUT-PSAC	

CB K305 TRIP CIRCUIT-2 SUPERVISION CIRCUIT	
132/13.8kV GT-3 RELAY PANEL-2 +R04.2	
S/S 8709-132/13.8KV IN AL-KHARJ CITY	
RIYADH SAUDI ARABIA	

الشركة الوطنية لنقل الكهرباء				نقل الكهرباء	
				National Grid sa	
INDEX	PLANT NO.	DRAWING NUMBER		SHEET NO.	
-	C421	CD322934		SHT	CONT.
				491	492
				01	

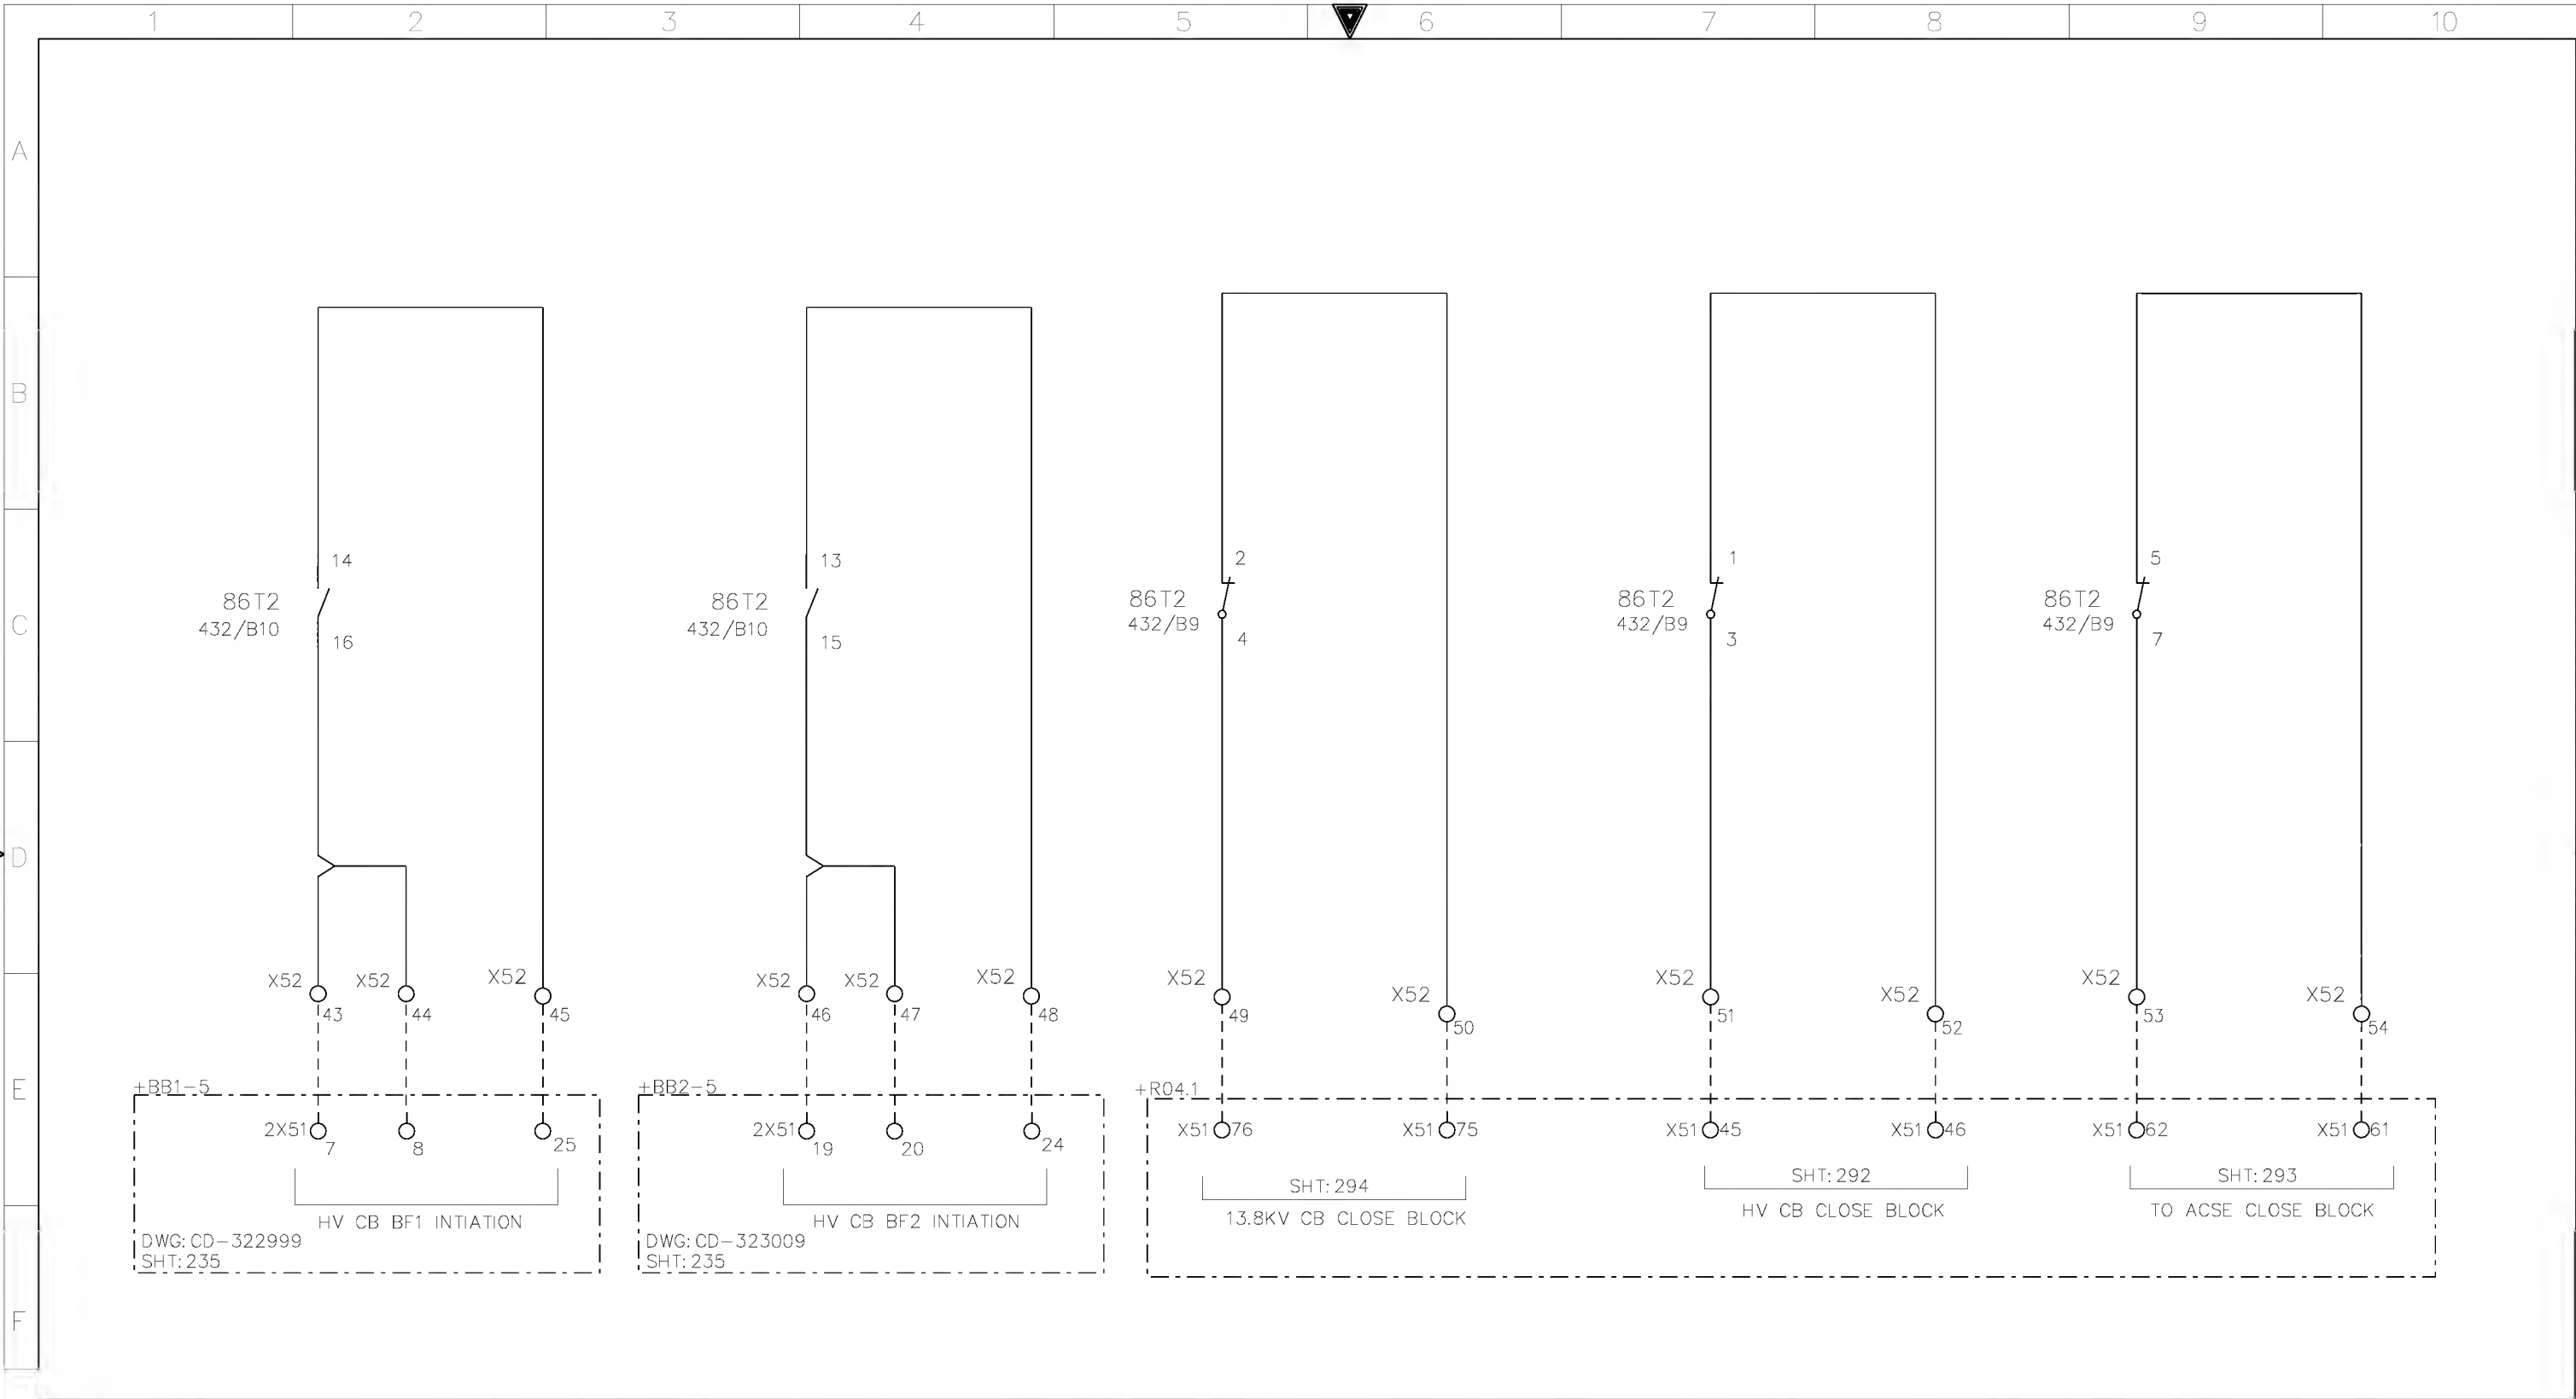

AS-BUILT BY _____ DATE _____			CONTRACT NO. 11131113/00		JOB ORDER NO. S-13656		BF INI & CLOSE BLOCK CIRCUIT		<div>الشركة الوطنية لنقل الكهرباء</div> <div>National Grid sa</div>								
			DRAWN BY RIZ		CHECKED BY JKR		132/13.8kV GT-3 RELAY PANEL-2 +R04.2										
01 13 49			FACTORY ASBUILT		DATE STARTED 24.01.2013		DATE COMPLETED _____		S/S 8709-132/13.8KV IN AL-KHARJ CITY		INDEX	PLANT NO.	DRAWING NUMBER		SHEET NO.		REV. NO.
00 13 04			FOR APPROVAL		OPRG. DEPT. CTPD		ENG. DEPT. AUT-PSAC		RIYADH SAUDI ARABIA		-	C421	CD322934		SHT 492 CONT. 493		01
REV. NO.			DATE		DESCRIPTION												

A


B

C

D

E


F

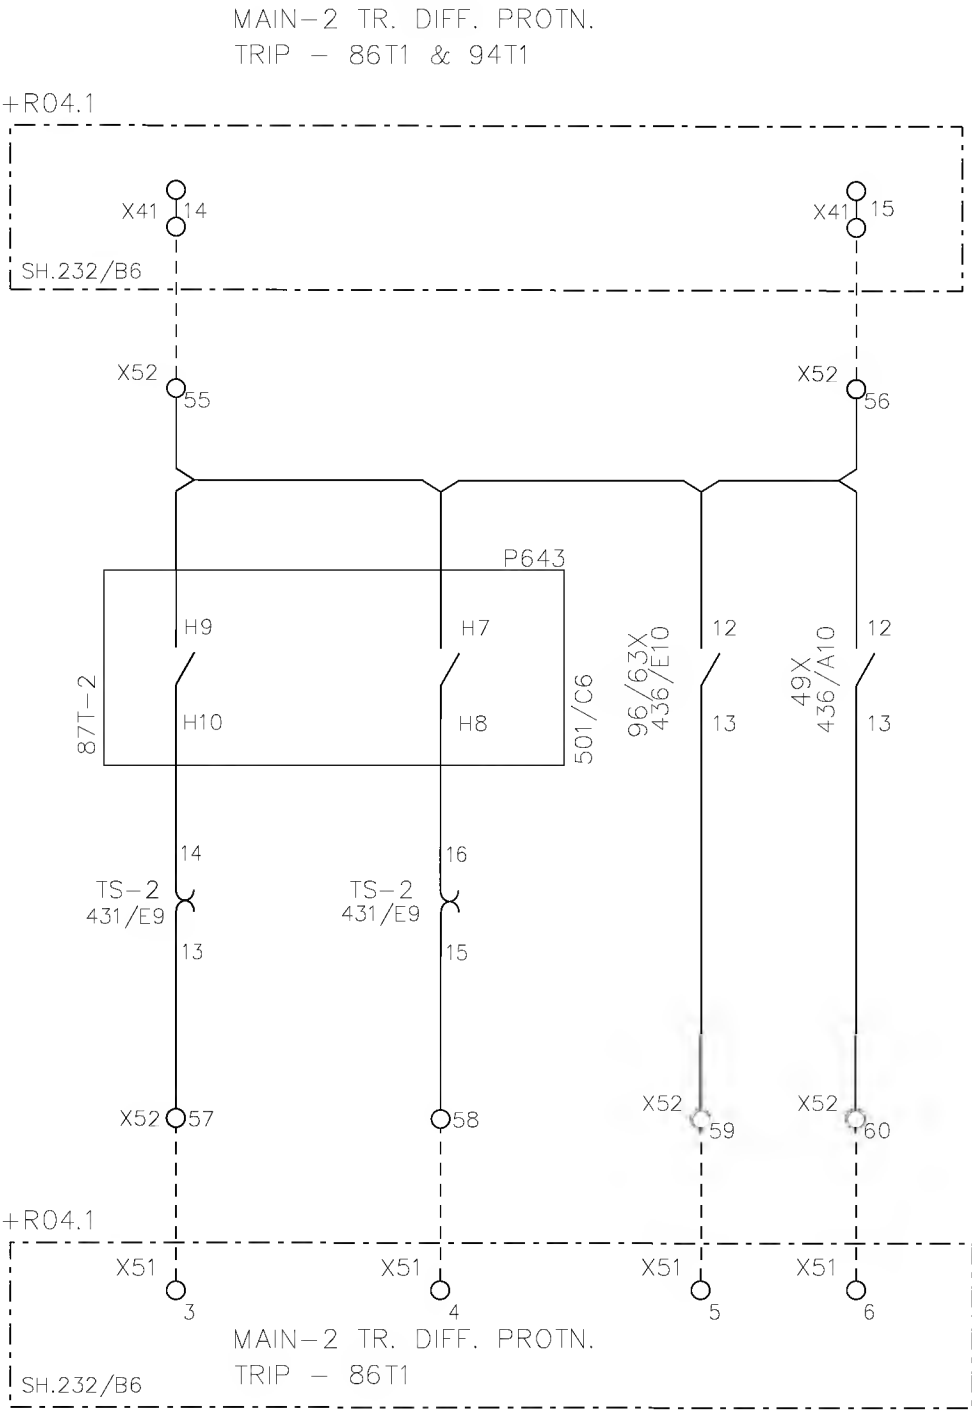


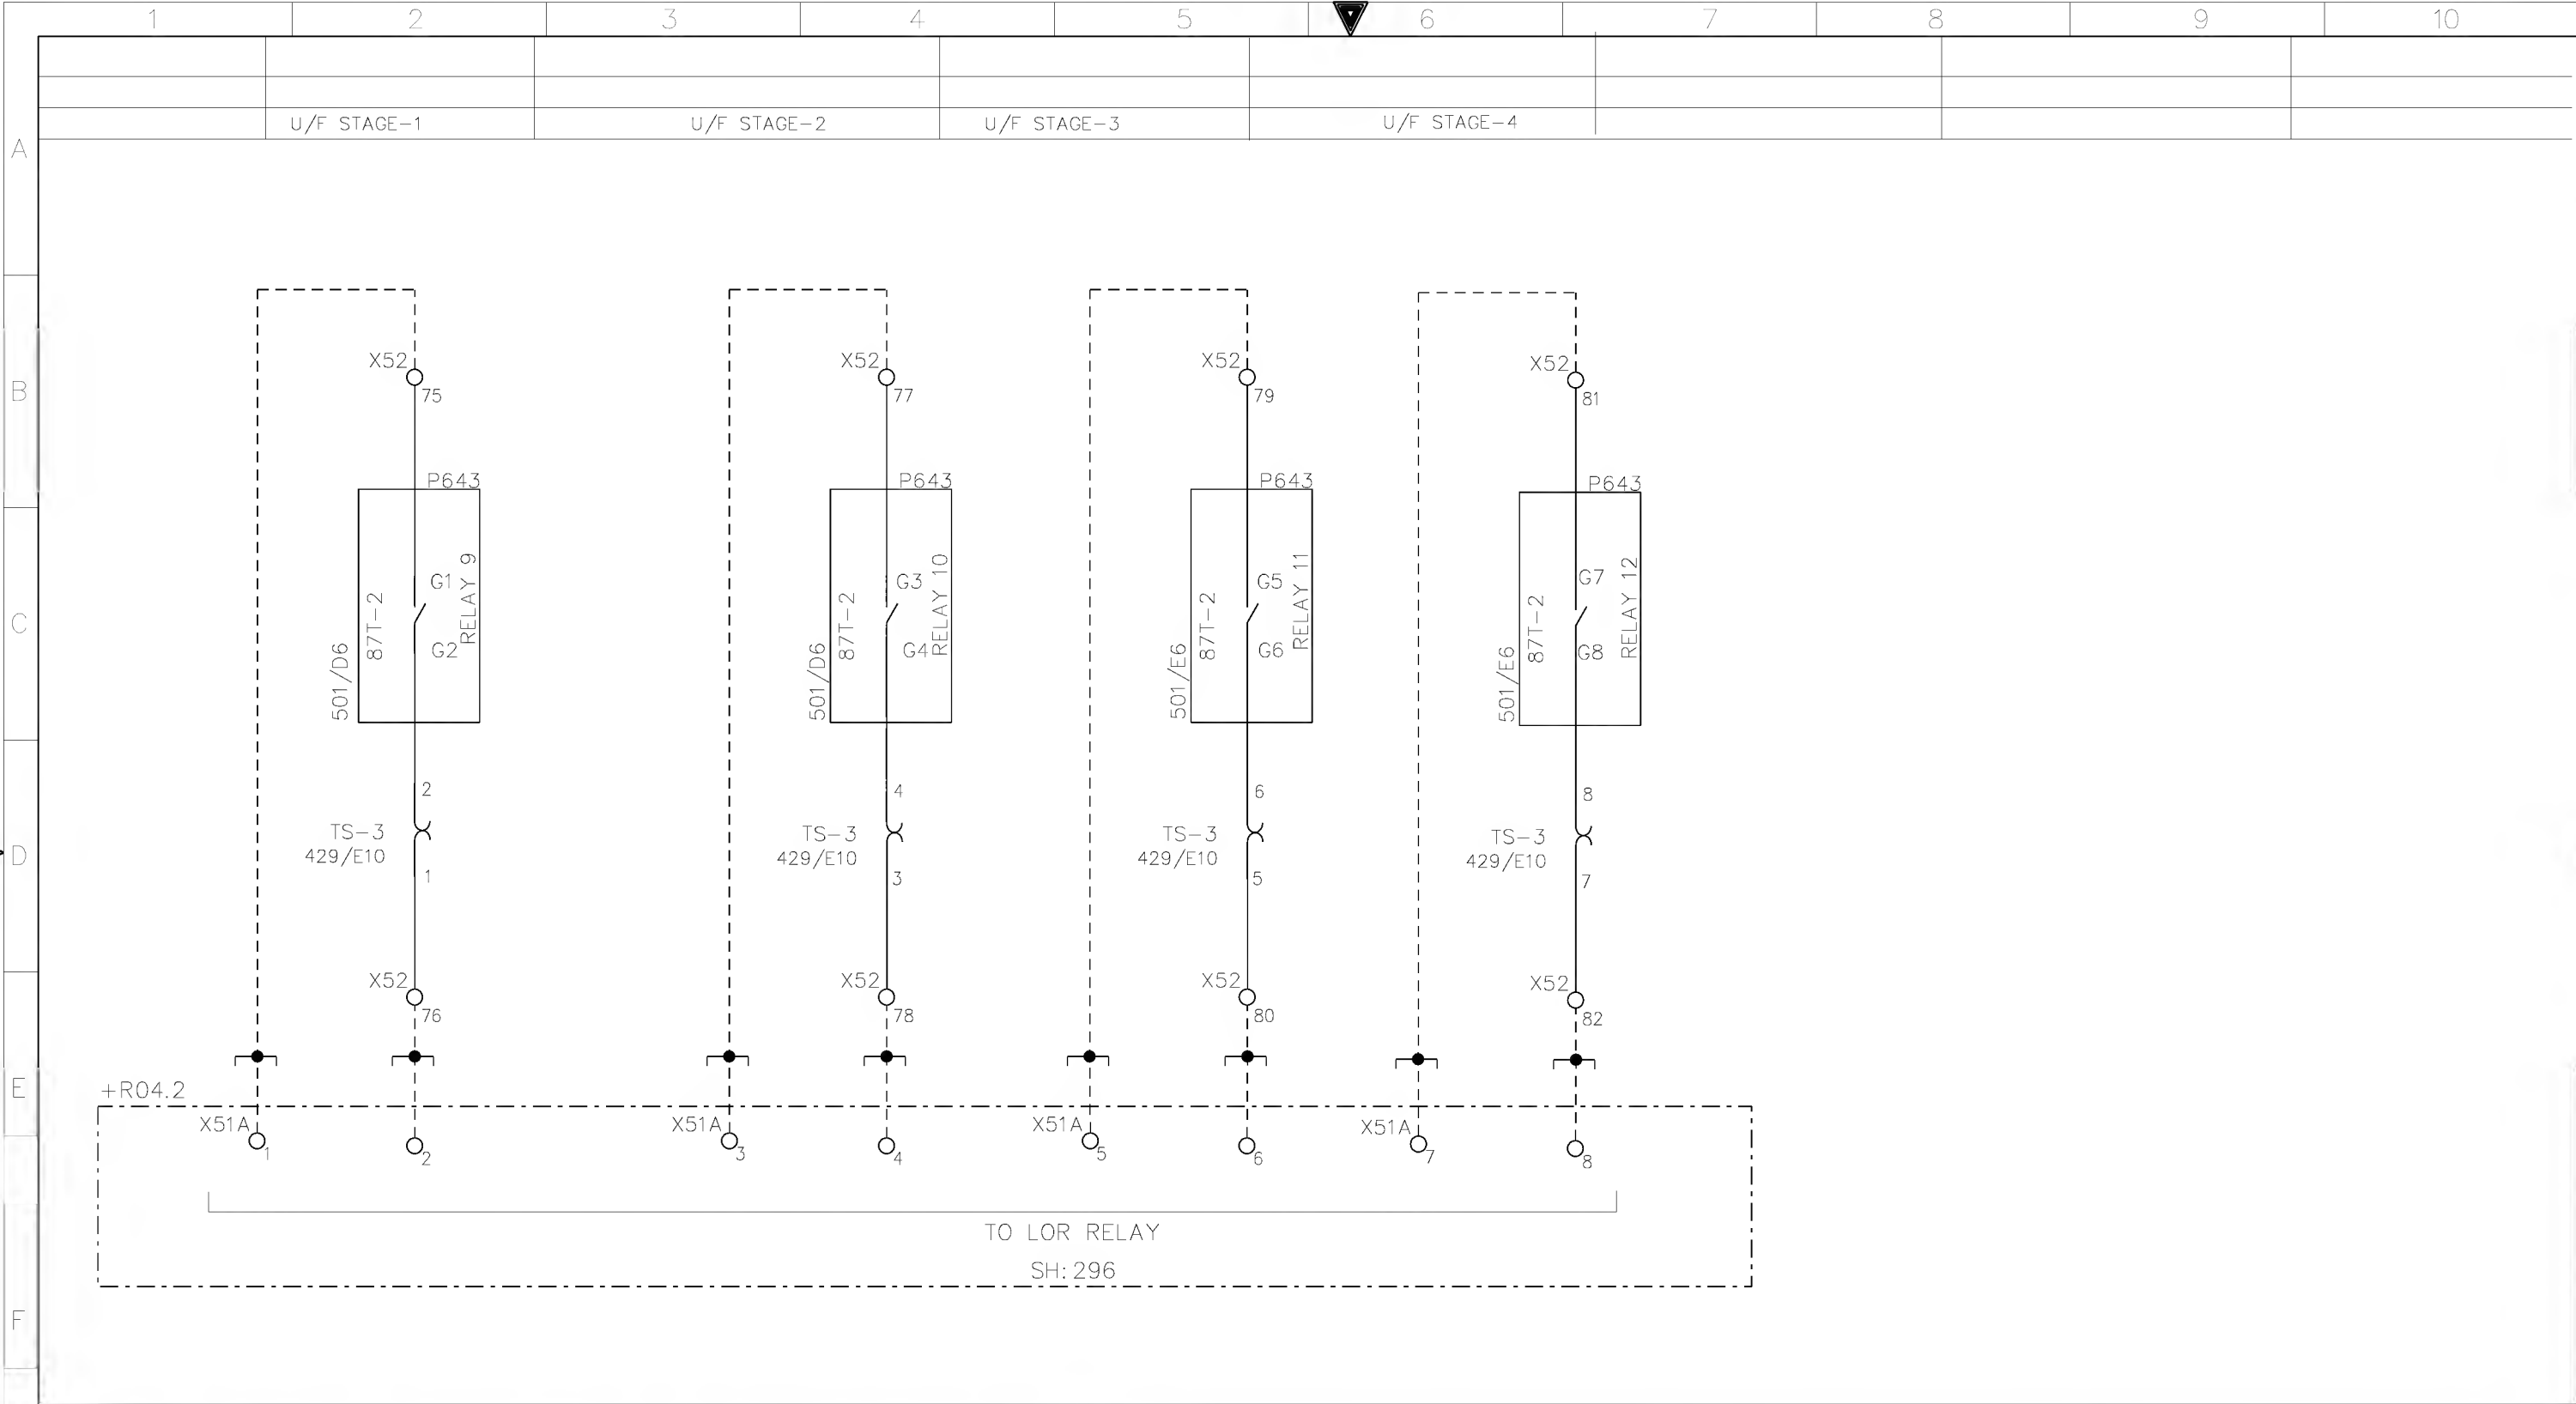
+R04.2

G

AS-BUILT BY _____ DATE _____			CONTRACT NO. 11131113/00		JOB ORDER NO. S-13656		TRANSFORMER MECHANICAL PROTN.		الشركة الوطنية لنقل الكهرباء National Grid sa													
			DRAWN BY _____ RIZ _____ CHECKED BY _____ JKR				132/13.8kV GT-3 RELAY PANEL-2 +R04.2															
01 13 49 FACTORY ASBUILT			DATE STARTED 24.01.2013		DATE COMPLETED _____		S/S 8709-132/13.8KV IN AL-KHARJ CITY		INDEX		PLANT NO.		DRAWING NUMBER		SHEET NO.		REV. NO.					
00 13 04 FOR APPROVAL																						
REV. NO.			DATE		DESCRIPTION		OPRG. DEPT. _____ CTPD _____ ENG. DEPT. _____ AUT-PSAC		RIYADH		SAUDI ARABIA		-		C421		CD322934		SHT 493 CONT. 494		01	

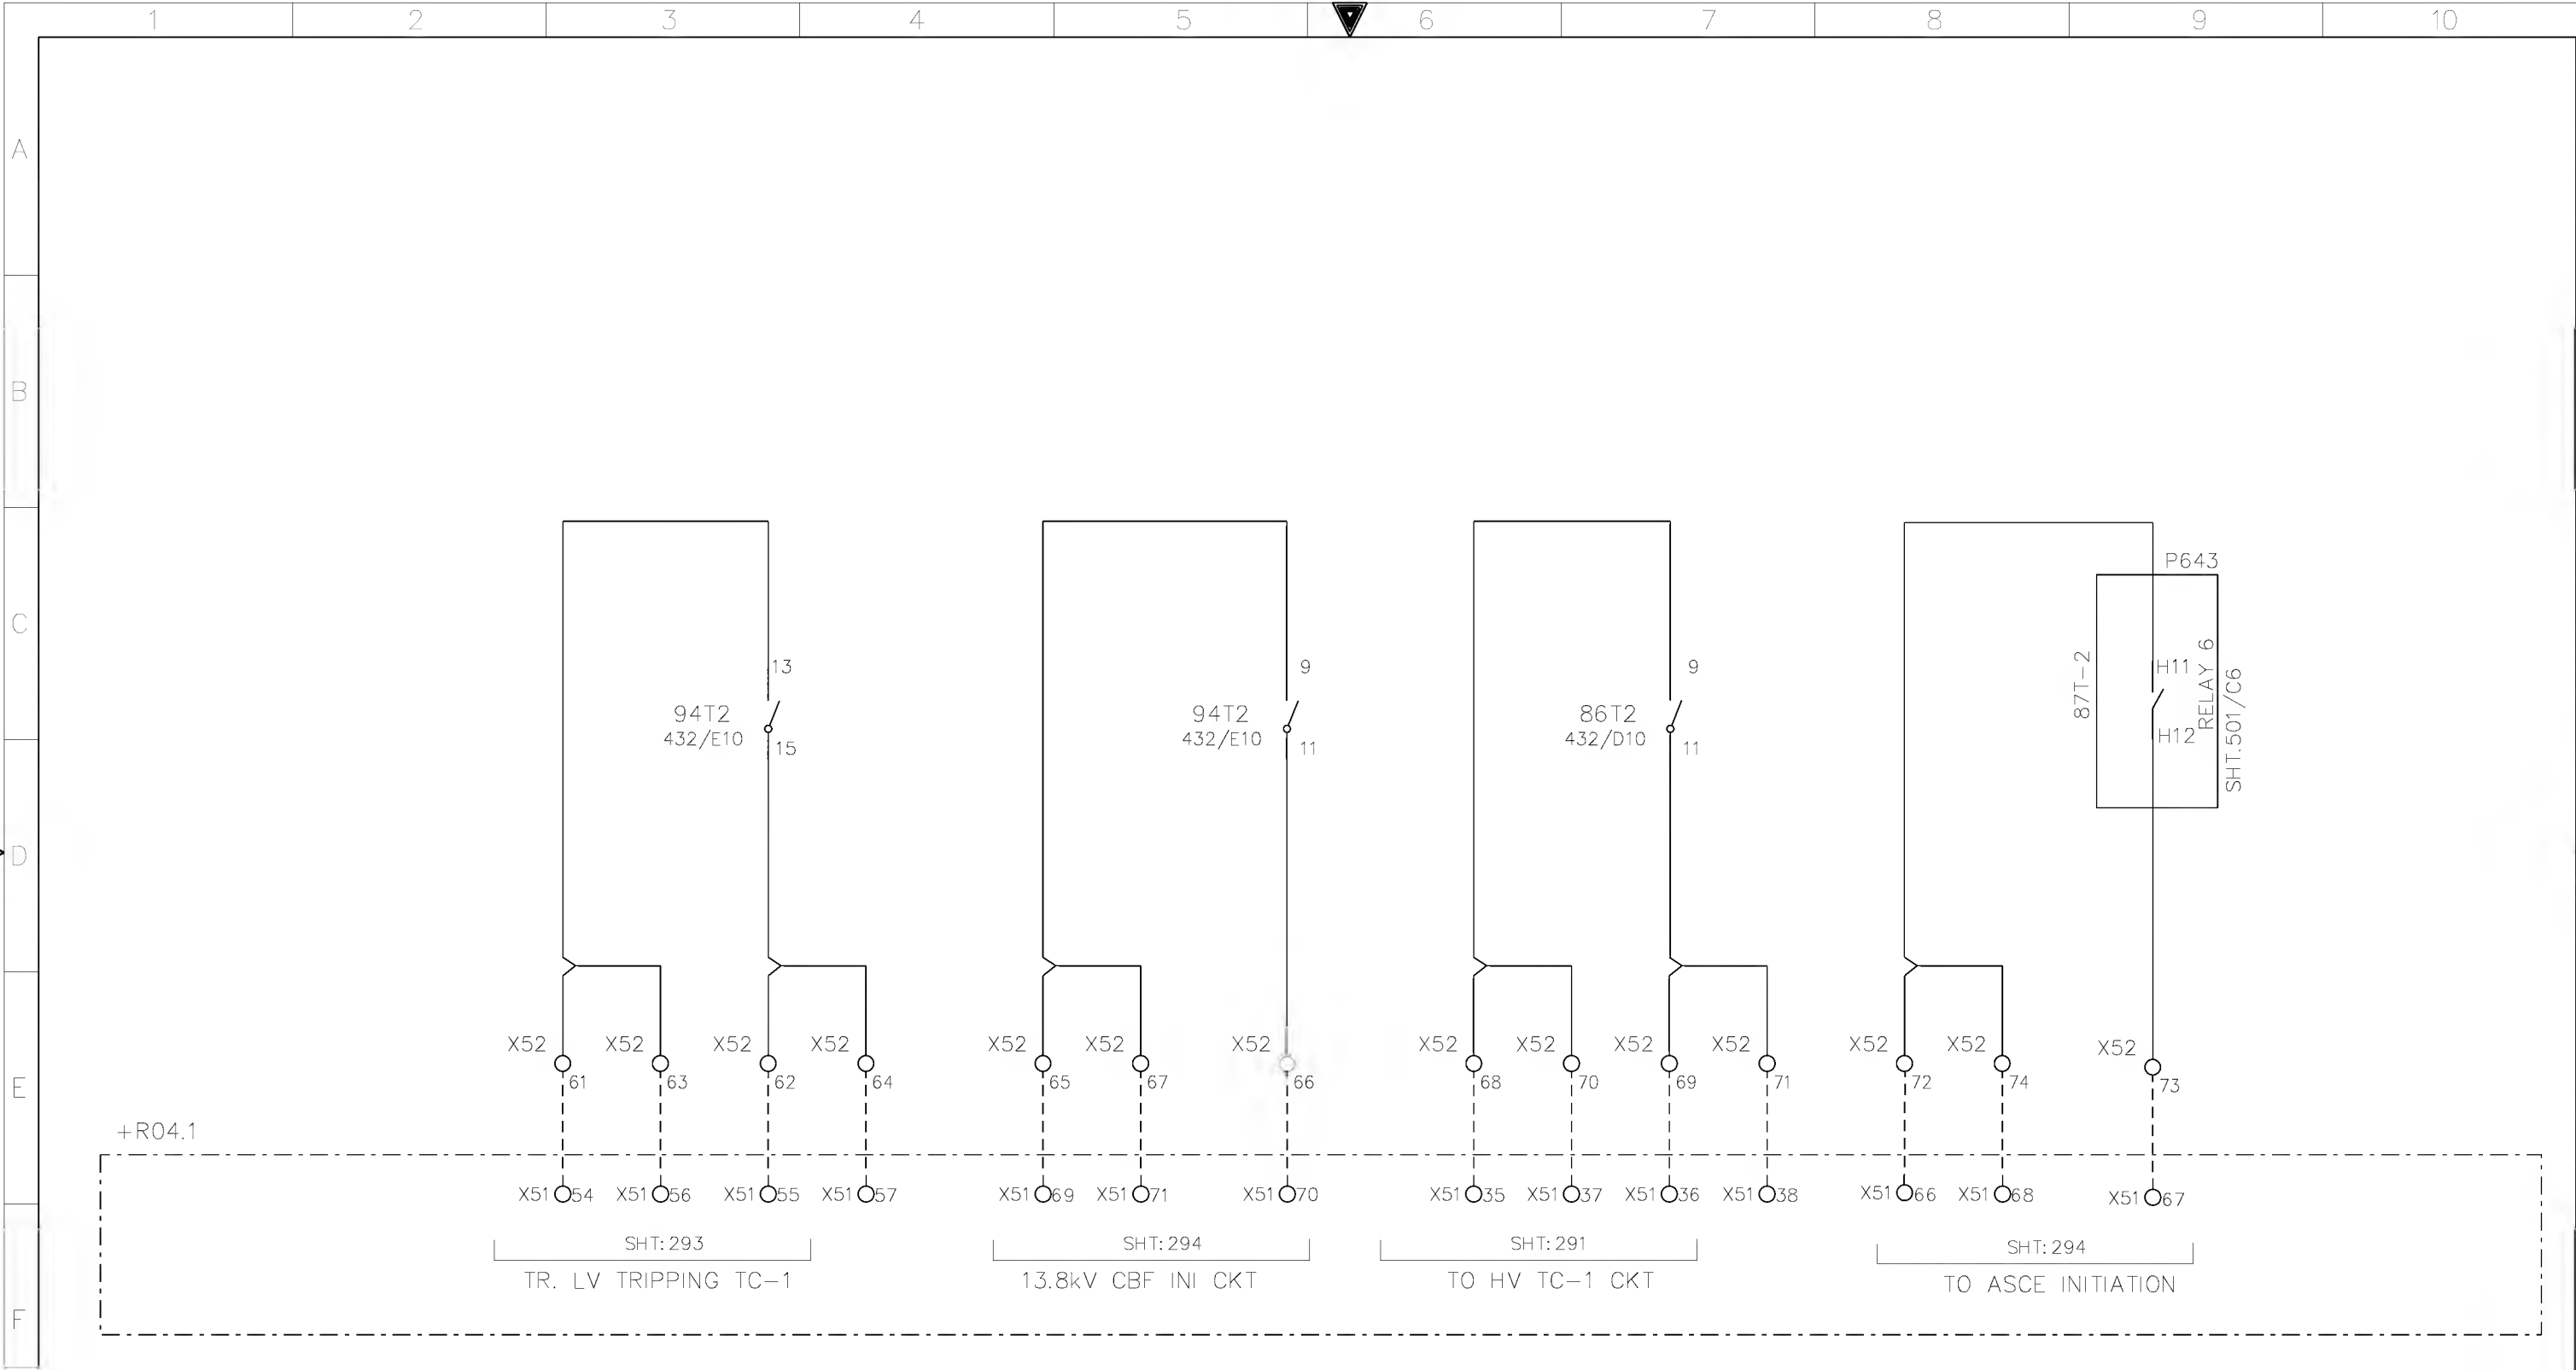

G	AS-BUILT BY _____ DATE _____		CONTRACT NO. 11131113/00		JOB ORDER NO. S-13656		CONTACTS FOR TRIP AND CLOSE BLOCK			الشركة الوطنية لنقل الكهرباء					 نقل الكهرباء						
							132/13.8kV GT-3 RELAY PANEL-2 +R04.2			National Grid sa											
	01 13 49		FACTORY ASBUILT		DRAWN BY RIZ CHECKED BY JKR		S/S 8709-132/13.8KV IN AL-KHARJ CITY			INDEX		PLANT NO.		DRAWING NUMBER		SHEET NO.		REV. NO.			
	00 13 04		FOR APPROVAL		DATE STARTED 24.01.2013 DATE COMPLETED		RIYADH SAUDI ARABIA			-		C421		CD322934		SHT 494		CONT. 496		01	
	REV. NO.		DATE		DESCRIPTION		OPRG. DEPT. CTPD		ENG. DEPT. AUT-PSAC												



AS-BUILT BY _____ DATE _____ CONTRACT NO. 11131113/00 JOB ORDER NO. S-13656

01	13 49	FACTORY ASBUILT	DRAWN BY RIZ	CHECKED BY JKR
00	13 04	FOR APPROVAL	DATE STARTED 24.01.2013	DATE COMPLETED
REV. NO.	DATE	DESCRIPTION	OPRG. DEPT. CTPD	ENG. DEPT. AUT-PSAC

CONTACTS FOR U/F LOAD SHEDDING

132/13.8kV GT-3 RELAY PANEL-2 +R04.2

S/S 8709-132/13.8KV IN AL-KHARJ CITY
RIYADH SAUDI ARABIA

الشركة الوطنية لنقل الكهرباء



نقل الكهرباء
National Grid sa


INDEX	PLANT NO.	DRAWING NUMBER	SHEET NO.	REV. NO.
-	C421	CD322934	SHT CONT.	01
			496	498


DMS

VECTOR


NG/D2-D (2012/01)

NGD200

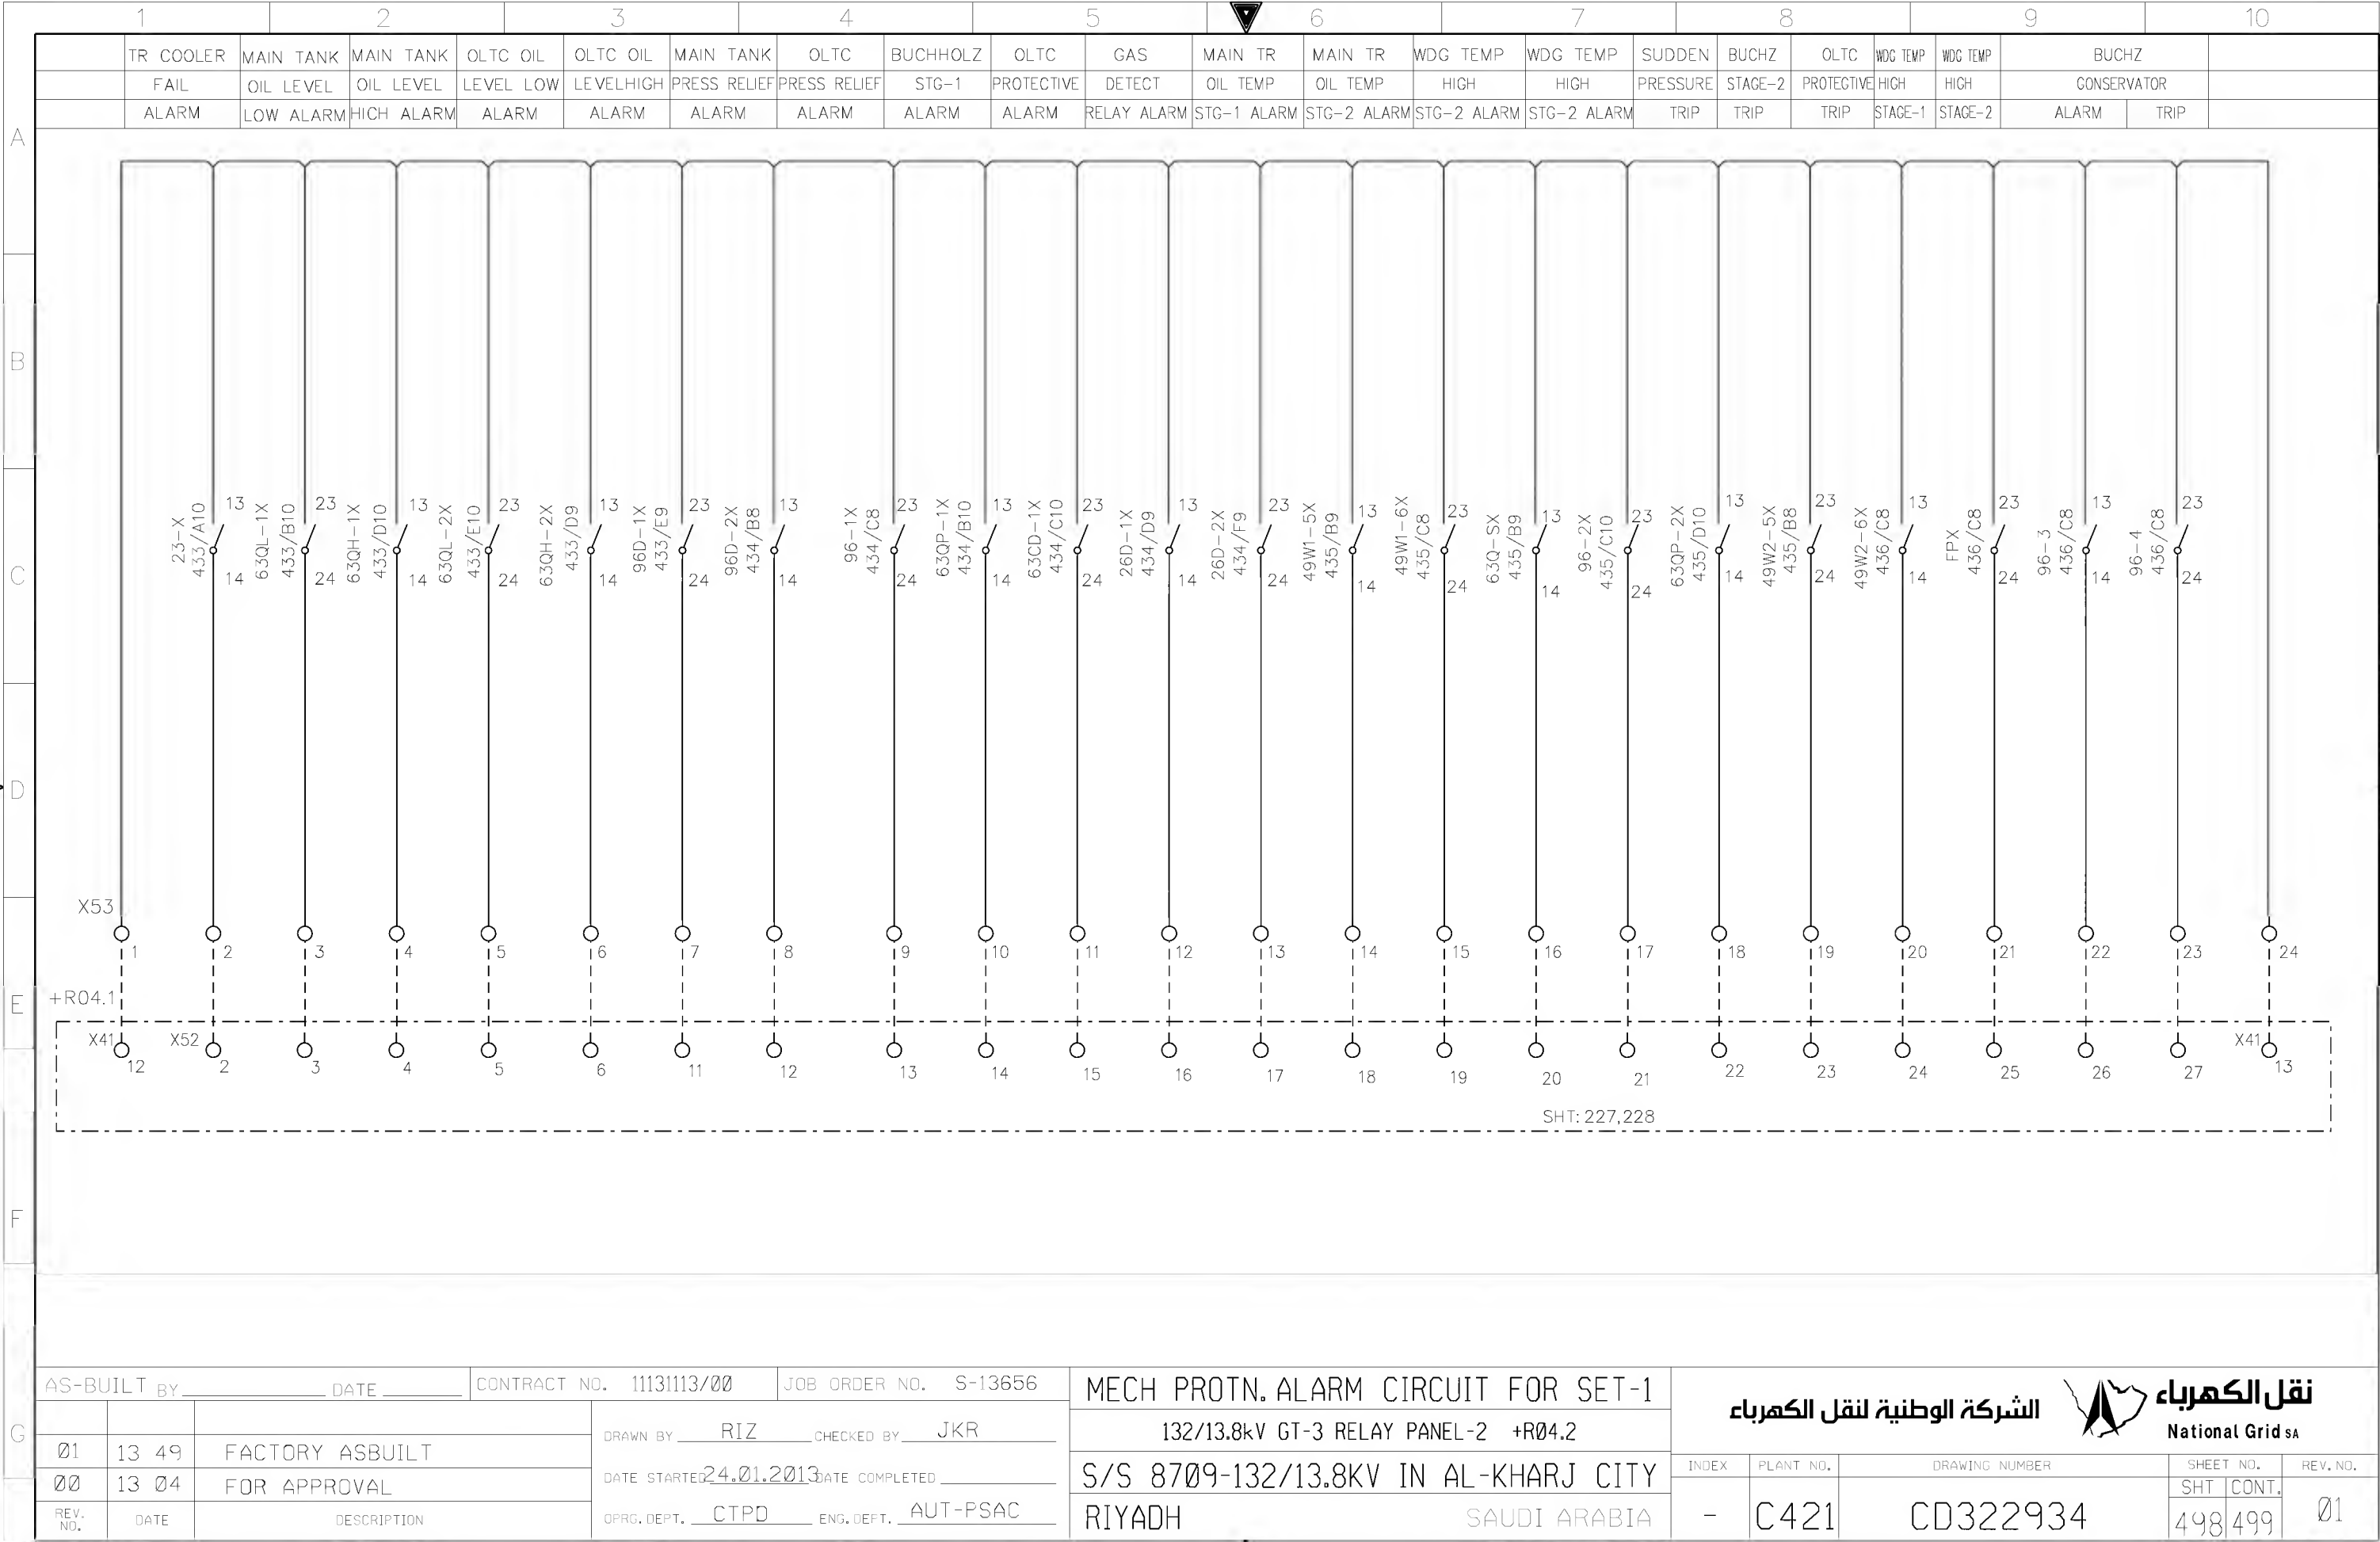


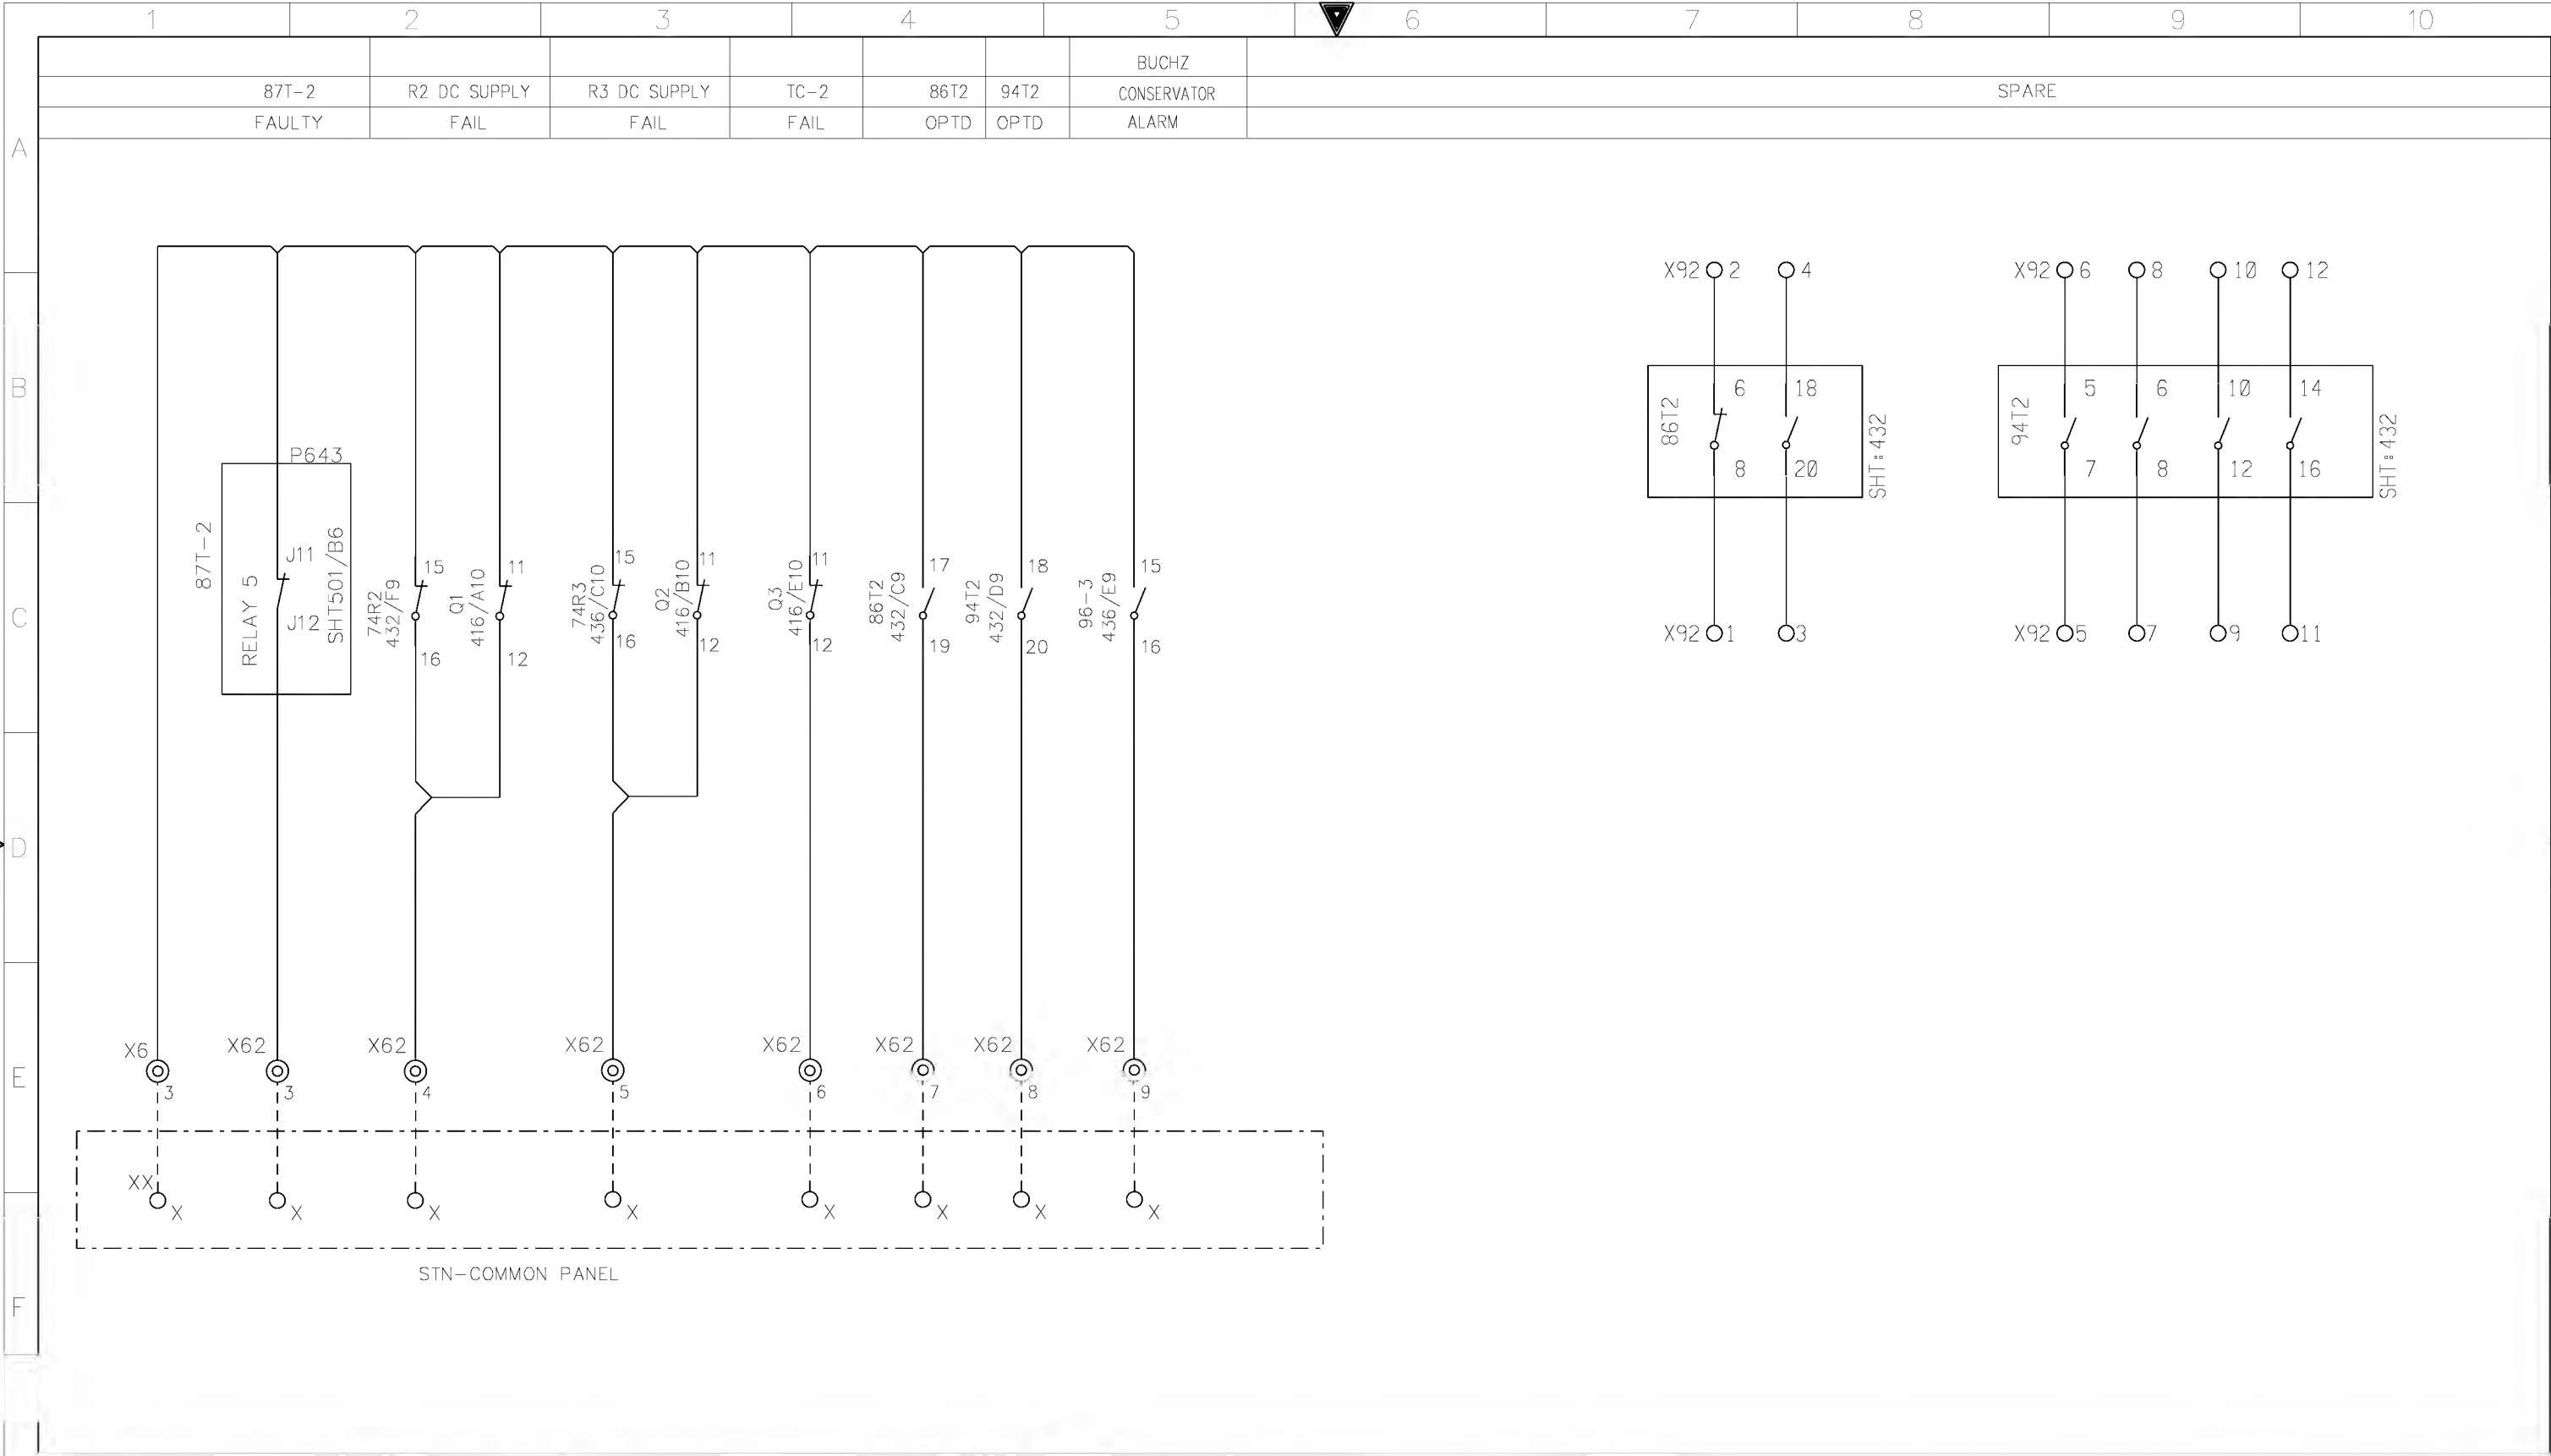


G	AS-BUILT BY _____ DATE _____		CONTRACT NO. 11131113/00		JOB ORDER NO. S-13656		STN COMMON ALARM CIRCUIT		<div>نقل الكهرباء</div> <div>الشركة الوطنية لنقل الكهرباء</div> <div>National Grid sa</div>						
					DRAWN BY RIZ CHECKED BY JKR		132/13.8kV GT-3 RELAY PANEL-2 +R04.2								
	01	13 49	FACTORY ASBUILT		DATE STARTED 24.01.2013 DATE COMPLETED _____		S/S 8709-132/13.8KV IN AL-KHARJ CITY		INDEX	PLANT NO.	DRAWING NUMBER		SHEET NO.		REV. NO.
	00	13 04	FOR APPROVAL		OPRG. DEPT. CTPC ENG. DEPT. AUT-PSAC		RIYADH SAUDI ARABIA		-	C421	CD322934		SHT	CONT.	01
	REV. NO.	DATE	DESCRIPTION										499	501	

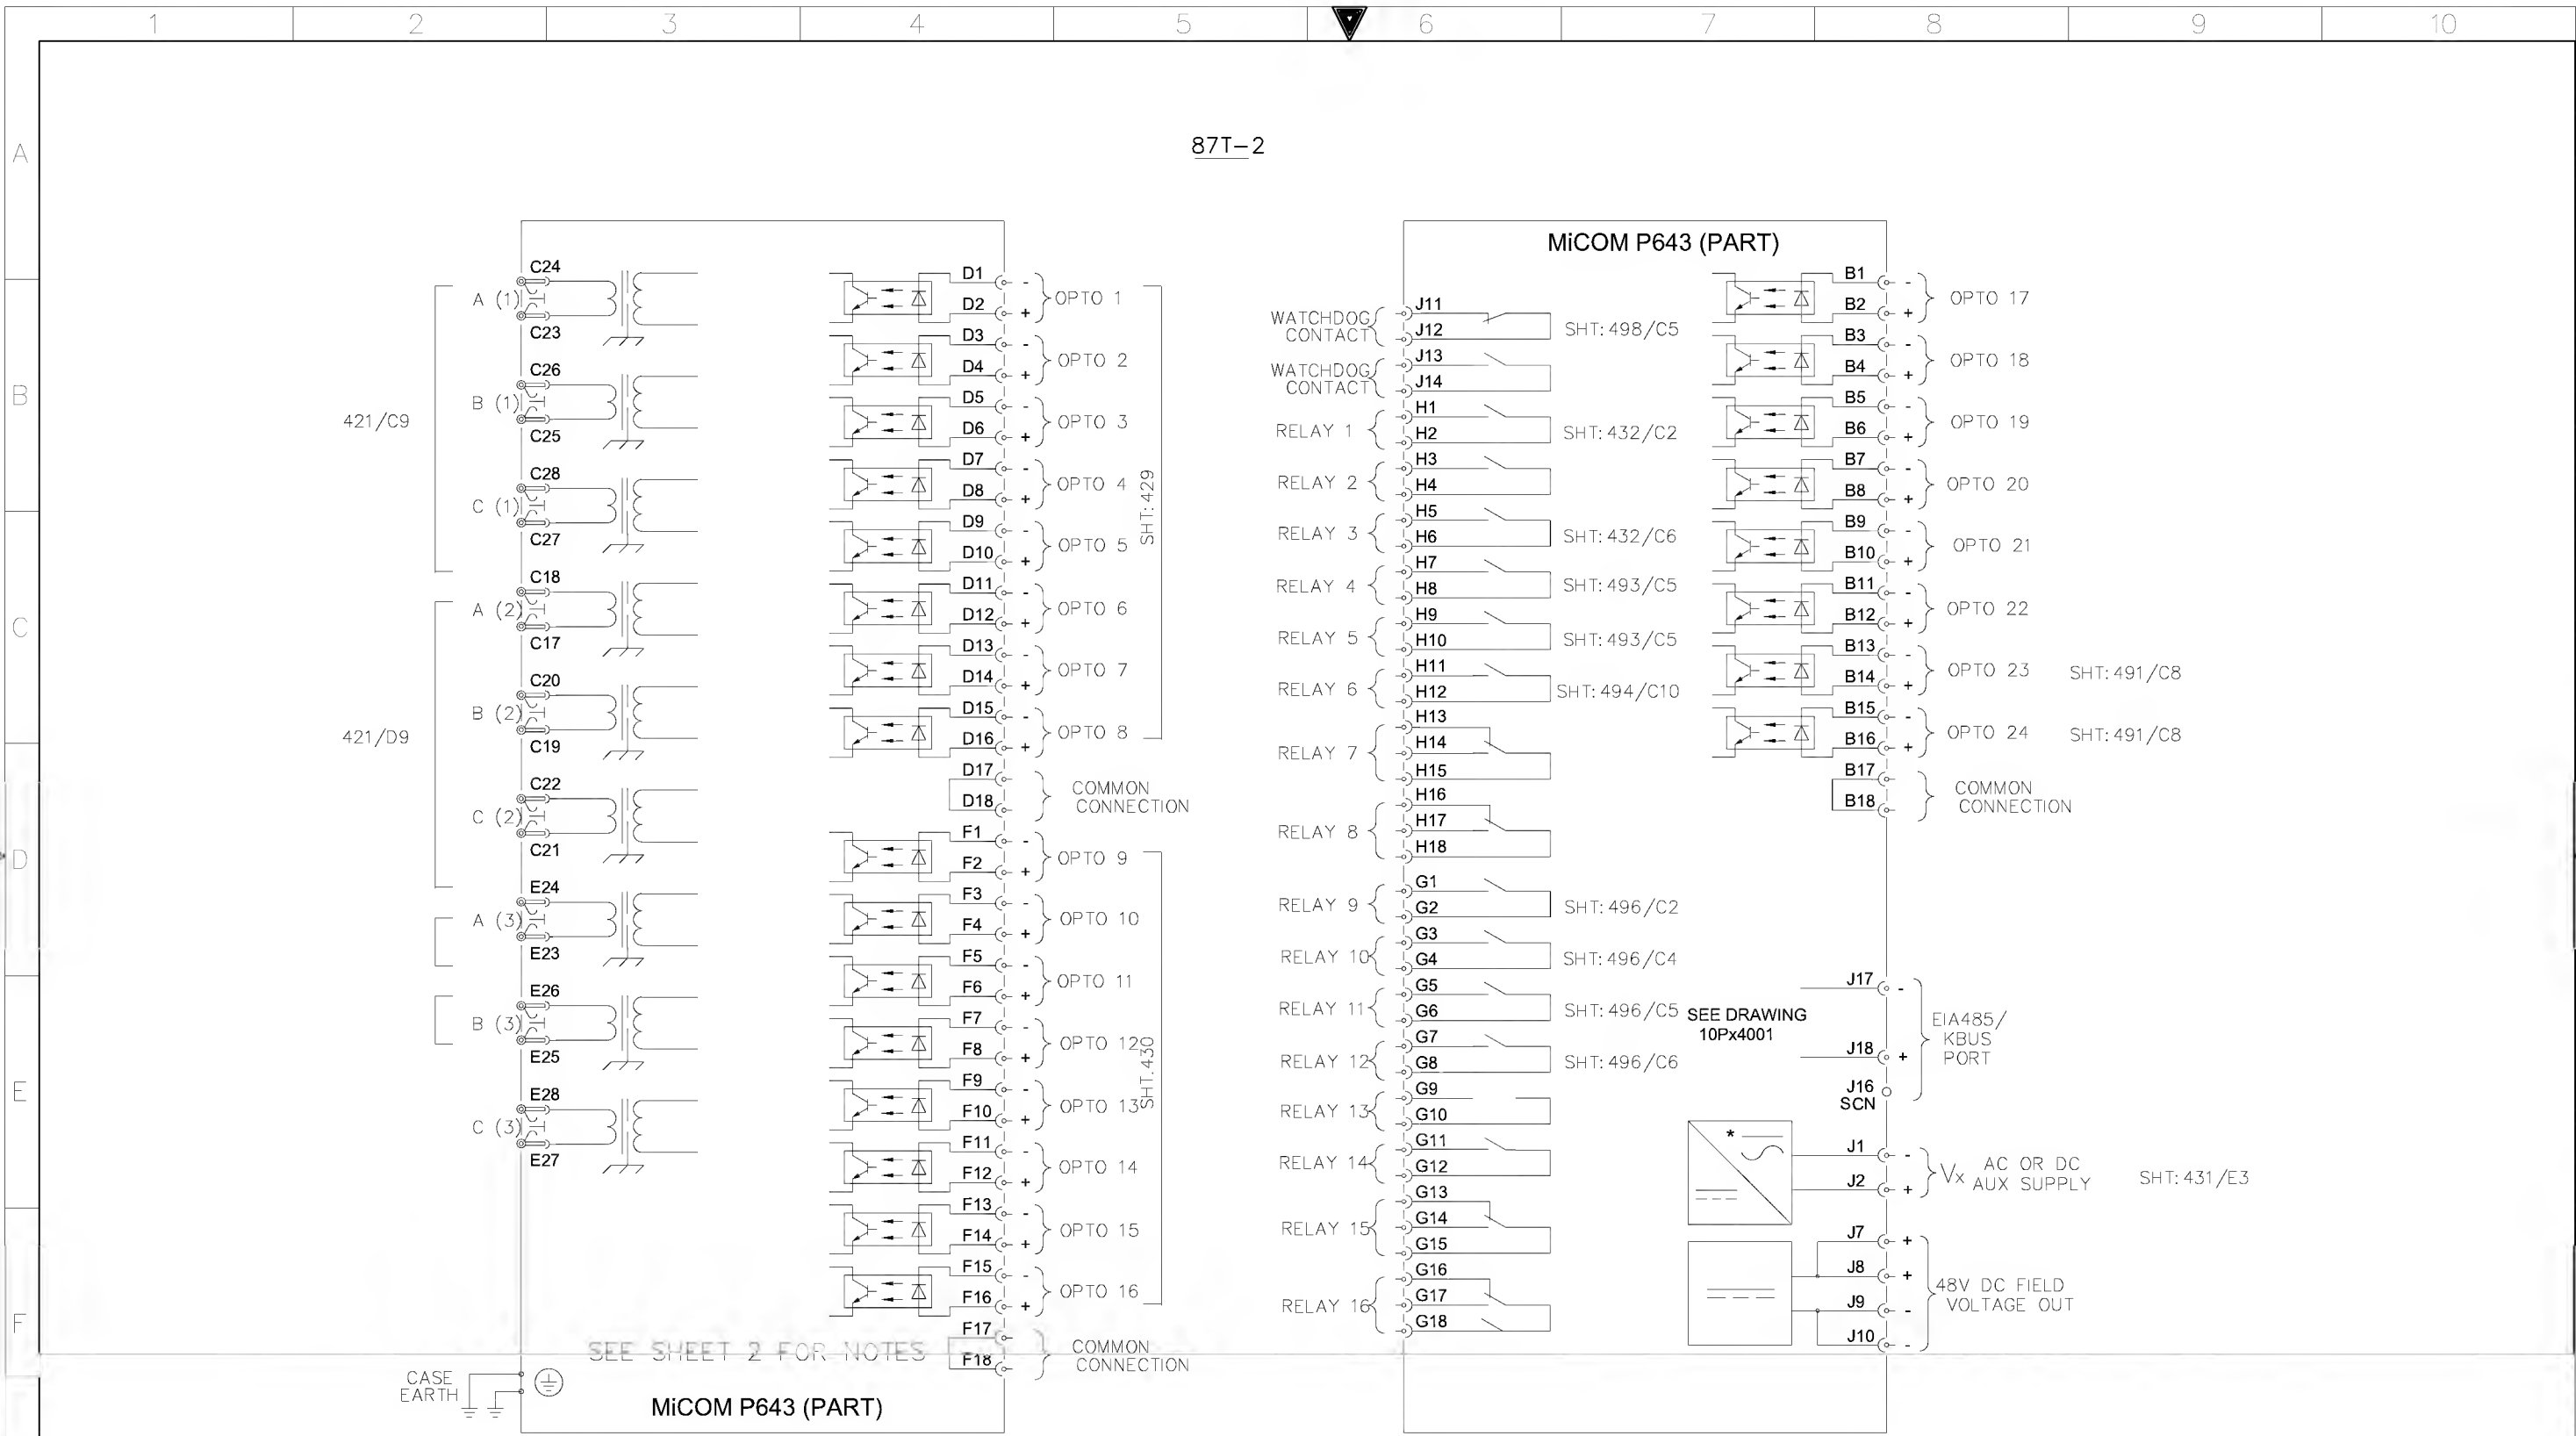

AS-BUILT BY _____ DATE _____			CONTRACT NO. 11131113/00		JOB ORDER NO. S-13656		BLOCK REFERENCE		الشركة الوطنية لنقل الكهرباء		نقل الكهرباء	
DRAWN BY RIZ CHECKED BY JKR			DATE STARTED 24.01.2013		DATE COMPLETED _____		132/13.8kV GT-3 RELAY PANEL-2 +R04.2		National Grid sa			
S/S 8709-132/13.8KV IN AL-KHARJ CITY			SAUDI ARABIA		INDEX		PLANT NO. C421		DRAWING NUMBER CD322934		SHEET NO. 501	
REV. NO. 00			DATE 13 04		DESCRIPTION FOR APPROVAL		OPRG. DEPT. CTPD		ENG. DEPT. AUT-PSAC		CONT. 502	
											01	

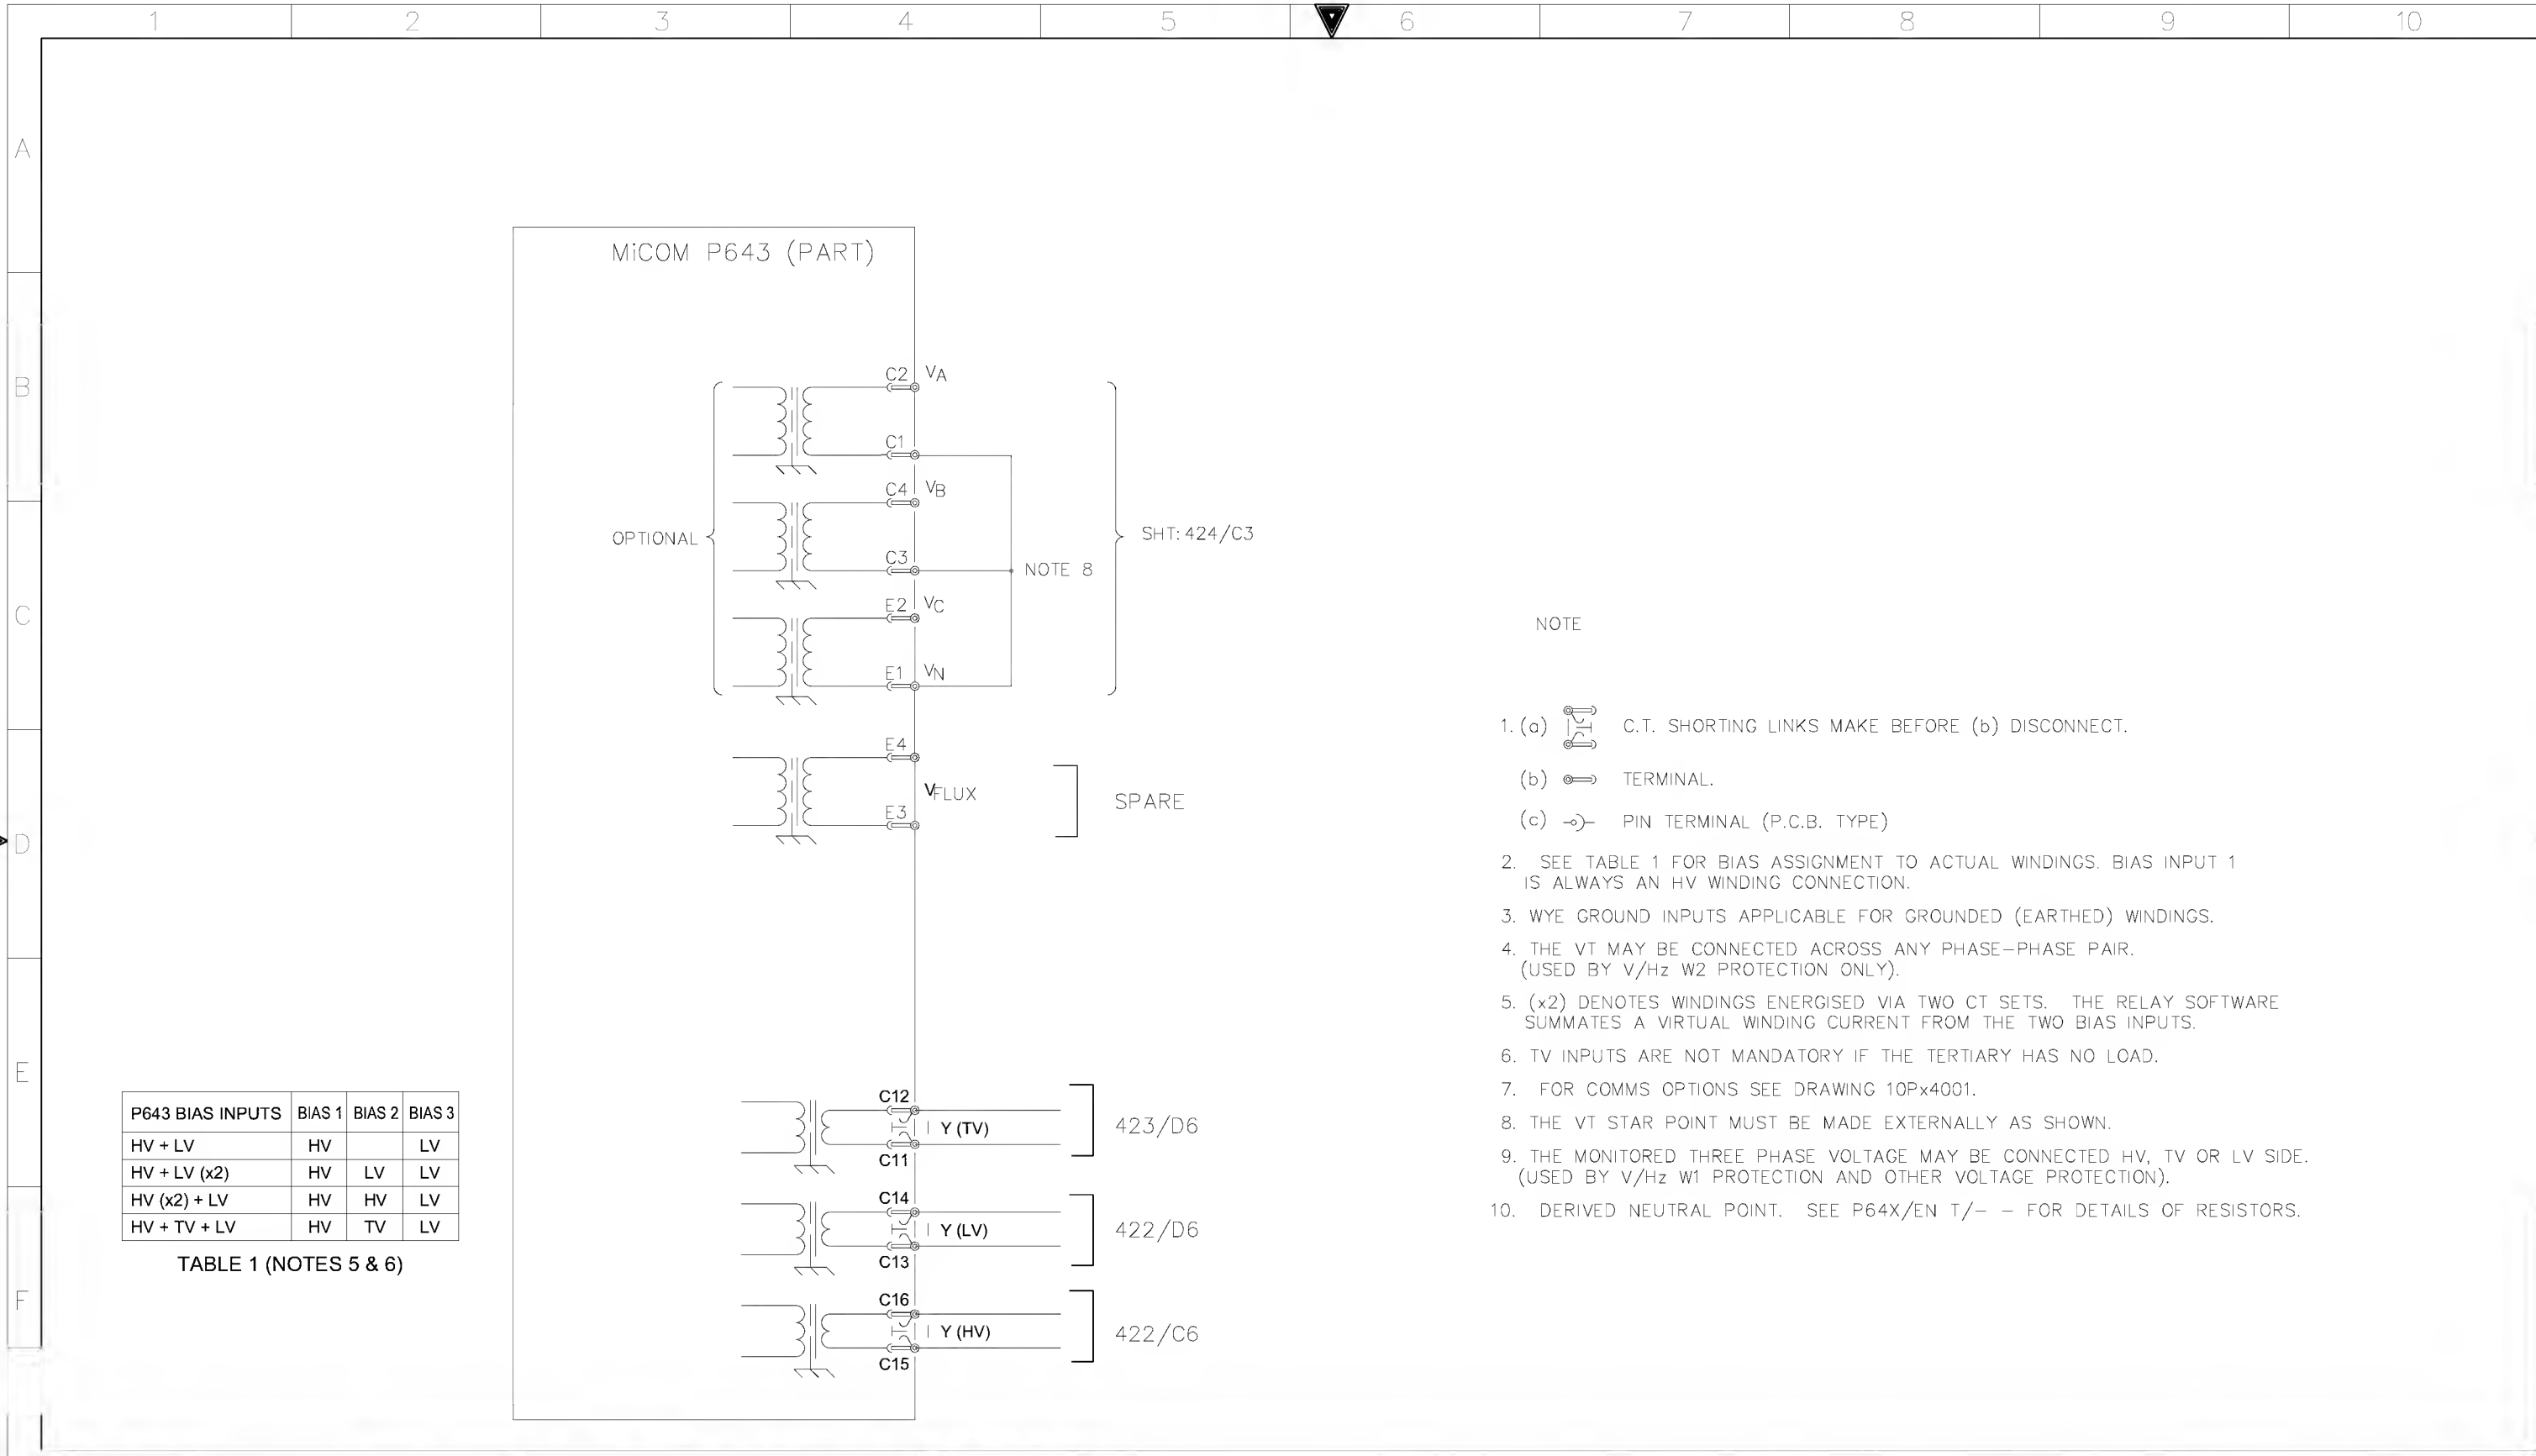

	1	2	3	4	5	6	7	8	9	10																																																																																																																																																																																																																																																																																																																																																																																																																													
A	<table><tr><td>REFERENCE</td><td>X3 AC CKT.</td></tr><tr><td>411/A3</td><td>1</td></tr><tr><td>411/A7</td><td>2</td></tr><tr><td>411/A3</td><td>3</td></tr><tr><td>411/A7</td><td>4</td></tr><tr><td>411/B3</td><td>5</td></tr><tr><td>411/B7</td><td>6</td></tr><tr><td>411/B3</td><td>7</td></tr><tr><td>411/B7</td><td>8</td></tr><tr><td>SPARE</td><td>9</td></tr><tr><td>SPARE</td><td>10</td></tr></table>	REFERENCE	X3 AC CKT.	411/A3	1	411/A7	2	411/A3	3	411/A7	4	411/B3	5	411/B7	6	411/B3	7	411/B7	8	SPARE	9	SPARE	10		<table><tr><td>REFERENCE</td><td>X1 CT CKTS.</td></tr><tr><td>421/B5</td><td>1</td></tr><tr><td>421/B5</td><td>2</td></tr><tr><td>421/B5</td><td>3</td></tr><tr><td>421/B5</td><td>4</td></tr><tr><td>421/B5</td><td>5</td></tr><tr><td>421/B5</td><td>6</td></tr><tr><td>421/C5</td><td>7</td></tr><tr><td>421/C5</td><td>8</td></tr><tr><td>421/C5</td><td>9</td></tr><tr><td>SPARE</td><td>10</td></tr><tr><td>421/E5</td><td>11</td></tr><tr><td>421/E5</td><td>12</td></tr><tr><td>421/E5</td><td>13</td></tr><tr><td>421/E5</td><td>14</td></tr><tr><td>421/E5</td><td>15</td></tr><tr><td>421/F5</td><td>16</td></tr><tr><td>421/F5</td><td>17</td></tr><tr><td>421/F5</td><td>18</td></tr><tr><td>421/F5</td><td>19</td></tr><tr><td>SPARE</td><td>20</td></tr><tr><td>422/D4</td><td>21</td></tr><tr><td>422/D4</td><td>22</td></tr><tr><td>422/D4</td><td>23</td></tr><tr><td>422/D4</td><td>24</td></tr><tr><td>422/D4</td><td>25</td></tr><tr><td>422/E4</td><td>26</td></tr><tr><td>422/E4</td><td>27</td></tr><tr><td>422/E4</td><td>28</td></tr><tr><td>422/E4</td><td>29</td></tr><tr><td>SPARE</td><td>30</td></tr><tr><td>423/E5</td><td>31</td></tr><tr><td>423/E5</td><td>32</td></tr><tr><td>423/D5</td><td>33</td></tr><tr><td>423/D5</td><td>34</td></tr><tr><td>423/D5</td><td>35</td></tr><tr><td>SPARE</td><td>36</td></tr><tr><td>SPARE</td><td>37</td></tr><tr><td>SPARE</td><td>38</td></tr><tr><td>SPARE</td><td>39</td></tr><tr><td>SPARE</td><td>40</td></tr></table>	REFERENCE	X1 CT CKTS.	421/B5	1	421/B5	2	421/B5	3	421/B5	4	421/B5	5	421/B5	6	421/C5	7	421/C5	8	421/C5	9	SPARE	10	421/E5	11	421/E5	12	421/E5	13	421/E5	14	421/E5	15	421/F5	16	421/F5	17	421/F5	18	421/F5	19	SPARE	20	422/D4	21	422/D4	22	422/D4	23	422/D4	24	422/D4	25	422/E4	26	422/E4	27	422/E4	28	422/E4	29	SPARE	30	423/E5	31	423/E5	32	423/D5	33	423/D5	34	423/D5	35	SPARE	36	SPARE	37	SPARE	38	SPARE	39	SPARE	40		<table><tr><td>REFERENCE</td><td>X52 CON & PROTN CKTS</td></tr><tr><td>416/B3</td><td>1</td></tr><tr><td>416/B3</td><td>2</td></tr><tr><td>429/D3</td><td>3</td></tr><tr><td>432/D4</td><td>4</td></tr><tr><td>432/D5</td><td>5</td></tr><tr><td>SPARE</td><td>6</td></tr><tr><td>SPARE</td><td>7</td></tr><tr><td>SPARE</td><td>8</td></tr><tr><td>436/D3</td><td>9</td></tr><tr><td>436/D3</td><td>10</td></tr><tr><td>433/D1</td><td>11</td></tr><tr><td>433/D2</td><td>12</td></tr><tr><td>433/D4</td><td>13</td></tr><tr><td>433/D5</td><td>14</td></tr><tr><td>433/D6</td><td>15</td></tr><tr><td>433/D7</td><td>16</td></tr><tr><td>434/D1</td><td>17</td></tr><tr><td>434/D2</td><td>18</td></tr><tr><td>434/D4</td><td>19</td></tr><tr><td>434/D5</td><td>20</td></tr><tr><td>434/D6</td><td>21</td></tr><tr><td>434/D7</td><td>22</td></tr><tr><td>435/D1</td><td>23</td></tr><tr><td>435/D2</td><td>24</td></tr><tr><td>435/D4</td><td>25</td></tr><tr><td>435/D5</td><td>26</td></tr><tr><td>435/D6</td><td>27</td></tr><tr><td>435/D7</td><td>28</td></tr><tr><td>436/D2</td><td>29</td></tr><tr><td>436/D2</td><td>30</td></tr><tr><td>491/A4</td><td>31</td></tr><tr><td>491/C4</td><td>32</td></tr><tr><td>491/D4</td><td>33</td></tr><tr><td>491/E4</td><td>34</td></tr><tr><td>491/B5</td><td>35</td></tr><tr><td>491/A6</td><td>36</td></tr><tr><td>491/C5</td><td>37</td></tr><tr><td>491/C6</td><td>38</td></tr><tr><td>SPARE</td><td>39</td></tr><tr><td>SPARE</td><td>40</td></tr><tr><td>491/A9</td><td>41</td></tr><tr><td>491/B9</td><td>42</td></tr><tr><td>492/E2</td><td>43</td></tr><tr><td>492/E2</td><td>44</td></tr><tr><td>492/E3</td><td>45</td></tr><tr><td>492/E4</td><td>46</td></tr><tr><td>492/E4</td><td>47</td></tr><tr><td>492/E5</td><td>48</td></tr><tr><td>492/E5</td><td>49</td></tr><tr><td>492/E6</td><td>50</td></tr></table>	REFERENCE	X52 CON & PROTN CKTS	416/B3	1	416/B3	2	429/D3	3	432/D4	4	432/D5	5	SPARE	6	SPARE	7	SPARE	8	436/D3	9	436/D3	10	433/D1	11	433/D2	12	433/D4	13	433/D5	14	433/D6	15	433/D7	16	434/D1	17	434/D2	18	434/D4	19	434/D5	20	434/D6	21	434/D7	22	435/D1	23	435/D2	24	435/D4	25	435/D5	26	435/D6	27	435/D7	28	436/D2	29	436/D2	30	491/A4	31	491/C4	32	491/D4	33	491/E4	34	491/B5	35	491/A6	36	491/C5	37	491/C6	38	SPARE	39	SPARE	40	491/A9	41	491/B9	42	492/E2	43	492/E2	44	492/E3	45	492/E4	46	492/E4	47	492/E5	48	492/E5	49	492/E6	50		<table><tr><td>REFERENCE</td><td>X52 CON & PROTN CKTS</td></tr><tr><td>492/E7</td><td>51</td></tr><tr><td>492/E8</td><td>52</td></tr><tr><td>492/E9</td><td>53</td></tr><tr><td>492/E10</td><td>54</td></tr><tr><td>SPARE</td><td>55</td></tr><tr><td>SPARE</td><td>56</td></tr><tr><td>493/E5</td><td>57</td></tr><tr><td>493/E5</td><td>58</td></tr><tr><td>493/E7</td><td>59</td></tr><tr><td>493/E7</td><td>60</td></tr><tr><td>494/E3</td><td>61</td></tr><tr><td>494/E4</td><td>62</td></tr><tr><td>494/E4</td><td>63</td></tr><tr><td>494/E5</td><td>64</td></tr><tr><td>494/E5</td><td>65</td></tr><tr><td>494/E6</td><td>66</td></tr><tr><td>494/E5</td><td>67</td></tr><tr><td>494/E7</td><td>68</td></tr><tr><td>494/E7</td><td>69</td></tr><tr><td>494/E8</td><td>70</td></tr><tr><td>494/E8</td><td>71</td></tr><tr><td>494/E9</td><td>72</td></tr><tr><td>494/E10</td><td>73</td></tr><tr><td>494/E9</td><td>74</td></tr><tr><td>495/B2</td><td>75</td></tr><tr><td>495/E2</td><td>76</td></tr><tr><td>495/B4</td><td>77</td></tr><tr><td>495/E4</td><td>78</td></tr><tr><td>495/B5</td><td>79</td></tr><tr><td>495/E5</td><td>80</td></tr><tr><td>495/B7</td><td>81</td></tr><tr><td>495/E7</td><td>82</td></tr><tr><td>SPARE</td><td>83</td></tr><tr><td>SPARE</td><td>84</td></tr><tr><td>SPARE</td><td>85</td></tr><tr><td>SPARE</td><td>86</td></tr><tr><td>SPARE</td><td>87</td></tr><tr><td>SPARE</td><td>88</td></tr><tr><td>SPARE</td><td>89</td></tr><tr><td>SPARE</td><td>90</td></tr></table>	REFERENCE	X52 CON & PROTN CKTS	492/E7	51	492/E8	52	492/E9	53	492/E10	54	SPARE	55	SPARE	56	493/E5	57	493/E5	58	493/E7	59	493/E7	60	494/E3	61	494/E4	62	494/E4	63	494/E5	64	494/E5	65	494/E6	66	494/E5	67	494/E7	68	494/E7	69	494/E8	70	494/E8	71	494/E9	72	494/E10	73	494/E9	74	495/B2	75	495/E2	76	495/B4	77	495/E4	78	495/B5	79	495/E5	80	495/B7	81	495/E7	82	SPARE	83	SPARE	84	SPARE	85	SPARE	86	SPARE	87	SPARE	88	SPARE	89	SPARE	90		<table><tr><td>REFERENCE</td><td>X42 DC CKTS.</td></tr><tr><td>416/B3</td><td>1</td></tr><tr><td>416/B3</td><td>2</td></tr><tr><td>416/C3</td><td>3</td></tr><tr><td>416/C3</td><td>4</td></tr><tr><td>416/D3</td><td>5</td></tr><tr><td>416/D3</td><td>6</td></tr><tr><td>429/B3</td><td>7</td></tr><tr><td>SPARE</td><td>8</td></tr><tr><td>SPARE</td><td>9</td></tr><tr><td>SPARE</td><td>10</td></tr><tr><td>432/A4</td><td>11</td></tr><tr><td>432/A5</td><td>12</td></tr><tr><td>433/B2</td><td>13</td></tr><tr><td>436/B2</td><td>14</td></tr><tr><td>432/A1</td><td>15</td></tr><tr><td>SPARE</td><td>16</td></tr><tr><td>SPARE</td><td>17</td></tr><tr><td>437/B4</td><td>18</td></tr><tr><td>437/B4</td><td>19</td></tr><tr><td>SPARE</td><td>20</td></tr></table>	REFERENCE	X42 DC CKTS.	416/B3	1	416/B3	2	416/C3	3	416/C3	4	416/D3	5	416/D3	6	429/B3	7	SPARE	8	SPARE	9	SPARE	10	432/A4	11	432/A5	12	433/B2	13	436/B2	14	432/A1	15	SPARE	16	SPARE	17	437/B4	18	437/B4	19	SPARE	20		<table><tr><td>REFERENCE</td><td>X53 CON & PROTN CKTS</td></tr><tr><td>498/E1</td><td>1</td></tr><tr><td>498/E1</td><td>2</td></tr><tr><td>498/E2</td><td>3</td></tr><tr><td>498/E2</td><td>4</td></tr><tr><td>498/E2</td><td>5</td></tr><tr><td>498/E3</td><td>6</td></tr><tr><td>498/E3</td><td>7</td></tr><tr><td>498/E4</td><td>8</td></tr><tr><td>498/E4</td><td>9</td></tr><tr><td>498/E4</td><td>10</td></tr><tr><td>498/E5</td><td>11</td></tr><tr><td>498/E5</td><td>12</td></tr><tr><td>498/E6</td><td>13</td></tr><tr><td>498/E6</td><td>14</td></tr><tr><td>498/E6</td><td>15</td></tr><tr><td>498/E7</td><td>16</td></tr><tr><td>498/E7</td><td>17</td></tr><tr><td>498/E8</td><td>18</td></tr><tr><td>498/E8</td><td>19</td></tr><tr><td>498/E8</td><td>20</td></tr><tr><td>498/E9</td><td>21</td></tr><tr><td>498/E9</td><td>22</td></tr><tr><td>498/E10</td><td>23</td></tr><tr><td>498/E10</td><td>24</td></tr><tr><td>SPARE</td><td>25</td></tr><tr><td>SPARE</td><td>26</td></tr><tr><td>SPARE</td><td>27</td></tr><tr><td>SPARE</td><td>28</td></tr><tr><td>SPARE</td><td>29</td></tr><tr><td>SPARE</td><td>30</td></tr><tr><td>SPARE</td><td>31</td></tr><tr><td>SPARE</td><td>32</td></tr><tr><td>SPARE</td><td>33</td></tr><tr><td>SPARE</td><td>34</td></tr><tr><td>SPARE</td><td>35</td></tr><tr><td>SPARE</td><td>36</td></tr><tr><td>SPARE</td><td>37</td></tr><tr><td>SPARE</td><td>38</td></tr><tr><td>SPARE</td><td>39</td></tr><tr><td>SPARE</td><td>40</td></tr></table>	REFERENCE	X53 CON & PROTN CKTS	498/E1	1	498/E1	2	498/E2	3	498/E2	4	498/E2	5	498/E3	6	498/E3	7	498/E4	8	498/E4	9	498/E4	10	498/E5	11	498/E5	12	498/E6	13	498/E6	14	498/E6	15	498/E7	16	498/E7	17	498/E8	18	498/E8	19	498/E8	20	498/E9	21	498/E9	22	498/E10	23	498/E10	24	SPARE	25	SPARE	26	SPARE	27	SPARE	28	SPARE	29	SPARE	30	SPARE	31	SPARE	32	SPARE	33	SPARE	34	SPARE	35	SPARE	36	SPARE	37	SPARE	38	SPARE	39	SPARE	40
REFERENCE	X3 AC CKT.																																																																																																																																																																																																																																																																																																																																																																																																																																						
411/A3	1																																																																																																																																																																																																																																																																																																																																																																																																																																						
411/A7	2																																																																																																																																																																																																																																																																																																																																																																																																																																						
411/A3	3																																																																																																																																																																																																																																																																																																																																																																																																																																						
411/A7	4																																																																																																																																																																																																																																																																																																																																																																																																																																						
411/B3	5																																																																																																																																																																																																																																																																																																																																																																																																																																						
411/B7	6																																																																																																																																																																																																																																																																																																																																																																																																																																						
411/B3	7																																																																																																																																																																																																																																																																																																																																																																																																																																						
411/B7	8																																																																																																																																																																																																																																																																																																																																																																																																																																						
SPARE	9																																																																																																																																																																																																																																																																																																																																																																																																																																						
SPARE	10																																																																																																																																																																																																																																																																																																																																																																																																																																						
REFERENCE	X1 CT CKTS.																																																																																																																																																																																																																																																																																																																																																																																																																																						
421/B5	1																																																																																																																																																																																																																																																																																																																																																																																																																																						
421/B5	2																																																																																																																																																																																																																																																																																																																																																																																																																																						
421/B5	3																																																																																																																																																																																																																																																																																																																																																																																																																																						
421/B5	4																																																																																																																																																																																																																																																																																																																																																																																																																																						
421/B5	5																																																																																																																																																																																																																																																																																																																																																																																																																																						
421/B5	6																																																																																																																																																																																																																																																																																																																																																																																																																																						
421/C5	7																																																																																																																																																																																																																																																																																																																																																																																																																																						
421/C5	8																																																																																																																																																																																																																																																																																																																																																																																																																																						
421/C5	9																																																																																																																																																																																																																																																																																																																																																																																																																																						
SPARE	10																																																																																																																																																																																																																																																																																																																																																																																																																																						
421/E5	11																																																																																																																																																																																																																																																																																																																																																																																																																																						
421/E5	12																																																																																																																																																																																																																																																																																																																																																																																																																																						
421/E5	13																																																																																																																																																																																																																																																																																																																																																																																																																																						
421/E5	14																																																																																																																																																																																																																																																																																																																																																																																																																																						
421/E5	15																																																																																																																																																																																																																																																																																																																																																																																																																																						
421/F5	16																																																																																																																																																																																																																																																																																																																																																																																																																																						
421/F5	17																																																																																																																																																																																																																																																																																																																																																																																																																																						
421/F5	18																																																																																																																																																																																																																																																																																																																																																																																																																																						
421/F5	19																																																																																																																																																																																																																																																																																																																																																																																																																																						
SPARE	20																																																																																																																																																																																																																																																																																																																																																																																																																																						
422/D4	21																																																																																																																																																																																																																																																																																																																																																																																																																																						
422/D4	22																																																																																																																																																																																																																																																																																																																																																																																																																																						
422/D4	23																																																																																																																																																																																																																																																																																																																																																																																																																																						
422/D4	24																																																																																																																																																																																																																																																																																																																																																																																																																																						
422/D4	25																																																																																																																																																																																																																																																																																																																																																																																																																																						
422/E4	26																																																																																																																																																																																																																																																																																																																																																																																																																																						
422/E4	27																																																																																																																																																																																																																																																																																																																																																																																																																																						
422/E4	28																																																																																																																																																																																																																																																																																																																																																																																																																																						
422/E4	29																																																																																																																																																																																																																																																																																																																																																																																																																																						
SPARE	30																																																																																																																																																																																																																																																																																																																																																																																																																																						
423/E5	31																																																																																																																																																																																																																																																																																																																																																																																																																																						
423/E5	32																																																																																																																																																																																																																																																																																																																																																																																																																																						
423/D5	33																																																																																																																																																																																																																																																																																																																																																																																																																																						
423/D5	34																																																																																																																																																																																																																																																																																																																																																																																																																																						
423/D5	35																																																																																																																																																																																																																																																																																																																																																																																																																																						
SPARE	36																																																																																																																																																																																																																																																																																																																																																																																																																																						
SPARE	37																																																																																																																																																																																																																																																																																																																																																																																																																																						
SPARE	38																																																																																																																																																																																																																																																																																																																																																																																																																																						
SPARE	39																																																																																																																																																																																																																																																																																																																																																																																																																																						
SPARE	40																																																																																																																																																																																																																																																																																																																																																																																																																																						
REFERENCE	X52 CON & PROTN CKTS																																																																																																																																																																																																																																																																																																																																																																																																																																						
416/B3	1																																																																																																																																																																																																																																																																																																																																																																																																																																						
416/B3	2																																																																																																																																																																																																																																																																																																																																																																																																																																						
429/D3	3																																																																																																																																																																																																																																																																																																																																																																																																																																						
432/D4	4																																																																																																																																																																																																																																																																																																																																																																																																																																						
432/D5	5																																																																																																																																																																																																																																																																																																																																																																																																																																						
SPARE	6																																																																																																																																																																																																																																																																																																																																																																																																																																						
SPARE	7																																																																																																																																																																																																																																																																																																																																																																																																																																						
SPARE	8																																																																																																																																																																																																																																																																																																																																																																																																																																						
436/D3	9																																																																																																																																																																																																																																																																																																																																																																																																																																						
436/D3	10																																																																																																																																																																																																																																																																																																																																																																																																																																						
433/D1	11																																																																																																																																																																																																																																																																																																																																																																																																																																						
433/D2	12																																																																																																																																																																																																																																																																																																																																																																																																																																						
433/D4	13																																																																																																																																																																																																																																																																																																																																																																																																																																						
433/D5	14																																																																																																																																																																																																																																																																																																																																																																																																																																						
433/D6	15																																																																																																																																																																																																																																																																																																																																																																																																																																						
433/D7	16																																																																																																																																																																																																																																																																																																																																																																																																																																						
434/D1	17																																																																																																																																																																																																																																																																																																																																																																																																																																						
434/D2	18																																																																																																																																																																																																																																																																																																																																																																																																																																						
434/D4	19																																																																																																																																																																																																																																																																																																																																																																																																																																						
434/D5	20																																																																																																																																																																																																																																																																																																																																																																																																																																						
434/D6	21																																																																																																																																																																																																																																																																																																																																																																																																																																						
434/D7	22																																																																																																																																																																																																																																																																																																																																																																																																																																						
435/D1	23																																																																																																																																																																																																																																																																																																																																																																																																																																						
435/D2	24																																																																																																																																																																																																																																																																																																																																																																																																																																						
435/D4	25																																																																																																																																																																																																																																																																																																																																																																																																																																						
435/D5	26																																																																																																																																																																																																																																																																																																																																																																																																																																						
435/D6	27																																																																																																																																																																																																																																																																																																																																																																																																																																						
435/D7	28																																																																																																																																																																																																																																																																																																																																																																																																																																						
436/D2	29																																																																																																																																																																																																																																																																																																																																																																																																																																						
436/D2	30																																																																																																																																																																																																																																																																																																																																																																																																																																						
491/A4	31																																																																																																																																																																																																																																																																																																																																																																																																																																						
491/C4	32																																																																																																																																																																																																																																																																																																																																																																																																																																						
491/D4	33																																																																																																																																																																																																																																																																																																																																																																																																																																						
491/E4	34																																																																																																																																																																																																																																																																																																																																																																																																																																						
491/B5	35																																																																																																																																																																																																																																																																																																																																																																																																																																						
491/A6	36																																																																																																																																																																																																																																																																																																																																																																																																																																						
491/C5	37																																																																																																																																																																																																																																																																																																																																																																																																																																						
491/C6	38																																																																																																																																																																																																																																																																																																																																																																																																																																						
SPARE	39																																																																																																																																																																																																																																																																																																																																																																																																																																						
SPARE	40																																																																																																																																																																																																																																																																																																																																																																																																																																						
491/A9	41																																																																																																																																																																																																																																																																																																																																																																																																																																						
491/B9	42																																																																																																																																																																																																																																																																																																																																																																																																																																						
492/E2	43																																																																																																																																																																																																																																																																																																																																																																																																																																						
492/E2	44																																																																																																																																																																																																																																																																																																																																																																																																																																						
492/E3	45																																																																																																																																																																																																																																																																																																																																																																																																																																						
492/E4	46																																																																																																																																																																																																																																																																																																																																																																																																																																						
492/E4	47																																																																																																																																																																																																																																																																																																																																																																																																																																						
492/E5	48																																																																																																																																																																																																																																																																																																																																																																																																																																						
492/E5	49																																																																																																																																																																																																																																																																																																																																																																																																																																						
492/E6	50																																																																																																																																																																																																																																																																																																																																																																																																																																						
REFERENCE	X52 CON & PROTN CKTS																																																																																																																																																																																																																																																																																																																																																																																																																																						
492/E7	51																																																																																																																																																																																																																																																																																																																																																																																																																																						
492/E8	52																																																																																																																																																																																																																																																																																																																																																																																																																																						
492/E9	53																																																																																																																																																																																																																																																																																																																																																																																																																																						
492/E10	54																																																																																																																																																																																																																																																																																																																																																																																																																																						
SPARE	55																																																																																																																																																																																																																																																																																																																																																																																																																																						
SPARE	56																																																																																																																																																																																																																																																																																																																																																																																																																																						
493/E5	57																																																																																																																																																																																																																																																																																																																																																																																																																																						
493/E5	58																																																																																																																																																																																																																																																																																																																																																																																																																																						
493/E7	59																																																																																																																																																																																																																																																																																																																																																																																																																																						
493/E7	60																																																																																																																																																																																																																																																																																																																																																																																																																																						
494/E3	61																																																																																																																																																																																																																																																																																																																																																																																																																																						
494/E4	62																																																																																																																																																																																																																																																																																																																																																																																																																																						
494/E4	63																																																																																																																																																																																																																																																																																																																																																																																																																																						
494/E5	64																																																																																																																																																																																																																																																																																																																																																																																																																																						
494/E5	65																																																																																																																																																																																																																																																																																																																																																																																																																																						
494/E6	66																																																																																																																																																																																																																																																																																																																																																																																																																																						
494/E5	67																																																																																																																																																																																																																																																																																																																																																																																																																																						
494/E7	68																																																																																																																																																																																																																																																																																																																																																																																																																																						
494/E7	69																																																																																																																																																																																																																																																																																																																																																																																																																																						
494/E8	70																																																																																																																																																																																																																																																																																																																																																																																																																																						
494/E8	71																																																																																																																																																																																																																																																																																																																																																																																																																																						
494/E9	72																																																																																																																																																																																																																																																																																																																																																																																																																																						
494/E10	73																																																																																																																																																																																																																																																																																																																																																																																																																																						
494/E9	74																																																																																																																																																																																																																																																																																																																																																																																																																																						
495/B2	75																																																																																																																																																																																																																																																																																																																																																																																																																																						
495/E2	76																																																																																																																																																																																																																																																																																																																																																																																																																																						
495/B4	77																																																																																																																																																																																																																																																																																																																																																																																																																																						
495/E4	78																																																																																																																																																																																																																																																																																																																																																																																																																																						
495/B5	79																																																																																																																																																																																																																																																																																																																																																																																																																																						
495/E5	80																																																																																																																																																																																																																																																																																																																																																																																																																																						
495/B7	81																																																																																																																																																																																																																																																																																																																																																																																																																																						
495/E7	82																																																																																																																																																																																																																																																																																																																																																																																																																																						
SPARE	83																																																																																																																																																																																																																																																																																																																																																																																																																																						
SPARE	84																																																																																																																																																																																																																																																																																																																																																																																																																																						
SPARE	85																																																																																																																																																																																																																																																																																																																																																																																																																																						
SPARE	86																																																																																																																																																																																																																																																																																																																																																																																																																																						
SPARE	87																																																																																																																																																																																																																																																																																																																																																																																																																																						
SPARE	88																																																																																																																																																																																																																																																																																																																																																																																																																																						
SPARE	89																																																																																																																																																																																																																																																																																																																																																																																																																																						
SPARE	90																																																																																																																																																																																																																																																																																																																																																																																																																																						
REFERENCE	X42 DC CKTS.																																																																																																																																																																																																																																																																																																																																																																																																																																						
416/B3	1																																																																																																																																																																																																																																																																																																																																																																																																																																						
416/B3	2																																																																																																																																																																																																																																																																																																																																																																																																																																						
416/C3	3																																																																																																																																																																																																																																																																																																																																																																																																																																						
416/C3	4																																																																																																																																																																																																																																																																																																																																																																																																																																						
416/D3	5																																																																																																																																																																																																																																																																																																																																																																																																																																						
416/D3	6																																																																																																																																																																																																																																																																																																																																																																																																																																						
429/B3	7																																																																																																																																																																																																																																																																																																																																																																																																																																						
SPARE	8																																																																																																																																																																																																																																																																																																																																																																																																																																						
SPARE	9																																																																																																																																																																																																																																																																																																																																																																																																																																						
SPARE	10																																																																																																																																																																																																																																																																																																																																																																																																																																						
432/A4	11																																																																																																																																																																																																																																																																																																																																																																																																																																						
432/A5	12																																																																																																																																																																																																																																																																																																																																																																																																																																						
433/B2	13																																																																																																																																																																																																																																																																																																																																																																																																																																						
436/B2	14																																																																																																																																																																																																																																																																																																																																																																																																																																						
432/A1	15																																																																																																																																																																																																																																																																																																																																																																																																																																						
SPARE	16																																																																																																																																																																																																																																																																																																																																																																																																																																						
SPARE	17																																																																																																																																																																																																																																																																																																																																																																																																																																						
437/B4	18																																																																																																																																																																																																																																																																																																																																																																																																																																						
437/B4	19																																																																																																																																																																																																																																																																																																																																																																																																																																						
SPARE	20																																																																																																																																																																																																																																																																																																																																																																																																																																						
REFERENCE	X53 CON & PROTN CKTS																																																																																																																																																																																																																																																																																																																																																																																																																																						
498/E1	1																																																																																																																																																																																																																																																																																																																																																																																																																																						
498/E1	2																																																																																																																																																																																																																																																																																																																																																																																																																																						
498/E2	3																																																																																																																																																																																																																																																																																																																																																																																																																																						
498/E2	4																																																																																																																																																																																																																																																																																																																																																																																																																																						
498/E2	5																																																																																																																																																																																																																																																																																																																																																																																																																																						
498/E3	6																																																																																																																																																																																																																																																																																																																																																																																																																																						
498/E3	7																																																																																																																																																																																																																																																																																																																																																																																																																																						
498/E4	8																																																																																																																																																																																																																																																																																																																																																																																																																																						
498/E4	9																																																																																																																																																																																																																																																																																																																																																																																																																																						
498/E4	10																																																																																																																																																																																																																																																																																																																																																																																																																																						
498/E5	11																																																																																																																																																																																																																																																																																																																																																																																																																																						
498/E5	12																																																																																																																																																																																																																																																																																																																																																																																																																																						
498/E6	13																																																																																																																																																																																																																																																																																																																																																																																																																																						
498/E6	14																																																																																																																																																																																																																																																																																																																																																																																																																																						
498/E6	15																																																																																																																																																																																																																																																																																																																																																																																																																																						
498/E7	16																																																																																																																																																																																																																																																																																																																																																																																																																																						
498/E7	17																																																																																																																																																																																																																																																																																																																																																																																																																																						
498/E8	18																																																																																																																																																																																																																																																																																																																																																																																																																																						
498/E8	19																																																																																																																																																																																																																																																																																																																																																																																																																																						
498/E8	20																																																																																																																																																																																																																																																																																																																																																																																																																																						
498/E9	21																																																																																																																																																																																																																																																																																																																																																																																																																																						
498/E9	22																																																																																																																																																																																																																																																																																																																																																																																																																																						
498/E10	23																																																																																																																																																																																																																																																																																																																																																																																																																																						
498/E10	24																																																																																																																																																																																																																																																																																																																																																																																																																																						
SPARE	25																																																																																																																																																																																																																																																																																																																																																																																																																																						
SPARE	26																																																																																																																																																																																																																																																																																																																																																																																																																																						
SPARE	27																																																																																																																																																																																																																																																																																																																																																																																																																																						
SPARE	28																																																																																																																																																																																																																																																																																																																																																																																																																																						
SPARE	29																																																																																																																																																																																																																																																																																																																																																																																																																																						
SPARE	30																																																																																																																																																																																																																																																																																																																																																																																																																																						
SPARE	31																																																																																																																																																																																																																																																																																																																																																																																																																																						
SPARE	32																																																																																																																																																																																																																																																																																																																																																																																																																																						
SPARE	33																																																																																																																																																																																																																																																																																																																																																																																																																																						
SPARE	34																																																																																																																																																																																																																																																																																																																																																																																																																																						
SPARE	35																																																																																																																																																																																																																																																																																																																																																																																																																																						
SPARE	36																																																																																																																																																																																																																																																																																																																																																																																																																																						
SPARE	37																																																																																																																																																																																																																																																																																																																																																																																																																																						
SPARE	38																																																																																																																																																																																																																																																																																																																																																																																																																																						
SPARE	39																																																																																																																																																																																																																																																																																																																																																																																																																																						
SPARE	40																																																																																																																																																																																																																																																																																																																																																																																																																																						
B																																																																																																																																																																																																																																																																																																																																																																																																																																							
C	<table><tr><td>REFERENCE</td><td>XTJ T.JACK</td></tr><tr><td>411/C3</td><td>1</td></tr><tr><td>411/D3</td><td>2</td></tr><tr><td>411/D3</td><td>3</td></tr><tr><td>411/D3</td><td>4</td></tr><tr><td>SPARE</td><td>5</td></tr></table>	REFERENCE	XTJ T.JACK	411/C3	1	411/D3	2	411/D3	3	411/D3	4	SPARE	5																																																																																																																																																																																																																																																																																																																																																																																																																										
REFERENCE	XTJ T.JACK																																																																																																																																																																																																																																																																																																																																																																																																																																						
411/C3	1																																																																																																																																																																																																																																																																																																																																																																																																																																						
411/D3	2																																																																																																																																																																																																																																																																																																																																																																																																																																						
411/D3	3																																																																																																																																																																																																																																																																																																																																																																																																																																						
411/D3	4																																																																																																																																																																																																																																																																																																																																																																																																																																						
SPARE	5																																																																																																																																																																																																																																																																																																																																																																																																																																						
D	<table><tr><td>REFERENCE</td><td>XSH SPACE HEATER</td></tr><tr><td>411/E6</td><td>1</td></tr><tr><td>411/F6</td><td>2</td></tr><tr><td>SPARE</td><td>3</td></tr></table>	REFERENCE	XSH SPACE HEATER	411/E6	1	411/F6	2	SPARE	3																																																																																																																																																																																																																																																																																																																																																																																																																														
REFERENCE	XSH SPACE HEATER																																																																																																																																																																																																																																																																																																																																																																																																																																						
411/E6	1																																																																																																																																																																																																																																																																																																																																																																																																																																						
411/F6	2																																																																																																																																																																																																																																																																																																																																																																																																																																						
SPARE	3																																																																																																																																																																																																																																																																																																																																																																																																																																						
E	<table><tr><td>REFERENCE</td><td>X6 ALM. CKT.</td></tr><tr><td>412/B5</td><td>1</td></tr><tr><td>412/B5</td><td>2</td></tr><tr><td>499/E1</td><td>3</td></tr></table>	REFERENCE	X6 ALM. CKT.	412/B5	1	412/B5	2	499/E1	3																																																																																																																																																																																																																																																																																																																																																																																																																														
REFERENCE	X6 ALM. CKT.																																																																																																																																																																																																																																																																																																																																																																																																																																						
412/B5	1																																																																																																																																																																																																																																																																																																																																																																																																																																						
412/B5	2																																																																																																																																																																																																																																																																																																																																																																																																																																						
499/E1	3																																																																																																																																																																																																																																																																																																																																																																																																																																						
F	<table><tr><td>REFERENCE</td><td>X2 VT CKT.</td></tr><tr><td>424/B4</td><td>1</td></tr><tr><td>424/B4</td><td>2</td></tr><tr><td>424/C4</td><td>3</td></tr><tr><td>424/C4</td><td>4</td></tr><tr><td>SPARE</td><td>5</td></tr></table>	REFERENCE	X2 VT CKT.	424/B4	1	424/B4	2	424/C4	3	424/C4	4	SPARE	5																																																																																																																																																																																																																																																																																																																																																																																																																										
REFERENCE	X2 VT CKT.																																																																																																																																																																																																																																																																																																																																																																																																																																						
424/B4	1																																																																																																																																																																																																																																																																																																																																																																																																																																						
424/B4	2																																																																																																																																																																																																																																																																																																																																																																																																																																						
424/C4	3																																																																																																																																																																																																																																																																																																																																																																																																																																						
424/C4	4																																																																																																																																																																																																																																																																																																																																																																																																																																						
SPARE	5																																																																																																																																																																																																																																																																																																																																																																																																																																						

G	AS-BUILT BY _____ DATE _____		CONTRACT NO. 11131113/00		JOB ORDER NO. S-13656		TERMINAL BLOCK REFERENCE		<div>الشركة الوطنية لنقل الكهرباء</div> <div>نقل الكهرباء National Grid sa</div>						
	01	13 49	FACTORY ASBUILT		DRAWN BY RIZ CHECKED BY JKR		132/13.8kV GT-3 RELAY PANEL-2 +R04.2		INDEX	PLANT NO.	DRAWING NUMBER		SHEET NO.		REV. NO.
	00	13 04	FOR APPROVAL		DATE STARTED 24.01.2013 DATE COMPLETED _____		S/S 8709-132/13.8KV IN AL-KHARJ CITY		-	C421	CD322934		SHT	CONT.	01
	REV. NO.	DATE	DESCRIPTION		OPRG. DEPT. CTPD ENG. DEPT. AUT-PSAC		RIYADH SAUDI ARABIA						506	507	

	1	2	3	4	5	6	7	8	9	10
A										
B										
C										
D										
E										
F										

REFERENCE

414/B3
414/B4
498/E1
498/E2
498/E2
498/E3
498/E3
498/E4
498/E4
SPARE
SPARE
X62
ALARM CKT

1			1
2			2
3			3
4			4
5			5
6			6
7			7
8			8
9			9
10			10
11			11
12			12
13			13
14			14
15			15
16			16
17			17
18			18
19			19
20			20

REFERENCE

499/C6
499/B6
499/C7
499/B7
499/C8
499/B8
499/C8
499/B8
499/C8
499/B8
499/C8
499/B8
499/C9
499/B9
SPARE
SPARE
X92
SPARE

1			1
2			2
3			3
4			4
5			5
6			6
7			7
8			8
9			9
10			10
11			11
12			12
13			13
14			14
15			15
16			16
17			17
18			18
19			19
20			20
21			21
22			22
23			23
24			24
25			20

AS-BUILT BY _____ DATE _____			CONTRACT NO. 11131113/00	JOB ORDER NO. S-13656
01	13 49	FACTORY ASBUILT	DRAWN BY RIZ	CHECKED BY JKR
00	13 04	FOR APPROVAL	DATE STARTED 24.01.2013	DATE COMPLETED _____
REV. NO.	DATE	DESCRIPTION	OPRG. DEPT. CTPD	ENG. DEPT. AUT-PSAC

TERMINAL BLOCK REFERENCE	
132/13.8kv GT-3 RELAY PANEL-2 +R04.2	
S/S 8709-132/13.8KV IN AL-KHARJ CITY	
RIYADH	SAUDI ARABIA

الشركة الوطنية لنقل الكهرباء National Grid sa				
INDEX	PLANT NO.	DRAWING NUMBER	SHEET NO.	
-	C421	CD322934	SHT	CONT.
			507	NIL
			01	